




LATERAL '1' DISTRICT 'C'
SANITARY SEWER No. 20

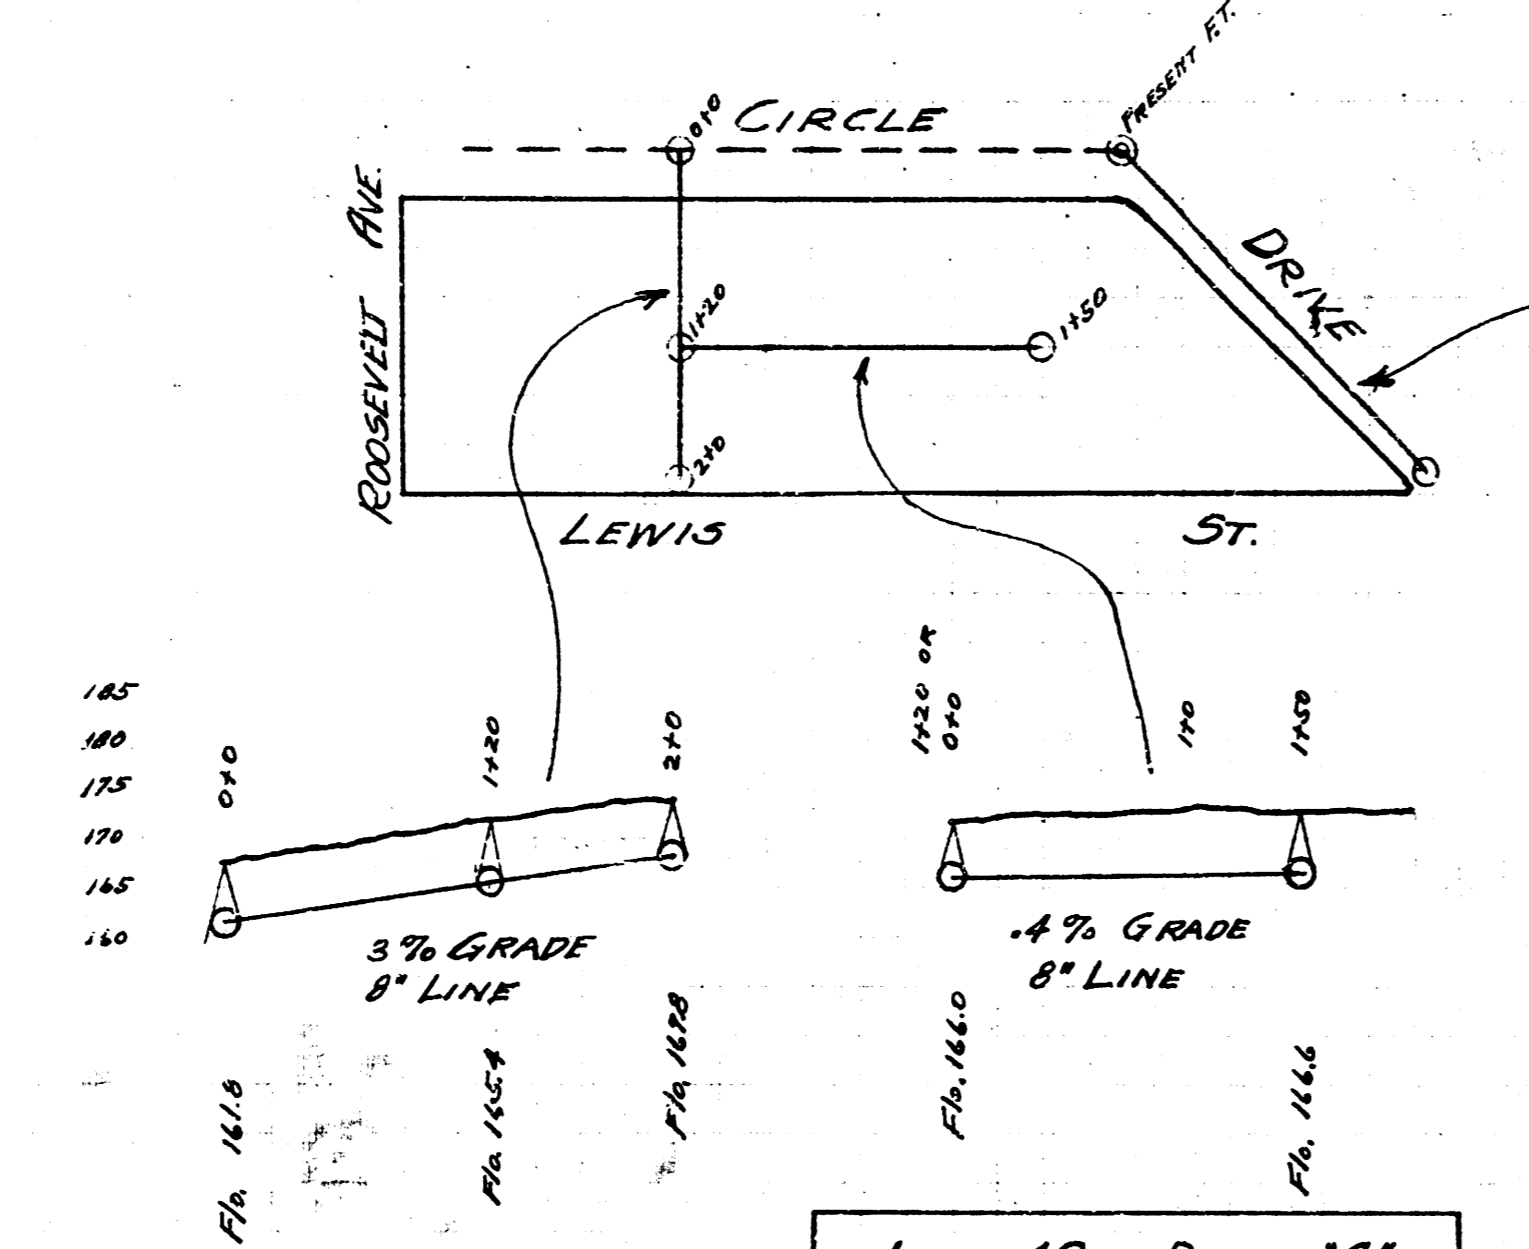

LAT. 16 - DIST. 'A'
S.S. No. 12


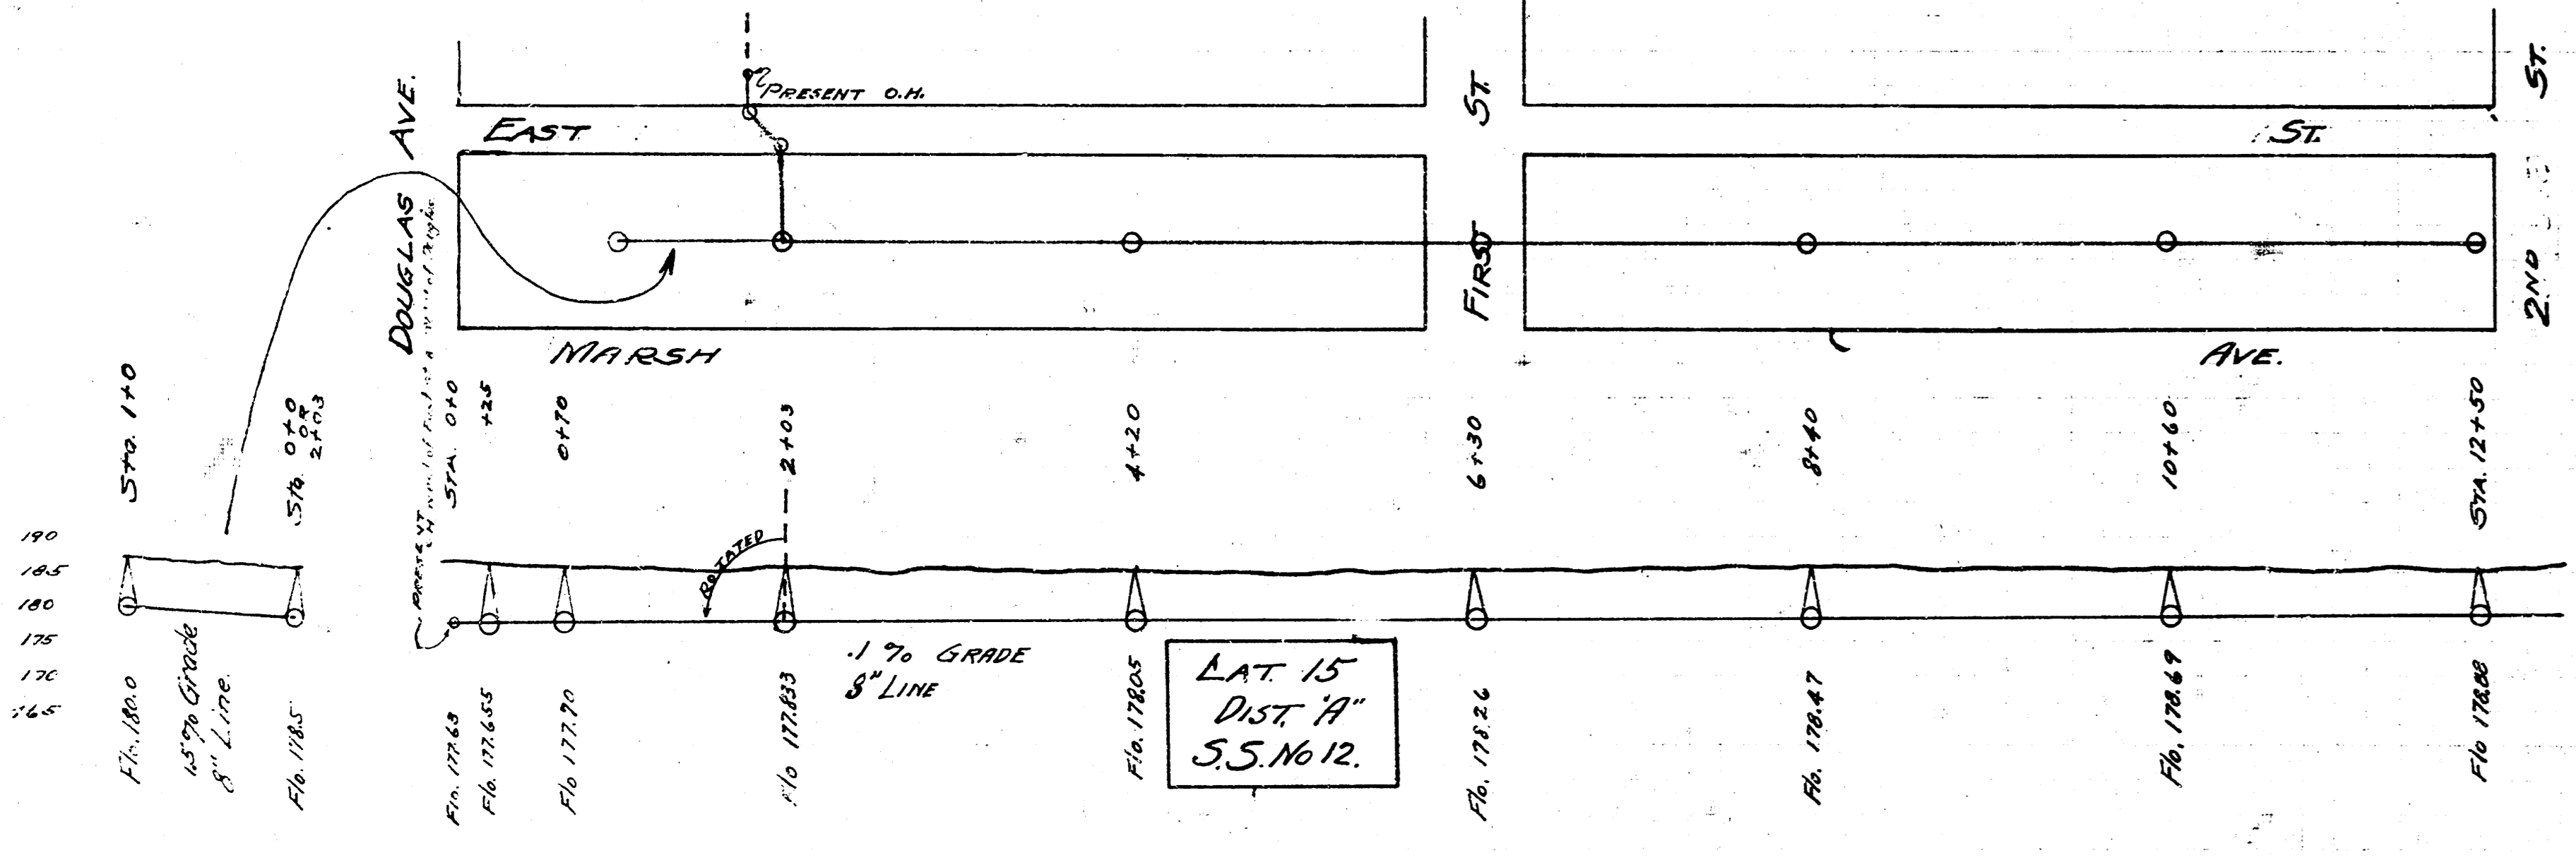


LAT. 15
DIST. 'A'
S.S. No. 12

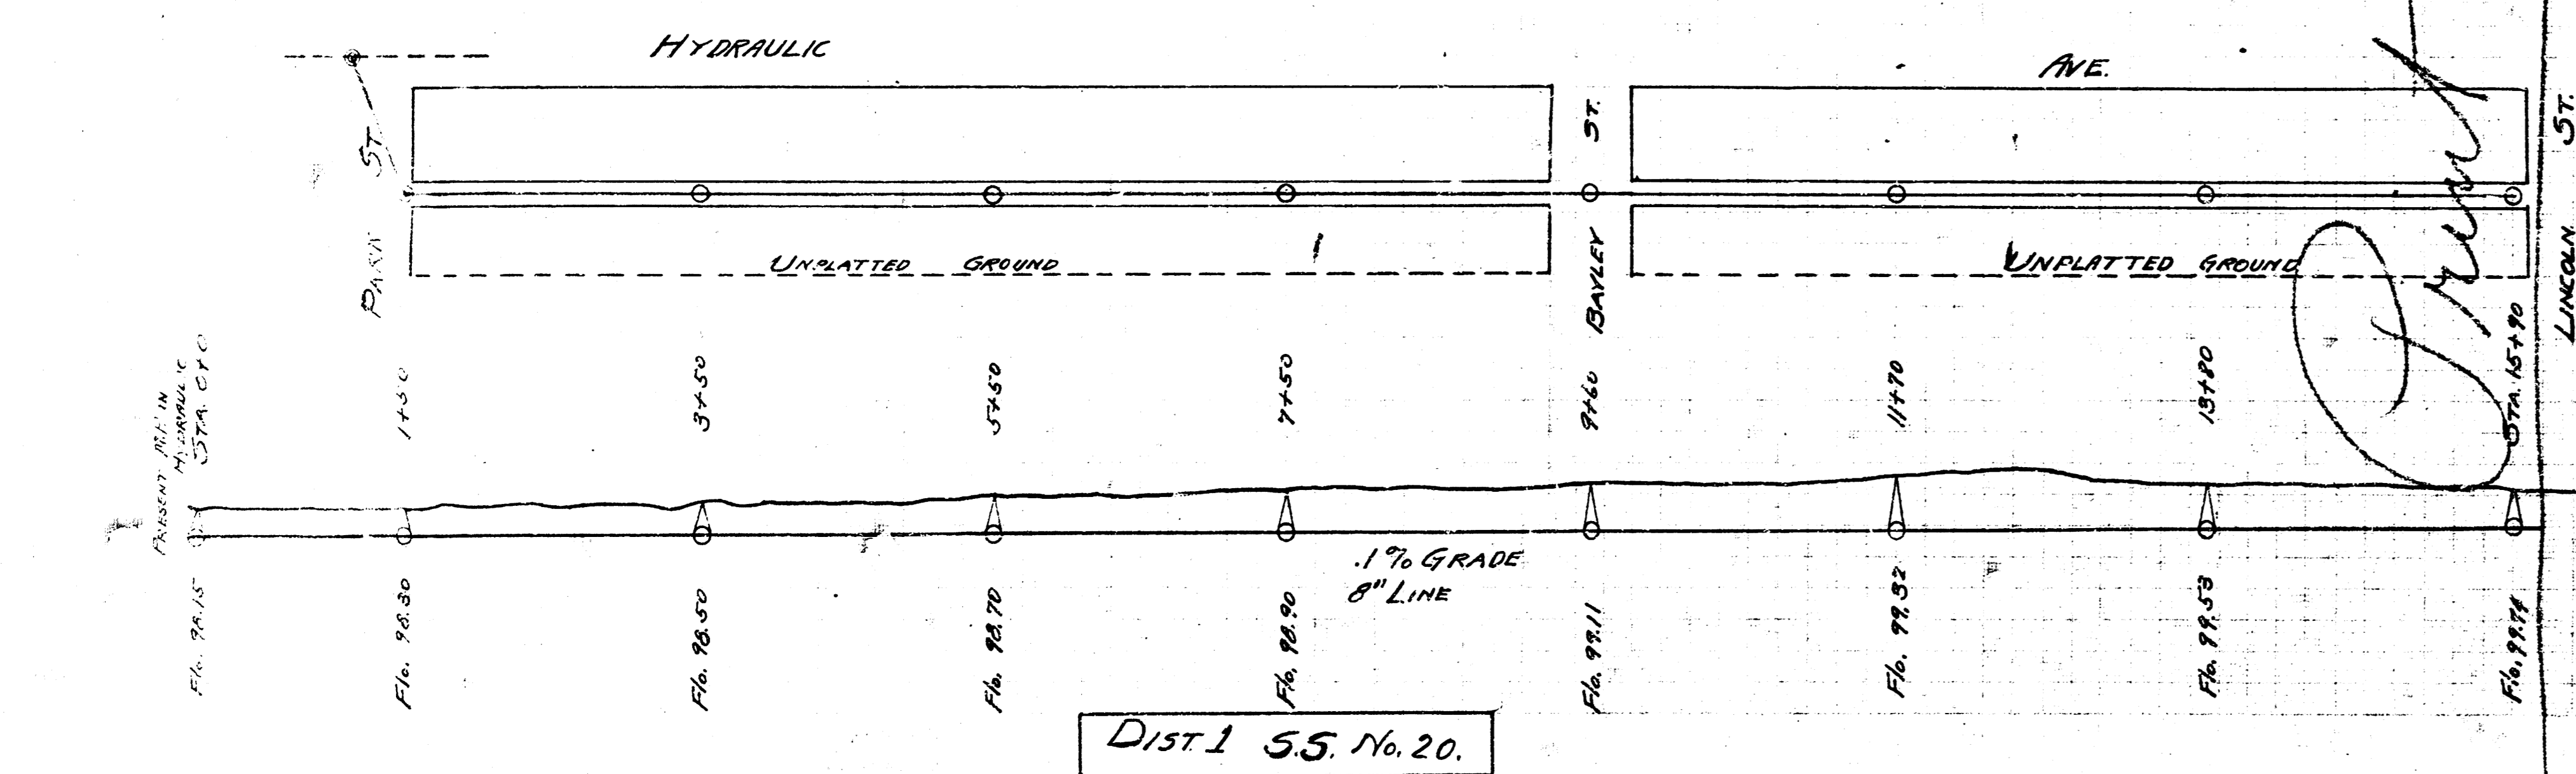



DIST. 1 S.S. No. 20

Front to right of this line only

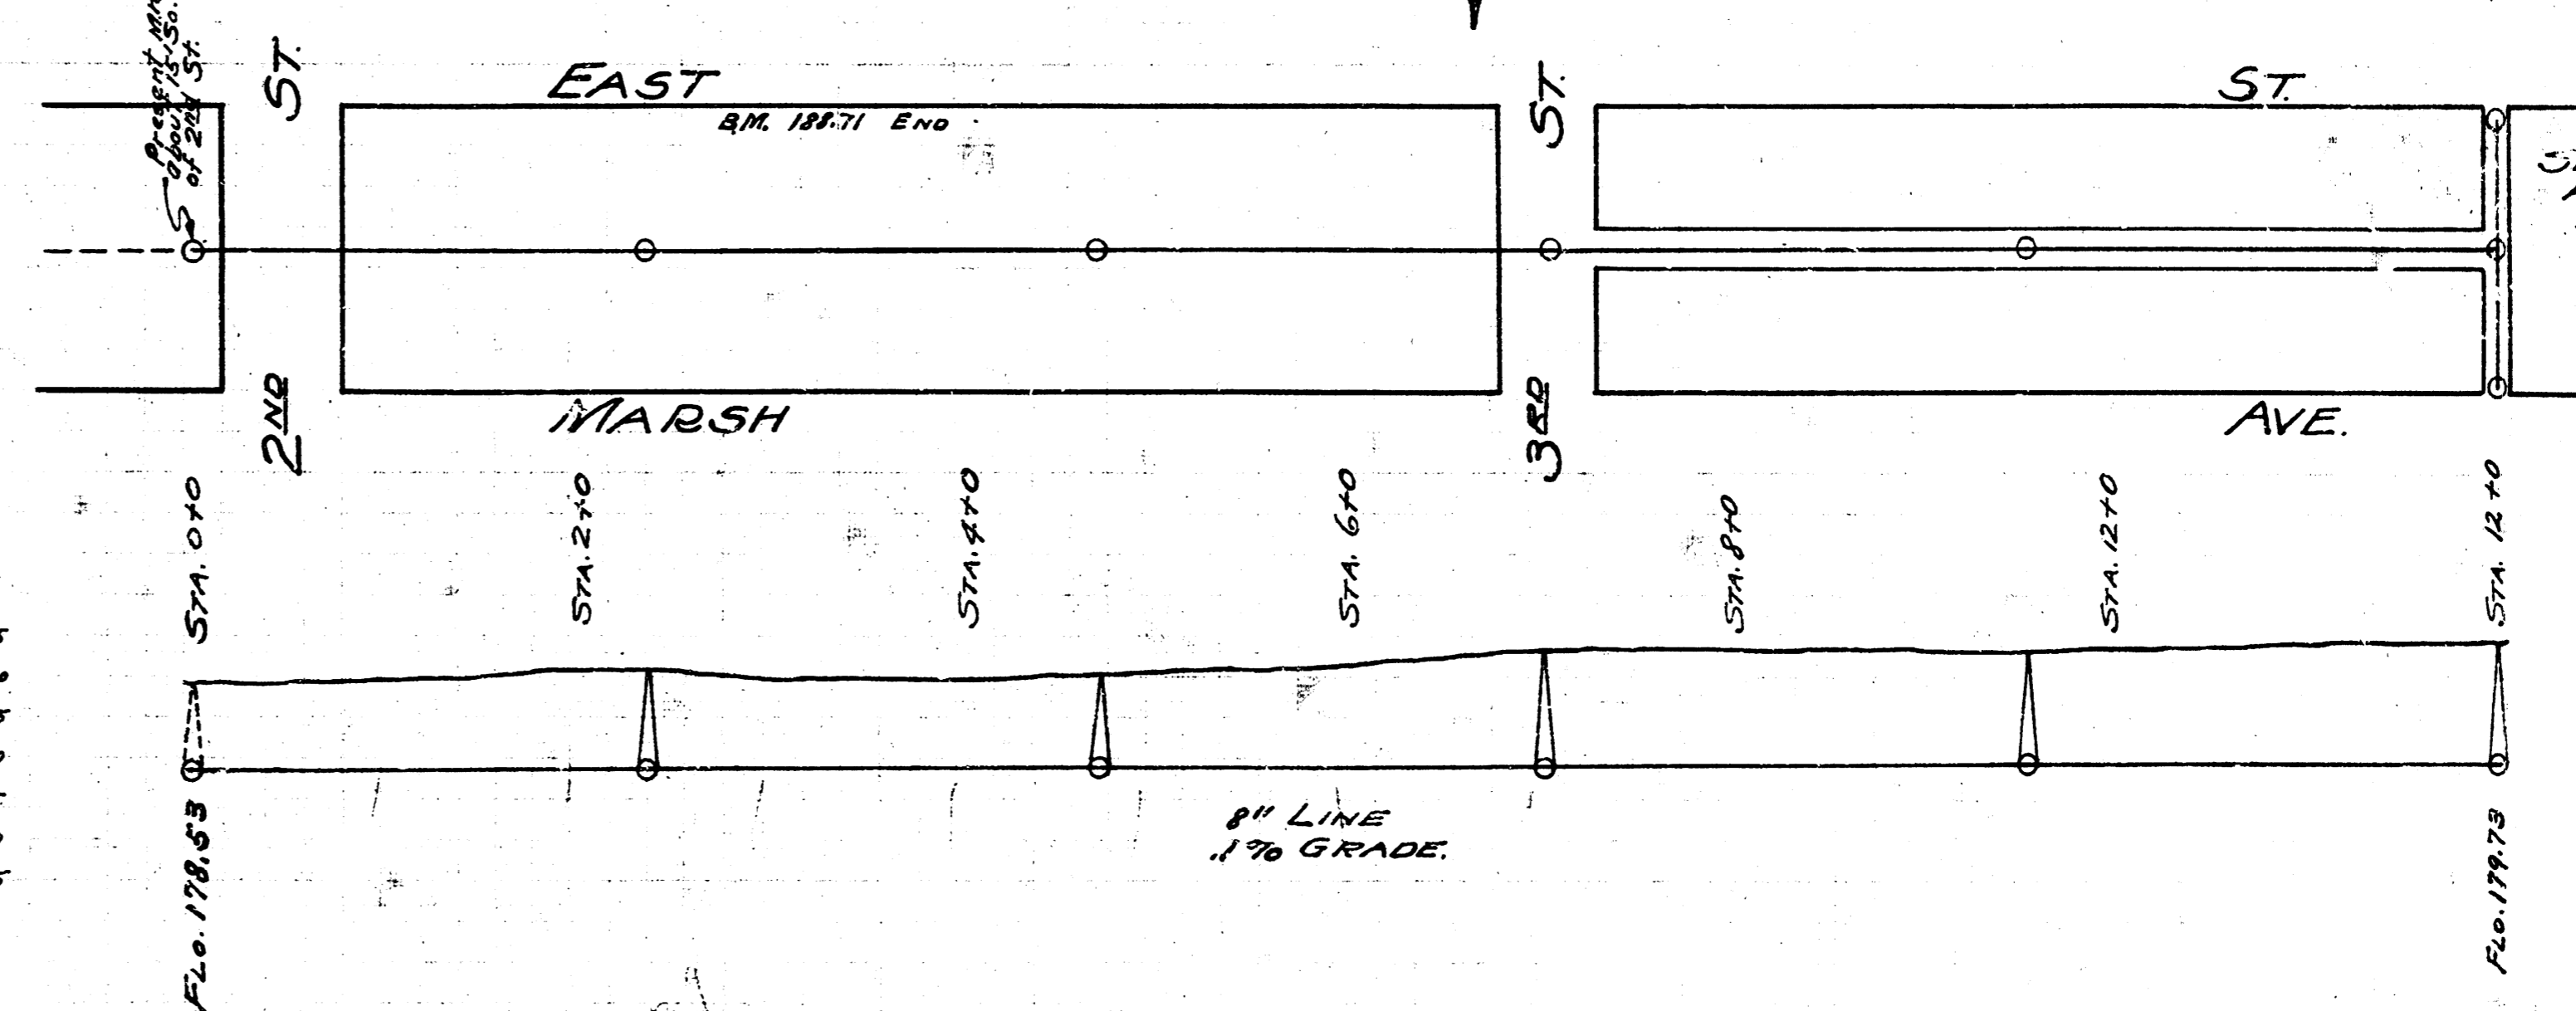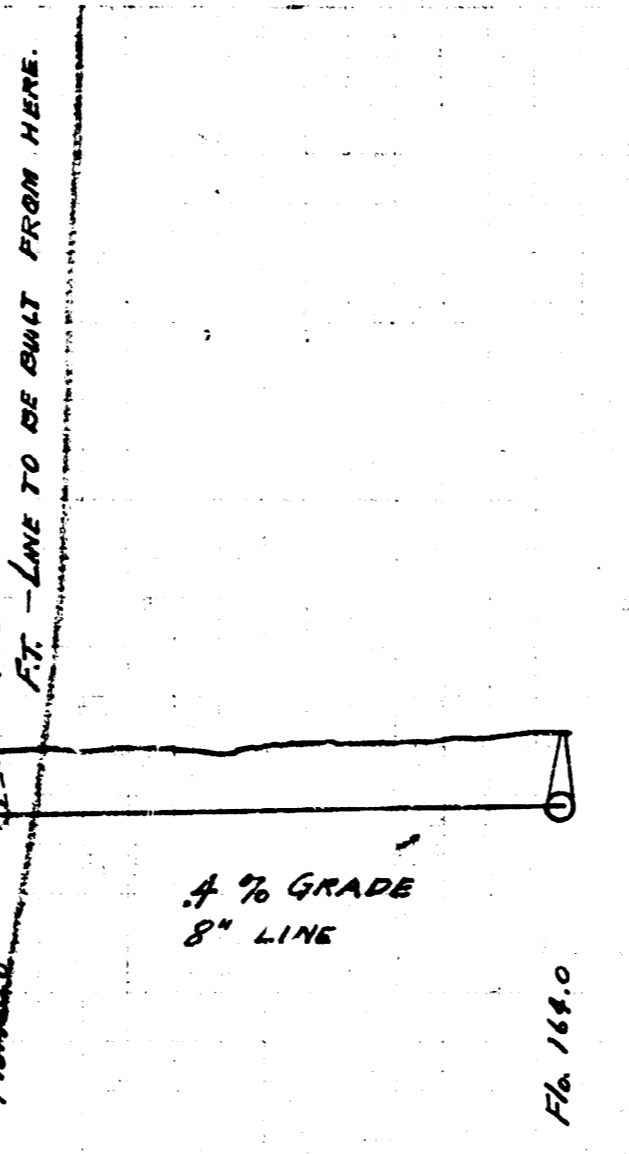

LAT. 17 - DIST. 'A'
S.S. No. 12

LAT. 2
DIST. 'N-O'
S.S. No. 20

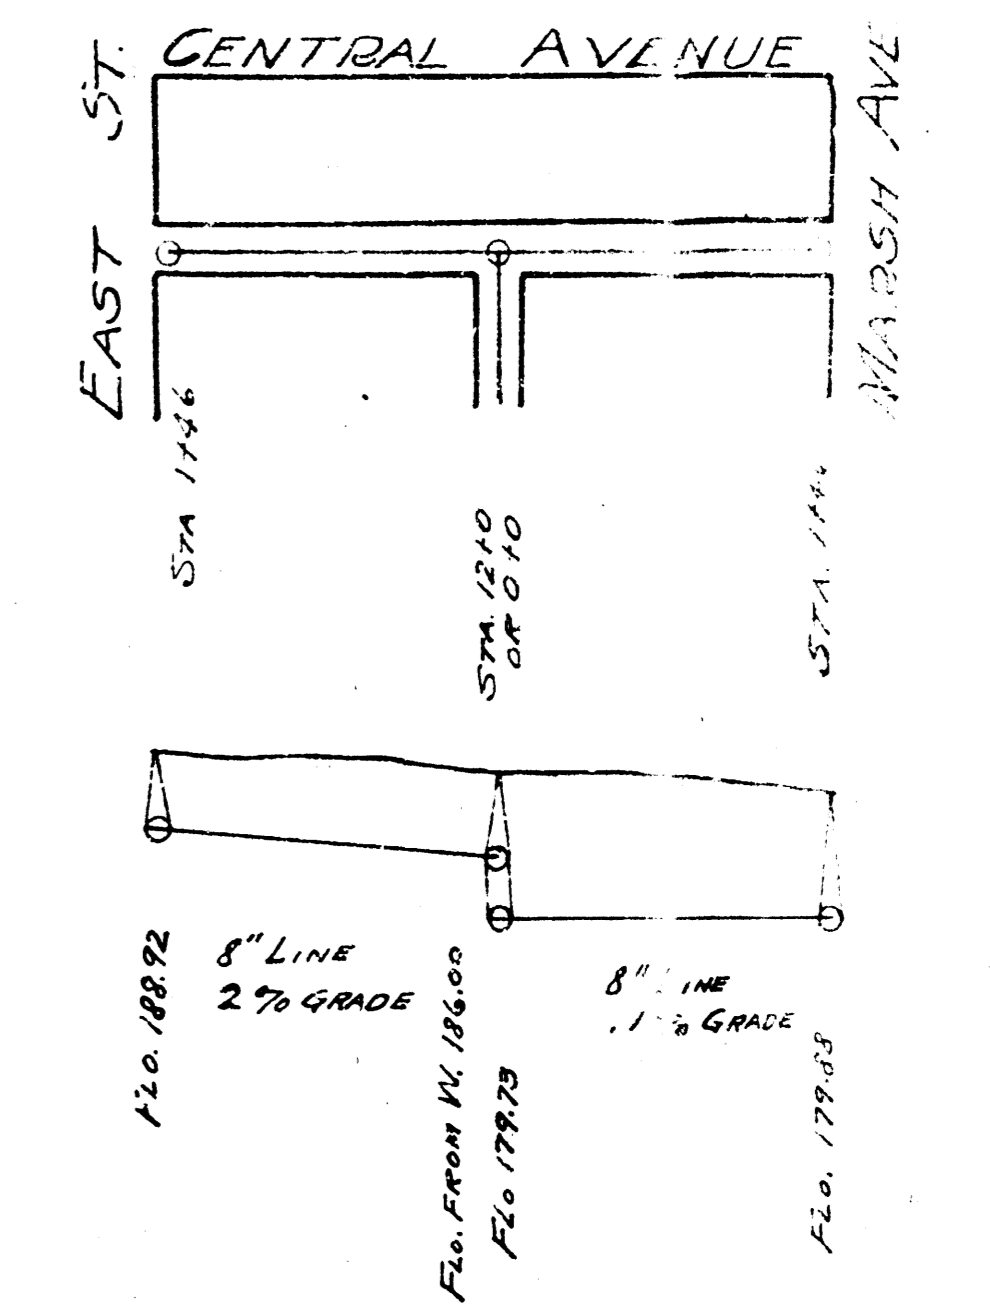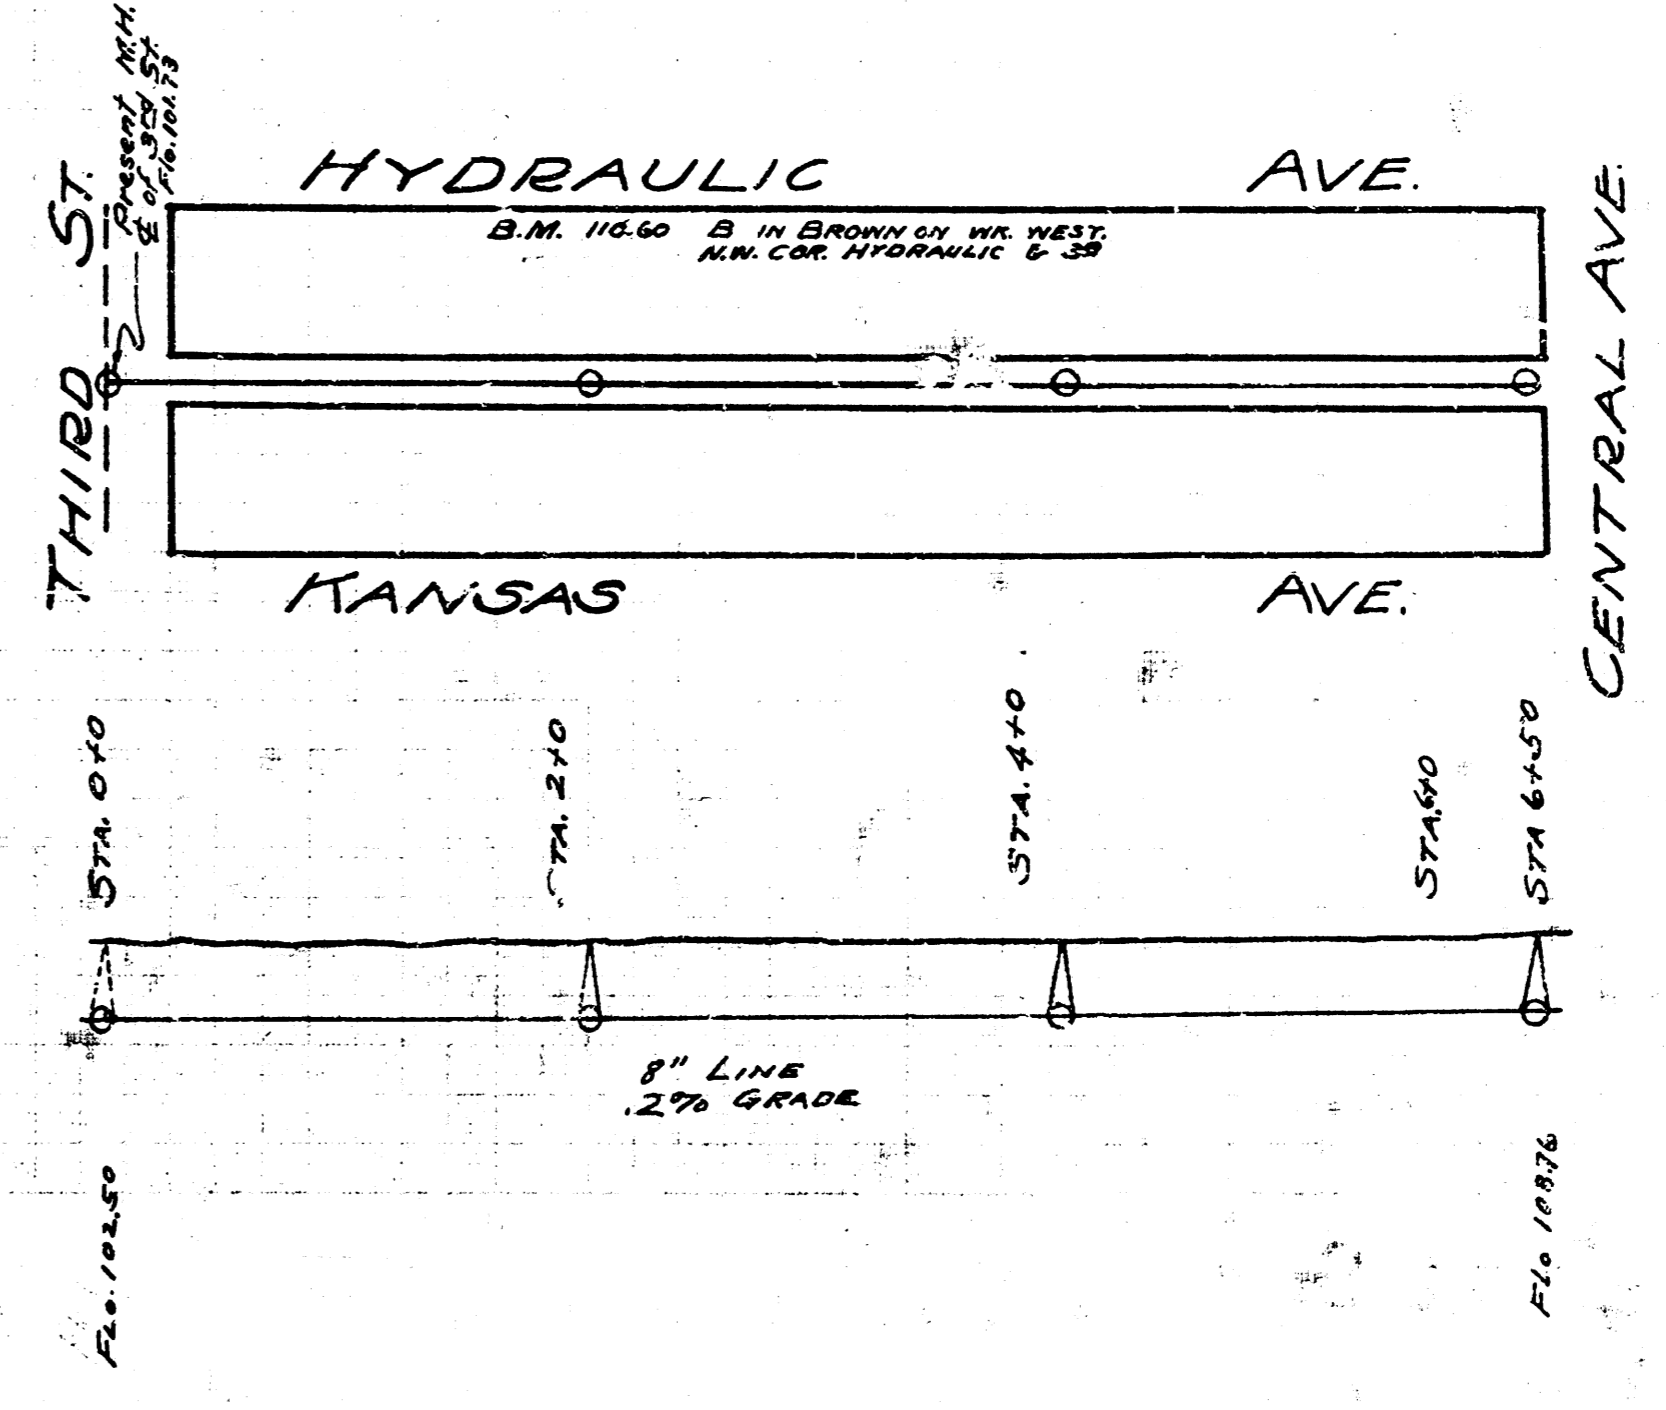

CENTRAL AVE