


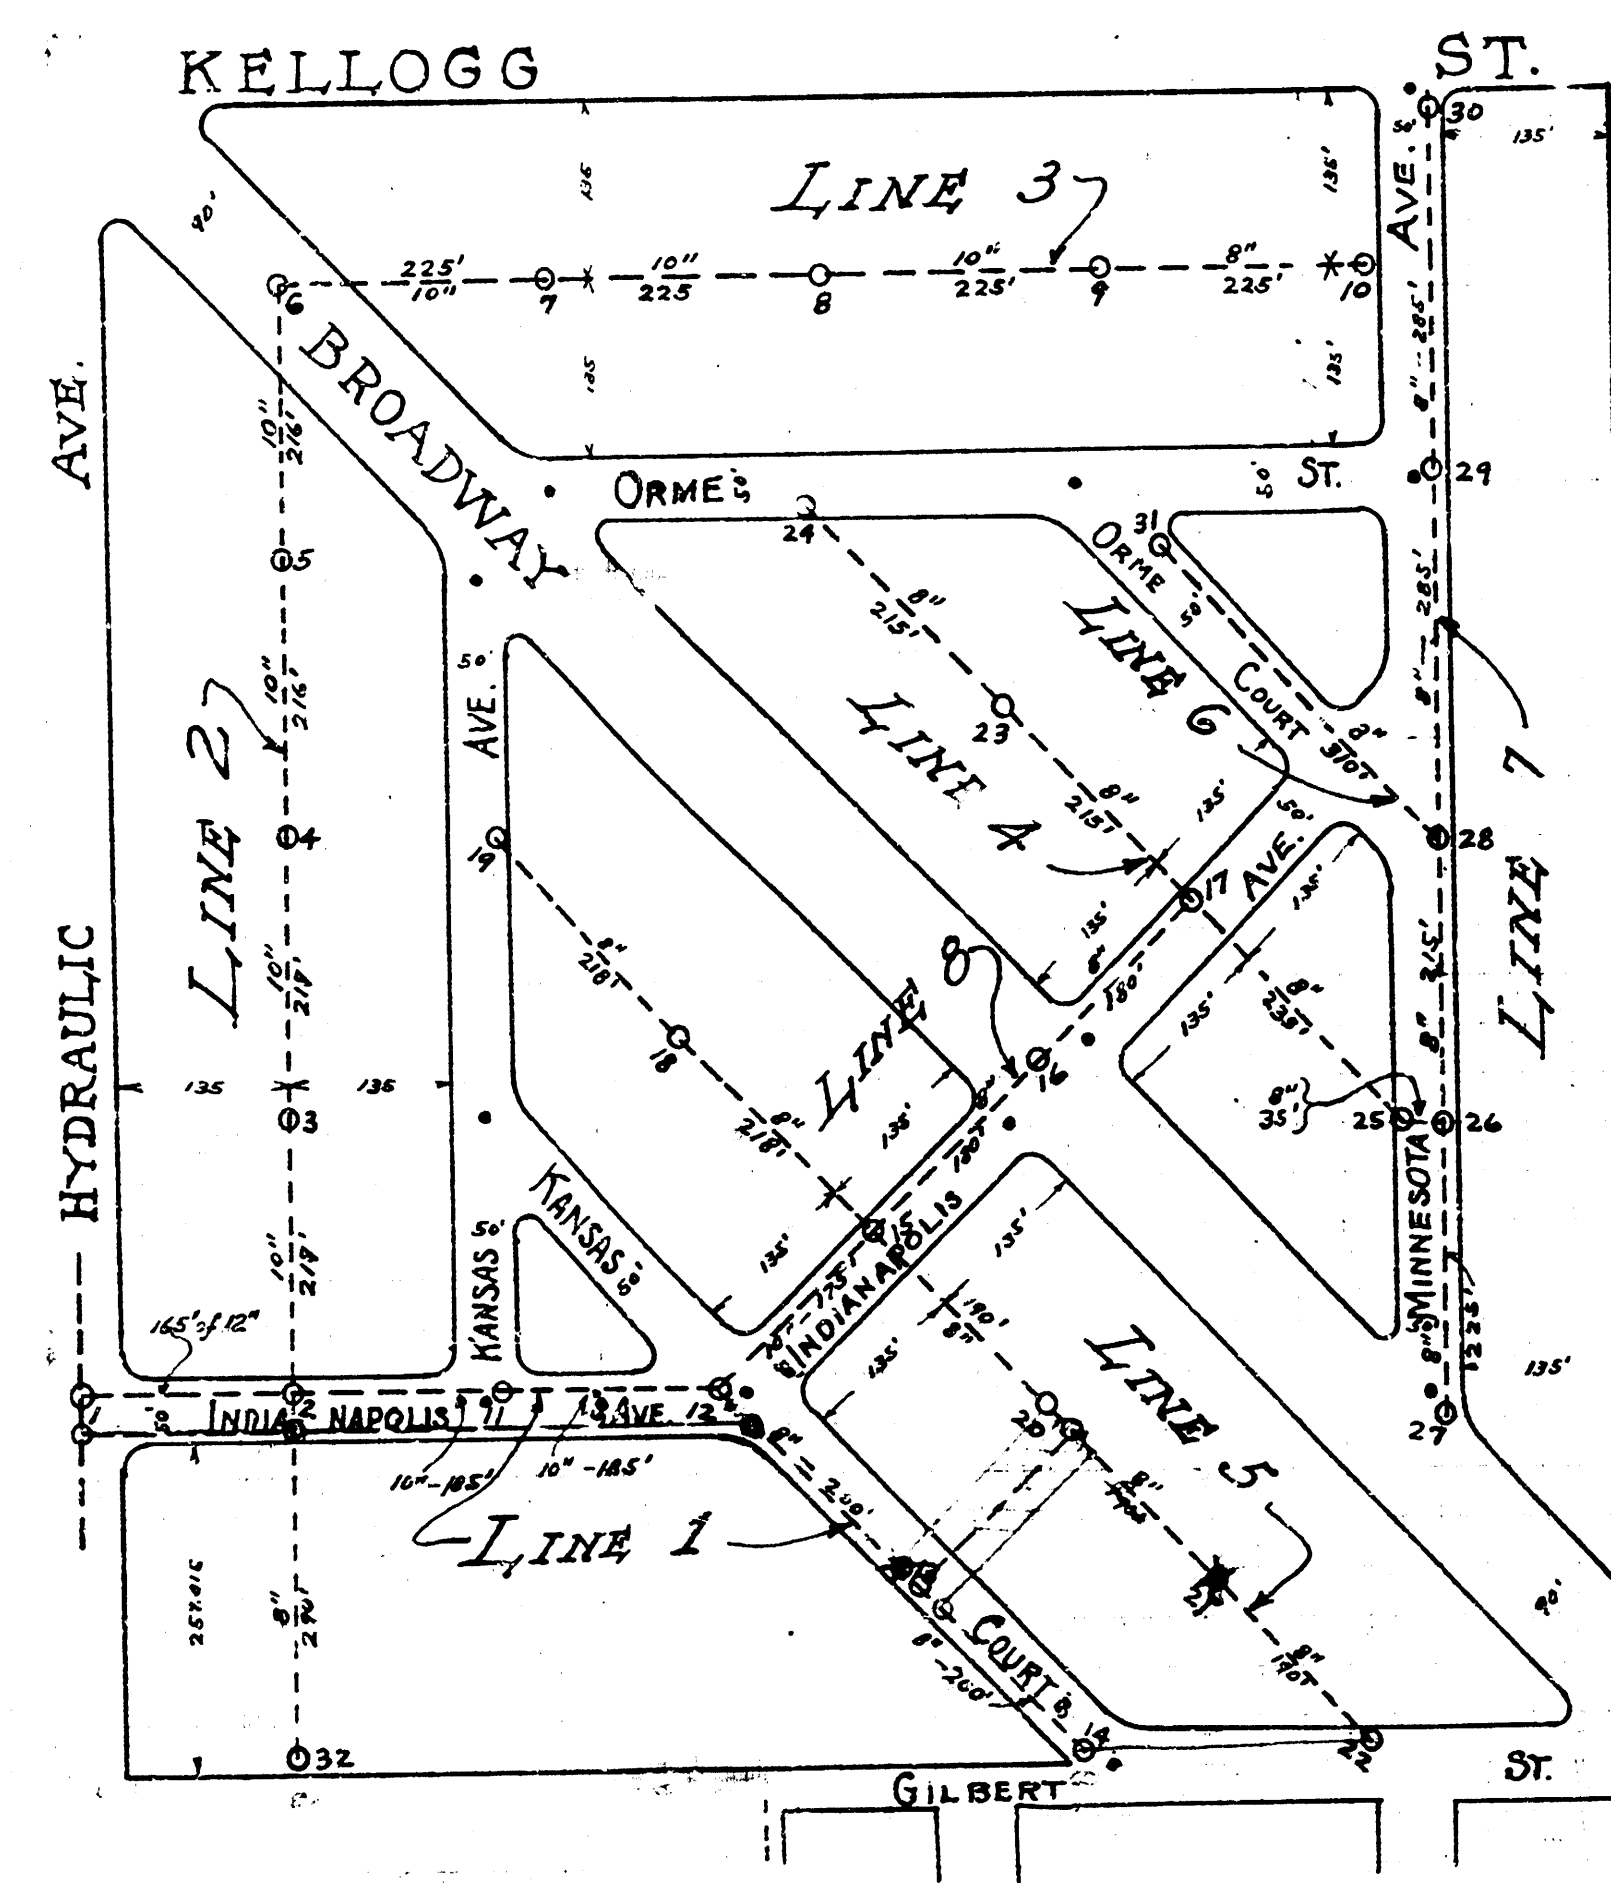

**LAT. 8, S.S.N<sup>o</sup> 20**

**DATA:**

• B.M. 107.15 Std. N.W. cor. Kellogg & Hydraulic.

- 31 Manholes
- 165 lin. ft. 12" Pipe
- 2086 " " 10" Pipe
- 4266 " " 8" Pipe

