

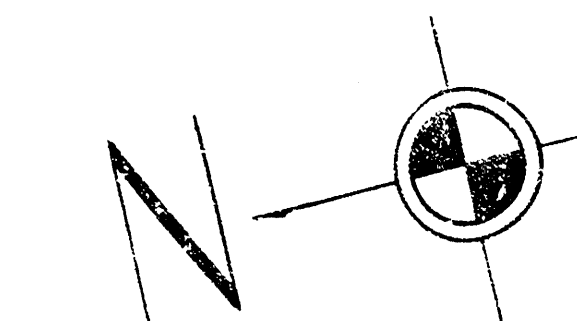
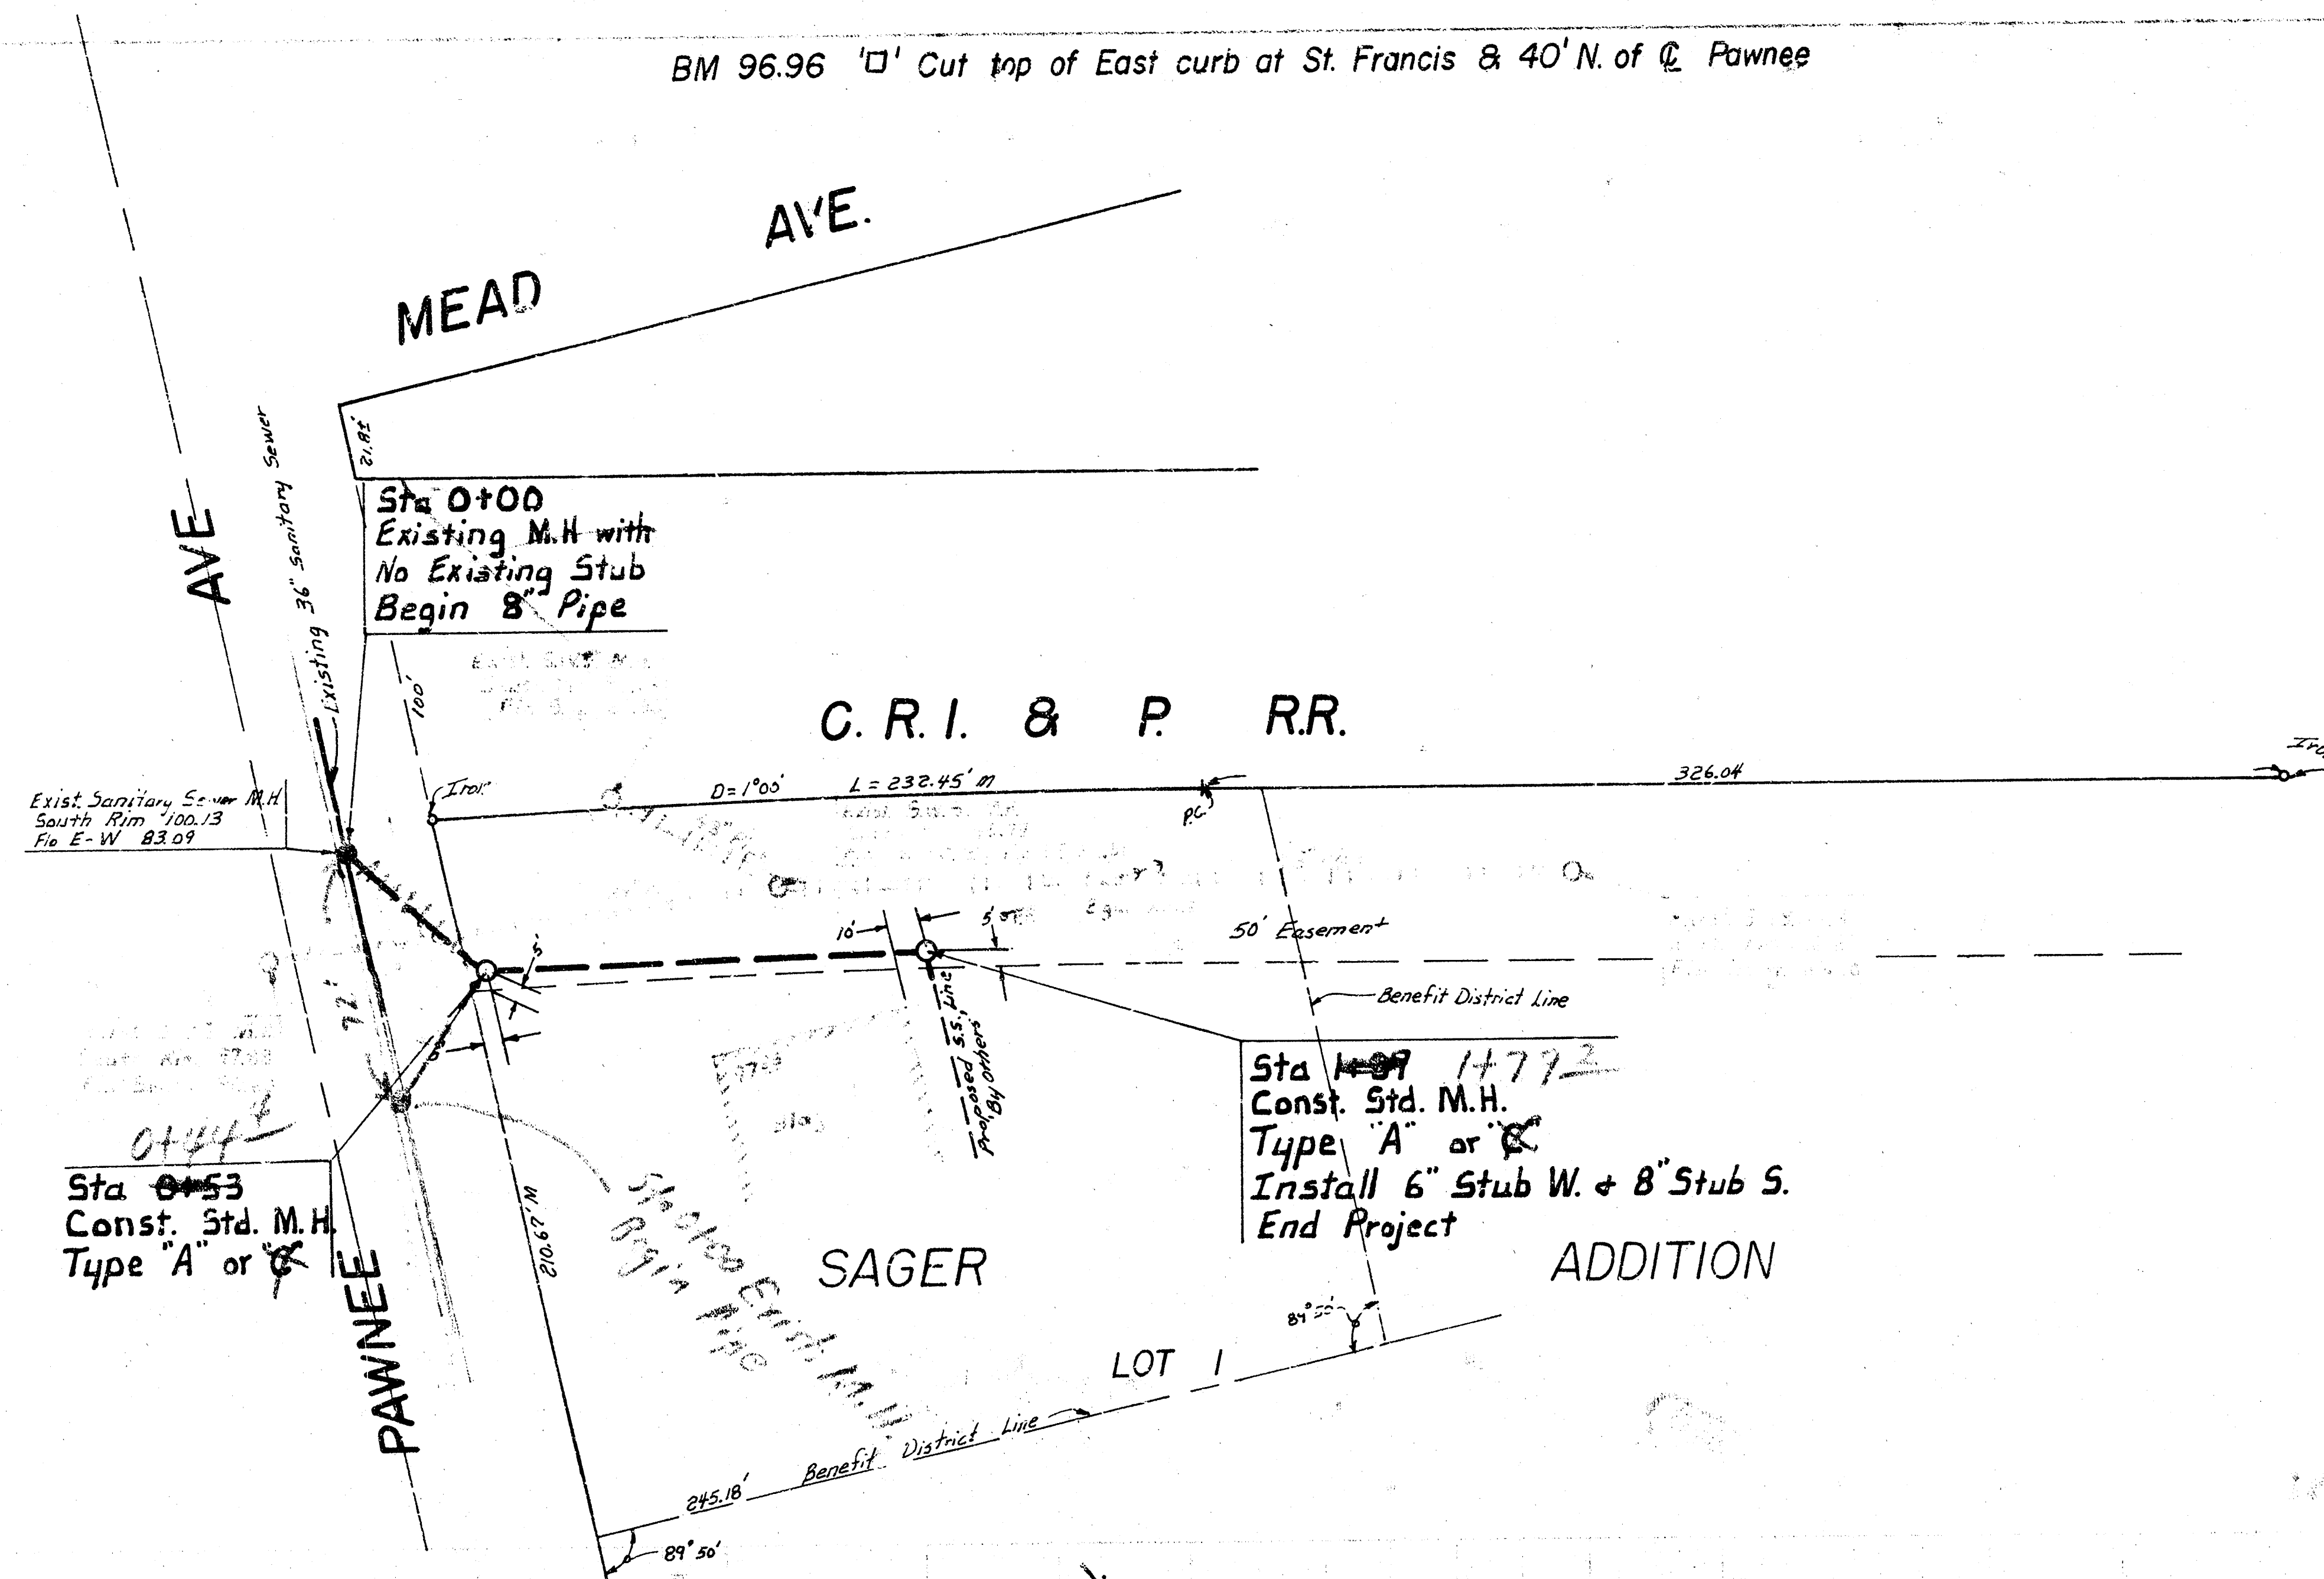


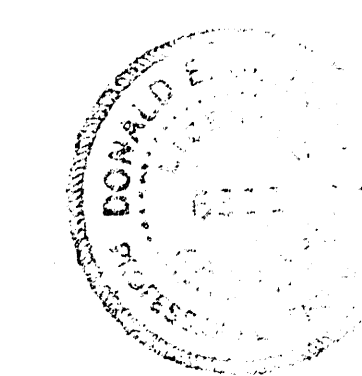

Plan Scale 1" = 40'
Profile Scale 1" = 40' Horz.
1" = 5' Vert.

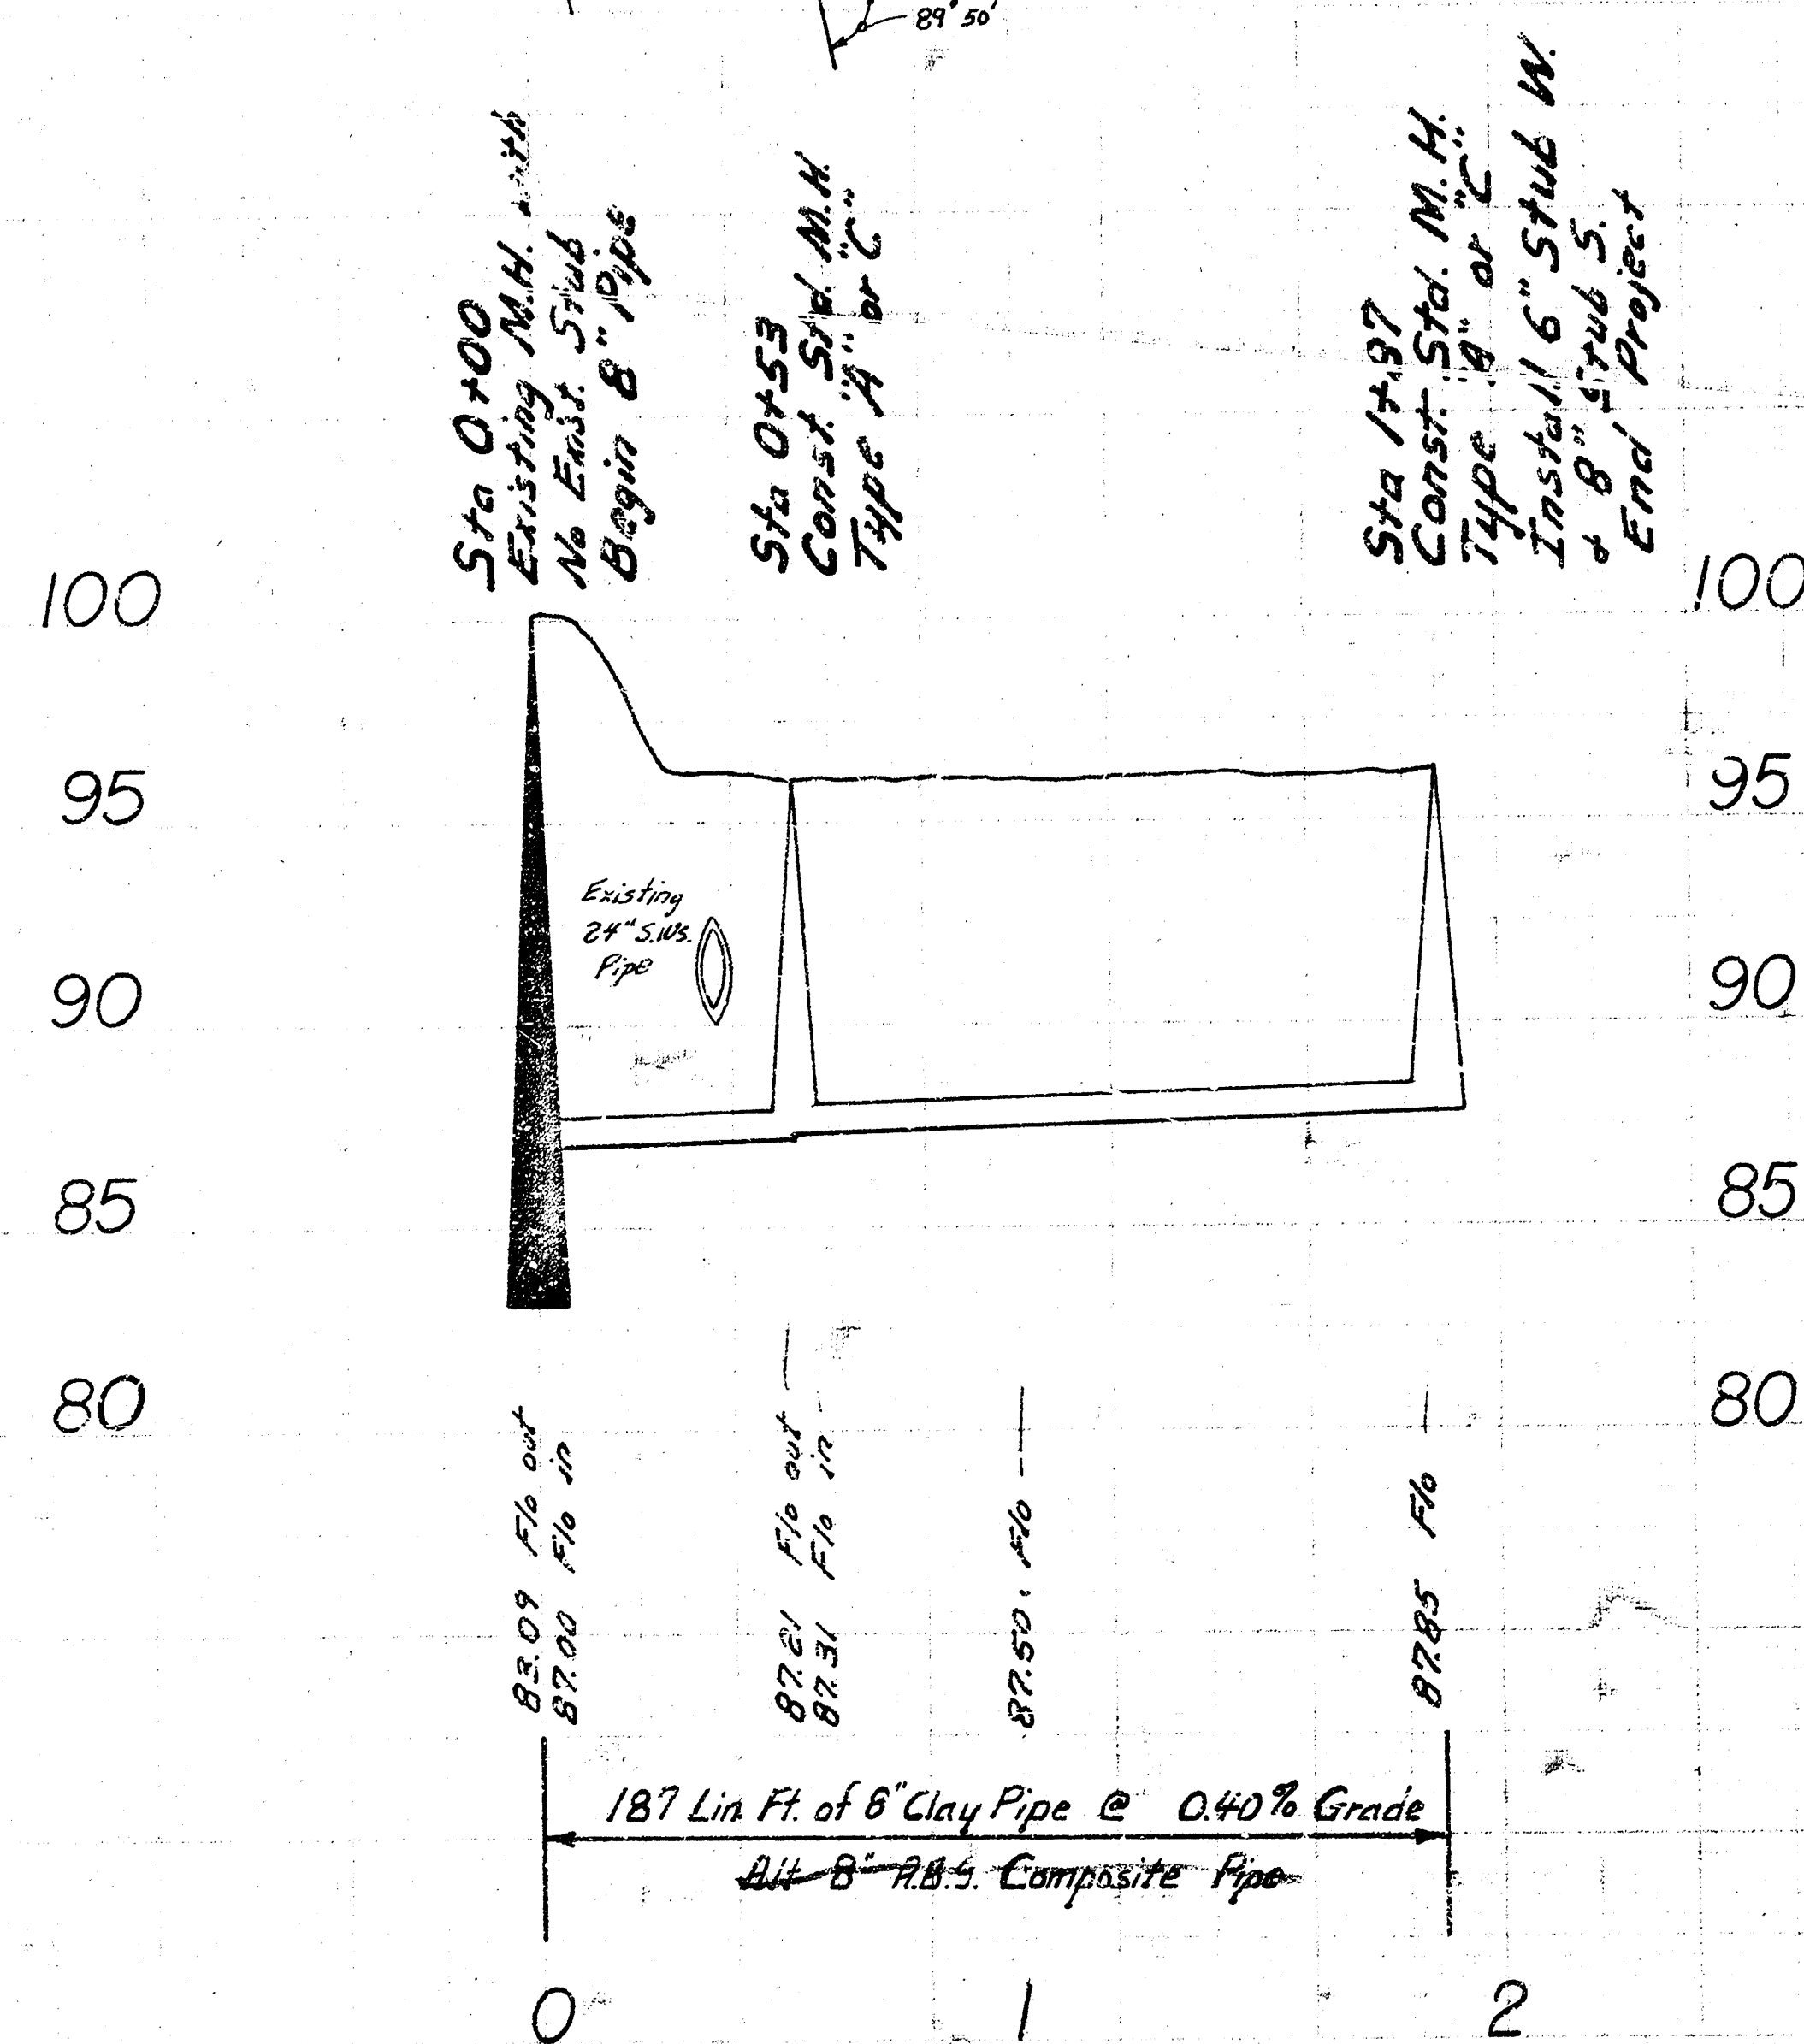

As built 6-28-78

LAT. 31 DIST. B S.S. NO. 20
CITY OF WICHITA, KS.
R. W. LINN CITY ENGINEER
Project No. 468 76 245 80505 000 000 001