

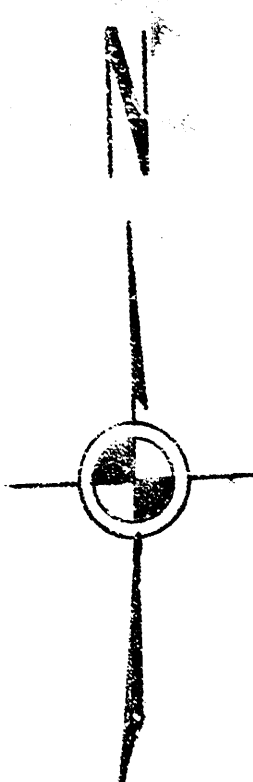





Plan Scale 1" = 20'
Profile Scale 1" = 20' Horiz.
1" = 3' Vert.

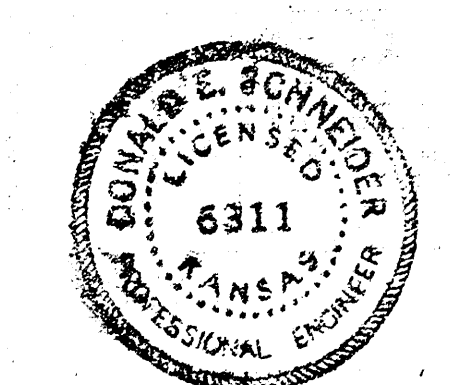



B. M. 102.19 iron in thimble @ Mt. Vernon Rd & K-15 Highway
B. M. 96.81 City Std. S.W. cor. Hydraulic & Mt. Vernon Rd (14" deep.)
B. M. 99.83 S.E. cor. Conc. Wk. in front of Liquor Store
N.W. Cor. Mt. Vernon Rd. & Hydraulic Ave.

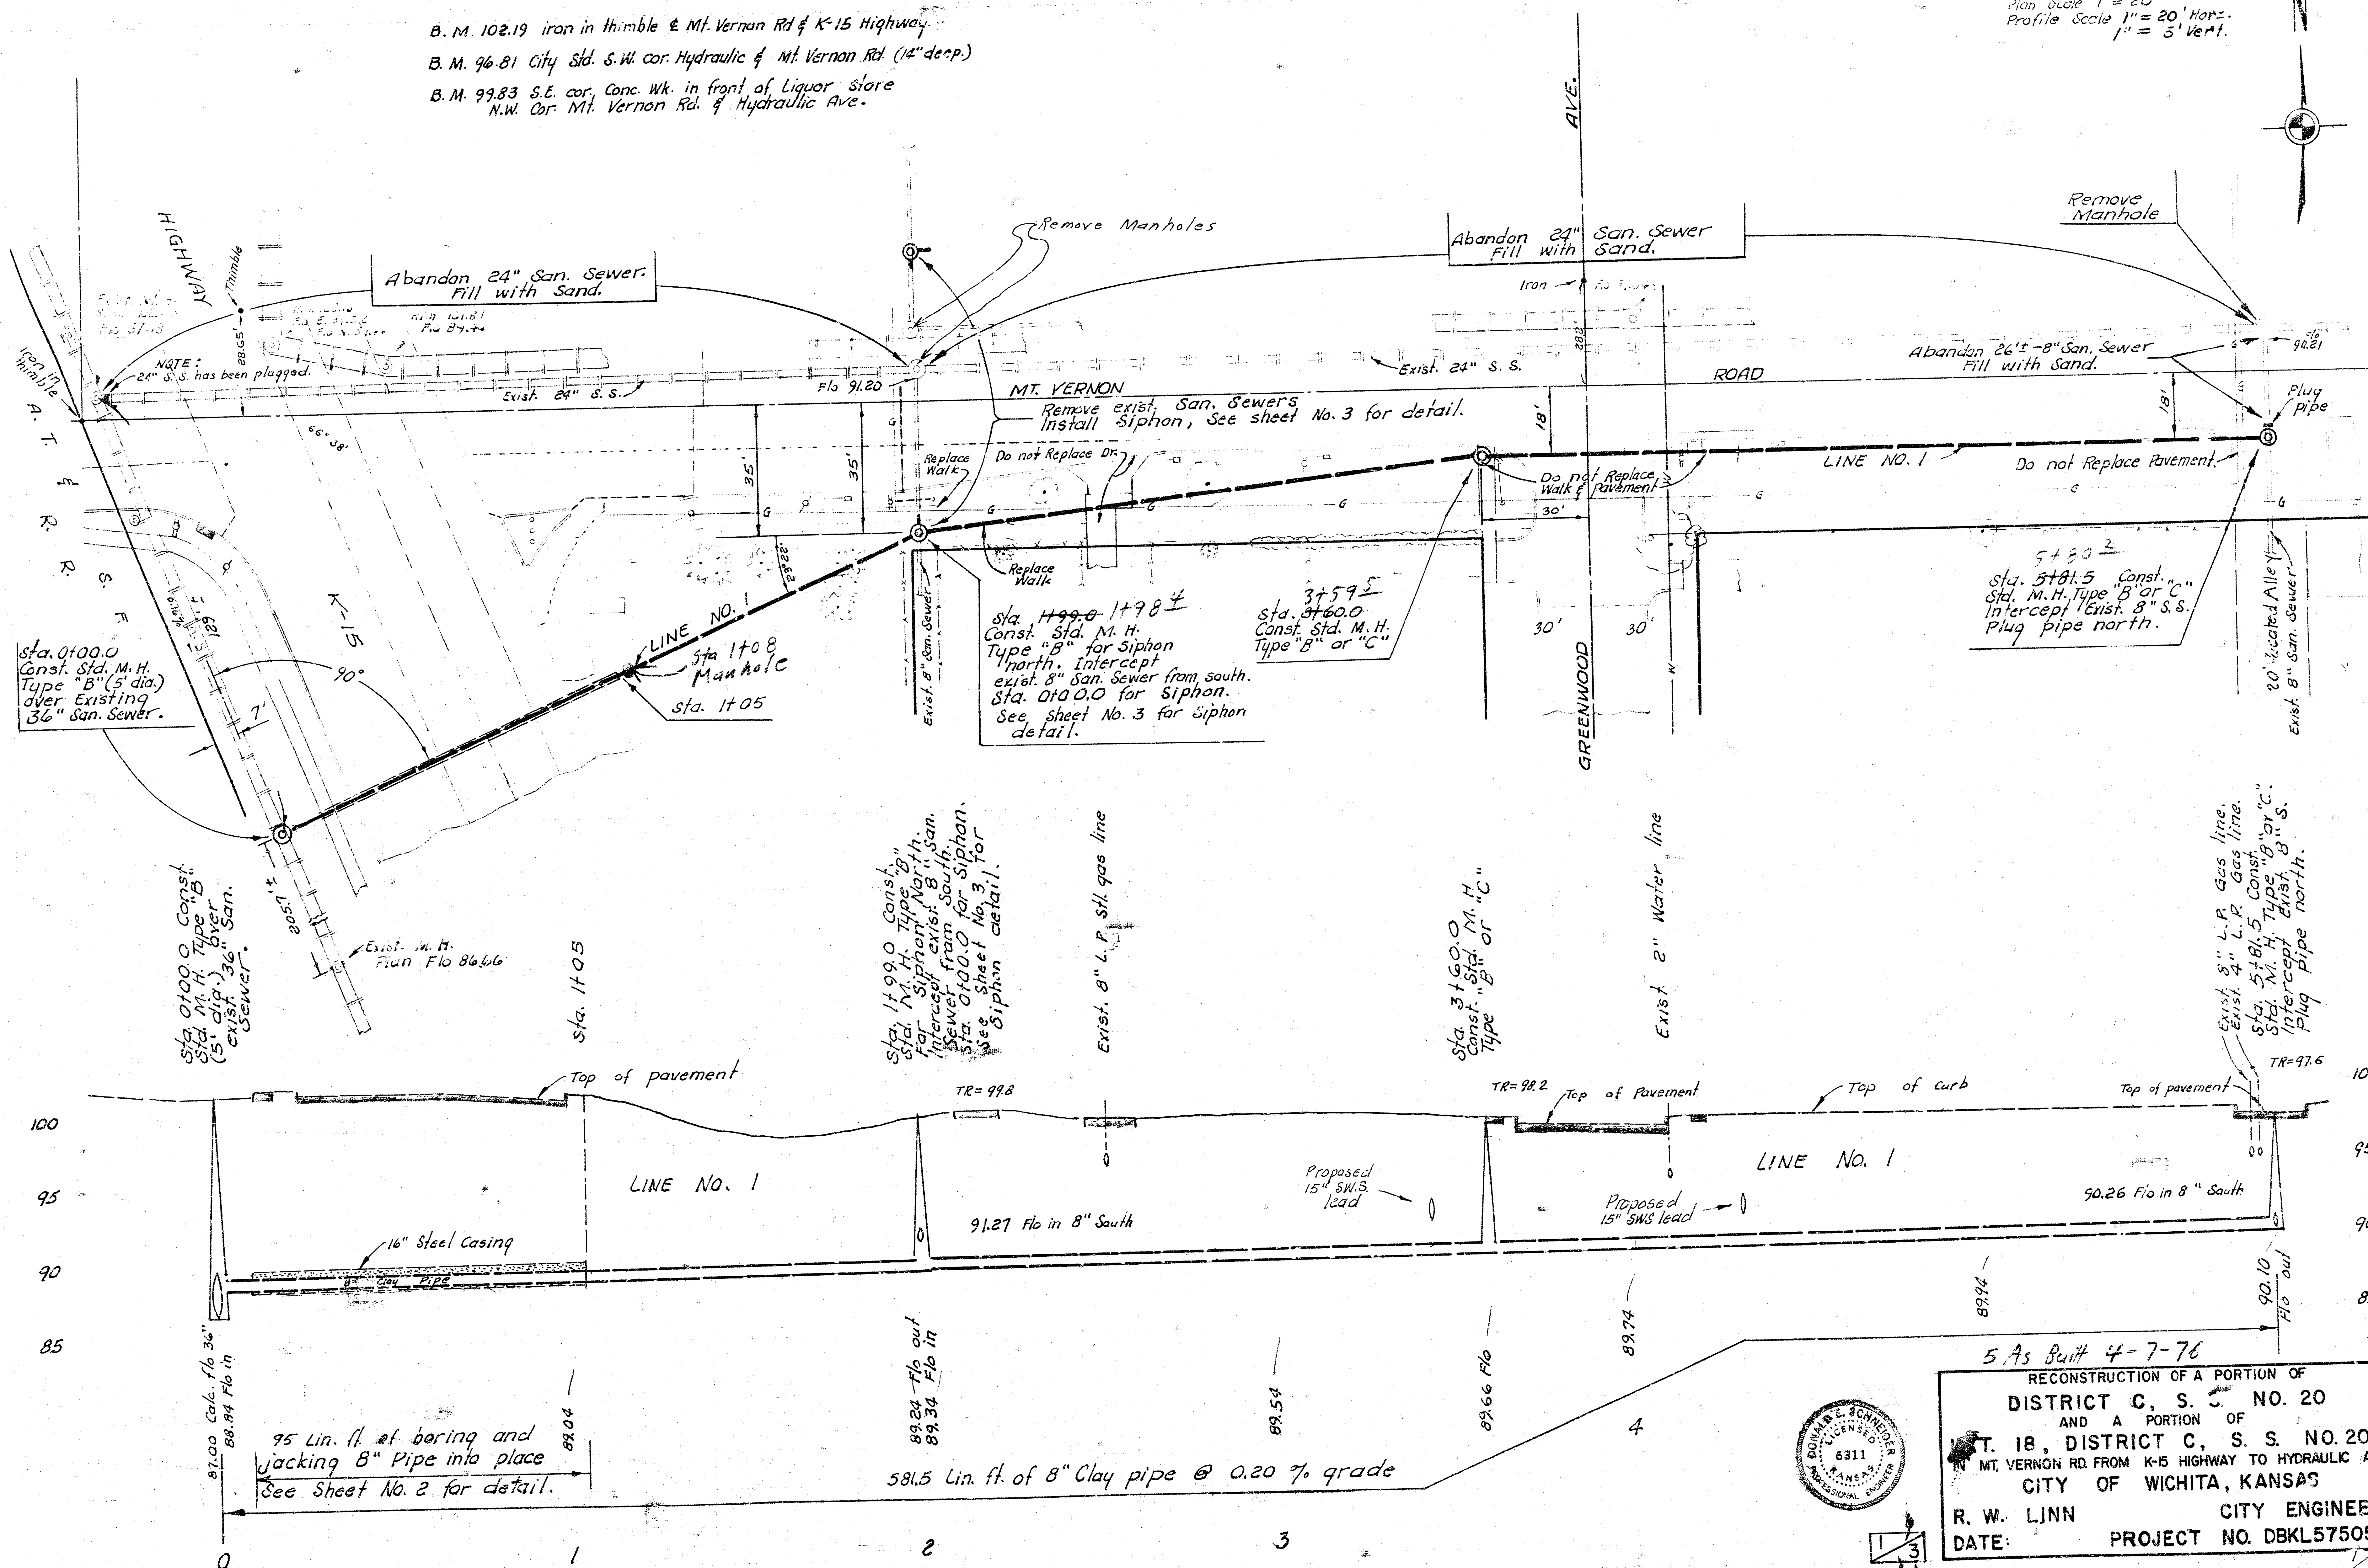

5 As Built 4-7-76
RECONSTRUCTION OF A PORTION OF
DISTRICT C, S. S. NO. 20
AND A PORTION OF
T. 18, DISTRICT C, S. S. NO. 20
MT. VERNON RD. FROM K-15 HIGHWAY TO HYDRAULIC AVE.
CITY OF WICHITA, KANSAS
R. W. LINN CITY ENGINEER
DATE: PROJECT NO. DBKL575059

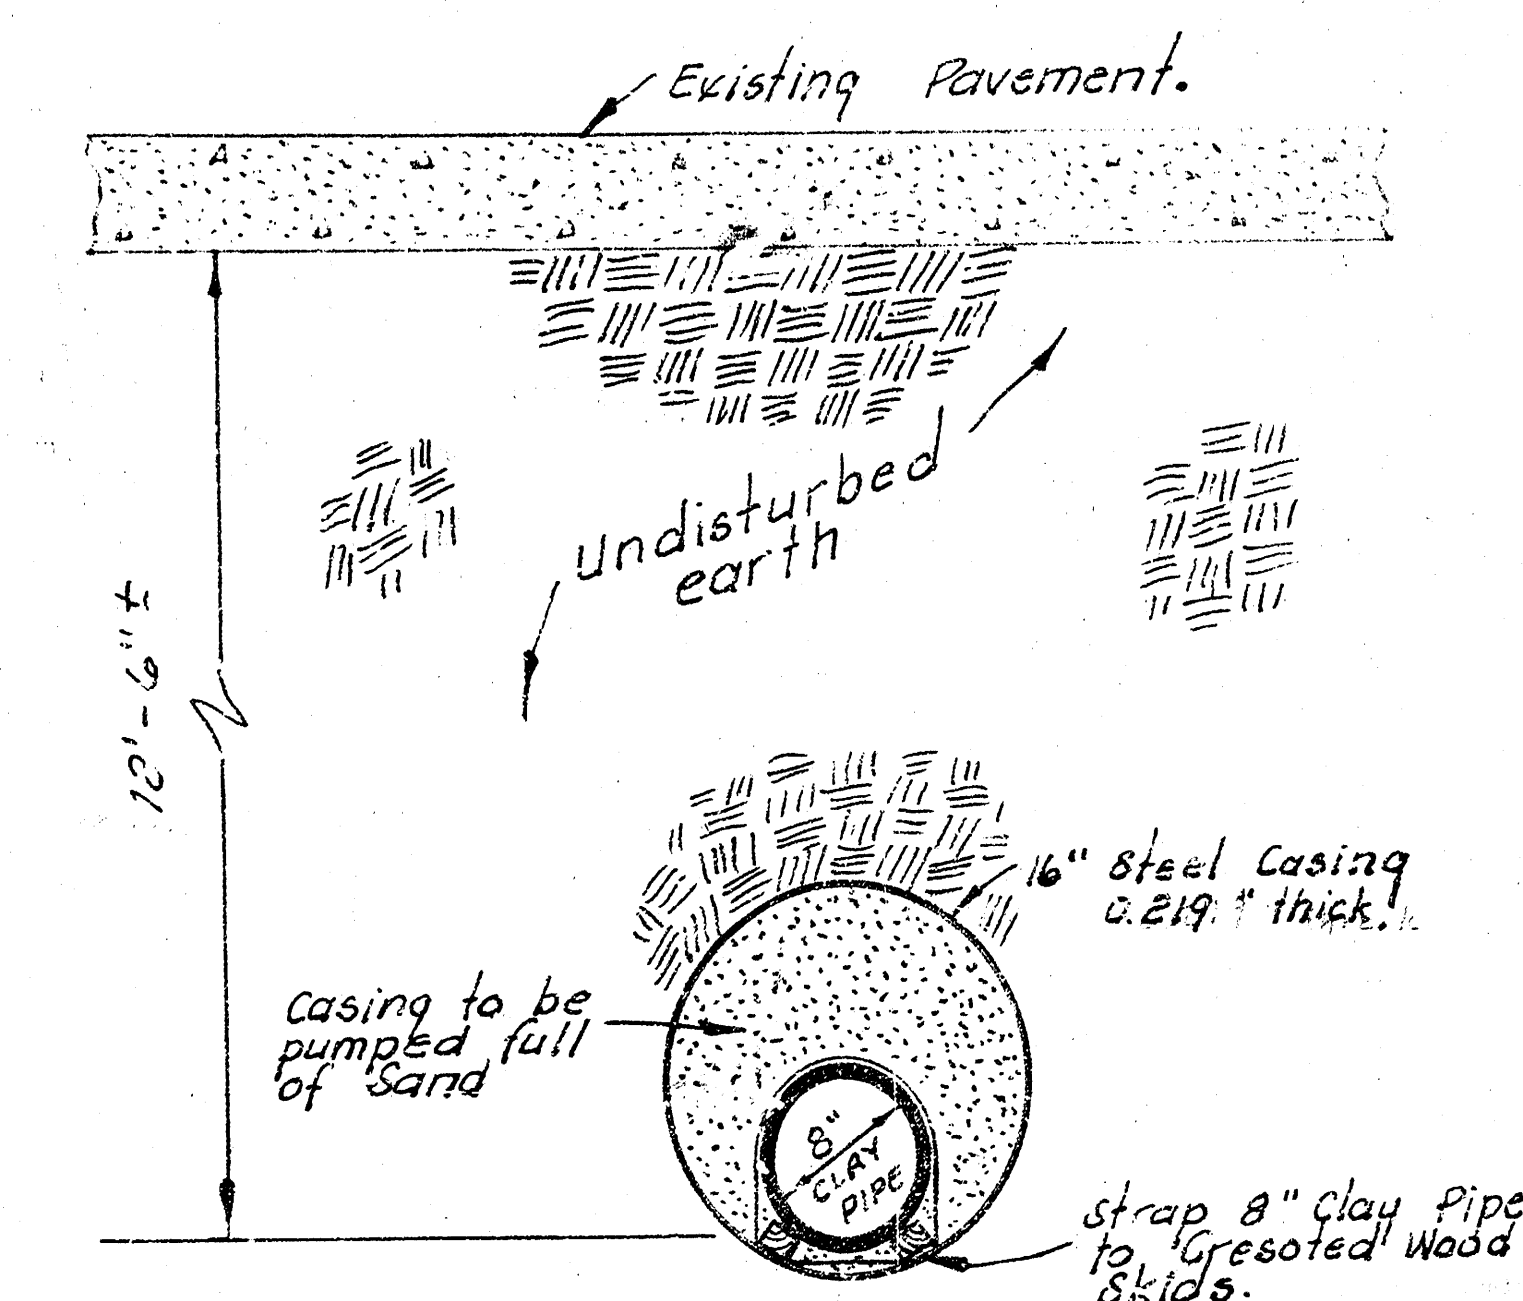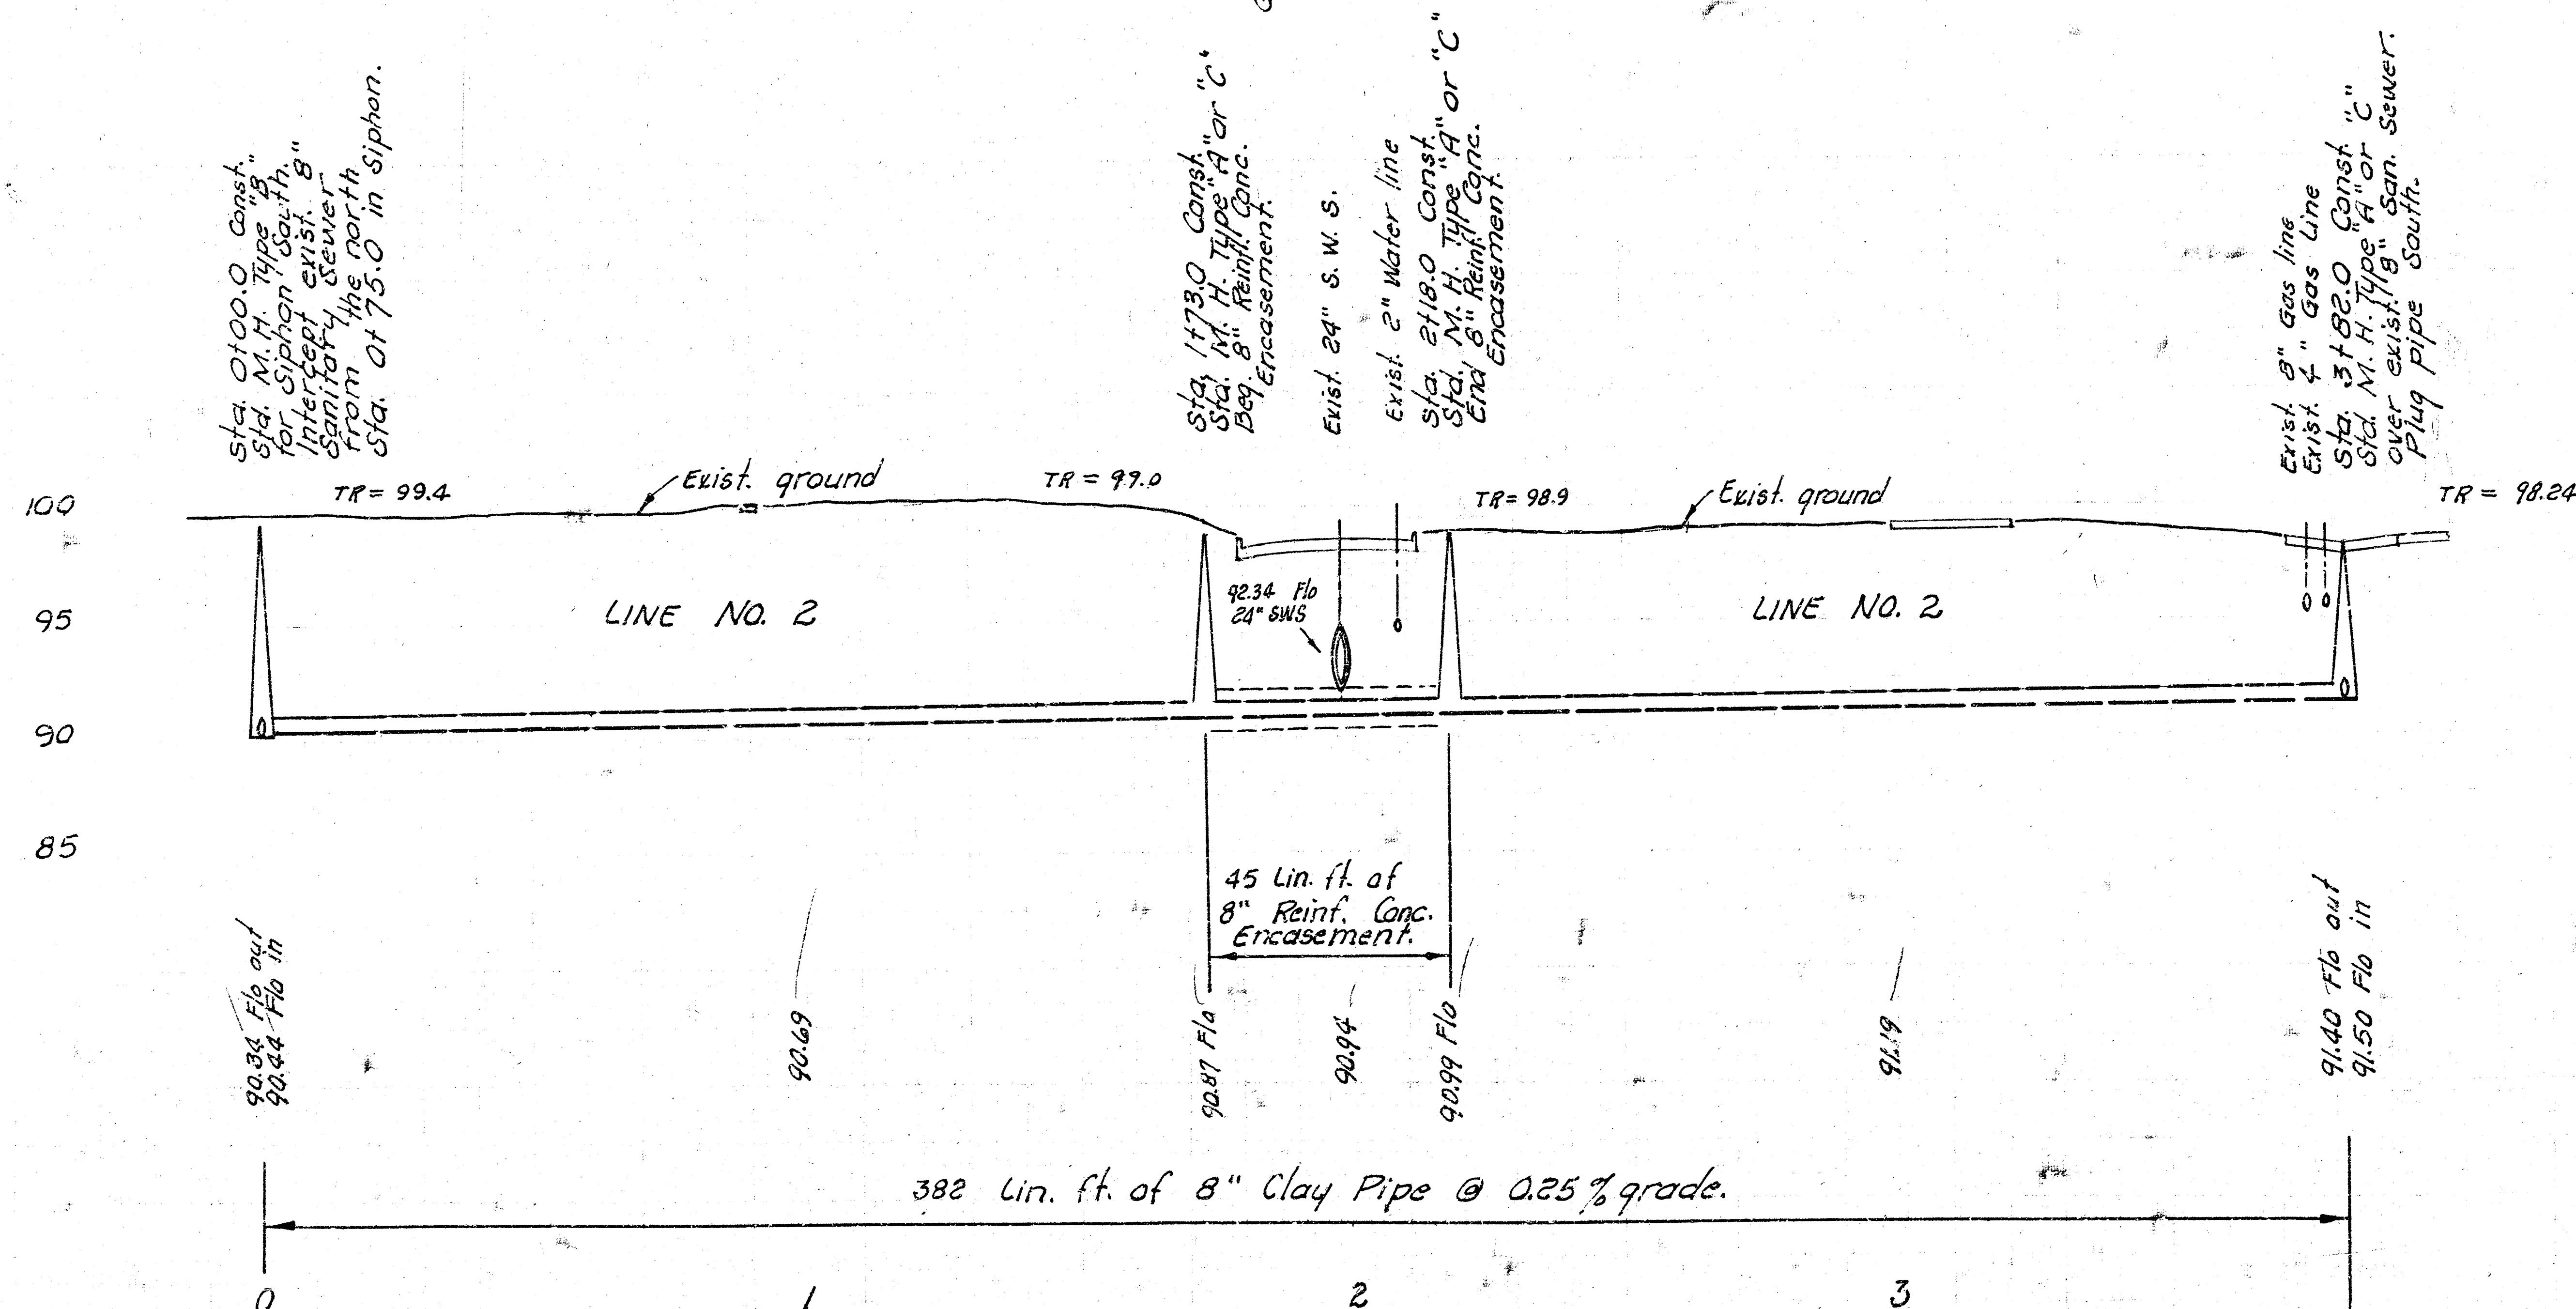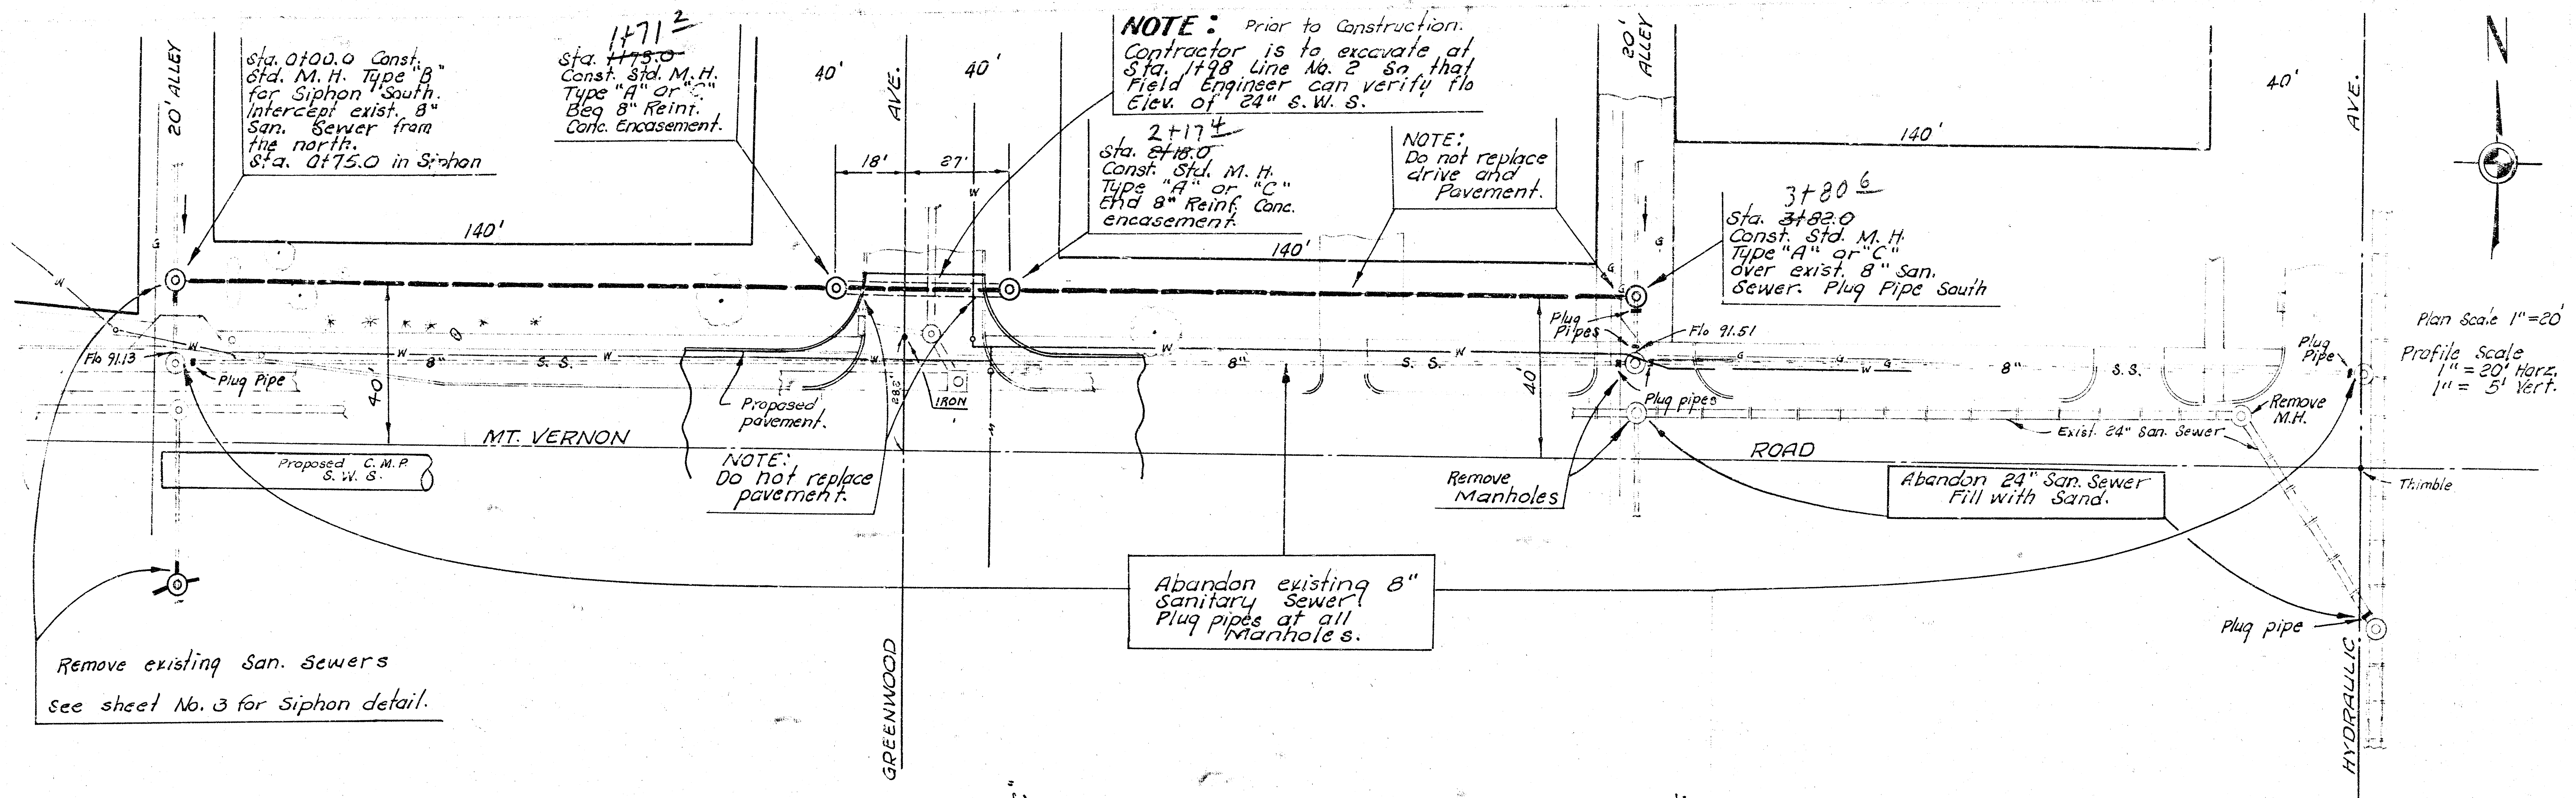

RECONSTRUCTION OF A PORTION OF
DISTRICT C, S. S. NO. 20
AND A PORTION OF
LAT 18, DISTRICT C, S. S. NO. 20
IN MT. VERNON RD. FROM K-15 HIGHWAY TO HYDRAULIC AVE.
PROJECT NO. DBKL575059

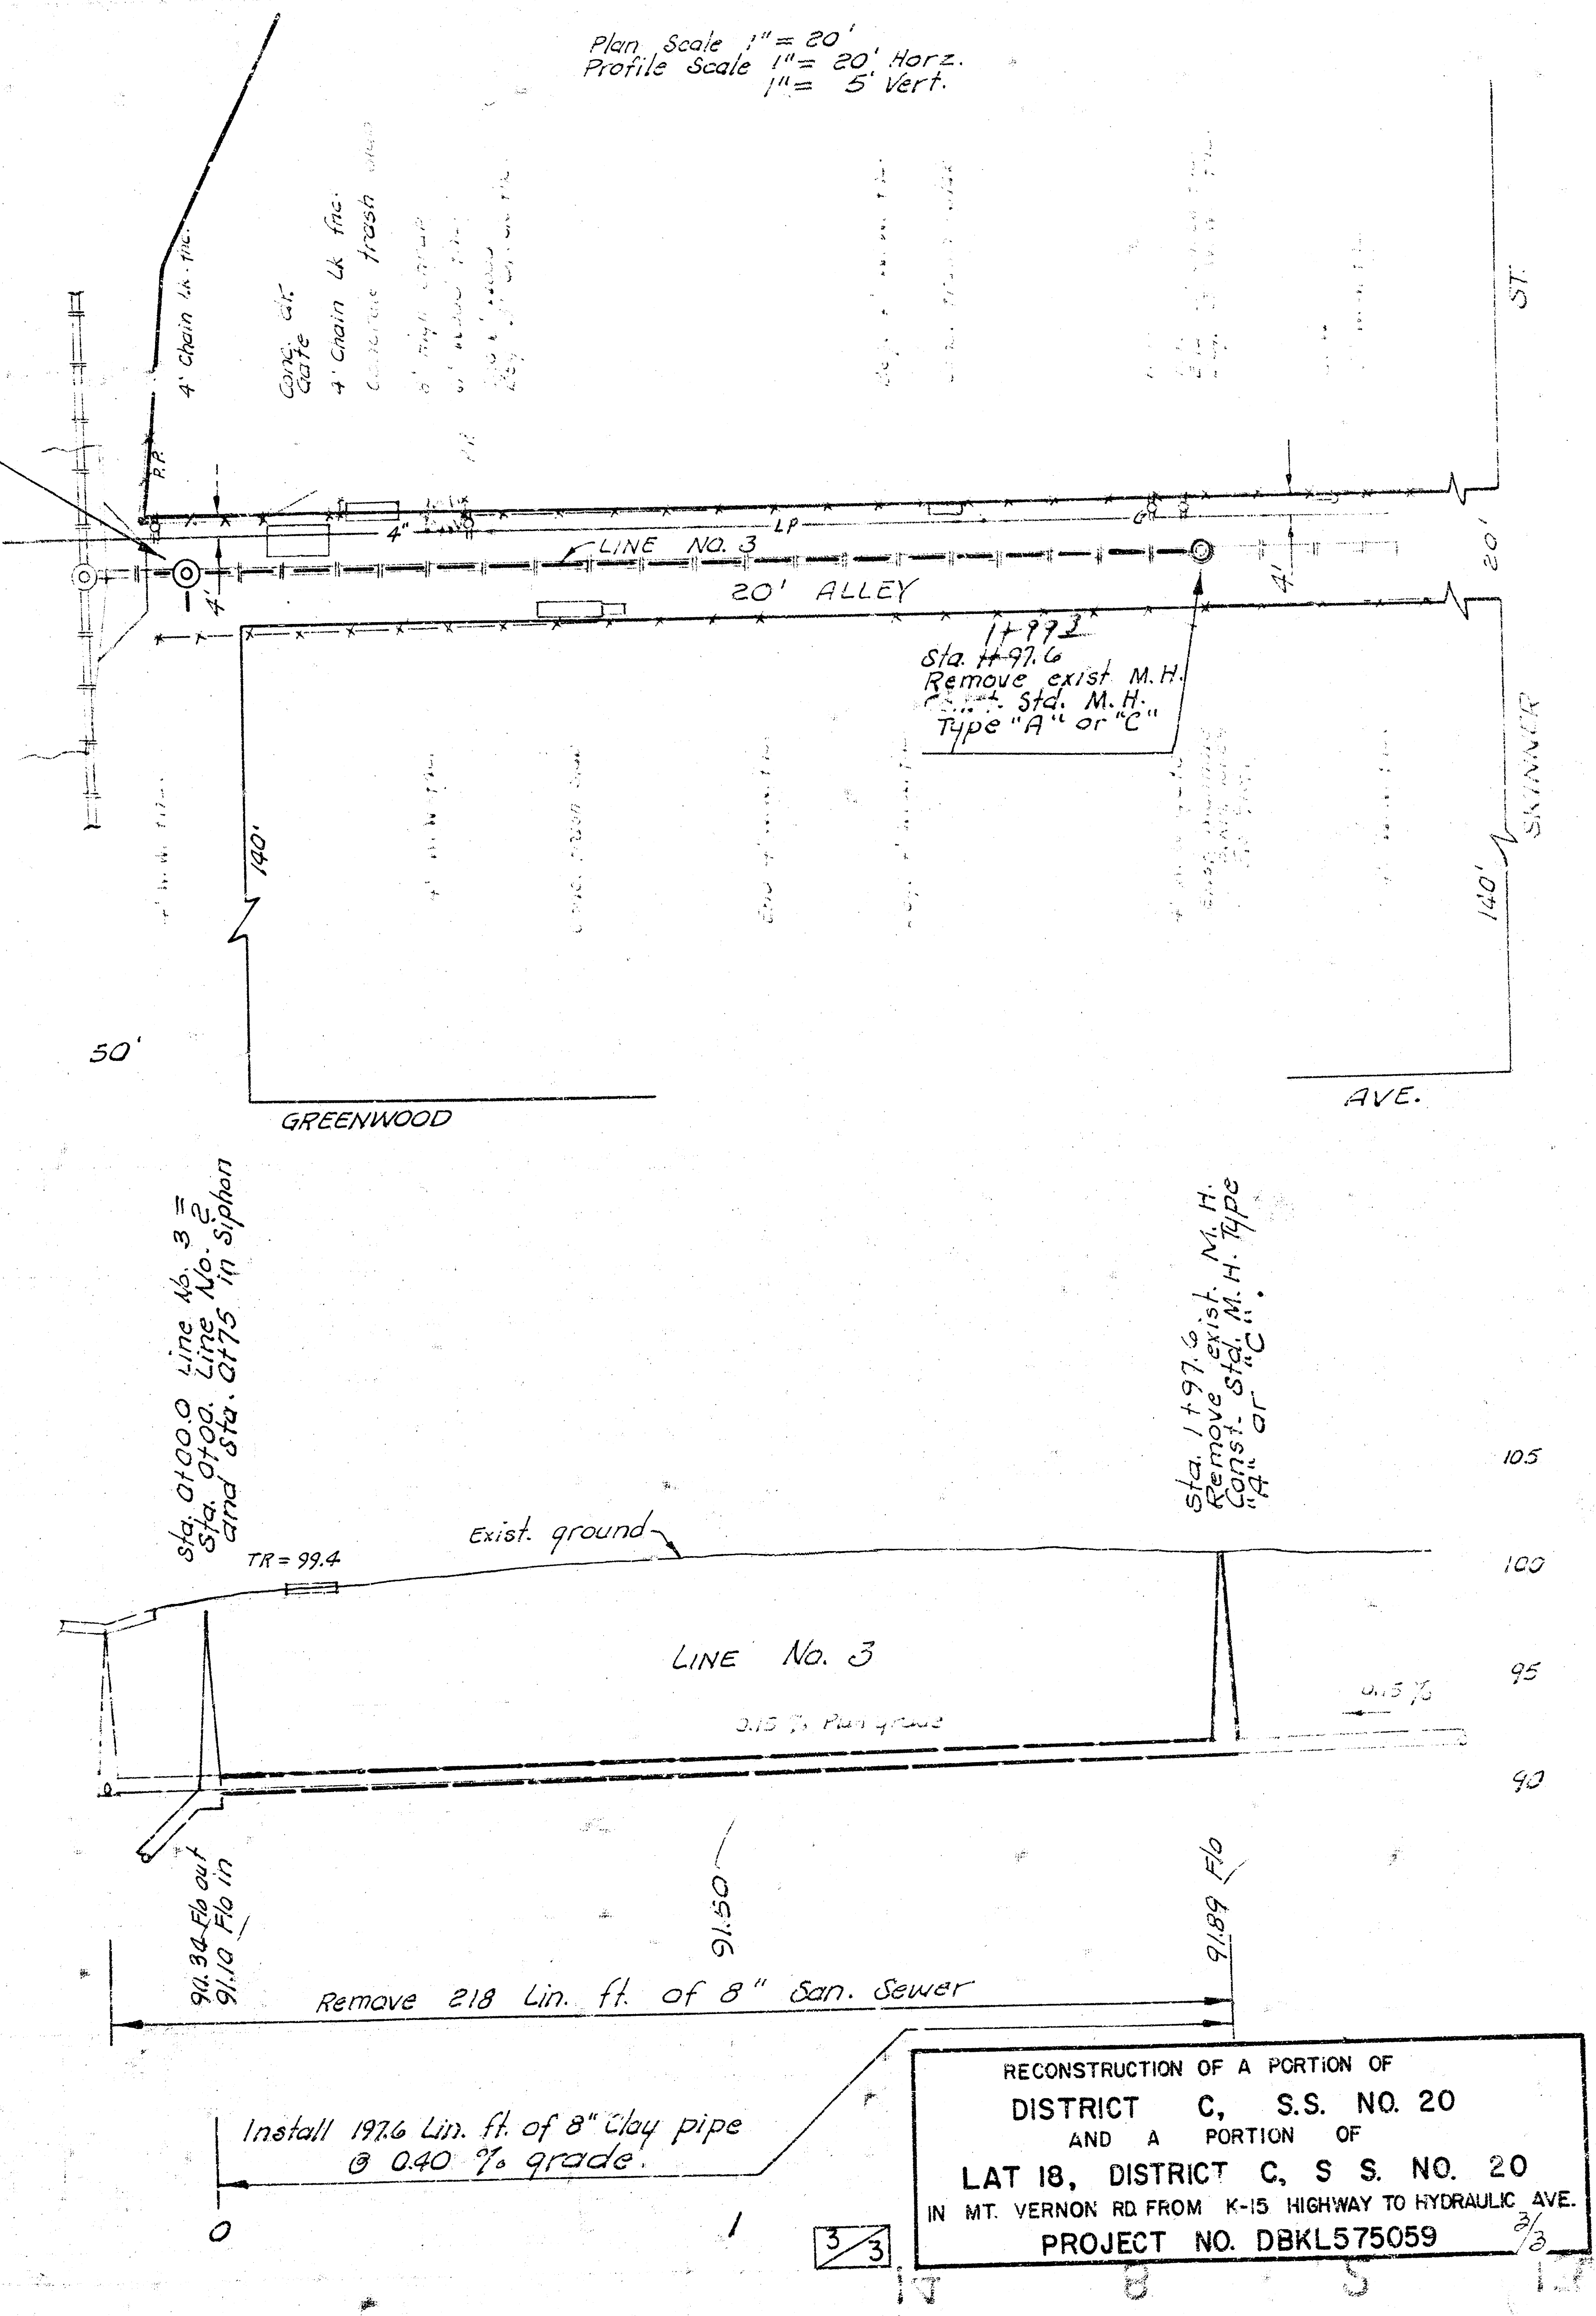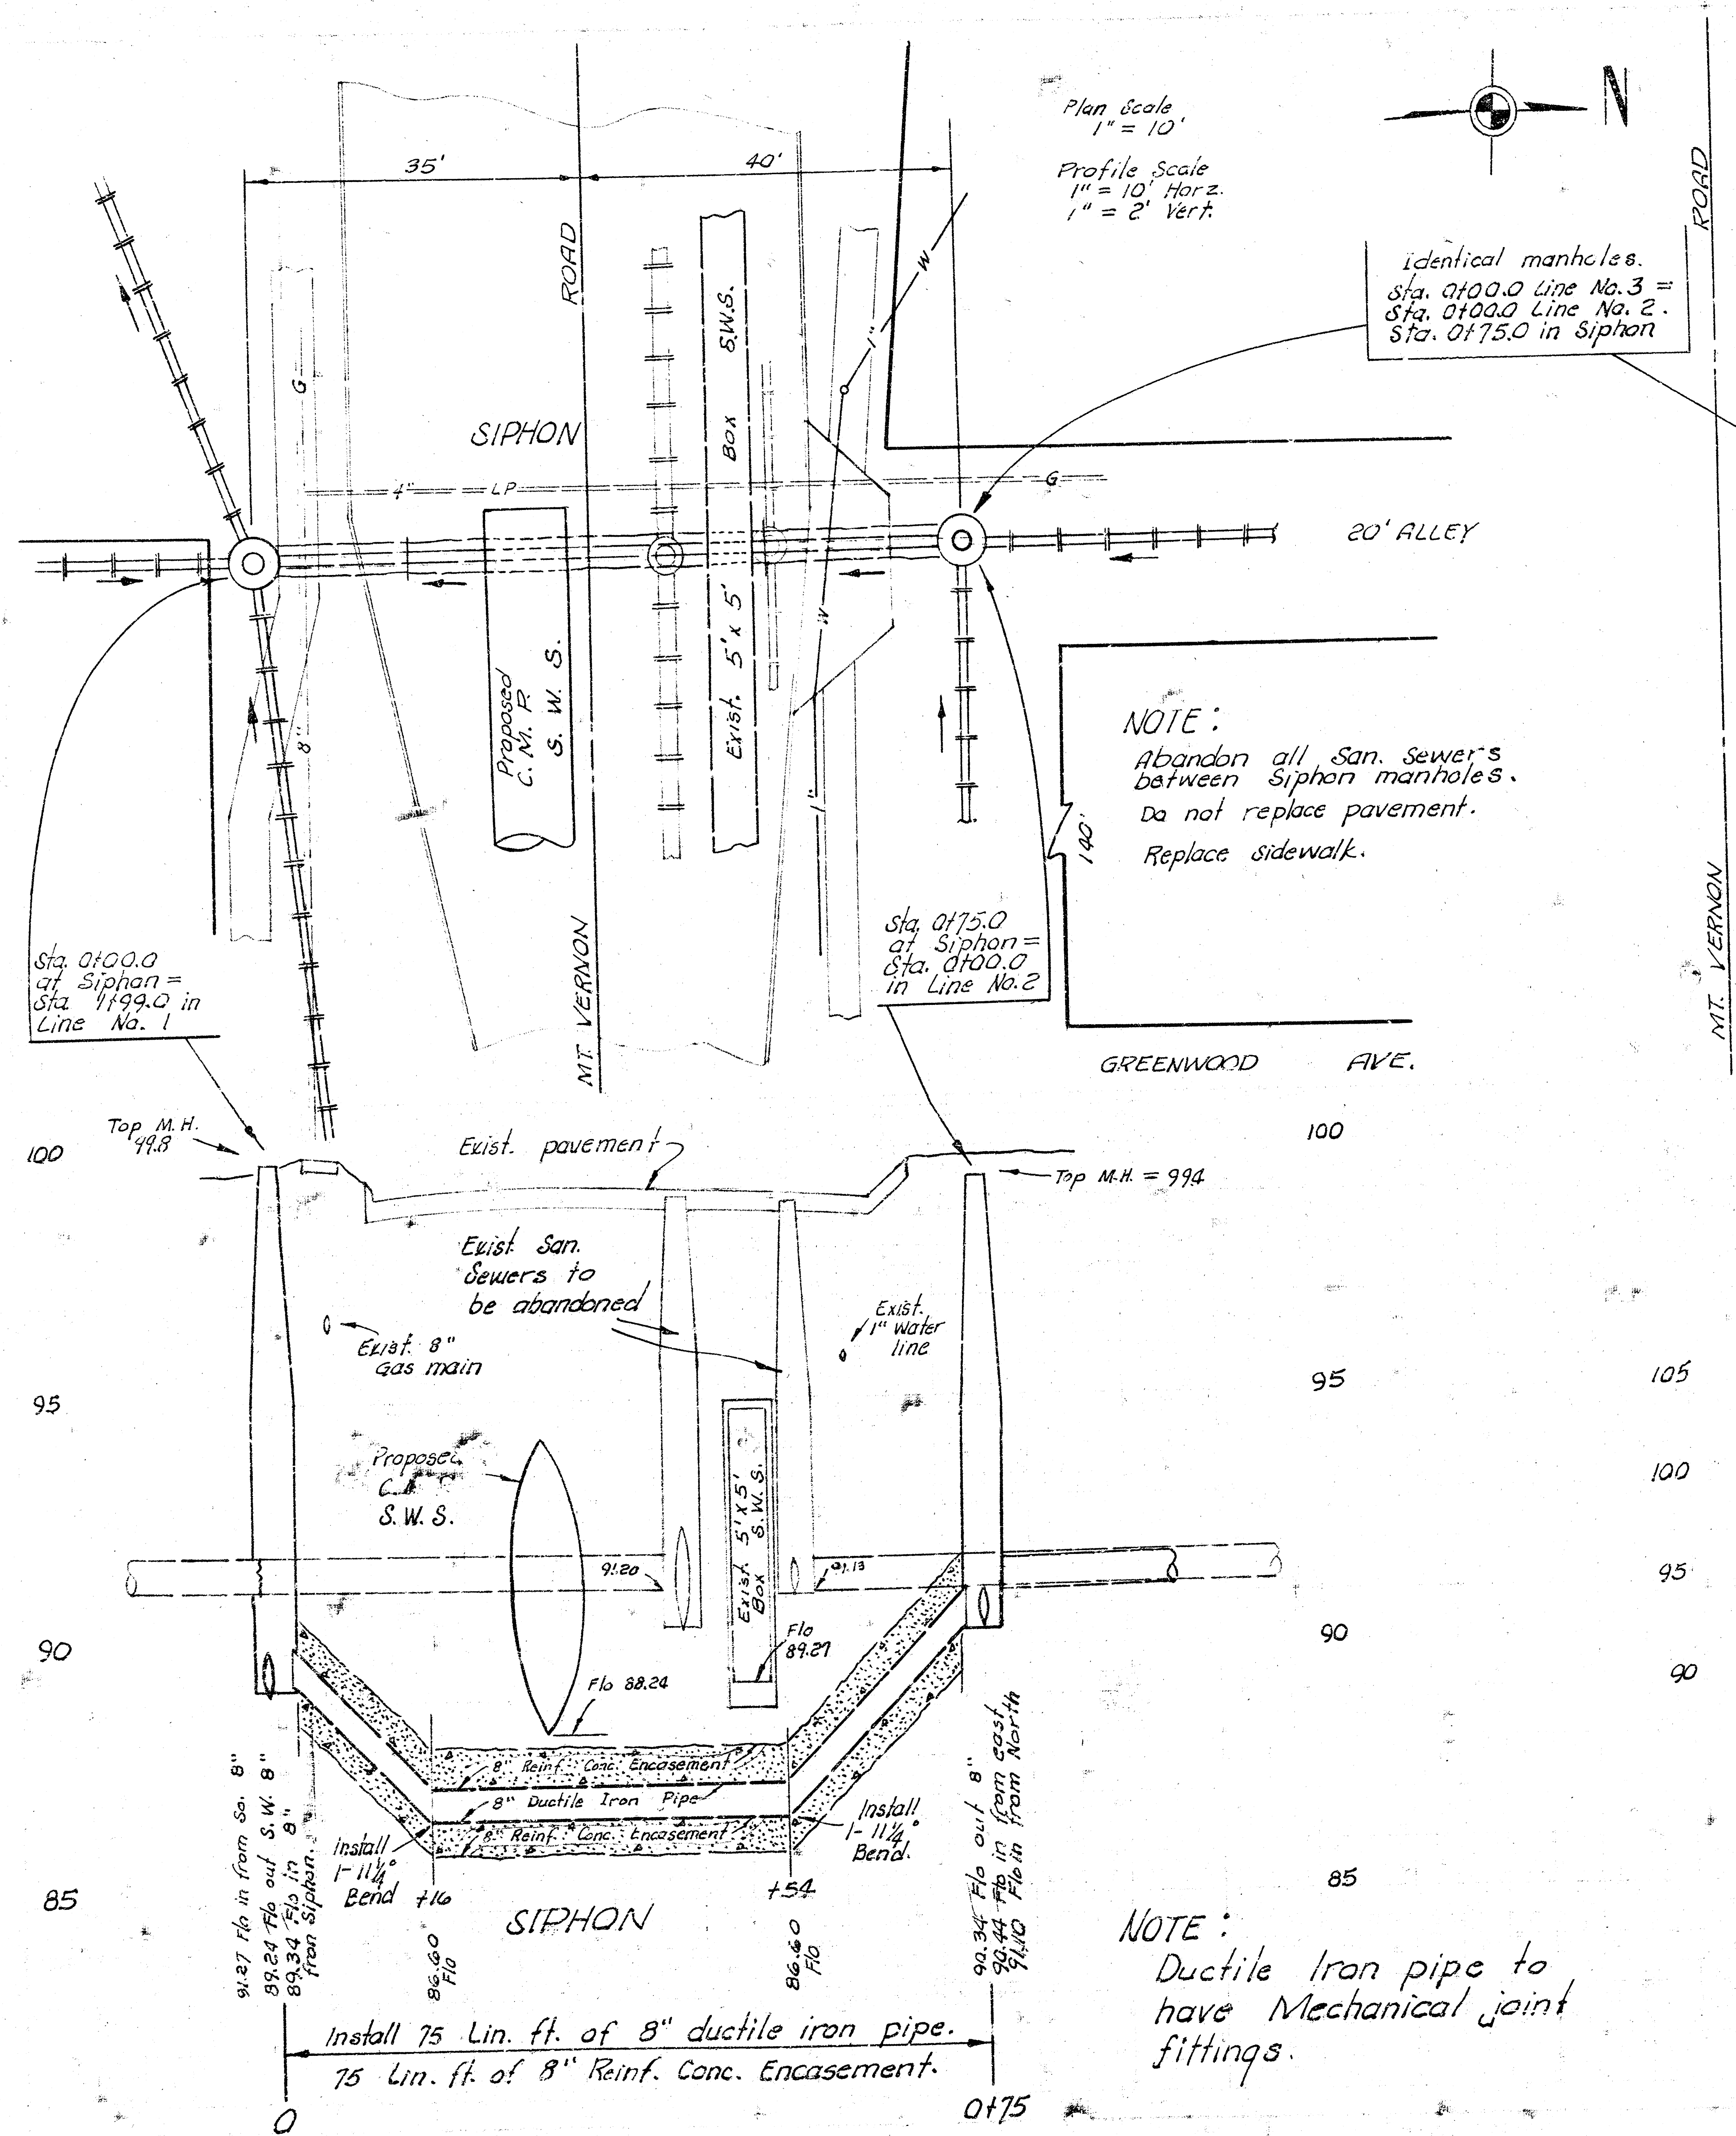

RECONSTRUCTION OF A PORTION OF
DISTRICT C, S.S. NO. 20
AND A PORTION OF
LAT 18, DISTRICT C, S.S. NO. 20
IN MT. VERNON RD FROM K-15 HIGHWAY TO HYDRAULIC AVE.
PROJECT NO. DBKL575059