




BM 105.44 R.R. Spike N. side P.P. S. side of Lewis, midway between Lulu & Ellis

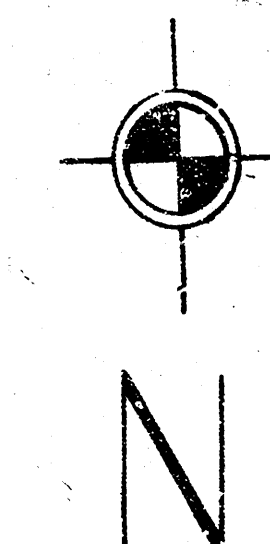


Plan Scale 1" = 20'
Profile Scale 1" = 20' Horiz
1" = 5' Vert

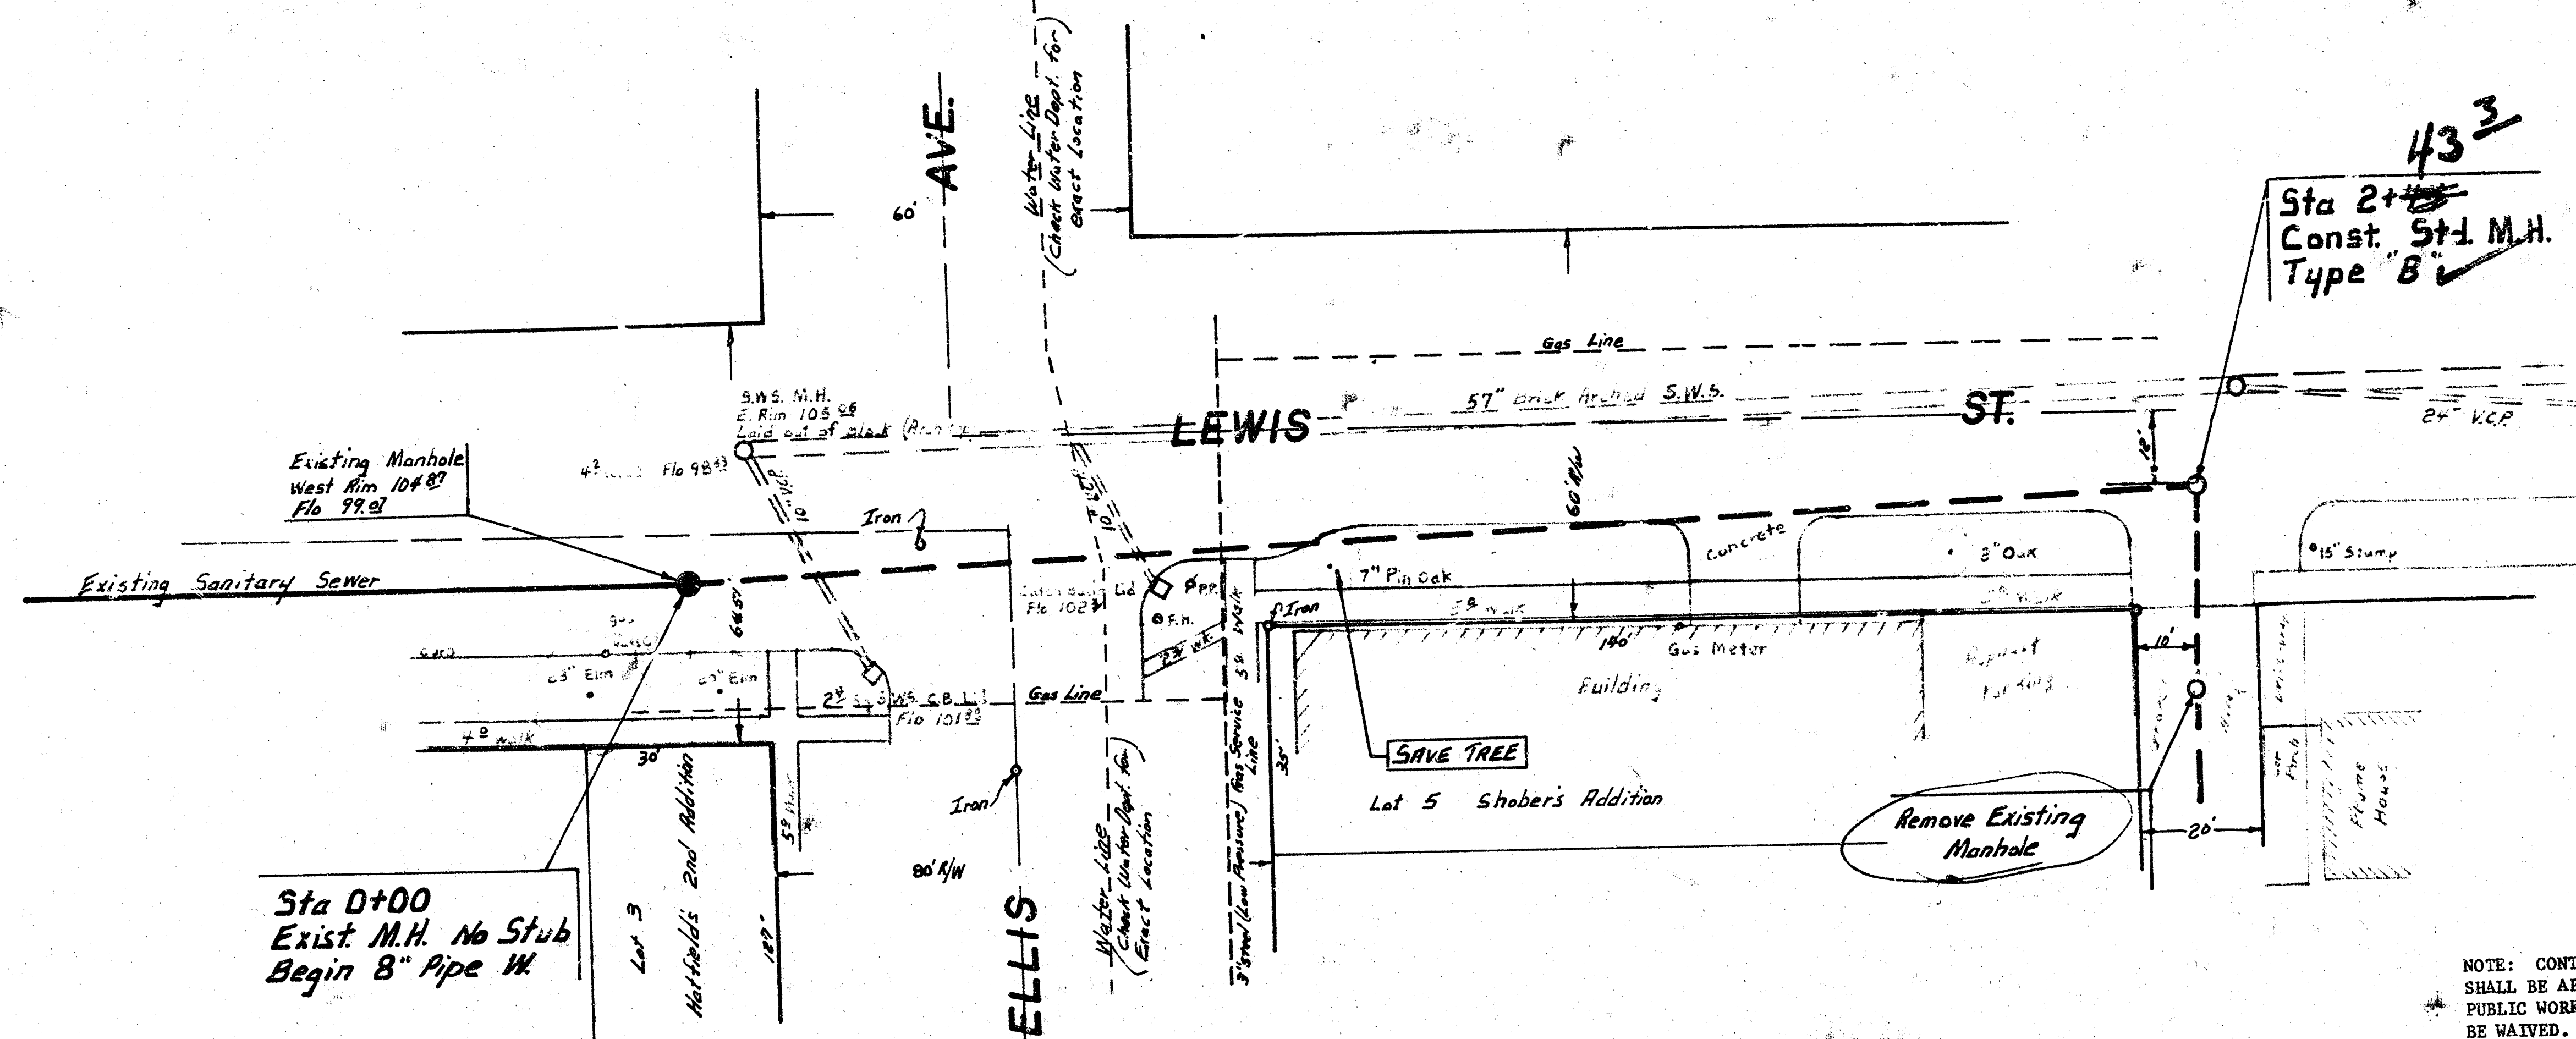

NOTE: CONTRACTOR'S METHOD FOR HANDLING SEWAGE FLOWS DURING CONSTRUCTION OF THIS PROJECT SHALL BE APPROVED BY THE ENGINEER. CONTRACTOR WILL BE REQUIRED TO OBTAIN PERMITS FROM PUBLIC WORKS ADMINISTRATION BEFORE RECONNECTING BUILDING SERVICE LINES. PERMIT FEE WILL BE WAIVED. BID ITEM FOR SERVICE CONNECTIONS SHALL COVER ALL COSTS FOR FURNISHING AND INSTALLING SADDLE INCLUDING TAPPING FEE. PIPE TAPS ARE TO BE MADE BY CITY MAINTENANCE DEPARTMENT PERSONNEL UNLESS APPROVED OTHERWISE BY THE ENGINEER. ONLY ACTIVE BUILDING SANITARY SEWER LINES ARE TO BE RECONNECTED TO THE NEW SEWER. CONTRACTOR SHALL VERIFY WHICH LINES ARE ACTIVE.

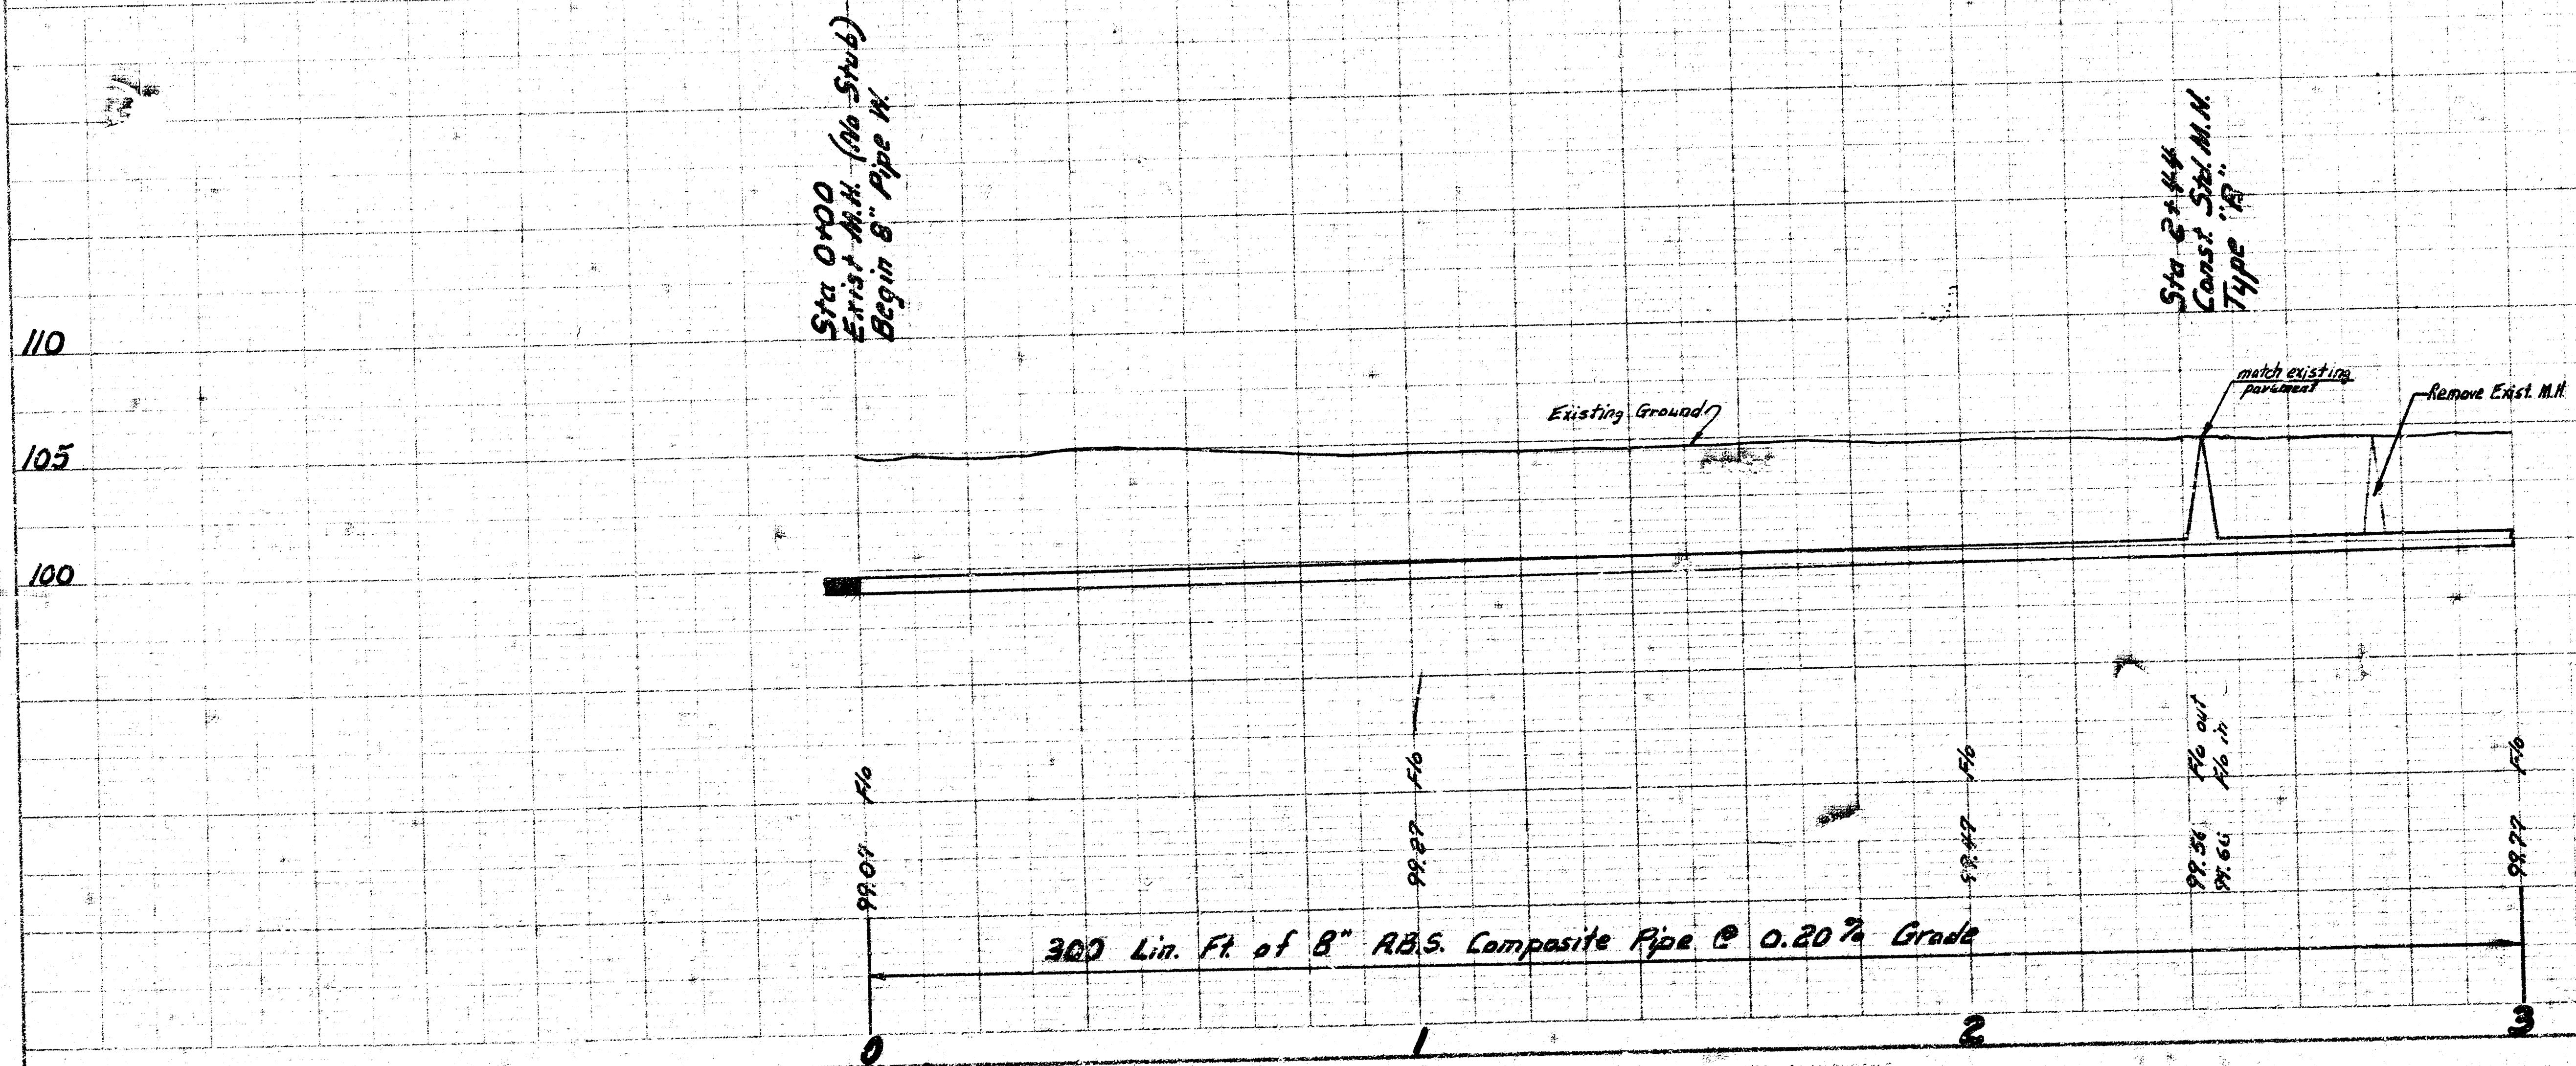


As Built
6/81

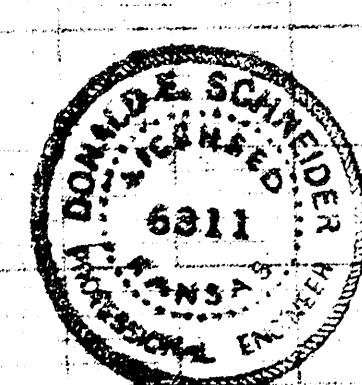


Reconstruction of a portion of Lateral 12, District Y,
Sanitary Sewer No. 20 in the Alley between Lulu and
Ellis from Lewis to Waterman.
City of Wichita, Ks.
R. W. Linn City Engineer
Project No. 576-80-245-50400-430-000-008

B.M. 107.65 R.R. Spike West Side of R.R. E.L. Alley South;
and S.L. of Hillou East & West South of
Waterman between Ellis & Lulu

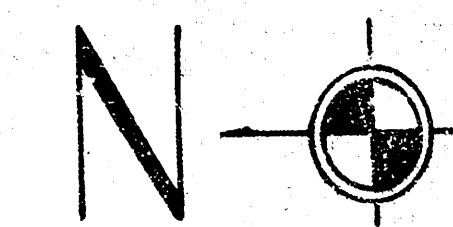


Plan Scale 1" = 20'
Profile Scale 1" = 20' Horiz.
1" = 5' Vert.

PLAN
NOTE BOOK
No.

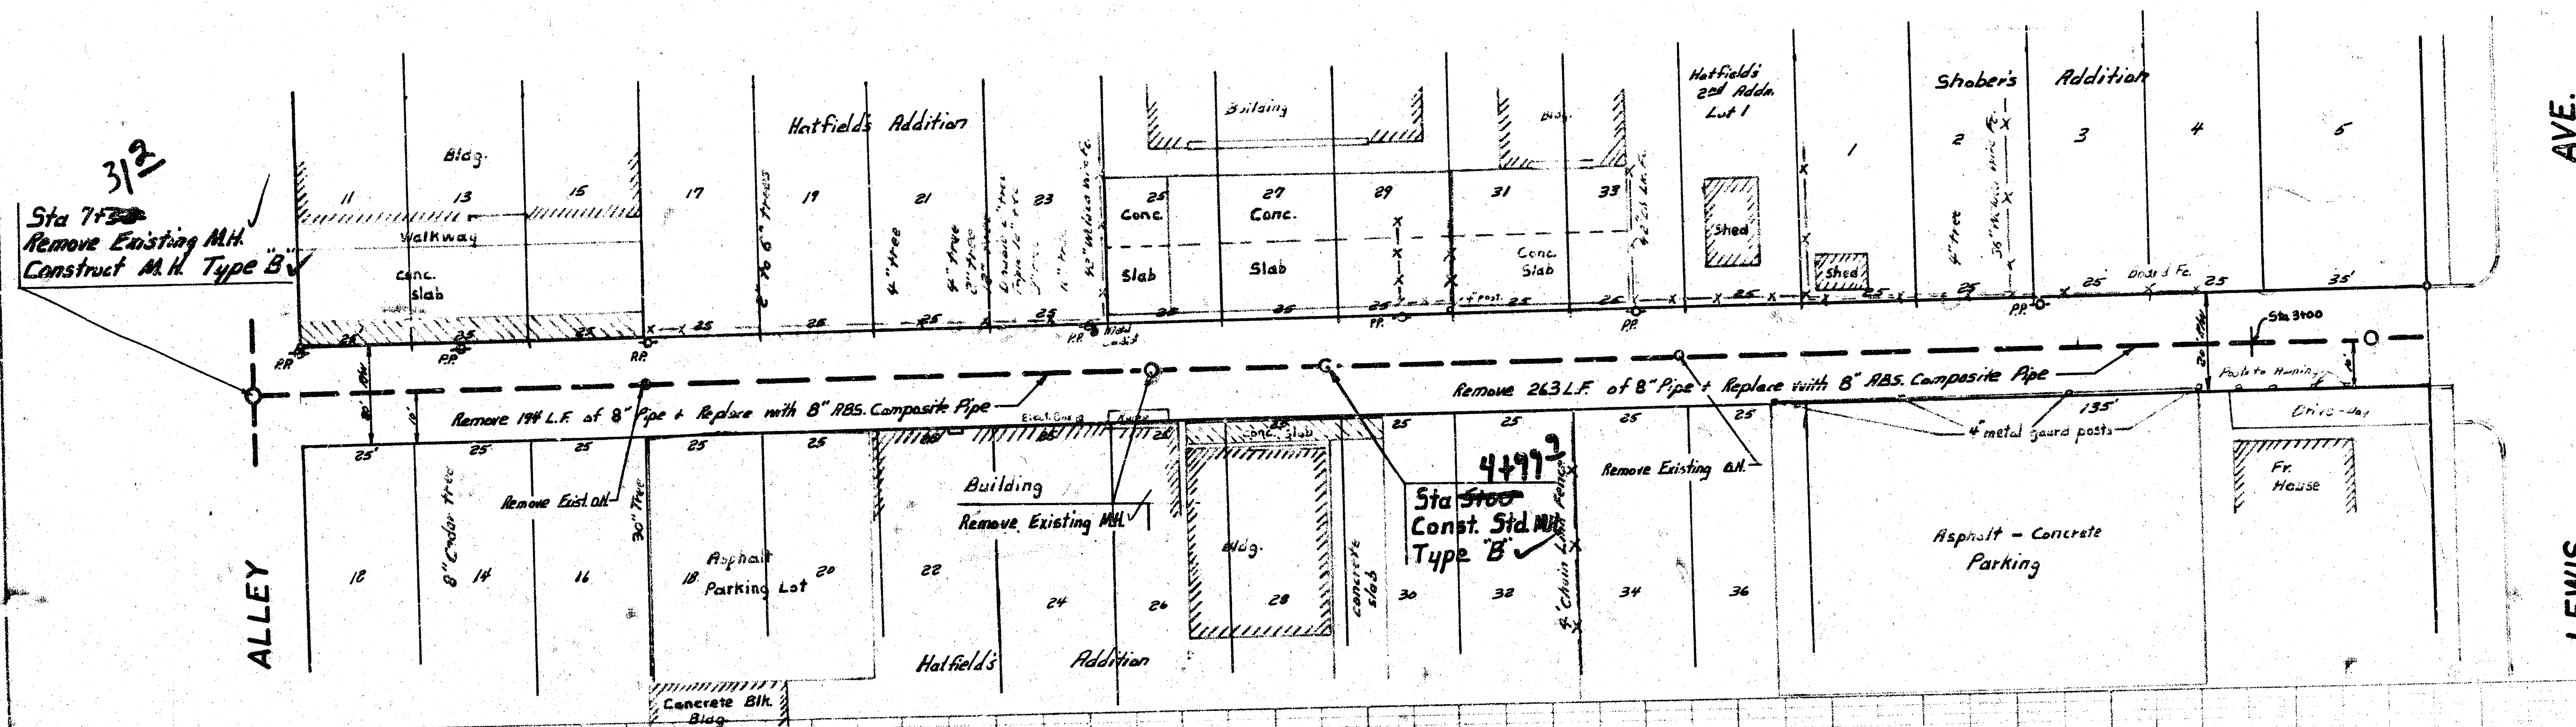

PROFILE
NOTE BOOK
No.

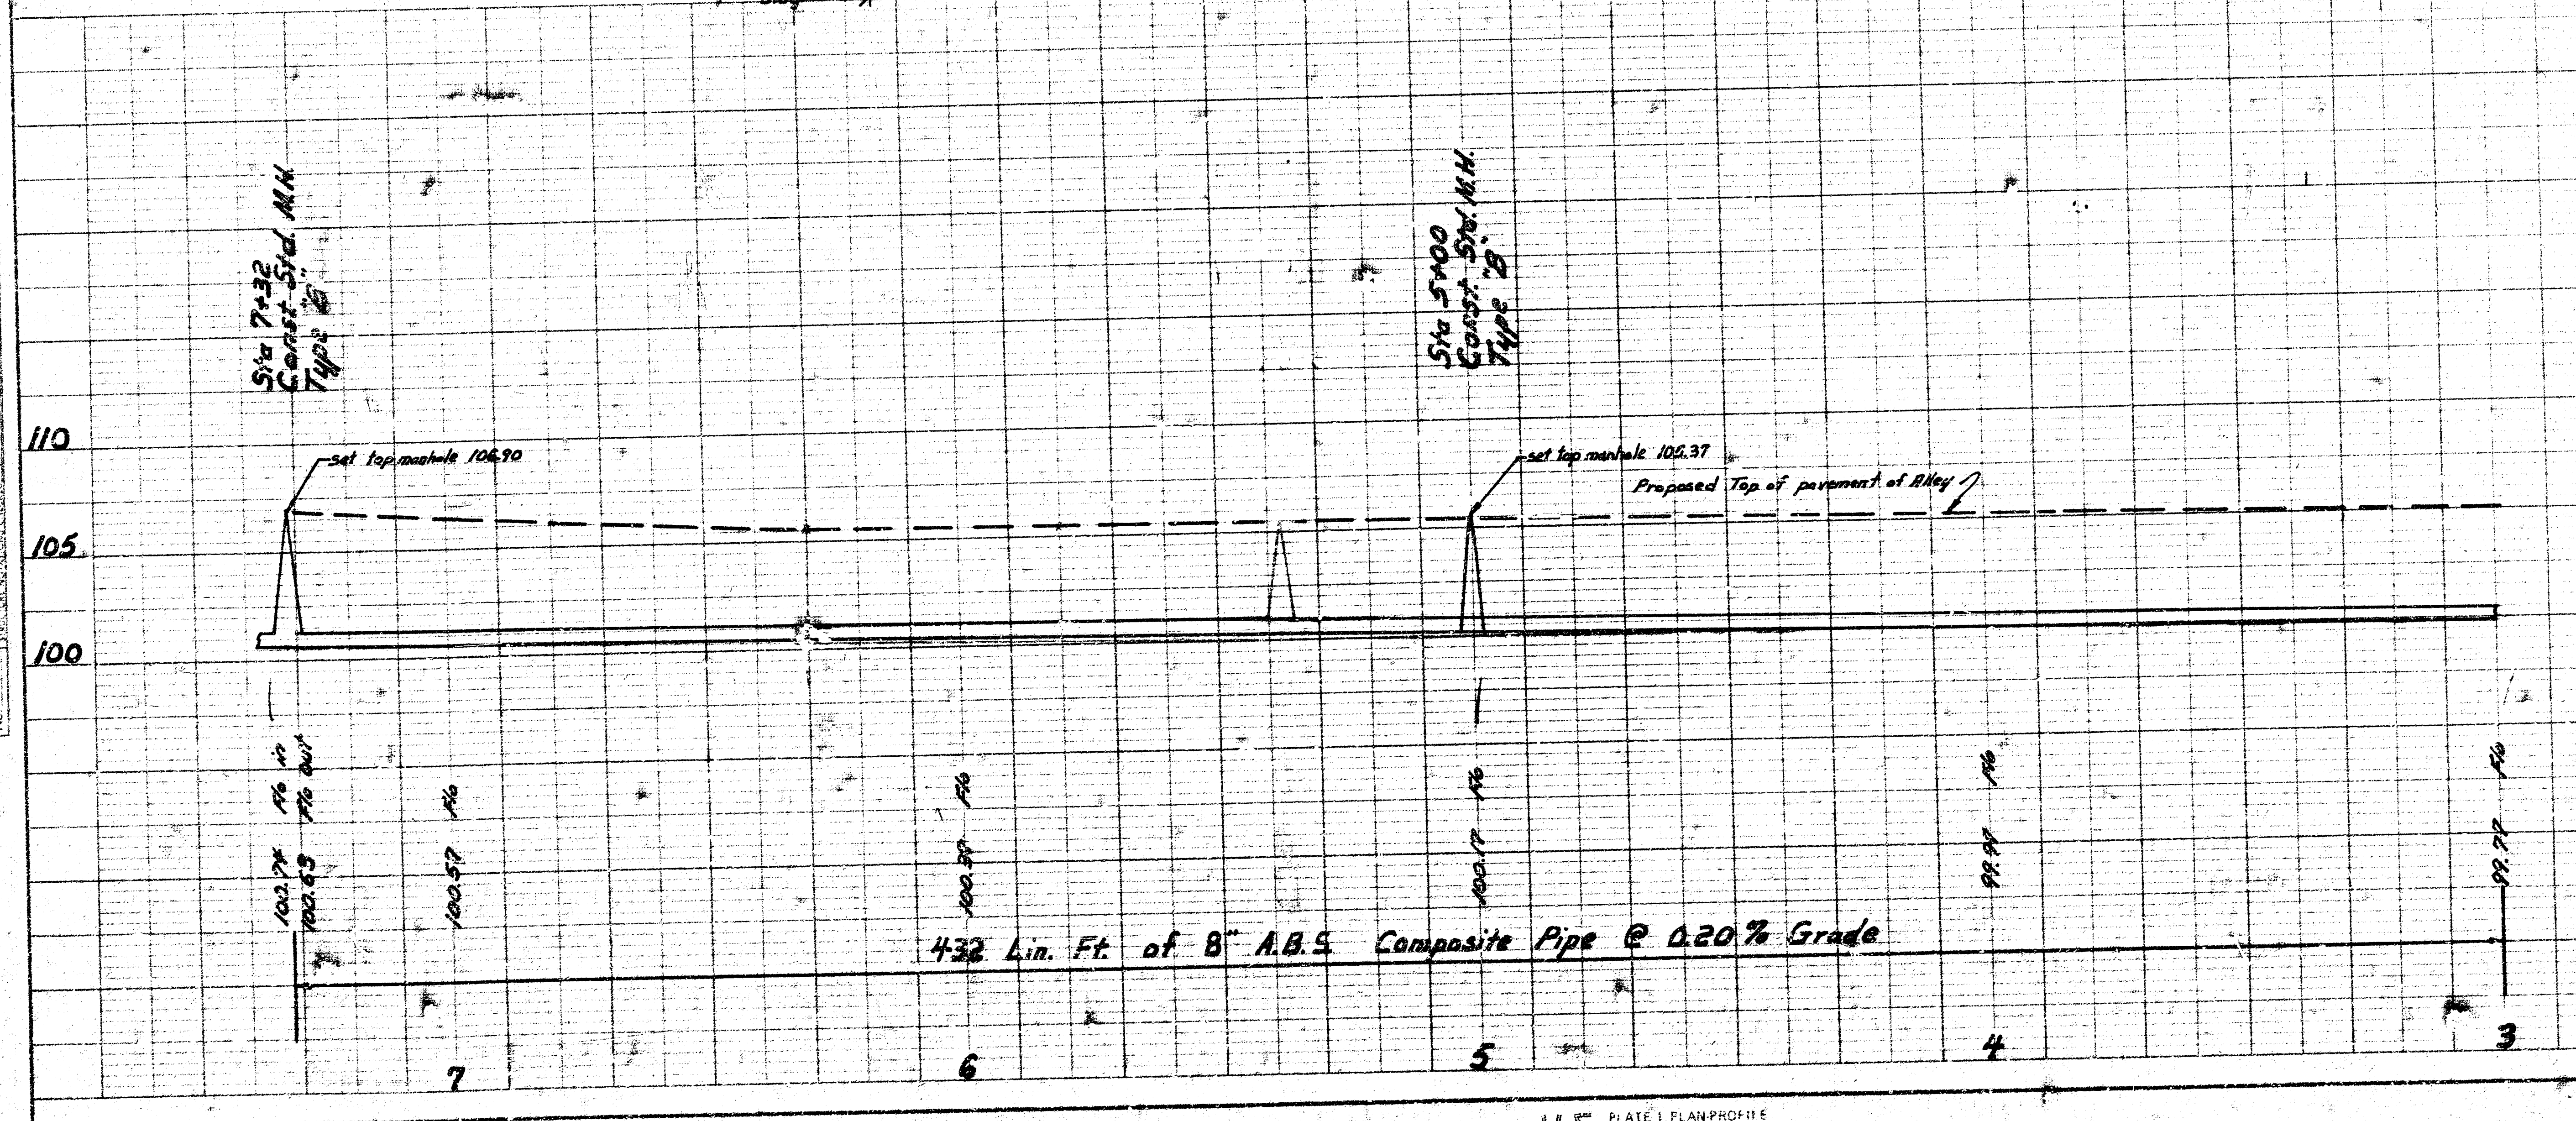

As Built
6/81
JLL



Reconstruction of a portion of Lateral 12, District Y,
Sanitary Sewer No. 20 in the Alley between Lulu and
Ellis from Lewis to Waterman.
City of Wichita, Ks.
R. W. Linn City Engineer
Project No. 976-80-245 - 50400 - 430-000-002

Sheet 2 of 3



Plan Scale 1" = 20'

Profile Scale 1" = 20' Horiz.
1" = 5' Vert.

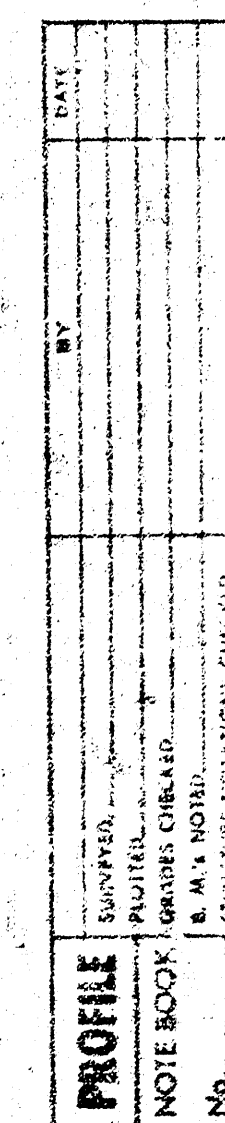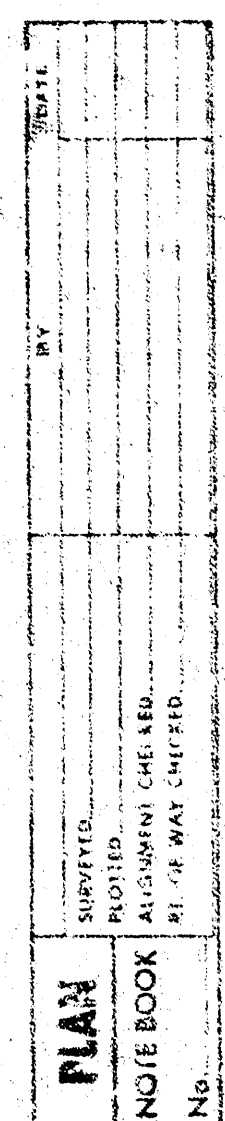

K-Σ PLATE 1, PLAN-PROFILE
KEUFFEL & ESSER CO.
48 7024 MADE IN U.S.A.*