
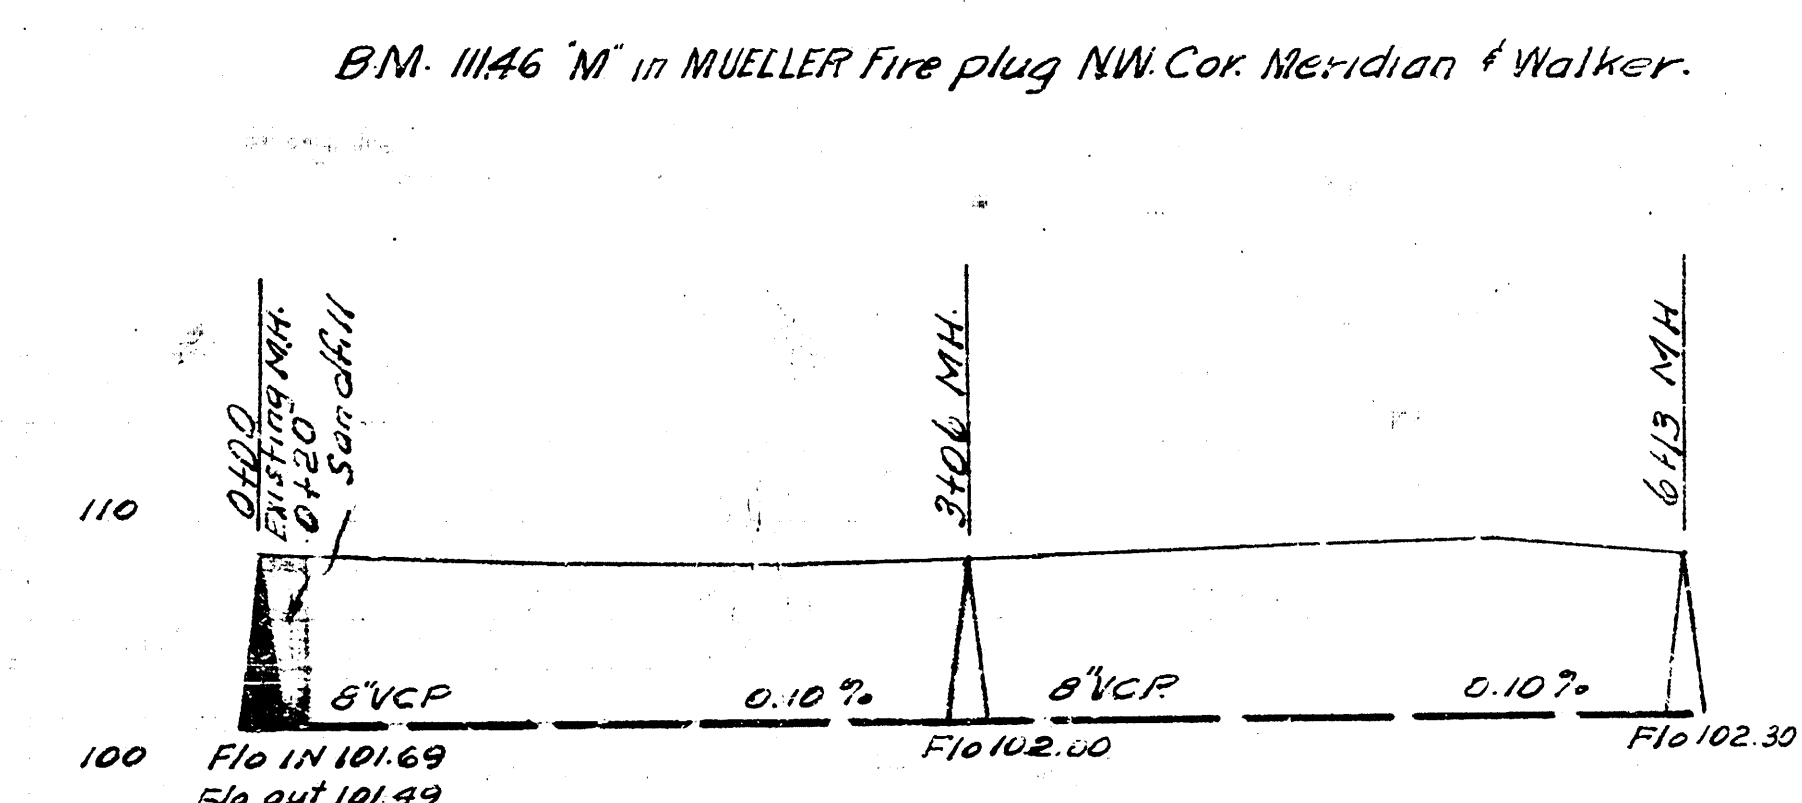


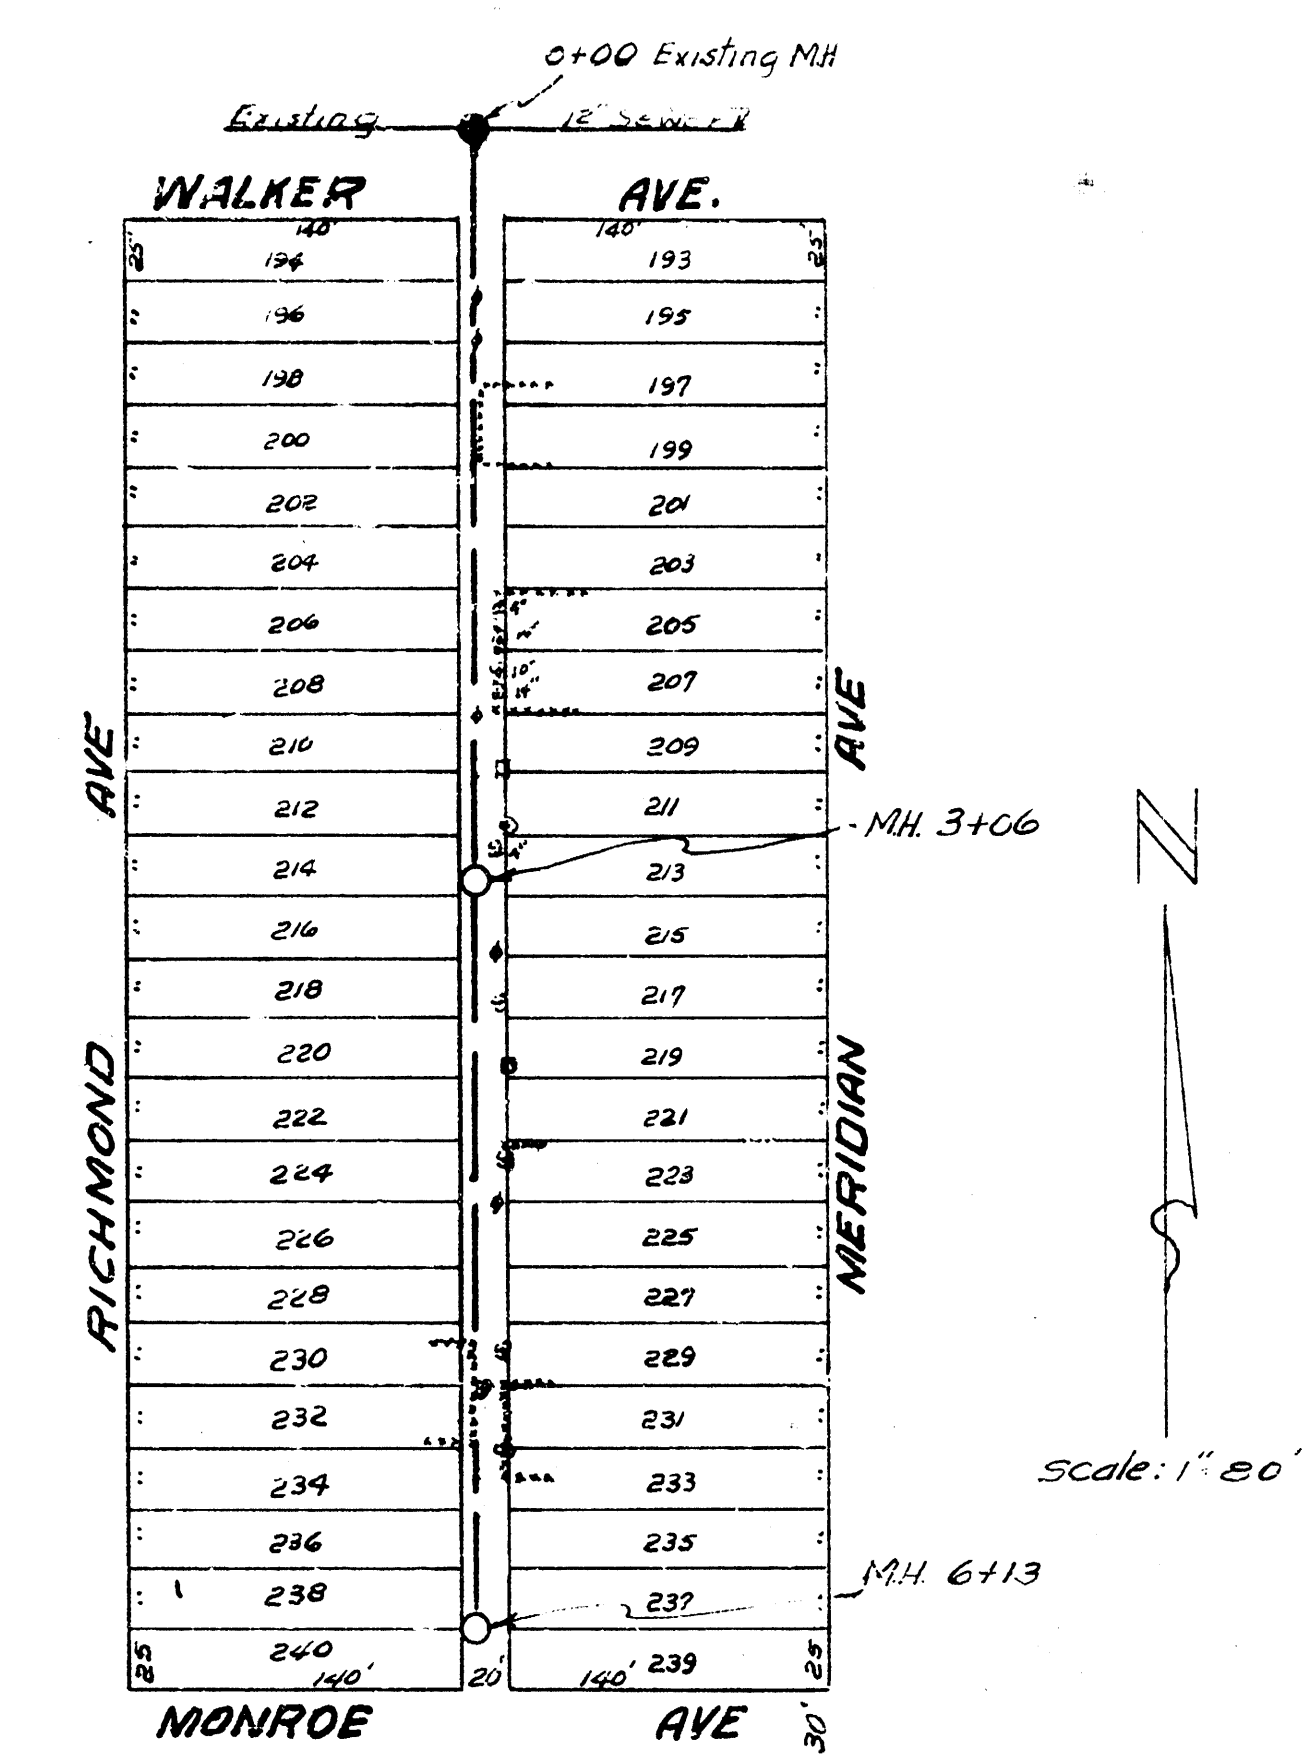

Date
Drawn by
Checked by
Book No

300.
LAT 6 ~~15~~ B SS 21
CITY OF WICHITA KANSAS
L.K. WHITE CITY ENGINEER
Proj. No. C-22-48