





N

SCALE
VERTICAL ~ 1"=5'
HORIZONTAL ~ 1"=40'

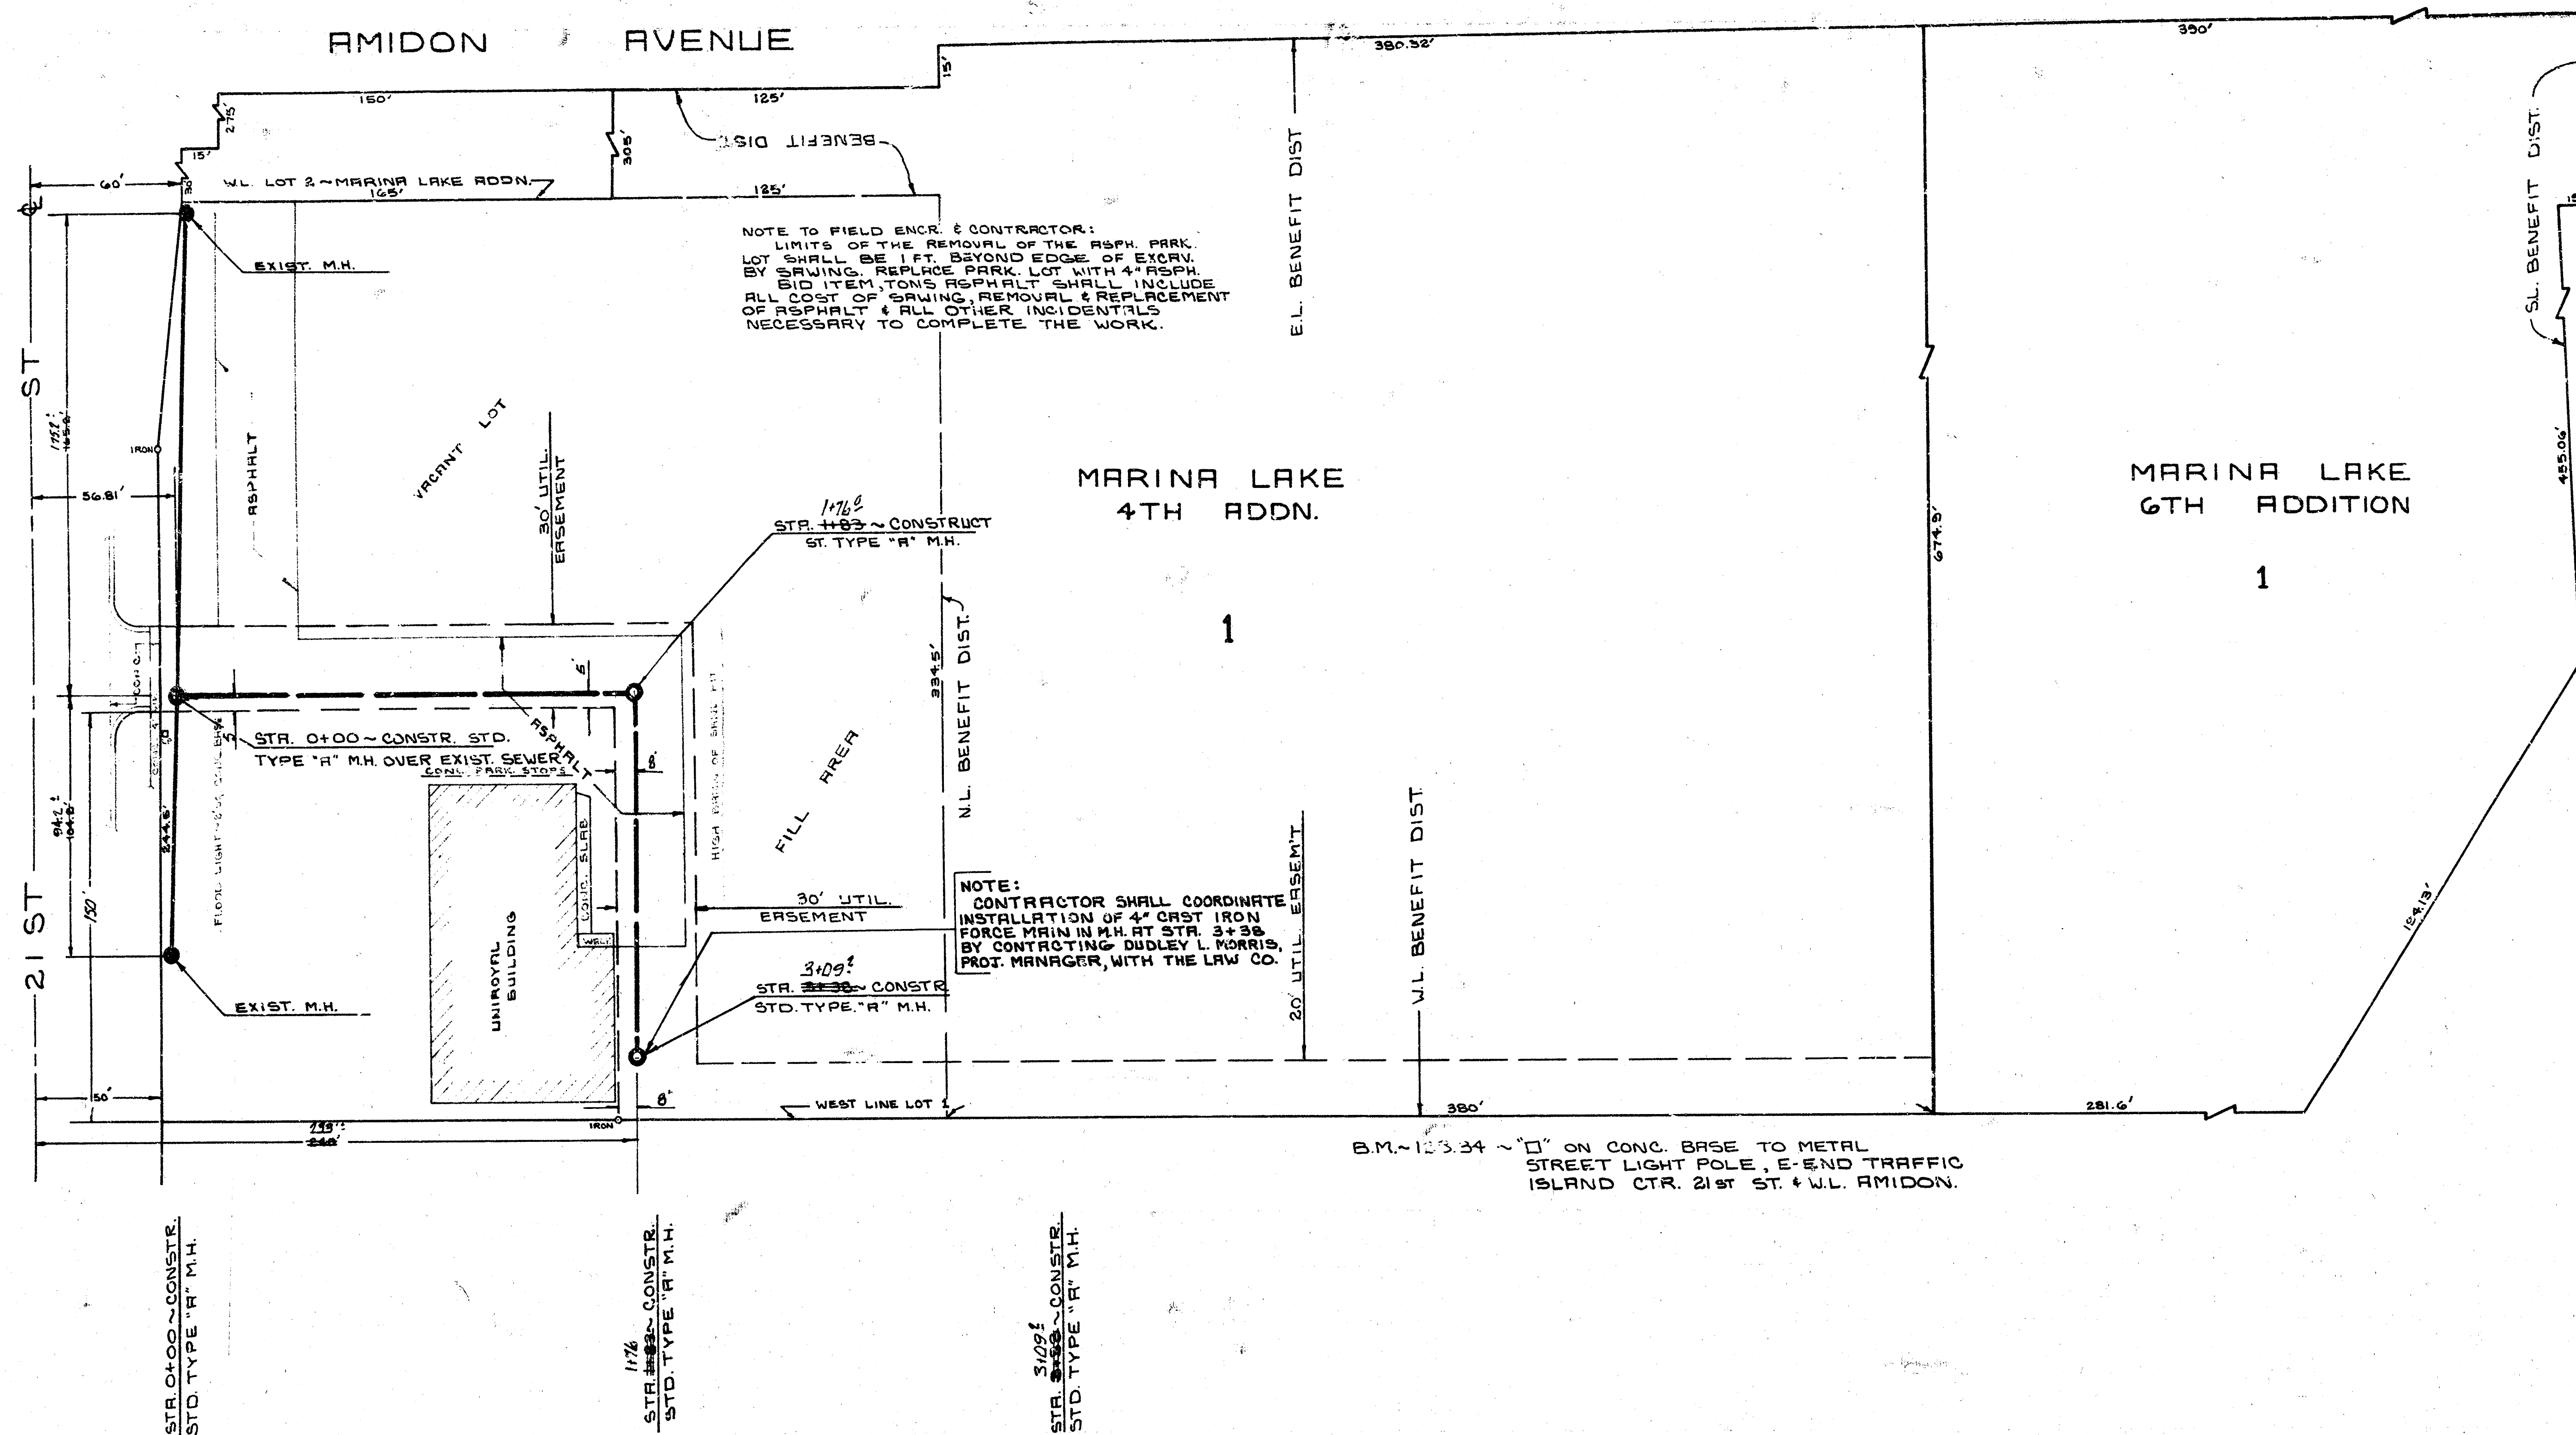

130
125
120
115
110

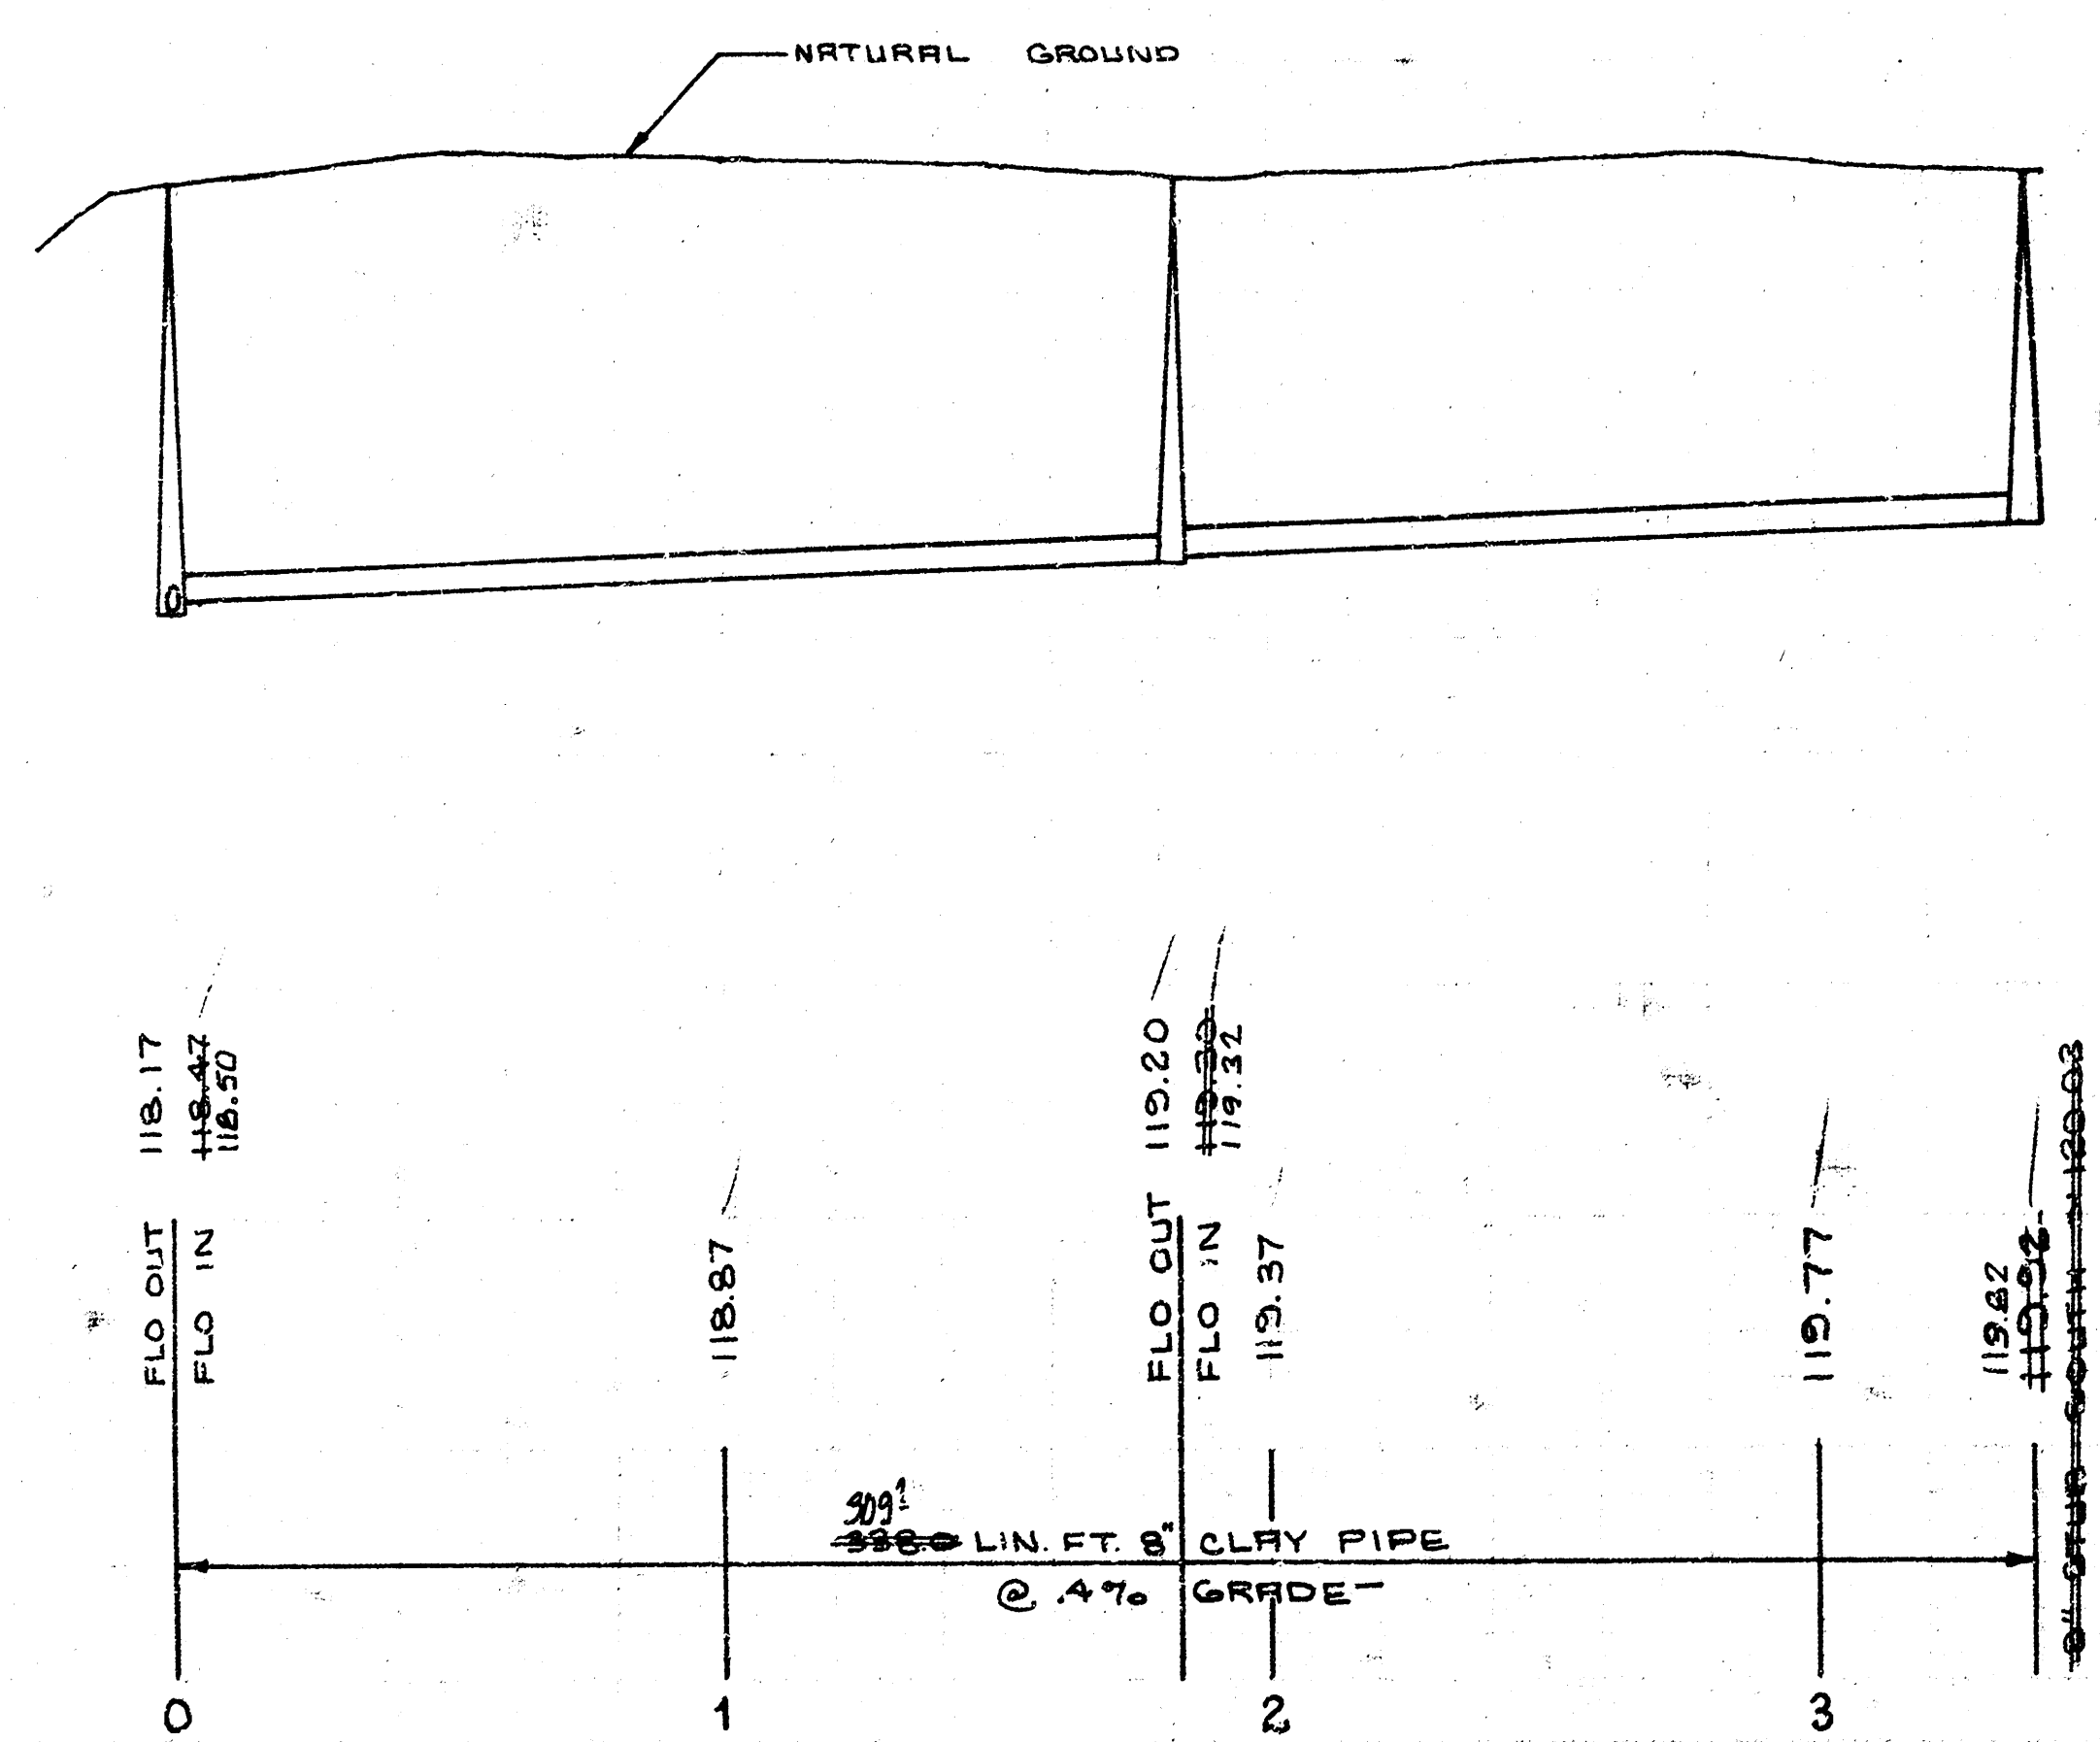

"As Built" 21 Aug 72 FINAL MEASUREMENT IN K-89

LAT 117 SS 22
CITY OF WICHITA
R.W. LINN CITY ENGINEER
DATE Aug. 1972 PROJECT NO. DBKL571029

FILMED FROM THE BEST