

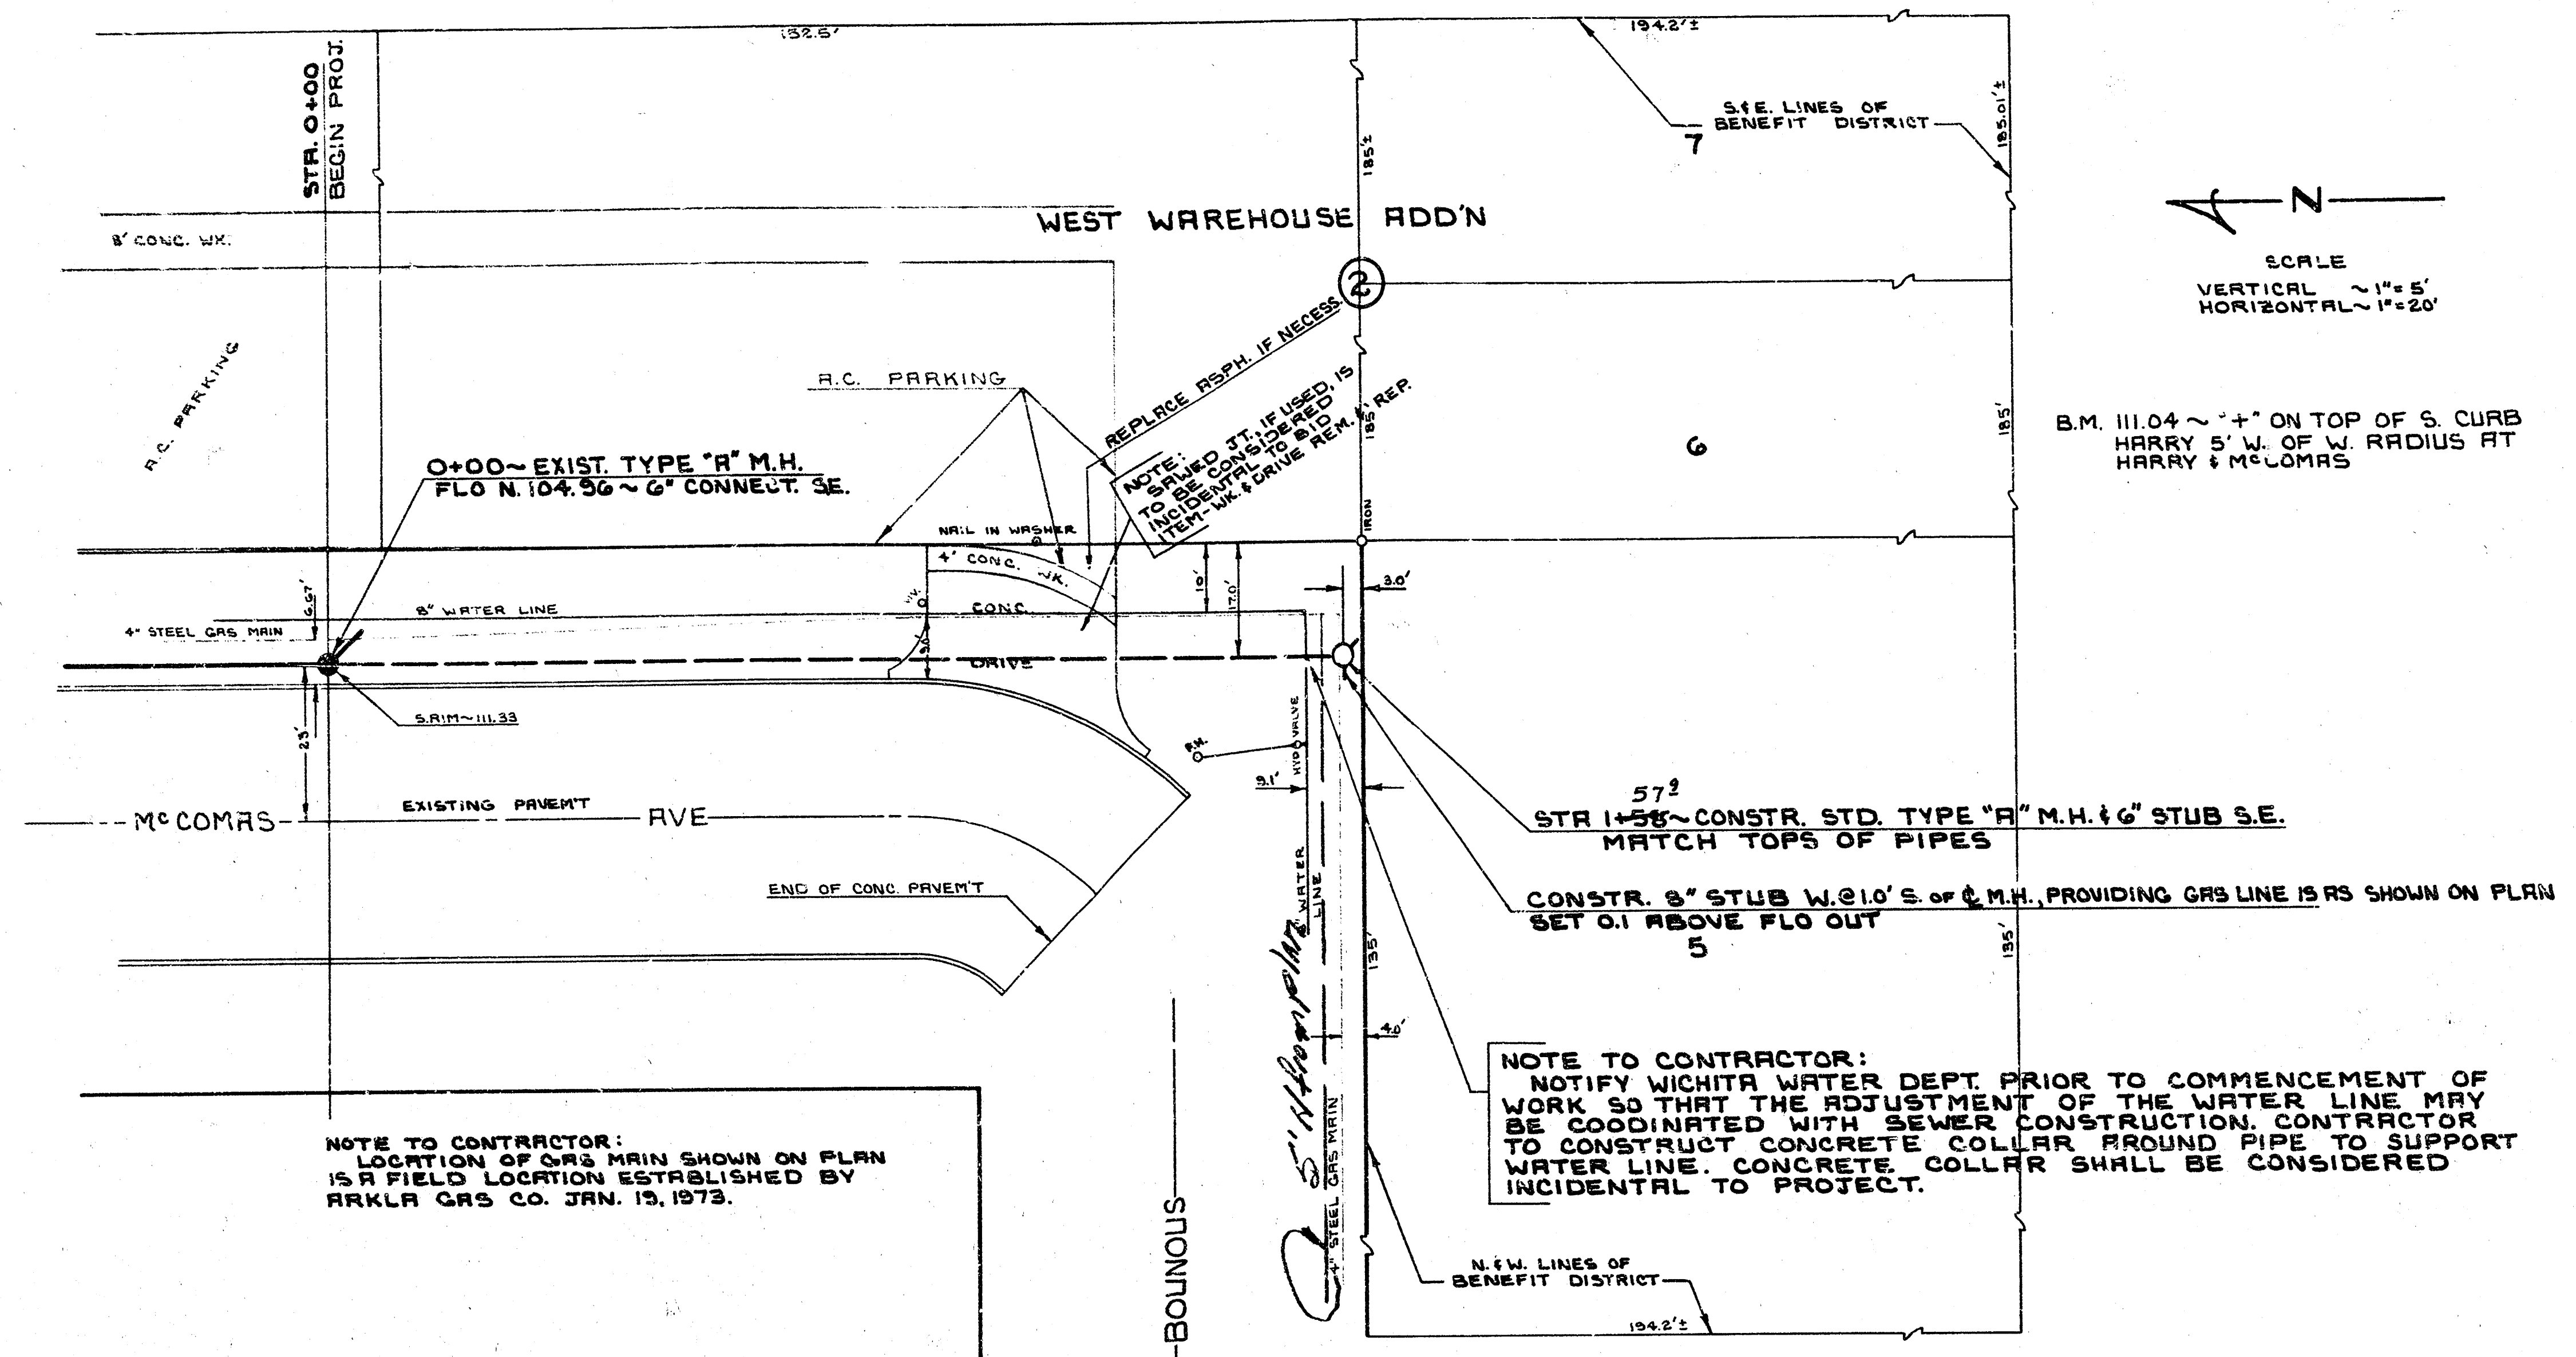


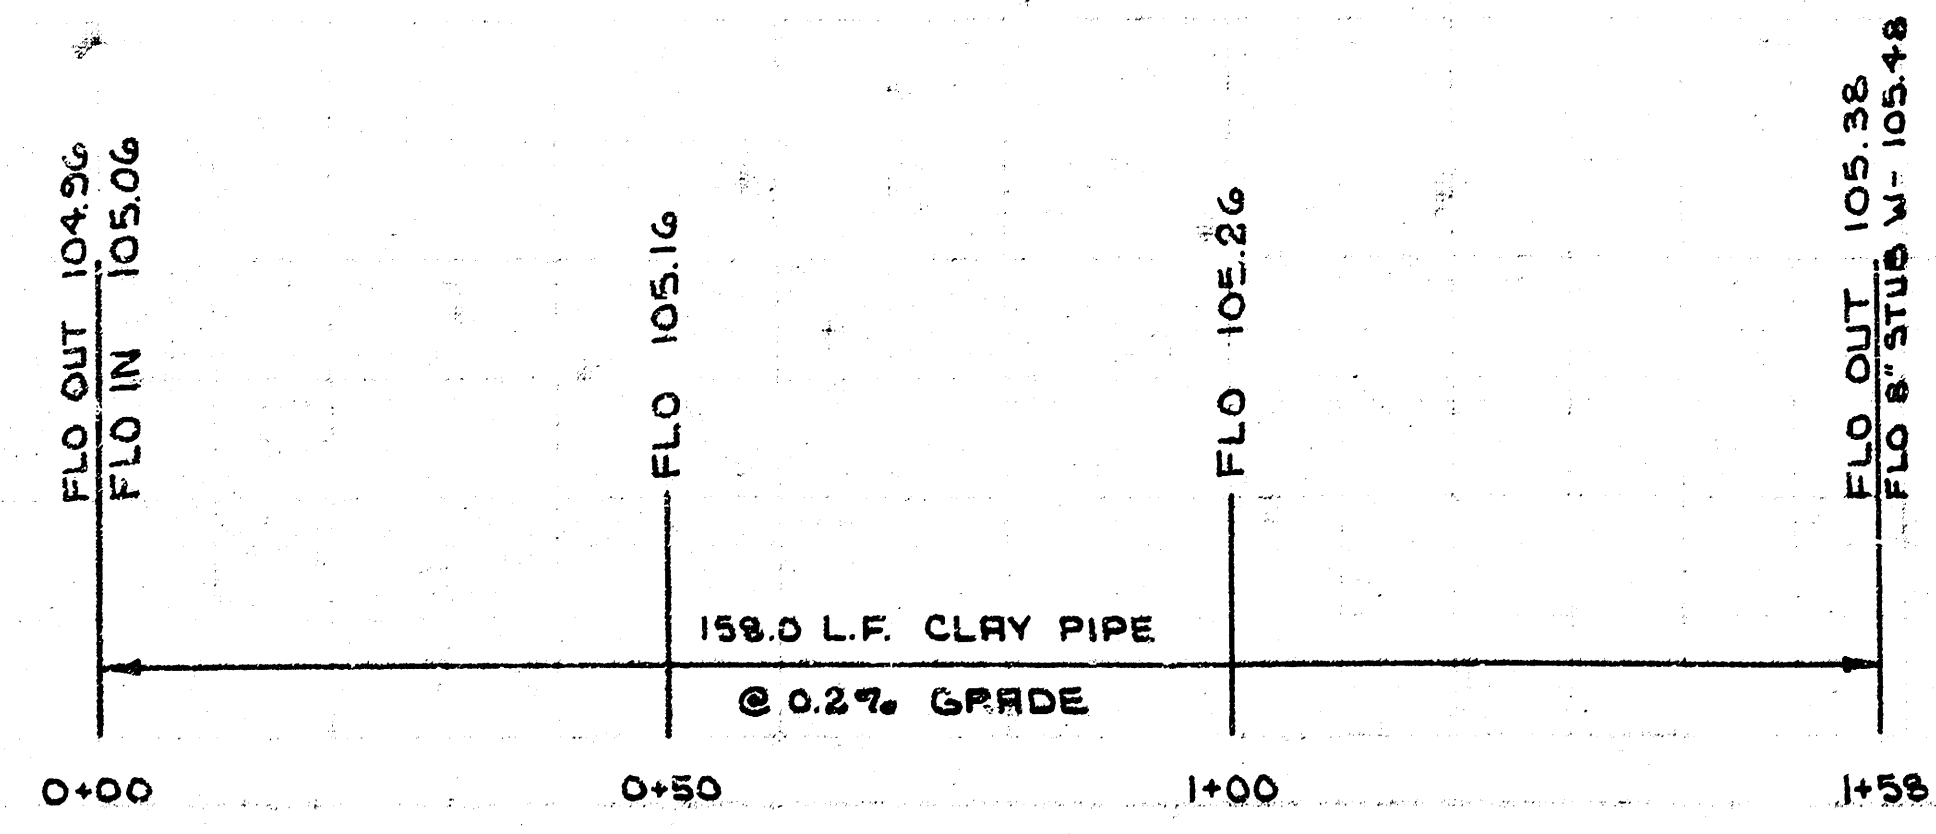


SCALE
VERTICAL ~ 1" = 5'
HORIZONTAL ~ 1" = 20'

CAUTION
UNDERGROUND
UTILITIES
Please Call 311 for Location
Telephone 661-1111

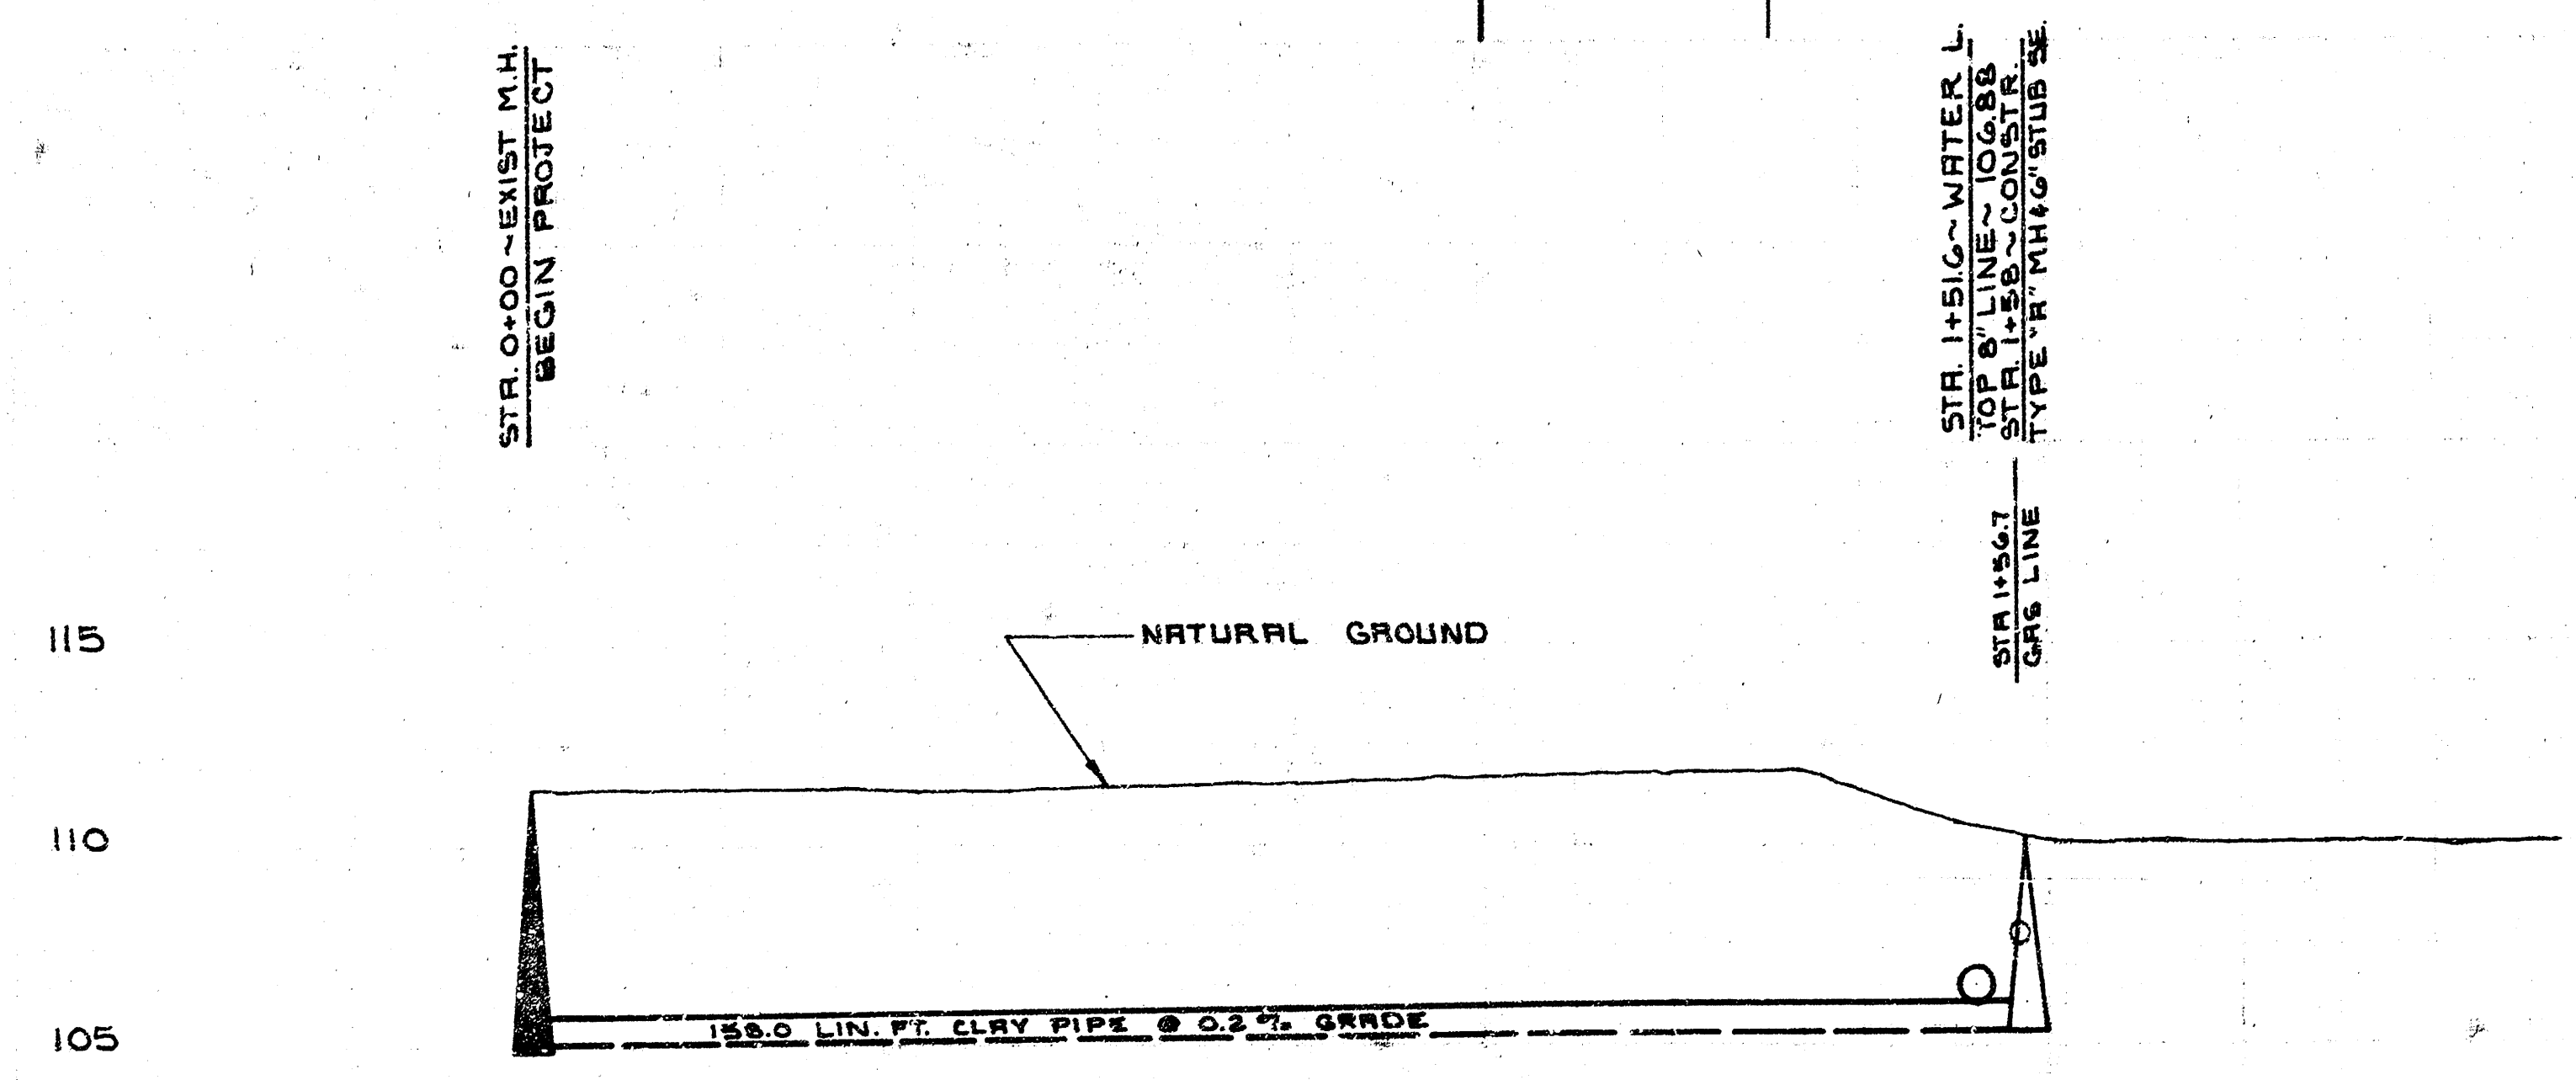

As Built Final Measurements SS. LH#9

LRT 119 ~ S.S.# 22
CITY OF WICHITA
R.W. LINN ~ CITY ENGINEER
DATE JAN. 1973 PROJ. NO. D3KL572076

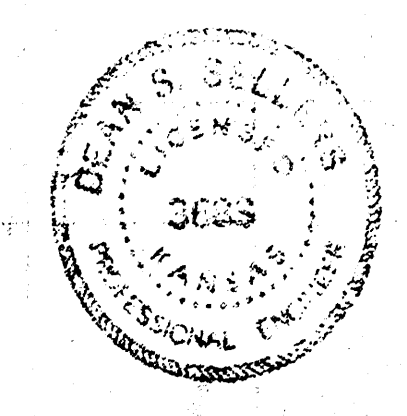

10-Engr
1-water

12