




CL. Along
S. Spence

DBL 57

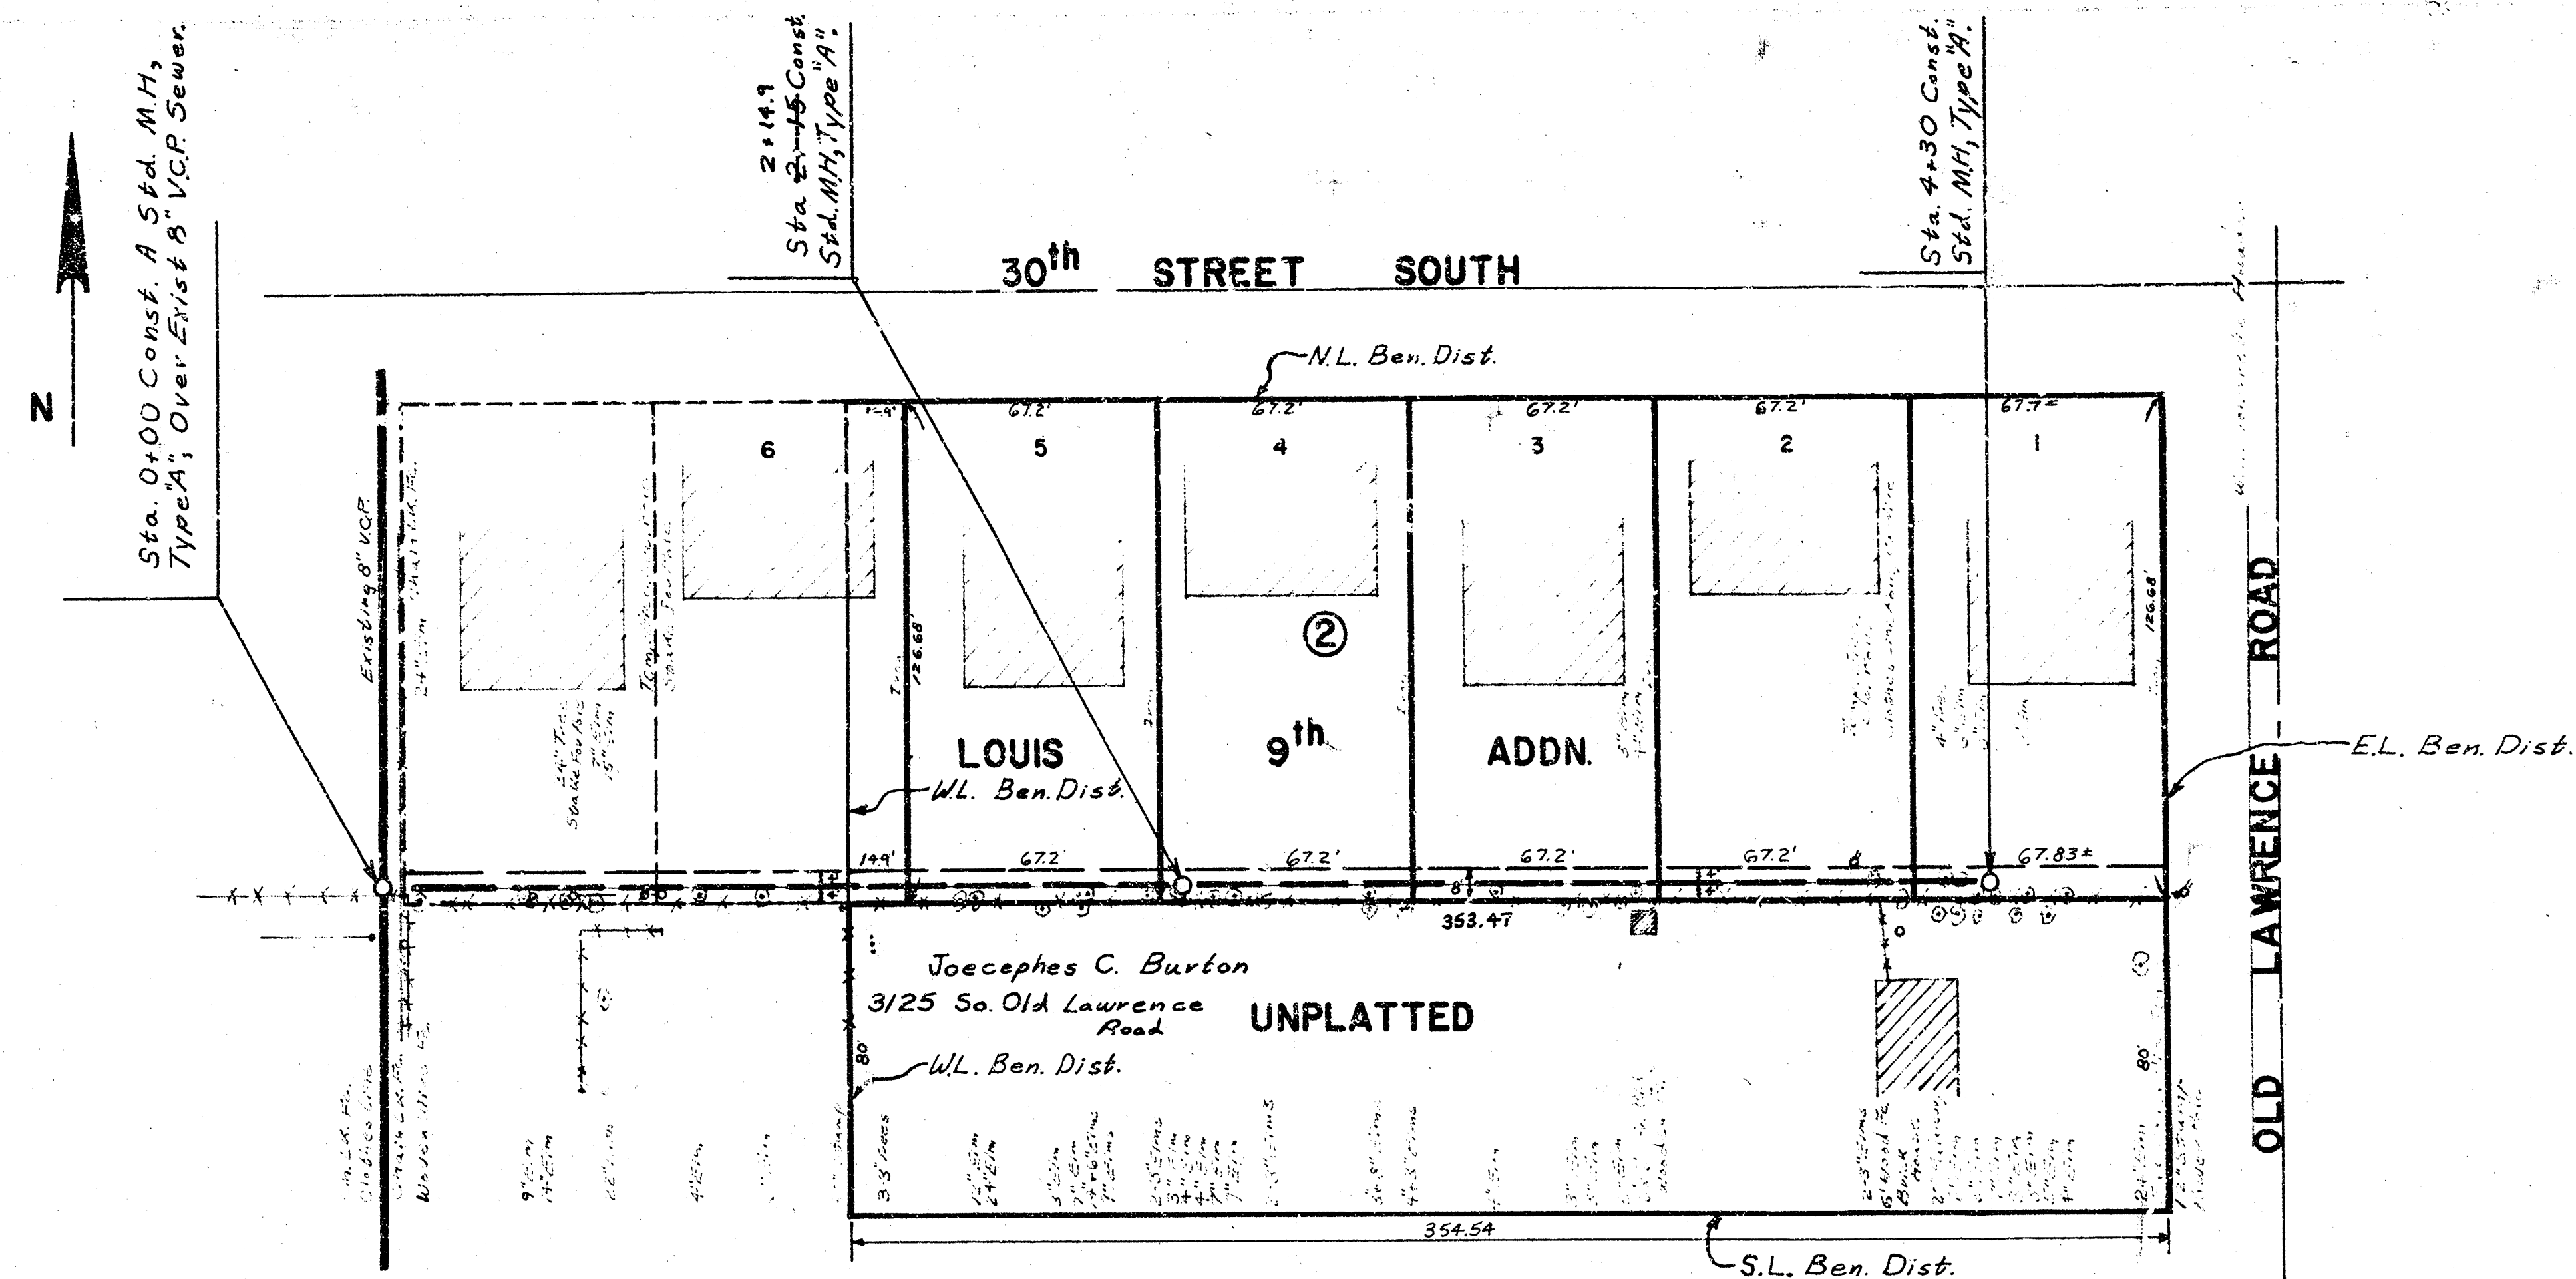

BM*1 96.70 SW. Cor. 1st Concrete Step, 210 W. 30th Street South.

Plan Scale: 1" = 40'
Profile Scale: Horizontal 1" = 40'
Vertical 1" = 5'

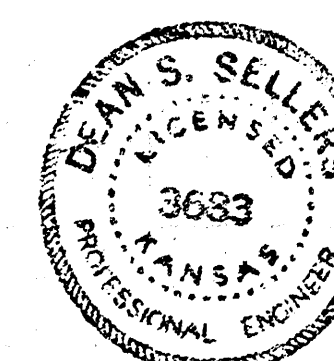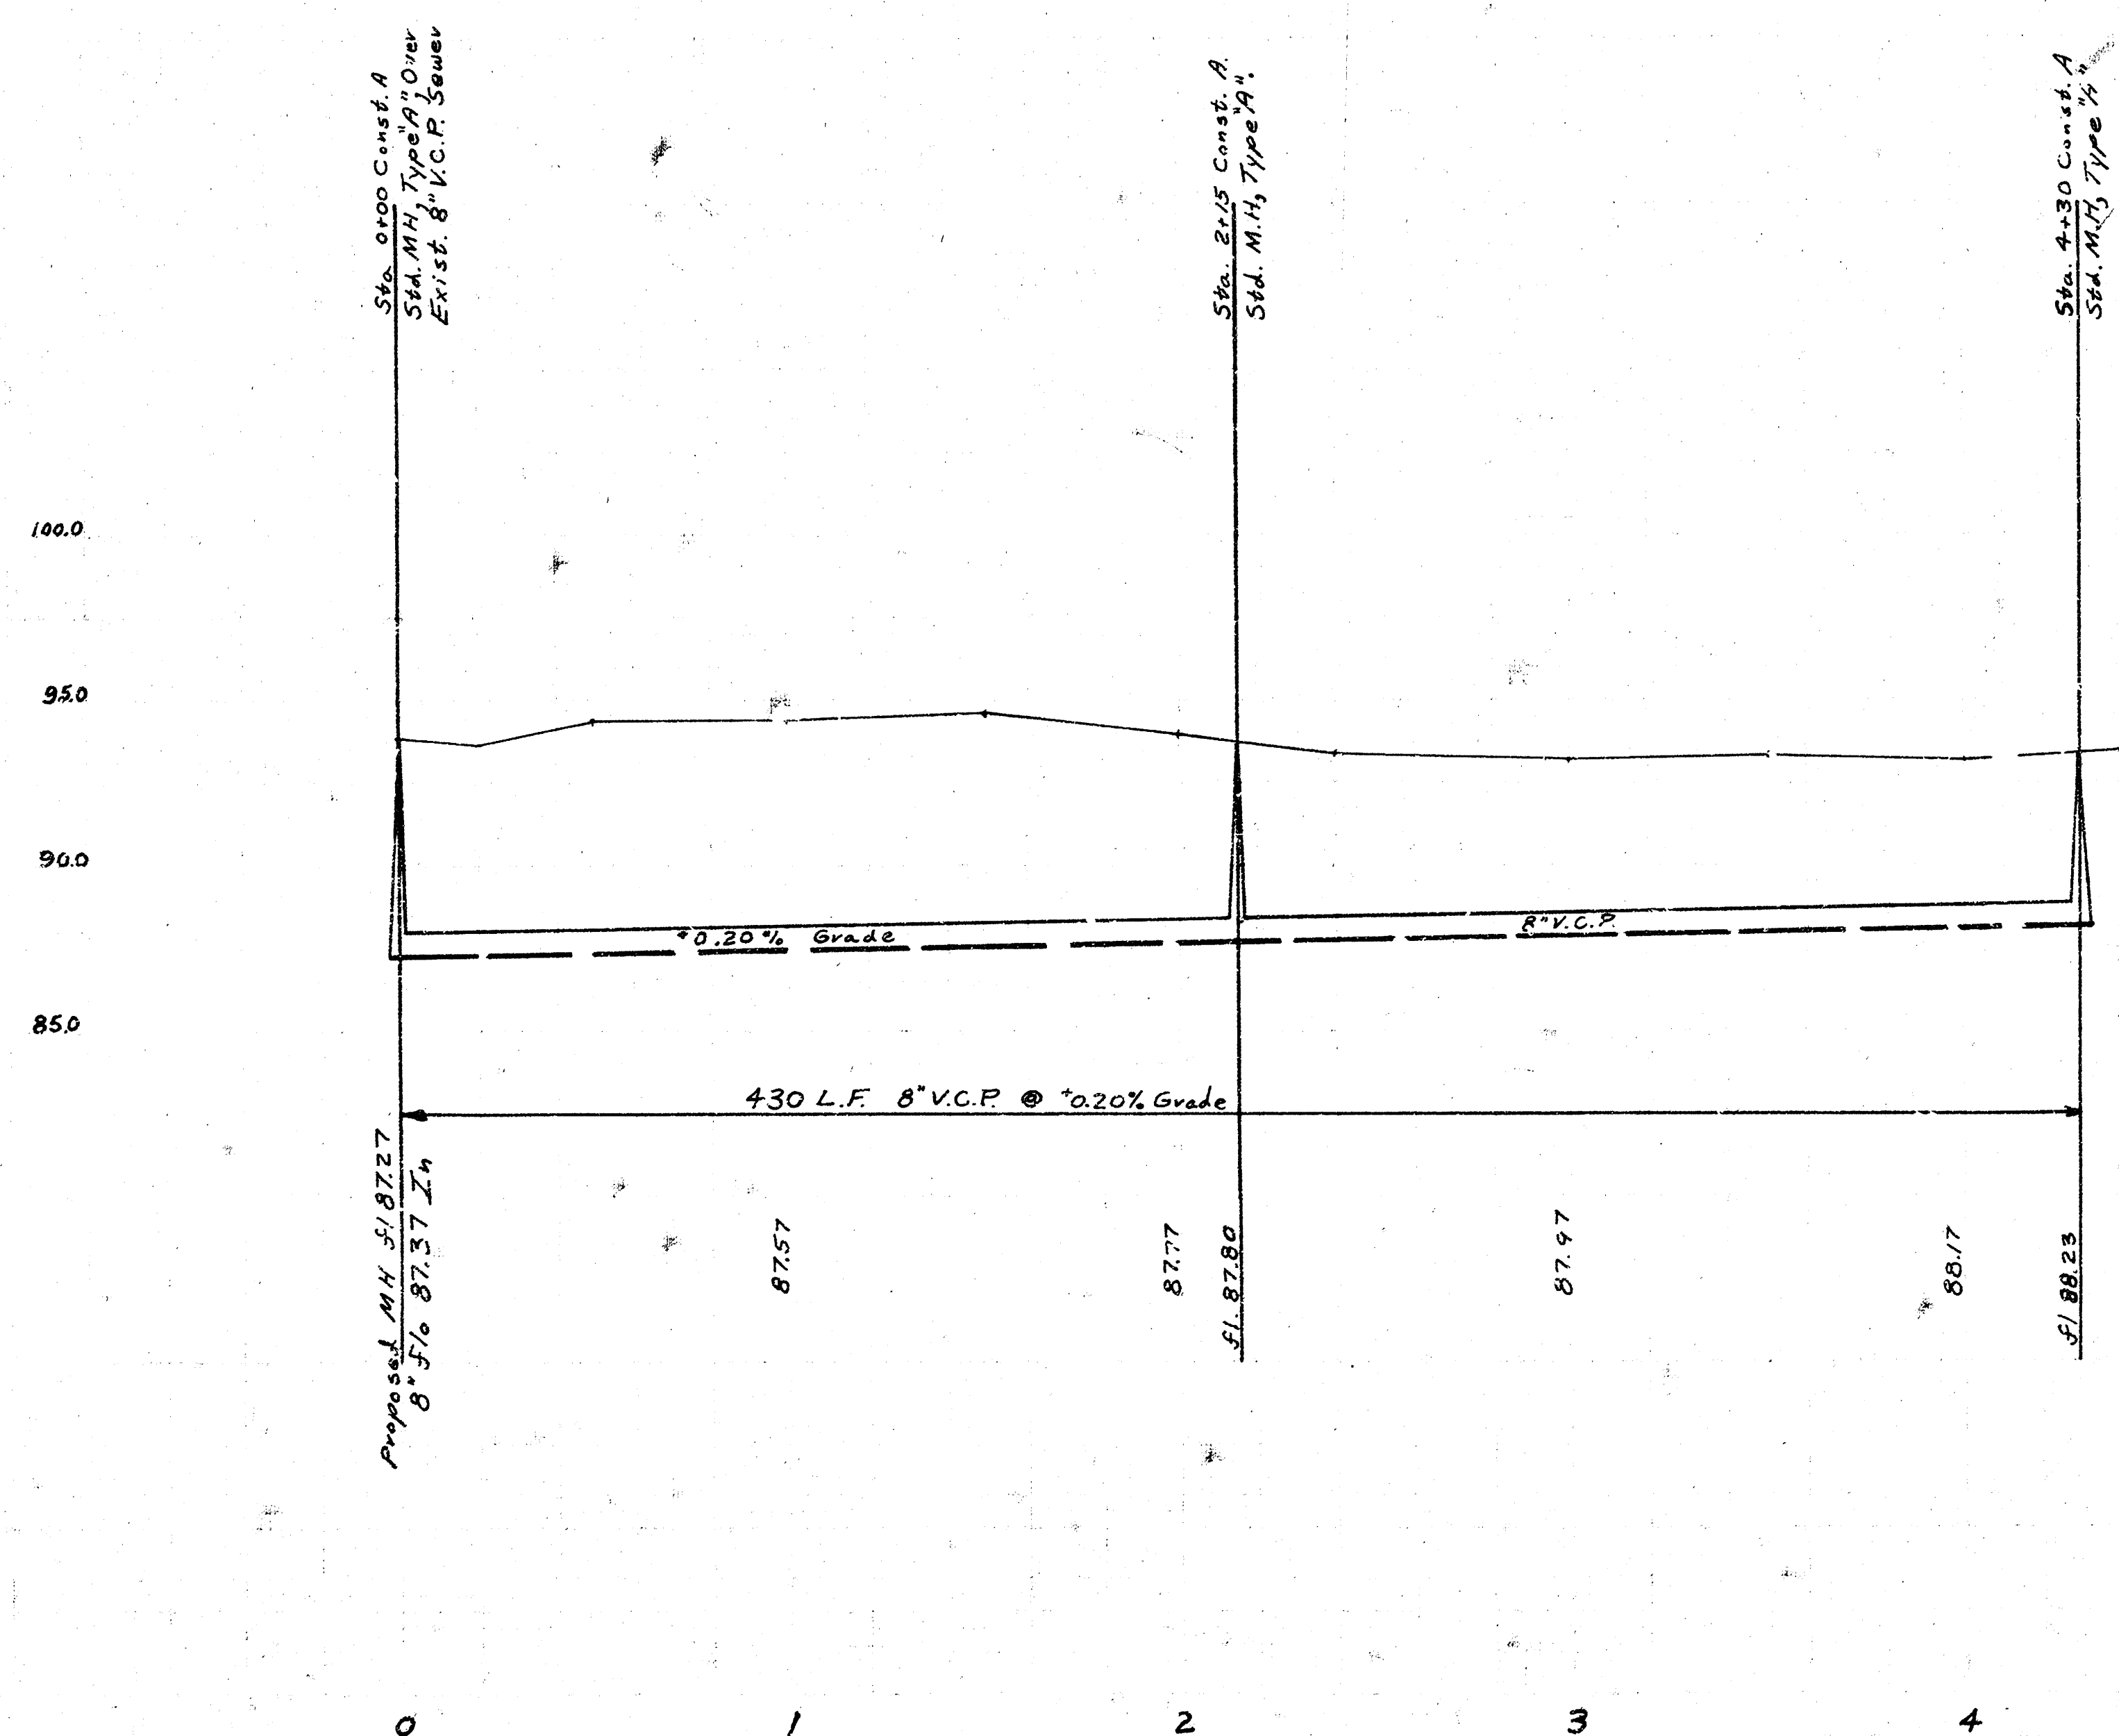

As Built Final Mount. SS JK # 9

LAT. 122	S.S. NO. 22
CITY OF WICHITA, KANSAS	
R.W. LINN CITY ENGINEER	
DATE: JULY 1973	
SHEET: 1 OF 1	
PROJECT NO. DBKL 573031	

187 Eng
12/1/73