

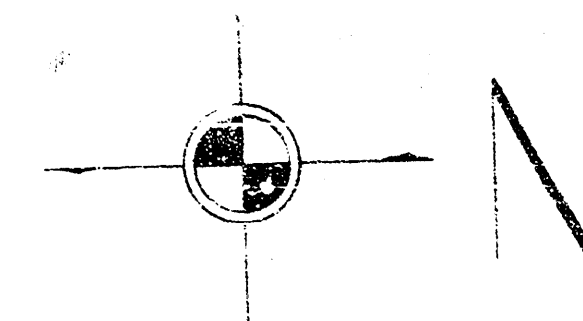
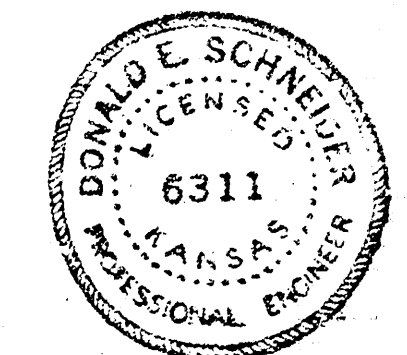


B.M. 100⁷⁶ "D" Top Curb South Return SW Corner Wildwood + St. Paul
 B.M. 99⁸⁵ "A" Top Curb South Return S.E. Corner Sunnybrook + St. Paul
 B.M. 99⁹³ City Std. Disc 6' N + 2' of S.E. R/W, Corner of Sheridan + 31st St. South

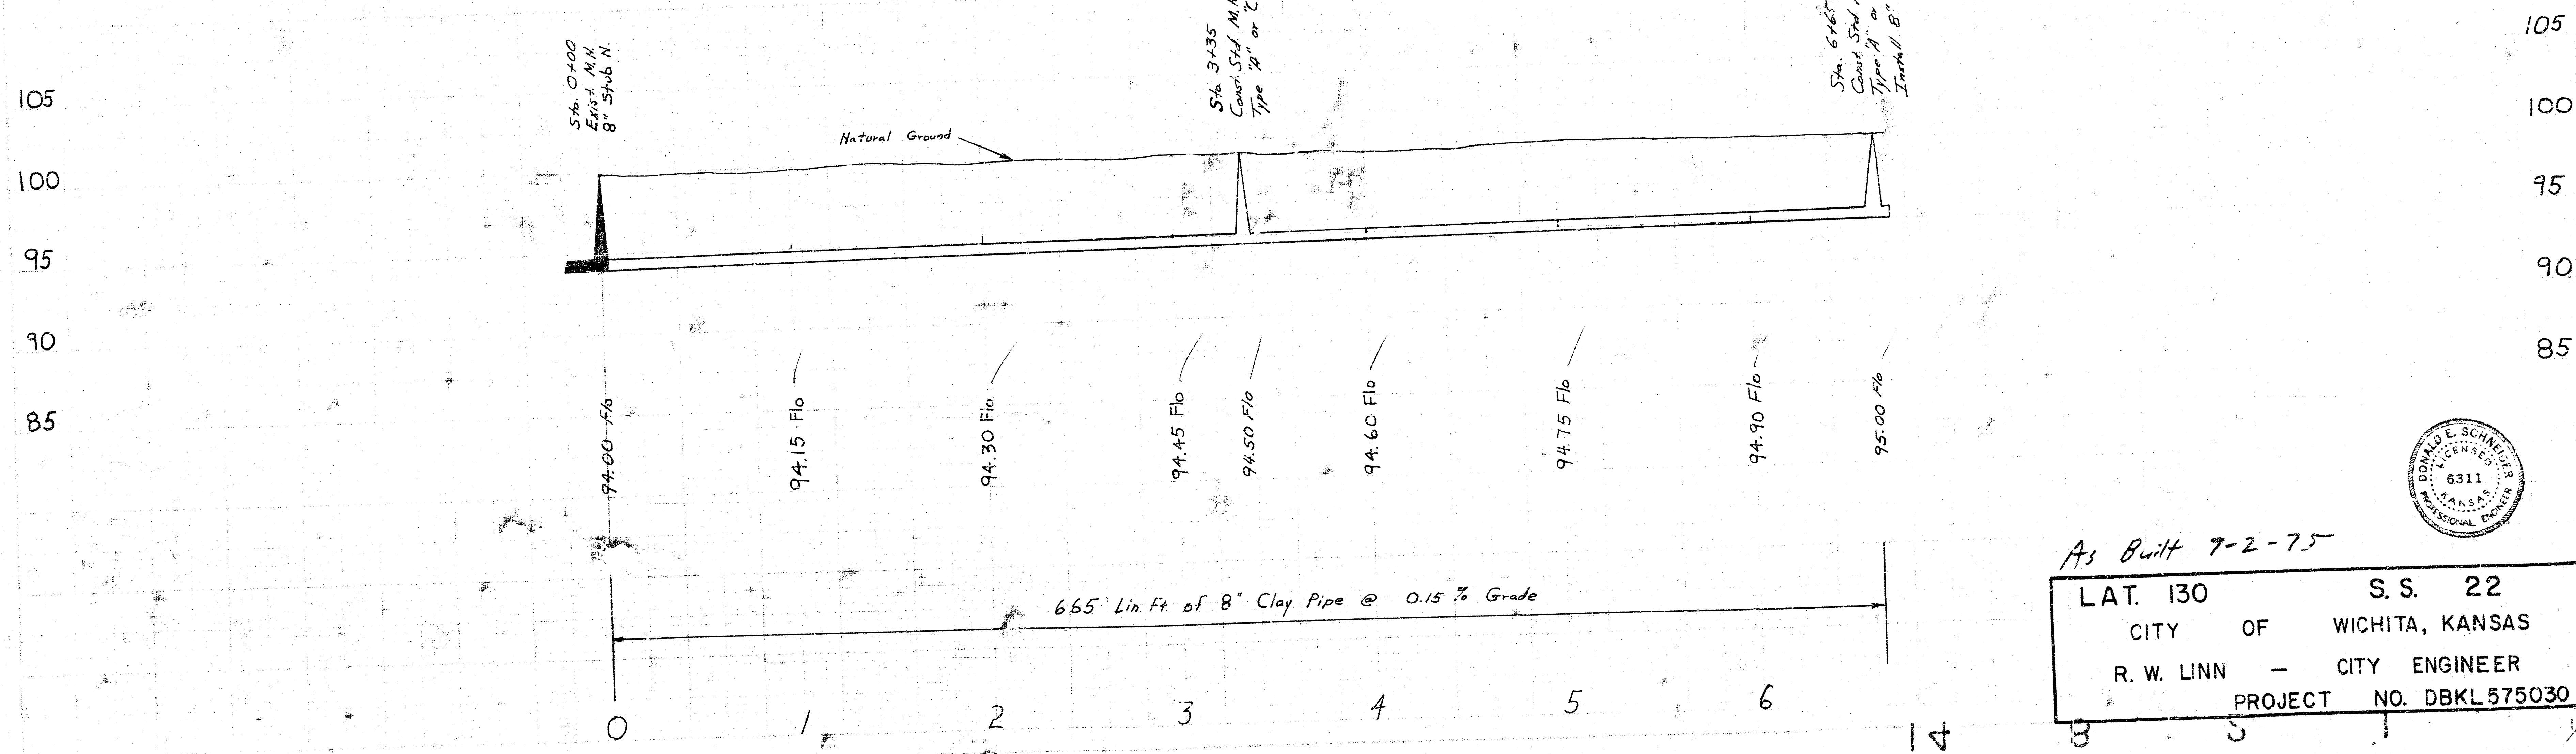

Plan Scale 1" = 40'
 Profile Scale 1" = 40' Horiz.
 1" = 5' Vert

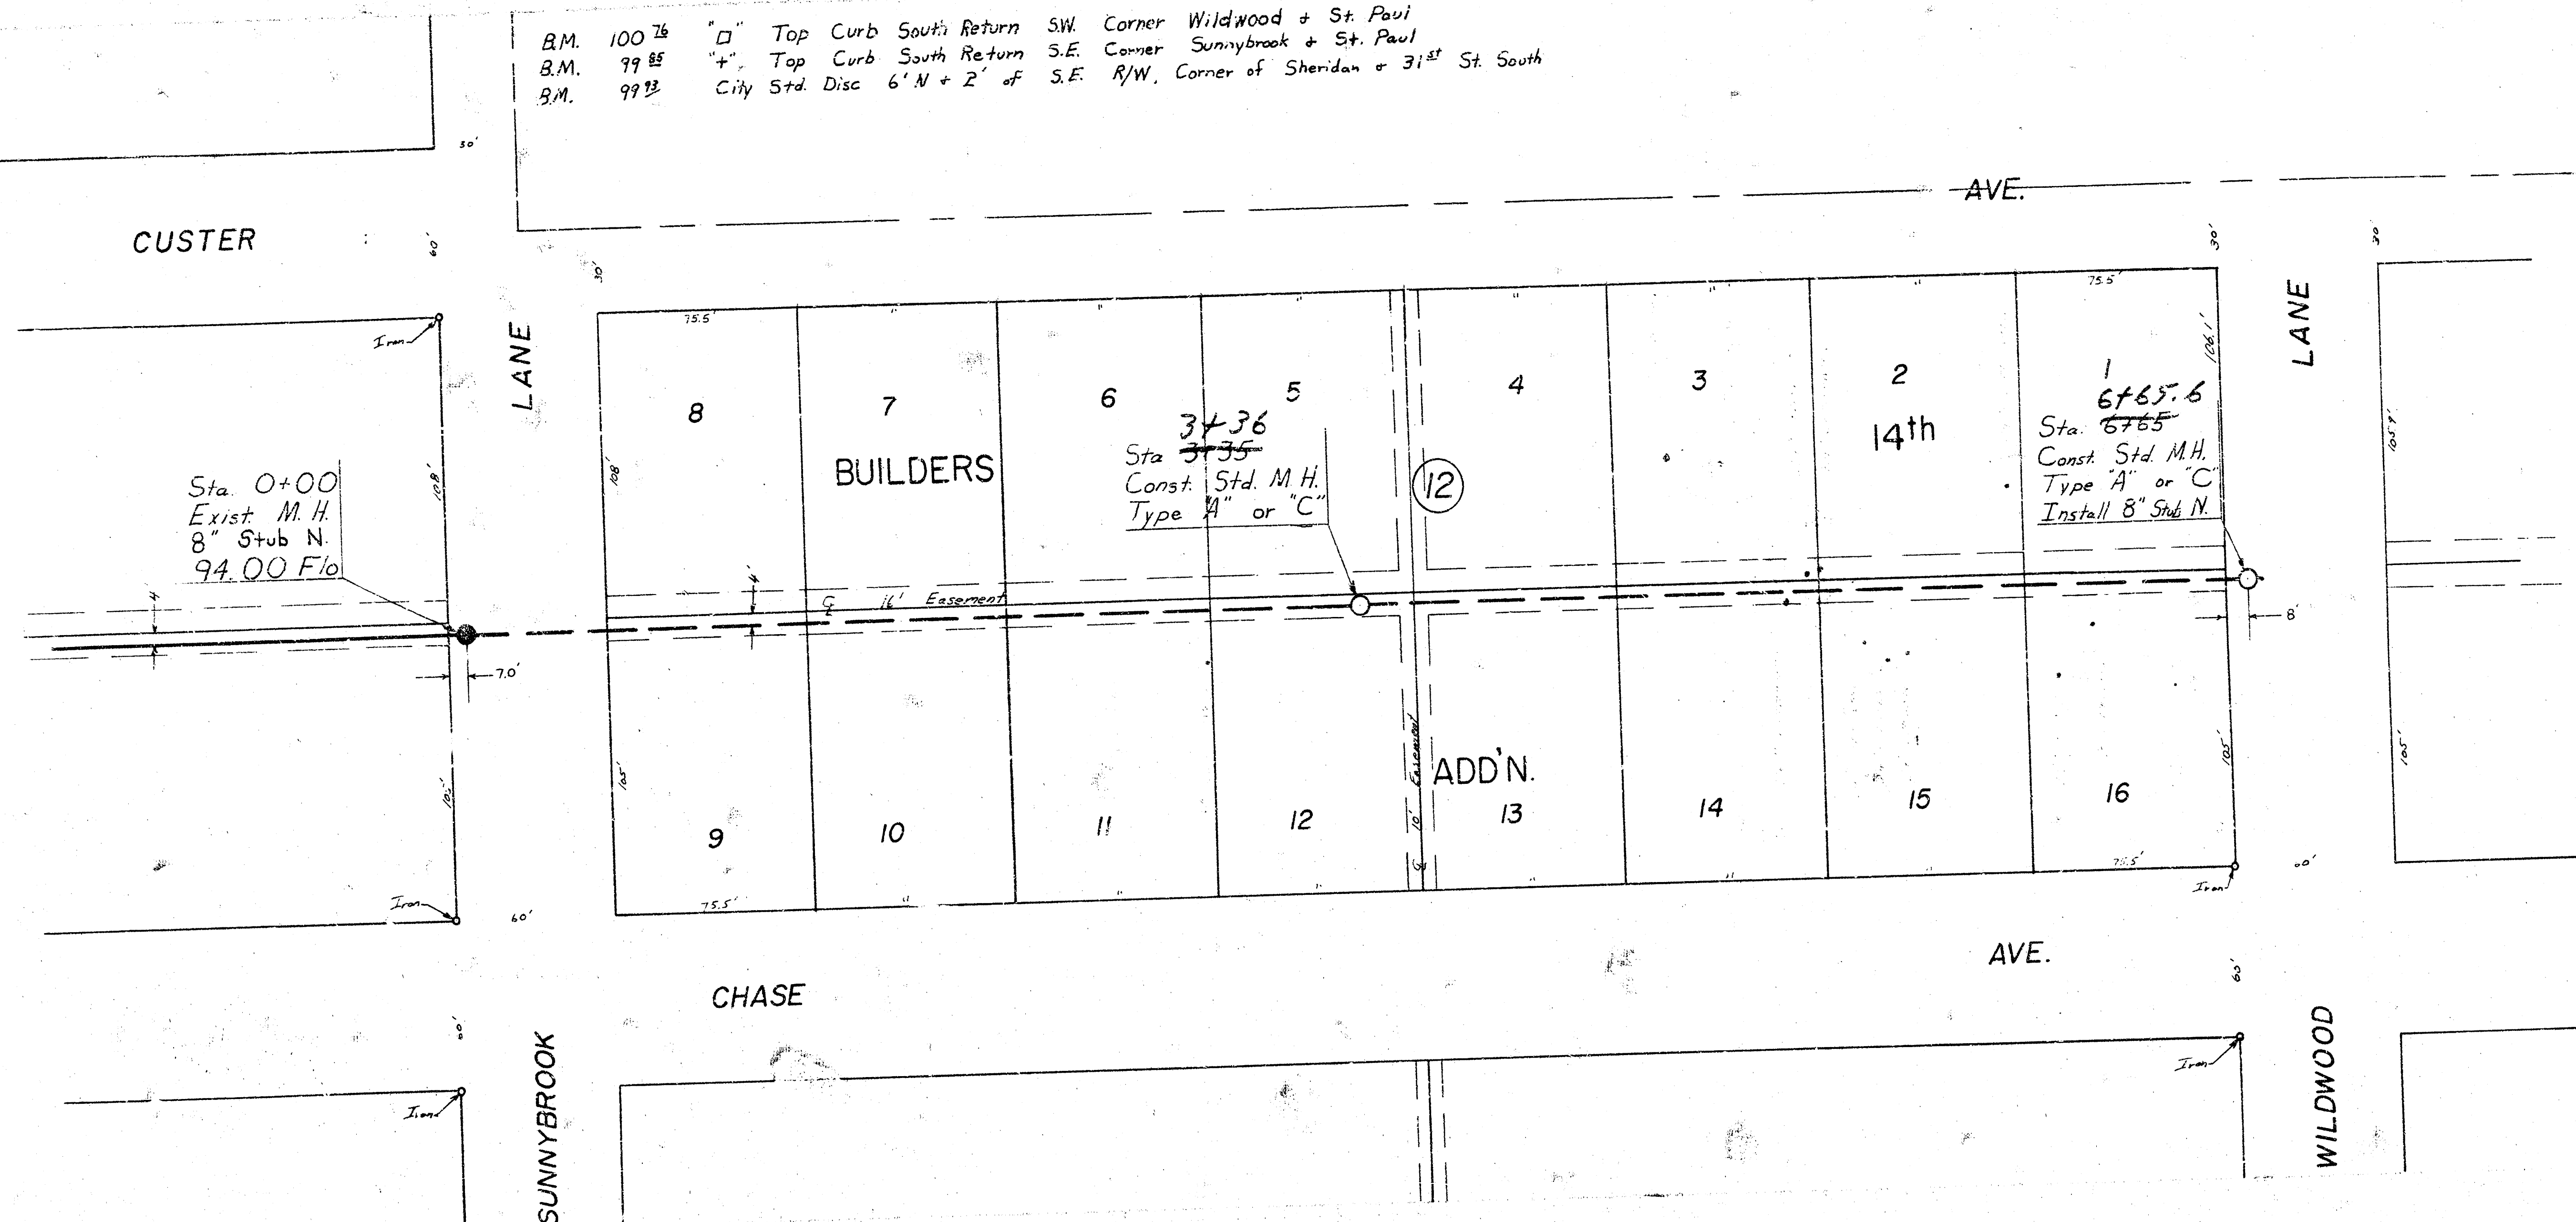

As Built 7-2-75
 LAT. 130 S.S. 22
 CITY OF WICHITA, KANSAS
 R. W. LINN - CITY ENGINEER
 PROJECT NO. DBKL575030