
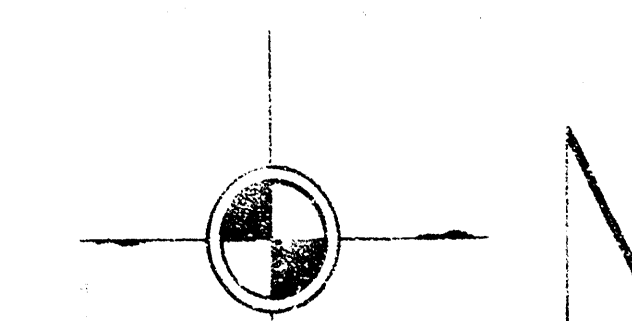


B.M. 99.93 City Std. Disc. 6' N. & 2'E.  
of SE. R/W Corner of Sheridan & 31st

B.M. 103.52 City B.M. Disc. Top East End South  
Handrail RCBC Sheridan & 31st

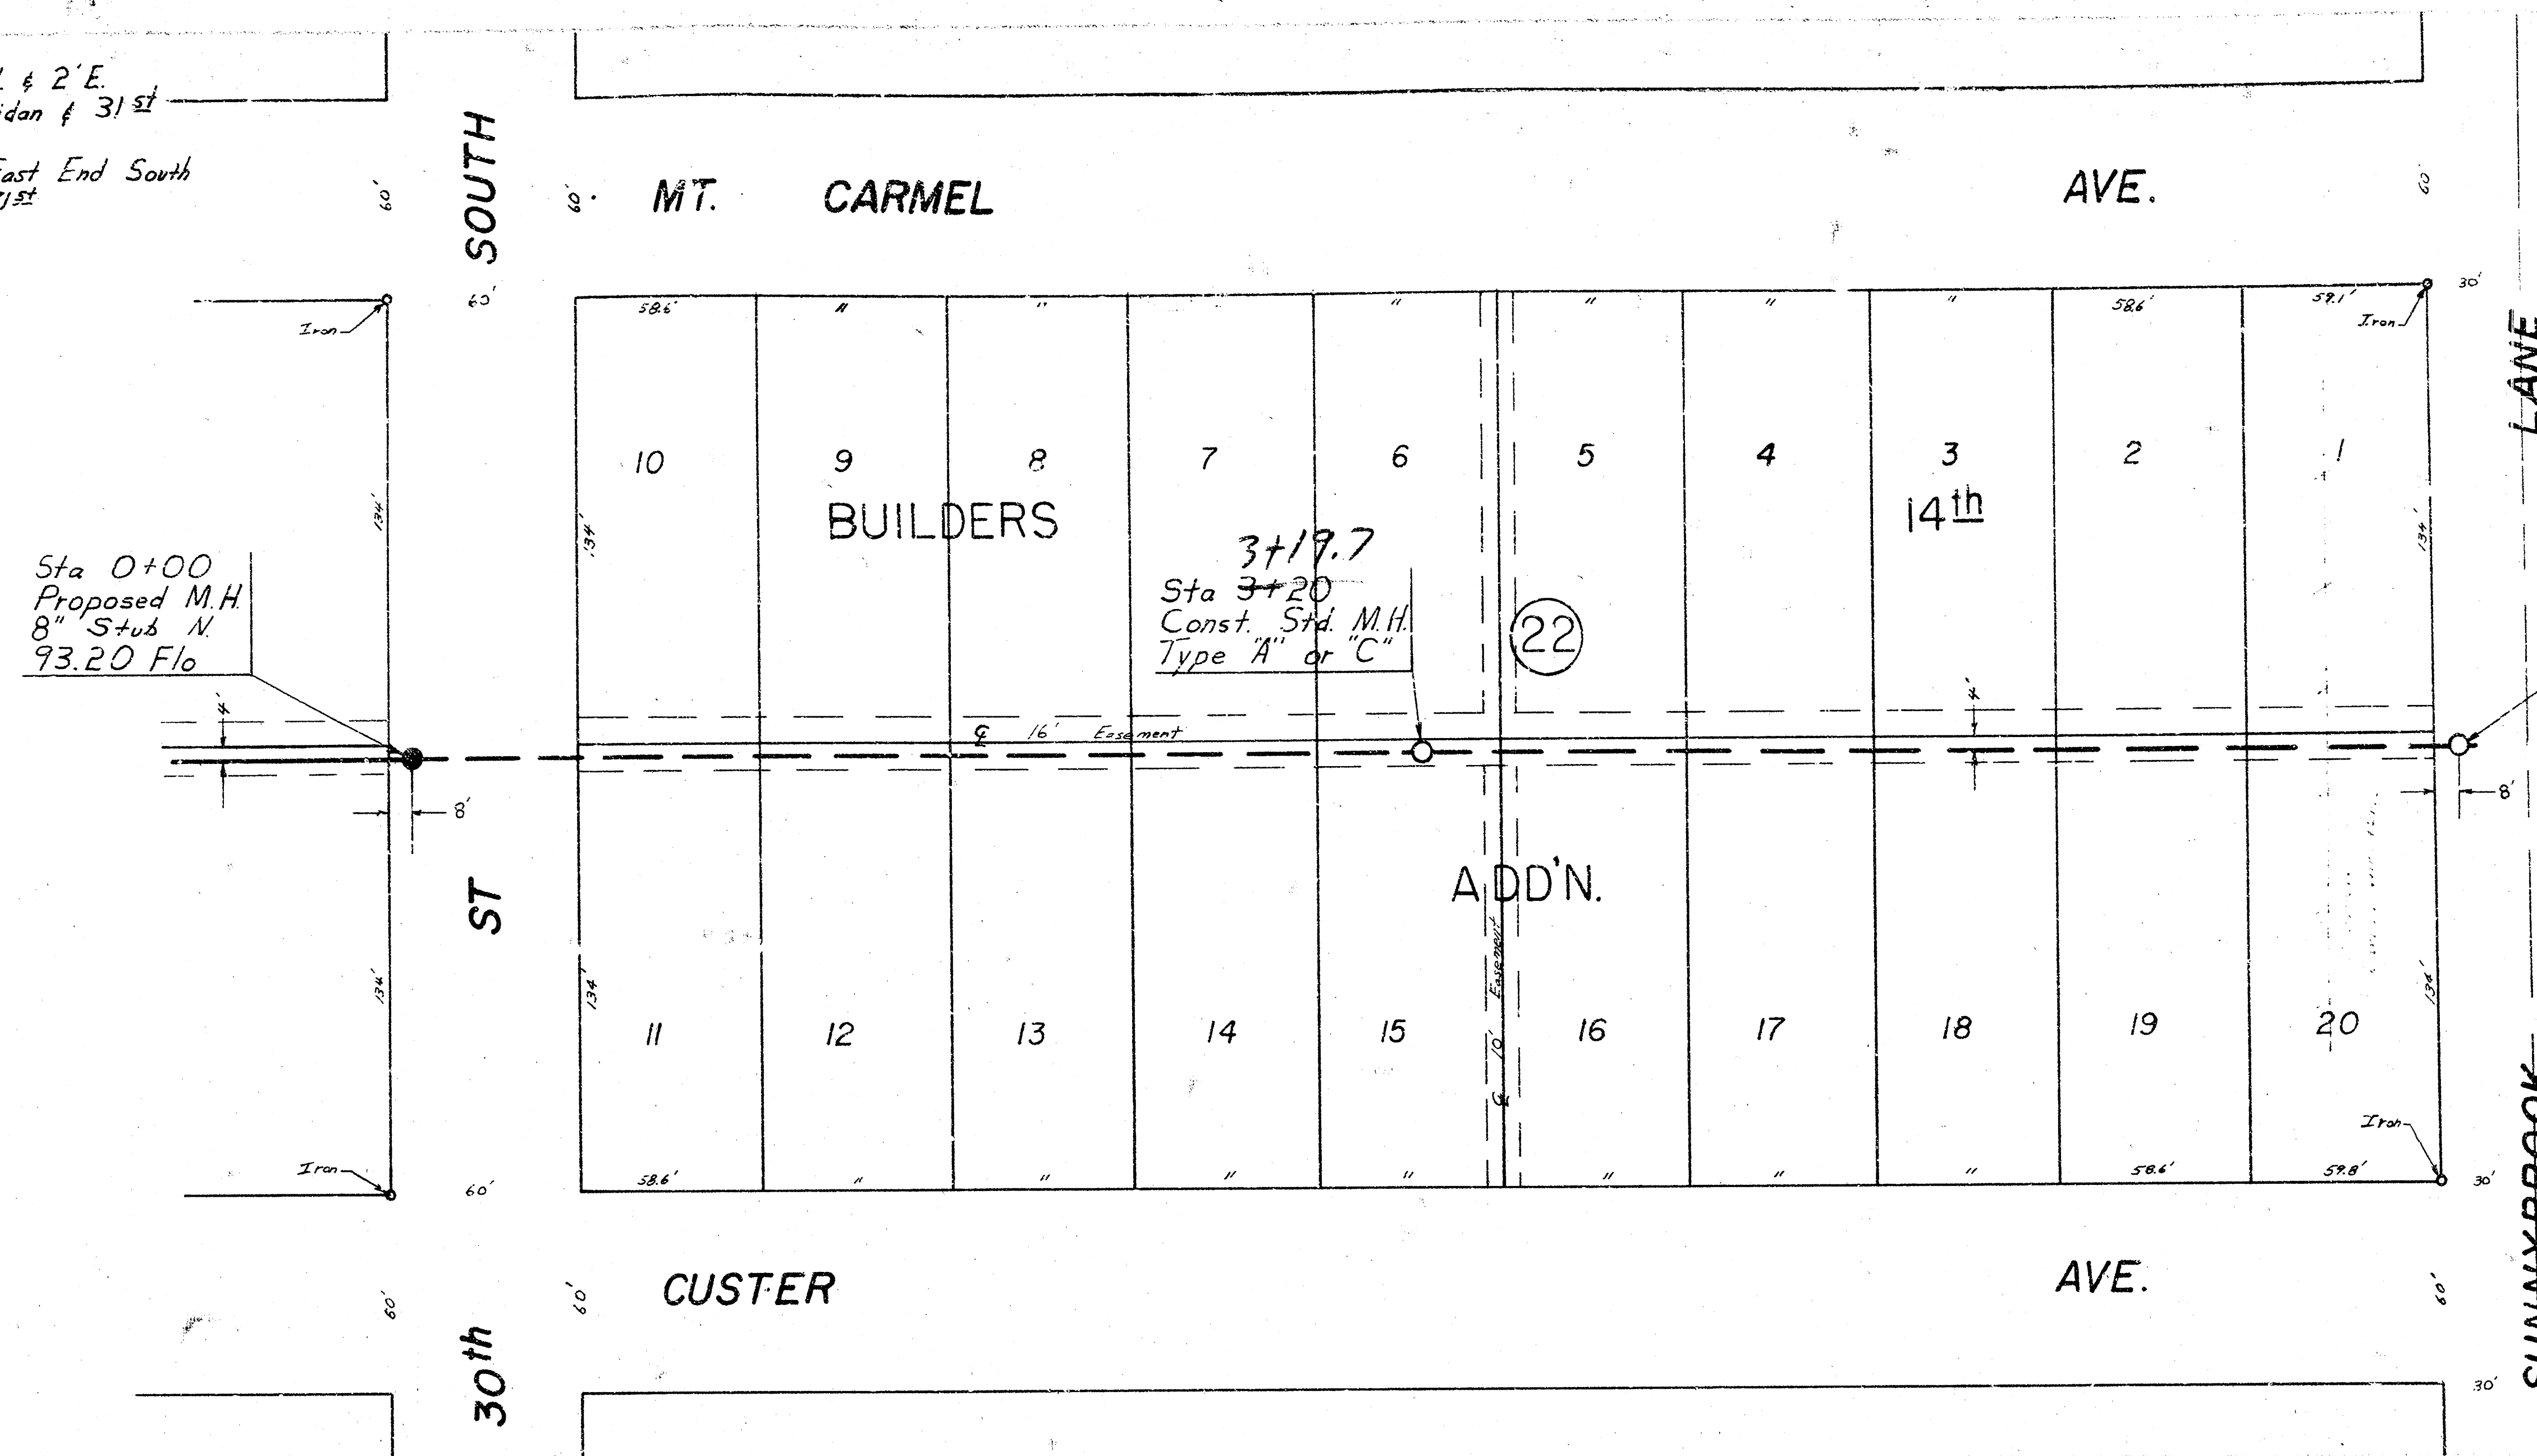

Plan Scale 1" = 40'  
Profile Scale 1" = 40' Horiz.  
1" = 5' Vert.

Sta 0+00  
Proposed M.H.  
8" Stub N  
93.20 Flo

Sta 3+20  
Const. Std. M.H.  
Type 'A' or 'C'

Sta 6+46.8  
Const. Std. M.H.  
Type 'A' or 'C'  
Install 8" Stub N.


Sta 0+00  
Proposed M.H.  
8" Stub N  
93.20 Flo

Sta 3+20  
Const. Std. M.H.  
Type 'A' or 'C'

Sta 6+46.8  
Const. Std. M.H.  
Type 'A' or 'C'  
Install 8" Stub N.

105  
100  
95  
90  
85

105  
100  
95  
90  
85

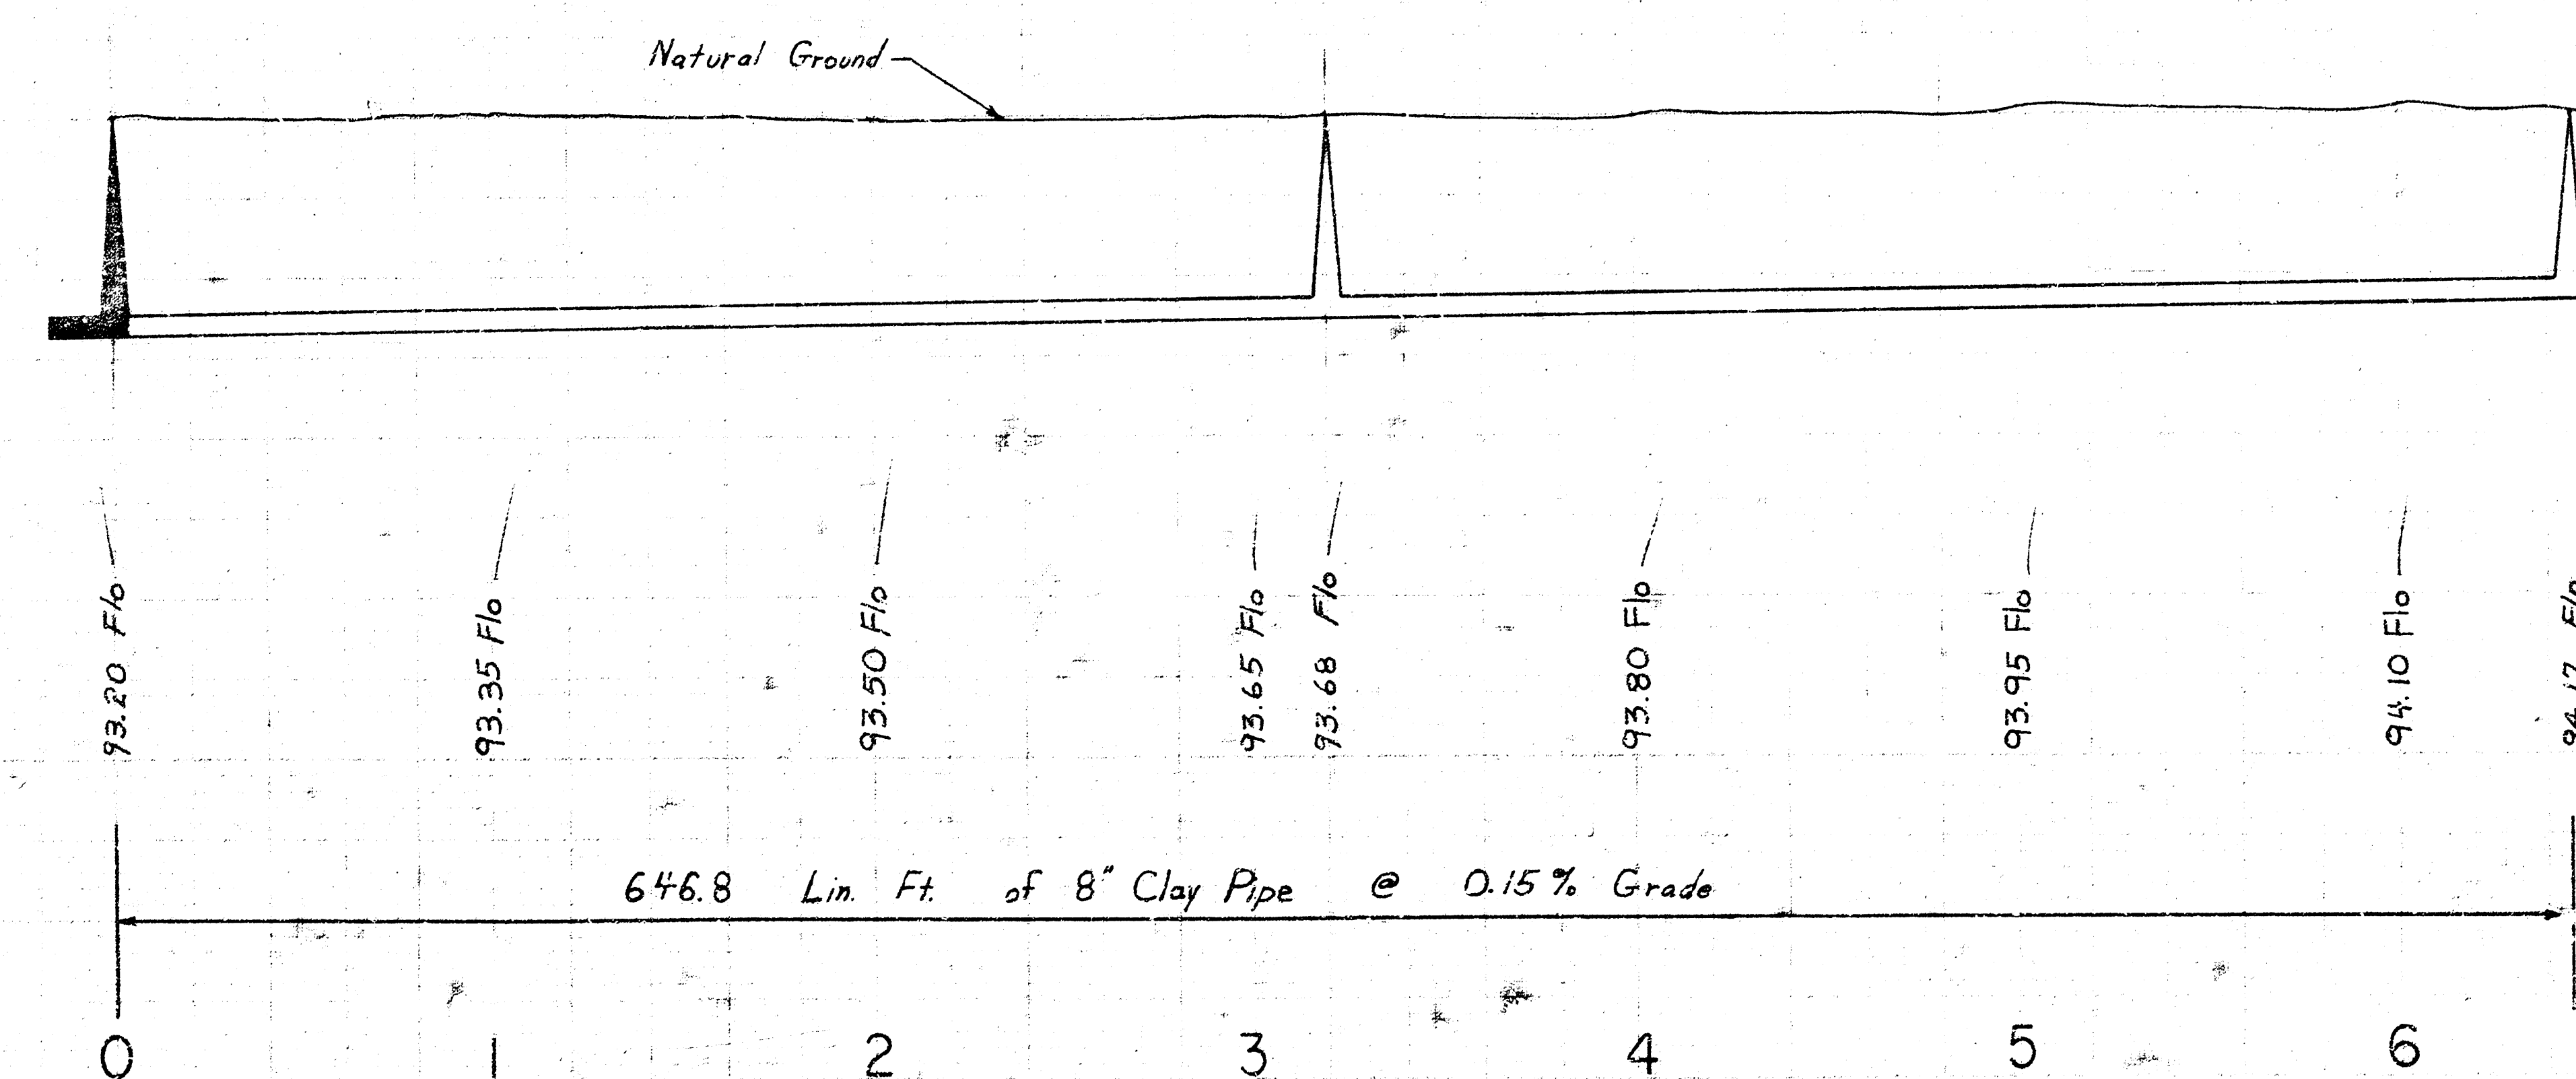

As Built 8-27-75

LAT. 132 S.S. NO. 22  
CITY OF WICHITA, KANSAS  
R. W. LINN CITY ENGINEER  
PROJECT NO. DBKL 575032

