



B.M. = 111.49' R.R. SPIKE IN N.E. SIDE OF P. POLE @ S.W. CORNER OF MCCOMAS & HARRY ST.
 B.M. = 112.15' CHISEL MARK IN N.E. CORNER OF CONC. SIDEWALK @ S. ENTRANCE TO PLASTIC FAB CO., 1650 MCCOMAS AVE.
 B.M. = 112.15' R.R. SPIKE IN N. SIDE OF P. POLE APPROX. 40' S. & 35' W. OF E. BOUND WEST & BOUNOUS.

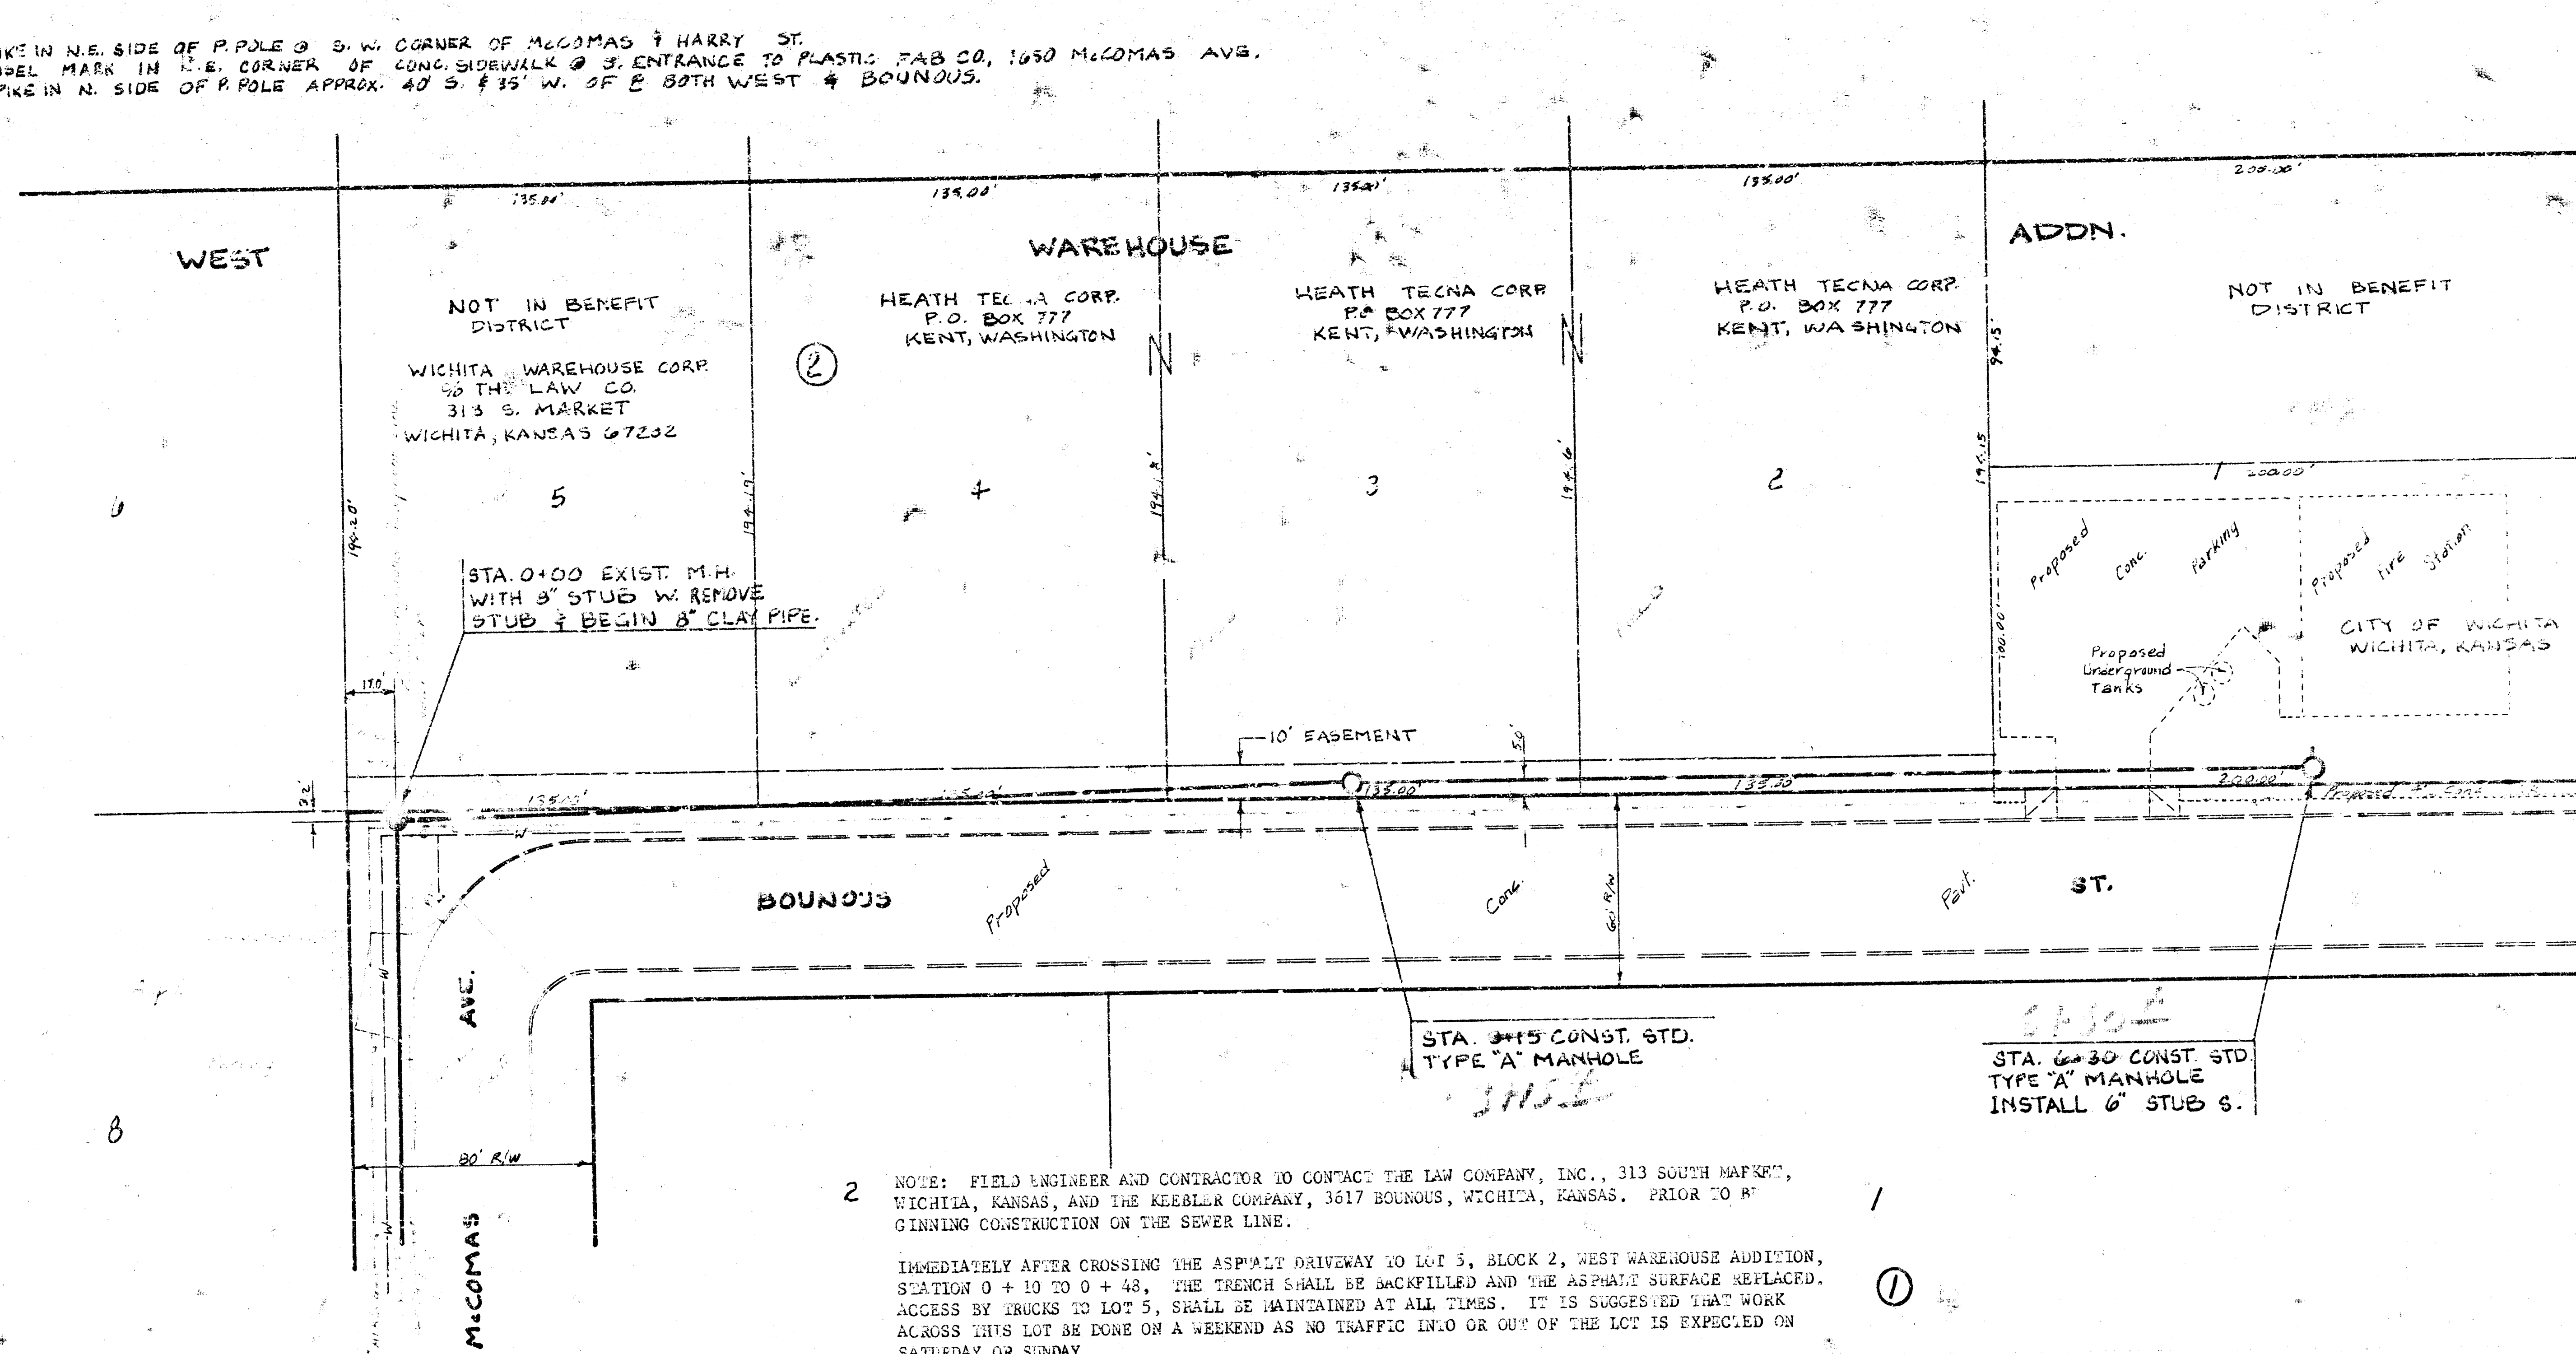

2 NOTE: FIELD ENGINEER AND CONTRACTOR TO CONTACT THE LAW COMPANY, INC., 313 SOUTH MARKET, WICHITA, KANSAS, AND THE KEEBLER COMPANY, 3617 BOUNOUS, WICHITA, KANSAS. PRIOR TO BEGINNING CONSTRUCTION ON THE SEWER LINE.

IMMEDIATELY AFTER CROSSING THE ASPHALT DRIVEWAY TO LOT 5, BLOCK 2, WEST WAREHOUSE ADDITION, STATION 0 + 10 TO 0 + 48, THE TRENCH SHALL BE BACKFILLED AND THE ASPHALT SURFACE REPLACED. ACCESS BY TRUCKS TO LOT 5, SHALL BE MAINTAINED AT ALL TIMES. IT IS SUGGESTED THAT WORK ACROSS THIS LOT BE DONE ON A WEEKEND AS NO TRAFFIC INTO OR OUT OF THE LOT IS EXPECTED ON SATURDAY OR SUNDAY.

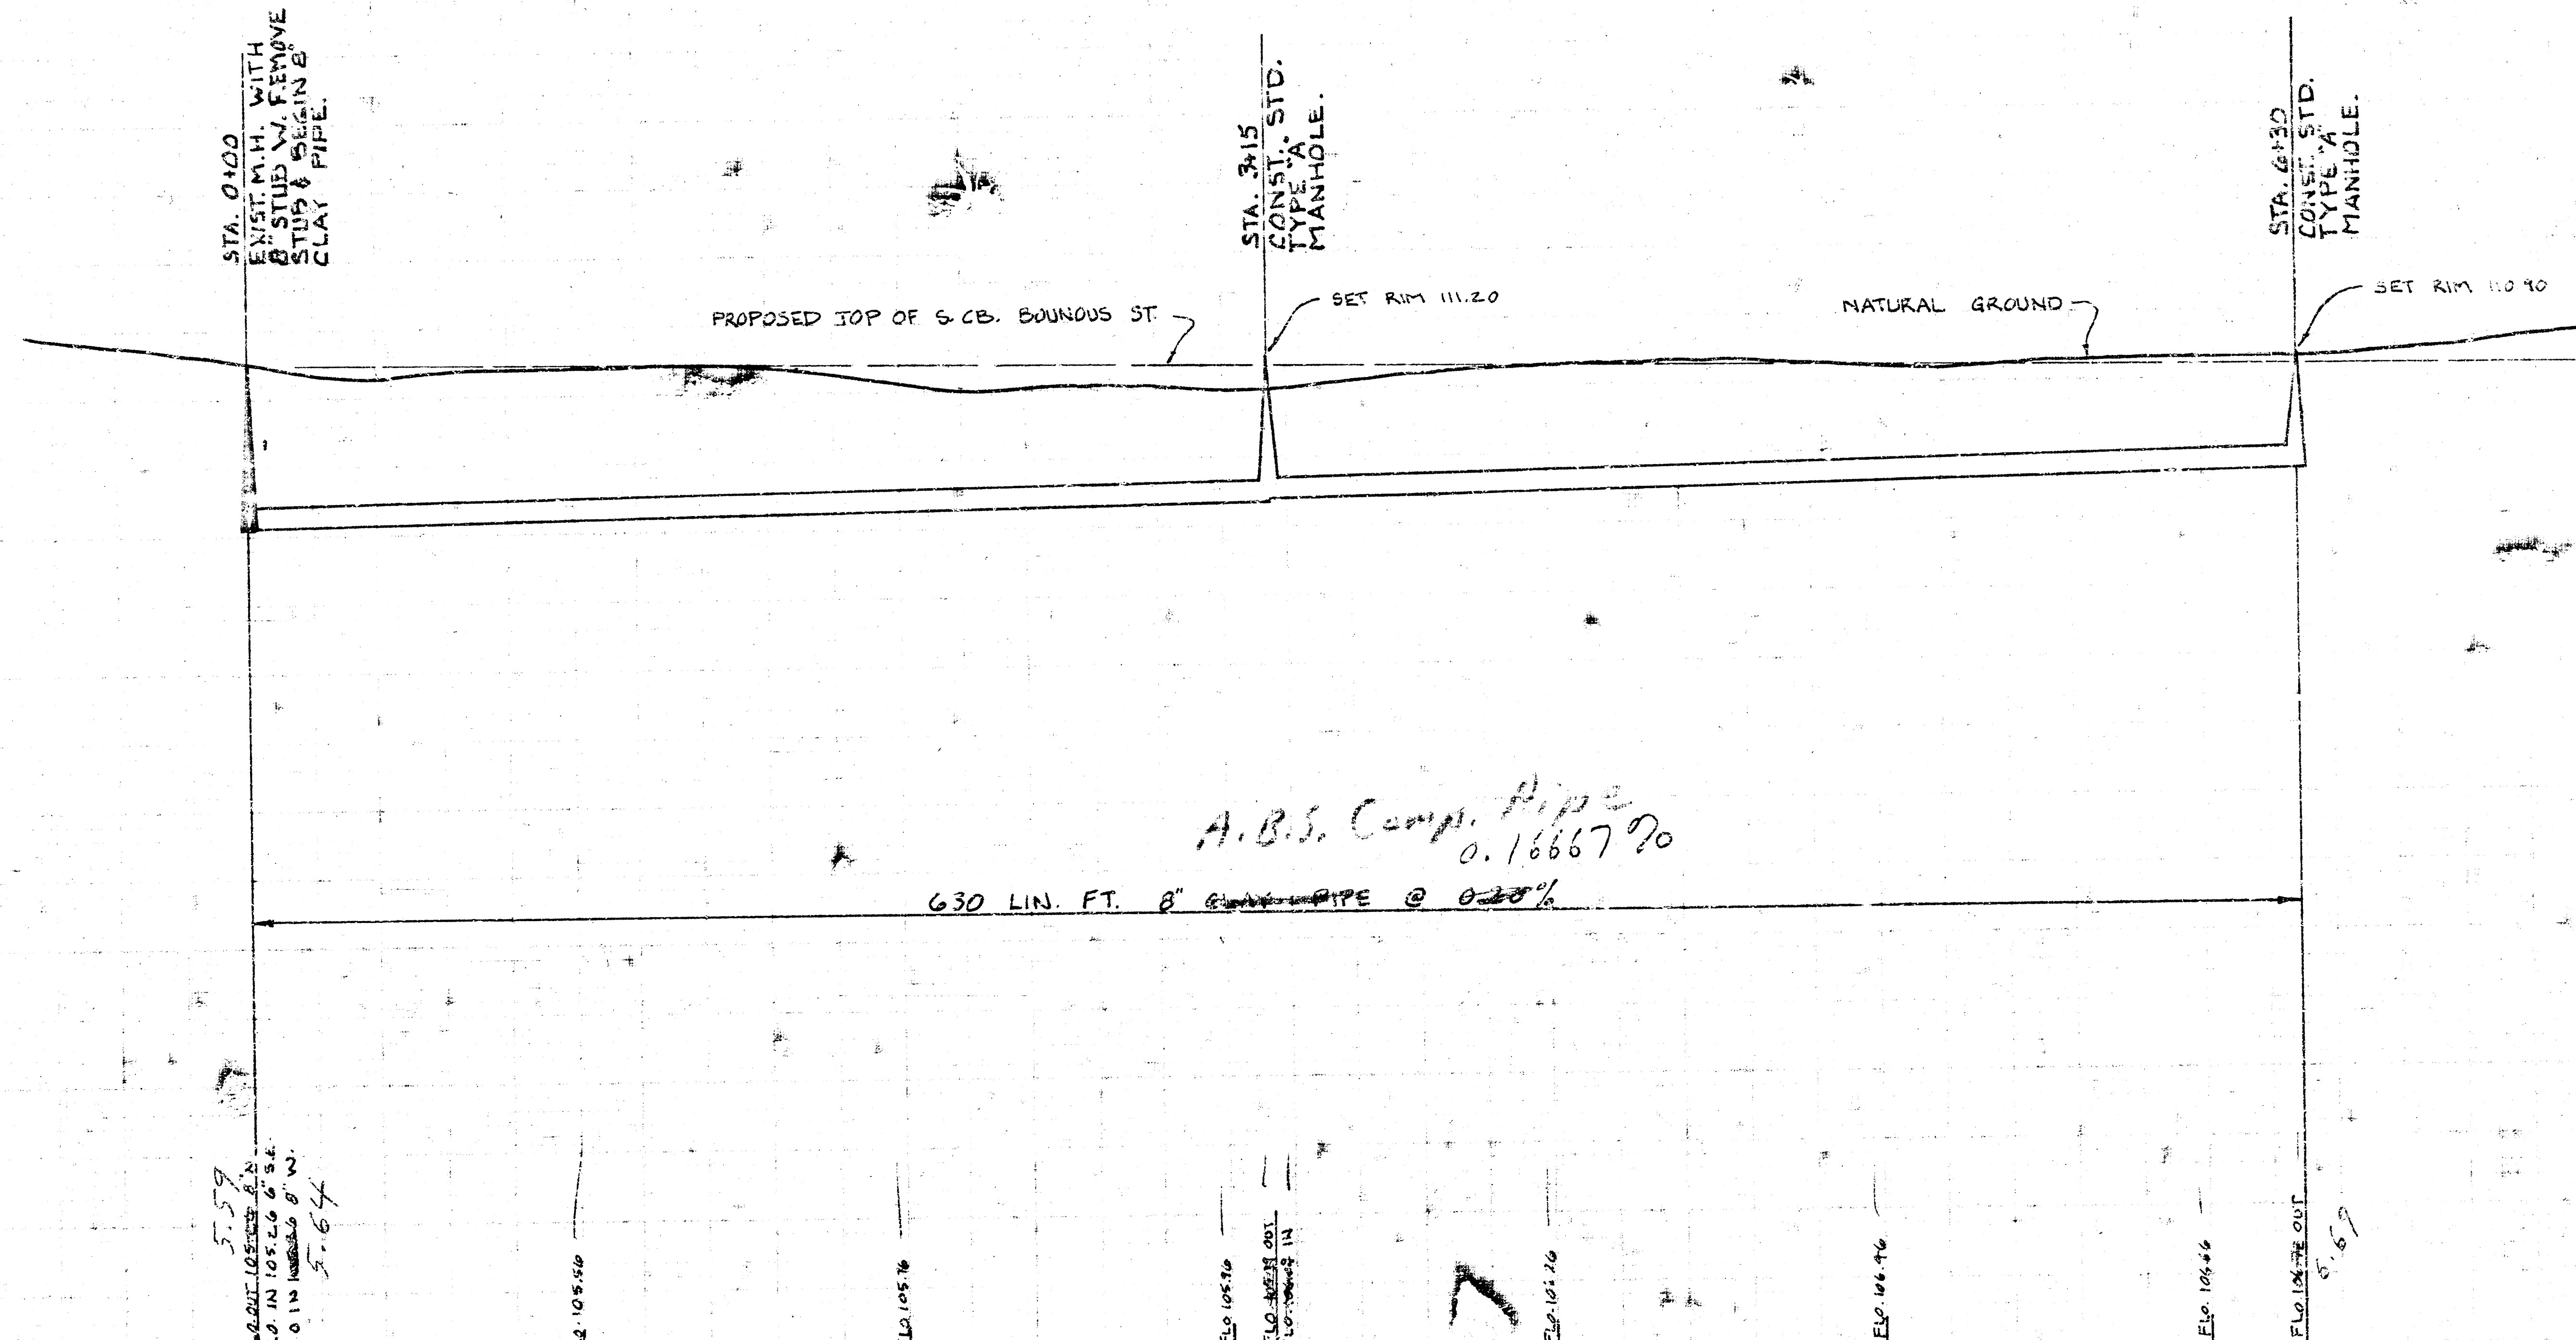

A.B.S. Comp. Pipe
 0.16667%

630 LIN. FT. 8" PIPE @ 0.28%

As built 5-17-78

LAT 137	15.S.22
CITY OF WICHITA, KANSAS	
R.W. LINN	CITY ENGINEER
DATE: _____	PROJECT NUMBER: DBKL577068