

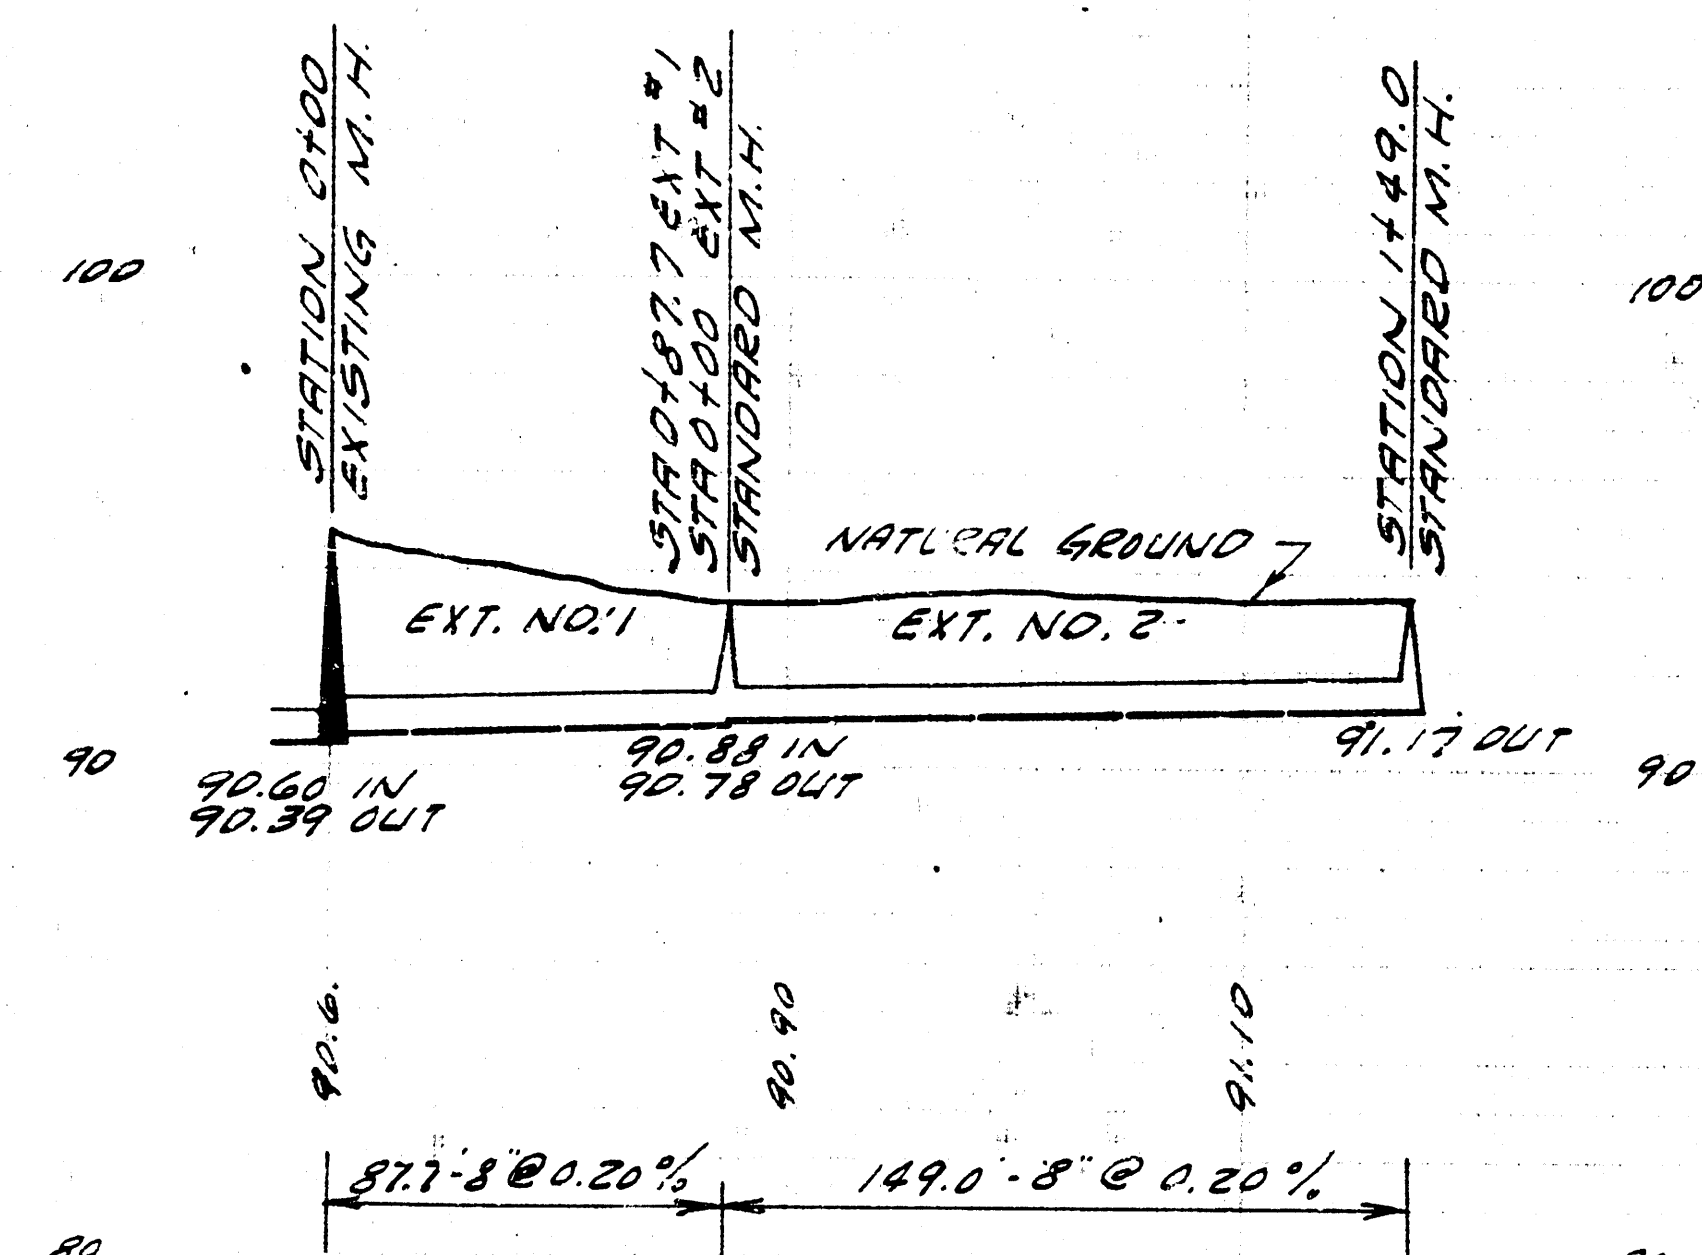


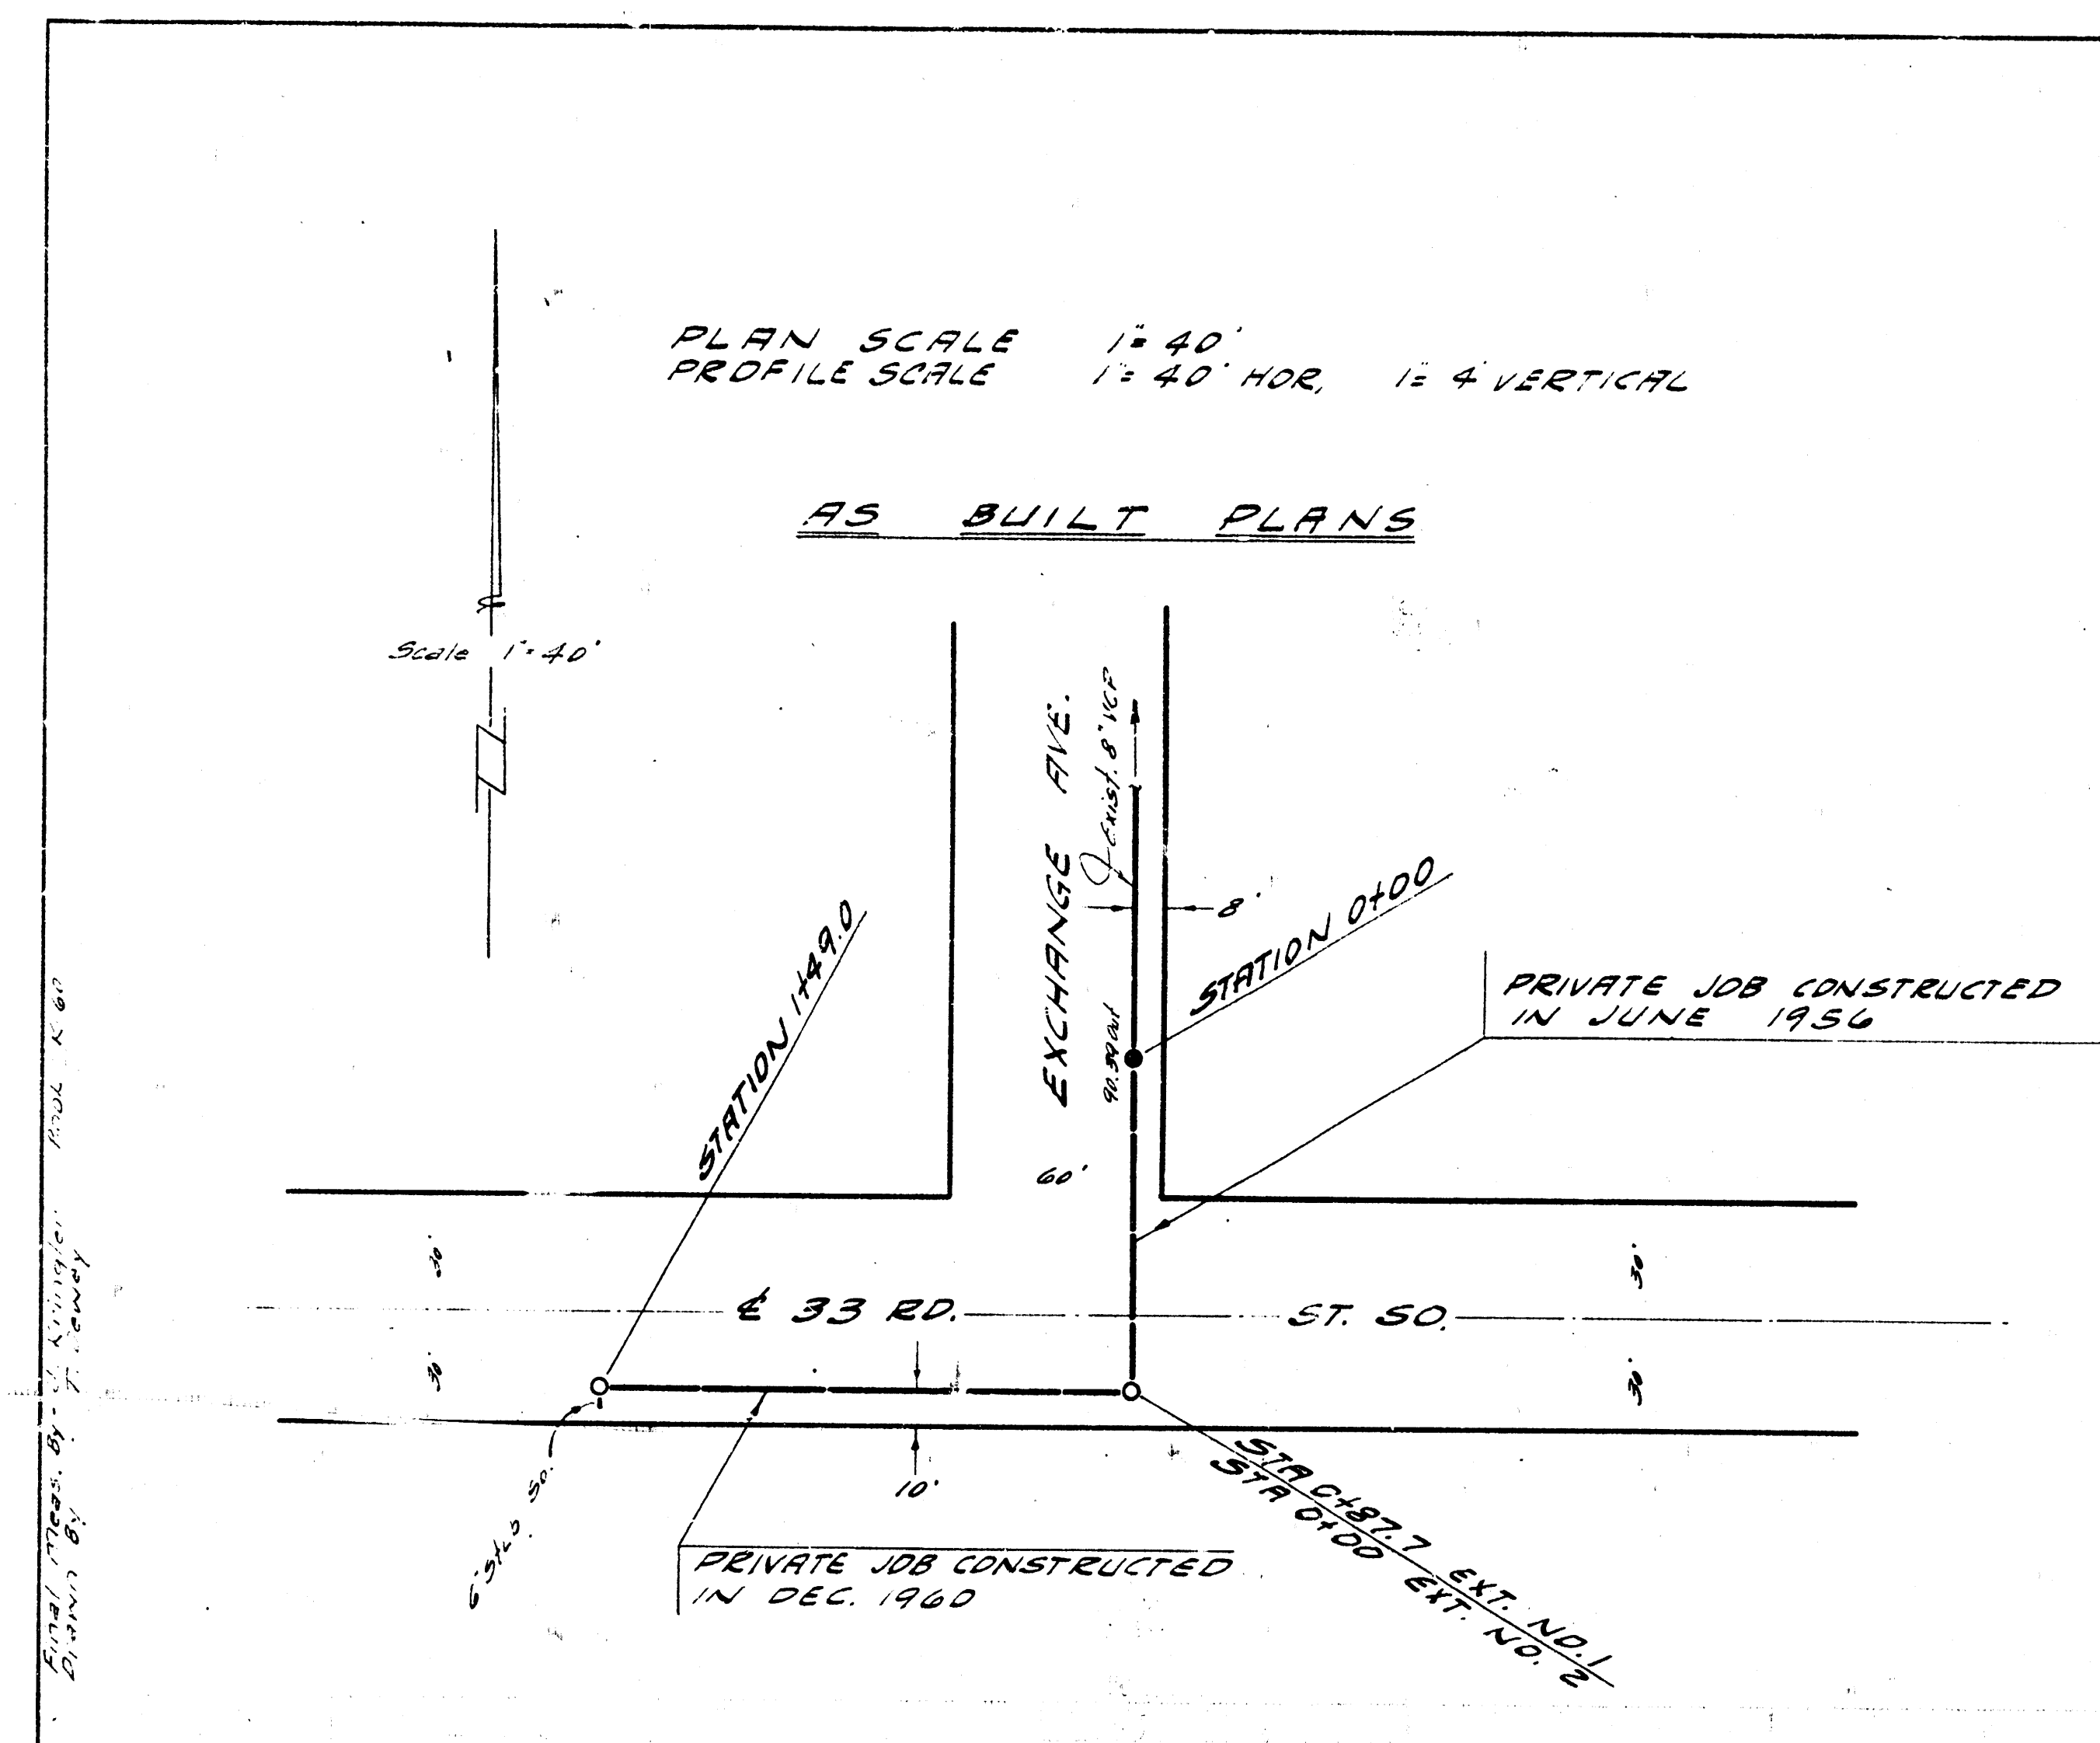


AS BUILT PLANS

EXT. OF LAT. 6 SAN. SEWER 23
CITY OF WICHITA, KANSAS
B.E. SMITH CITY ENGINEER
PRIVATE JOB DEC. 1960

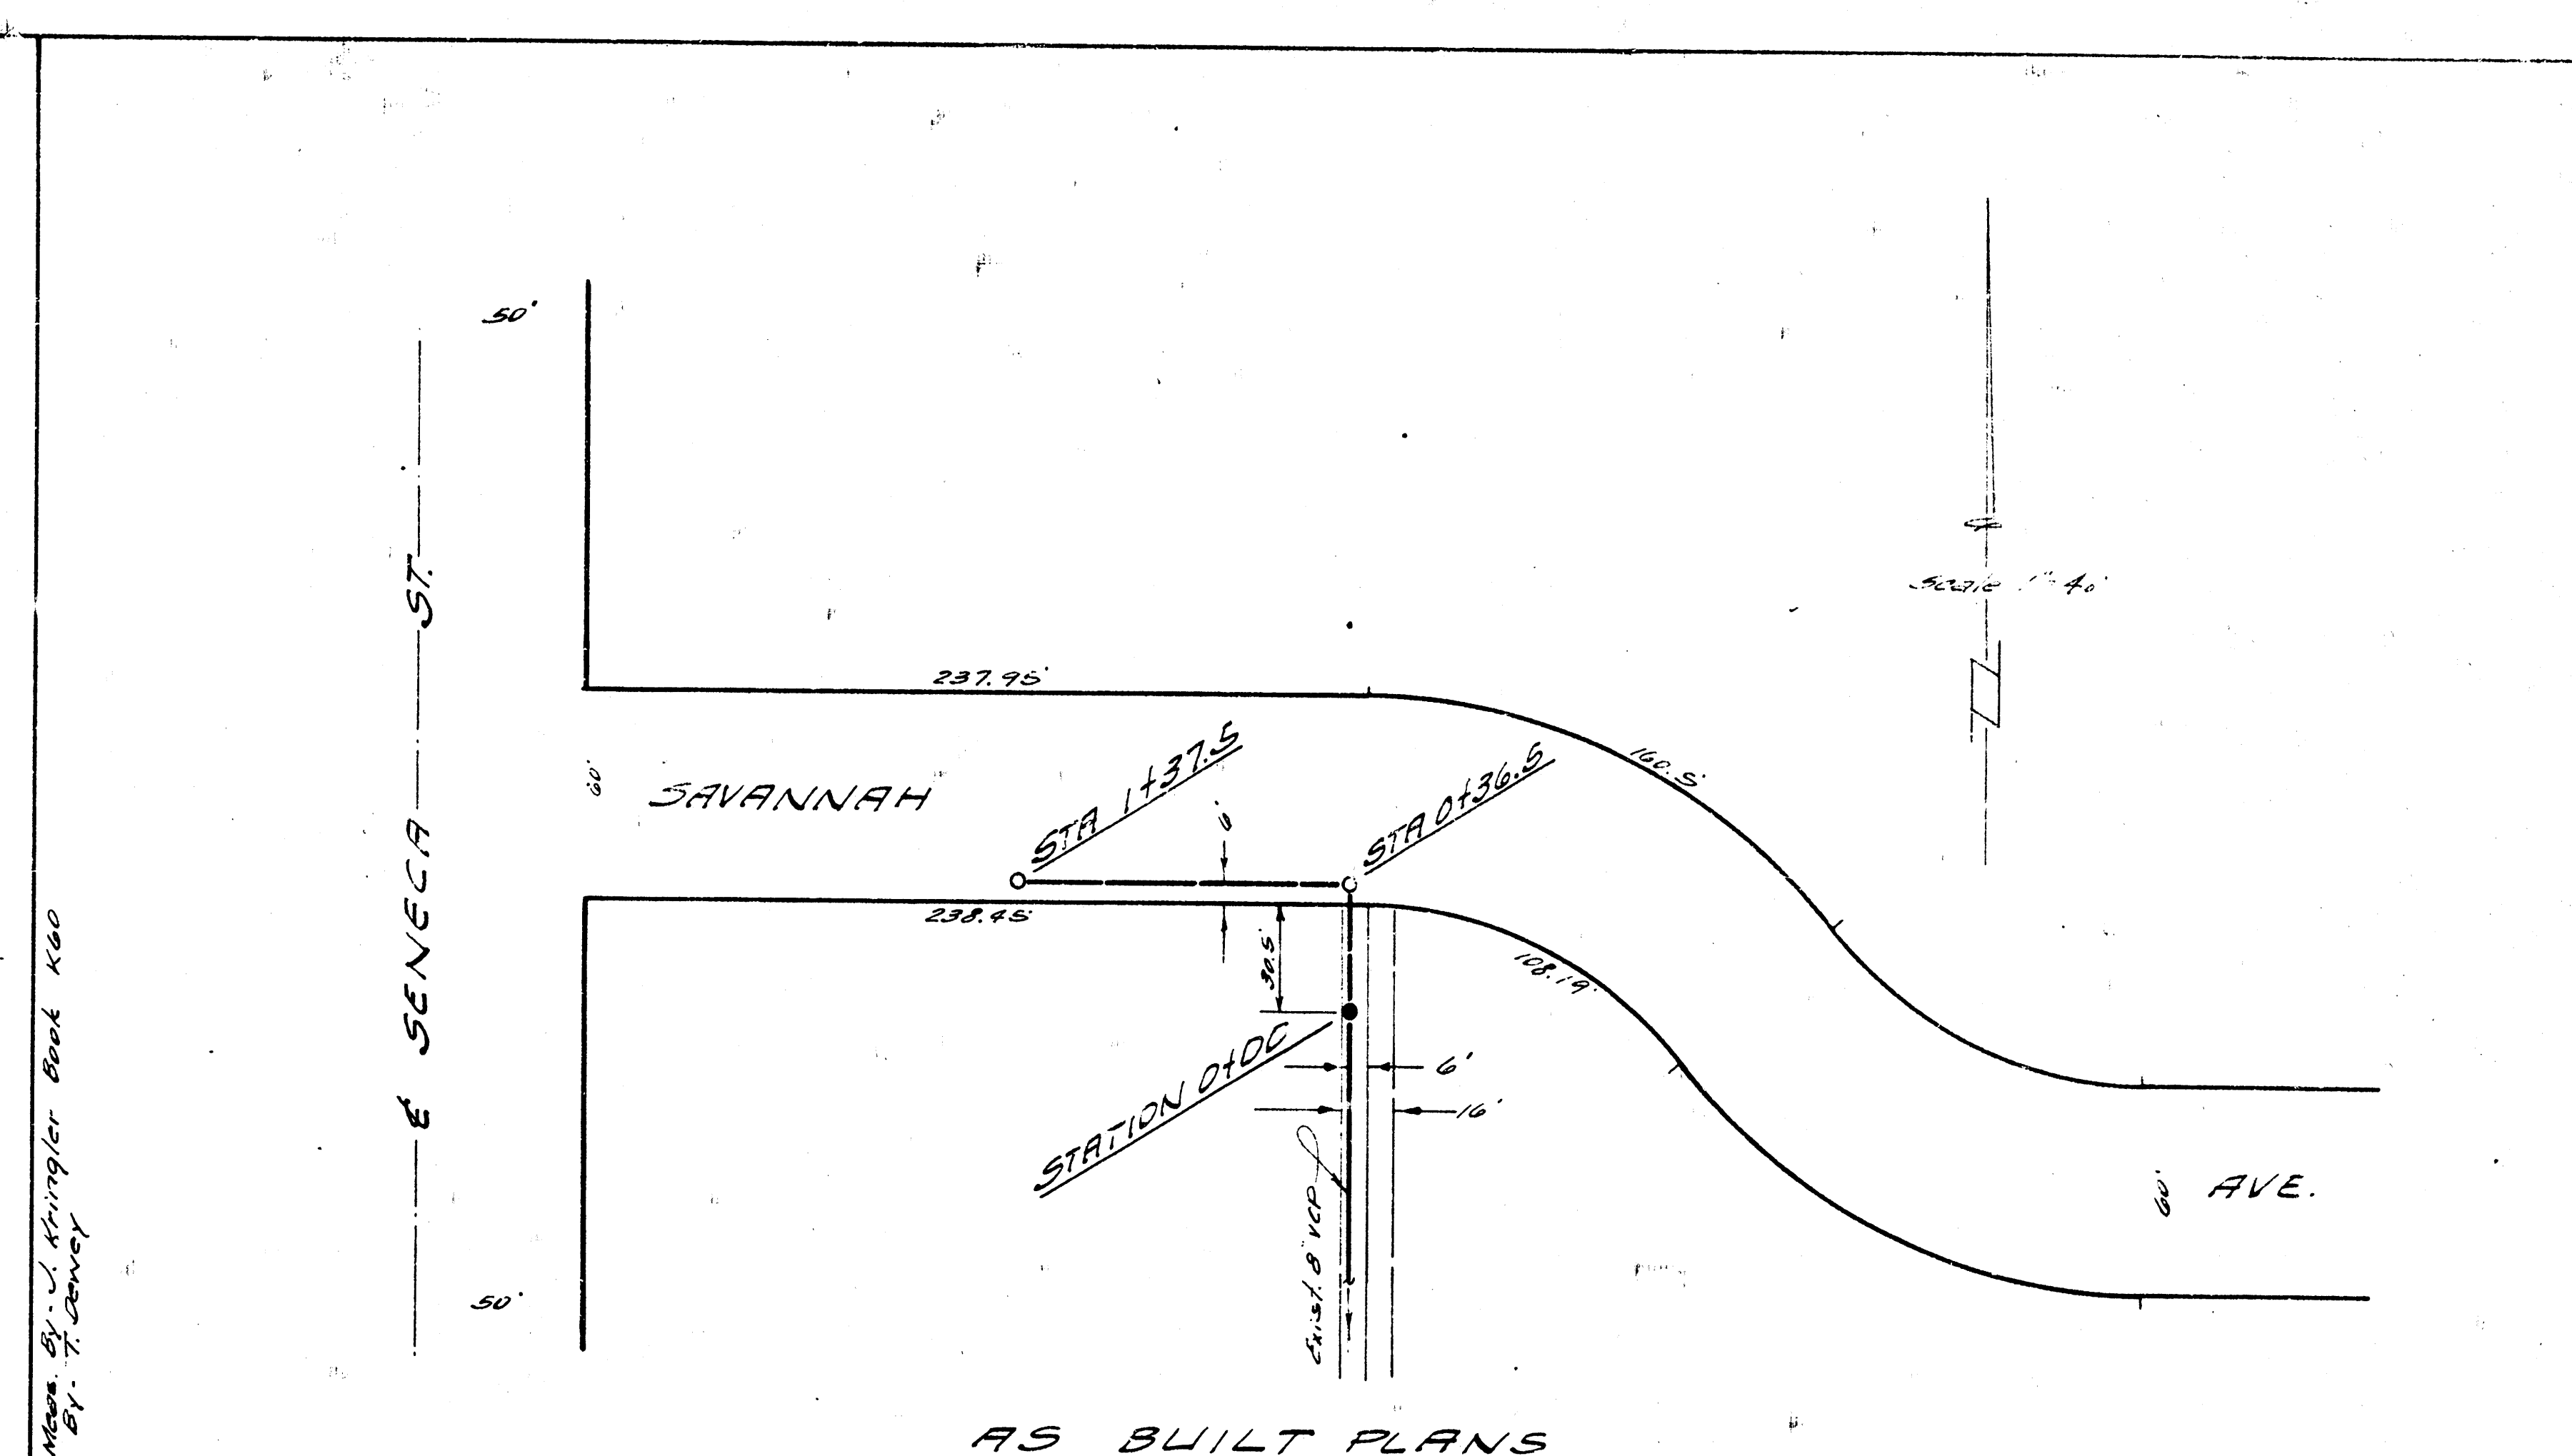

PLAN SCALE 1"=40'
PROFILE SCALE 1"=40' HOR. 1"=4' VERTICAL

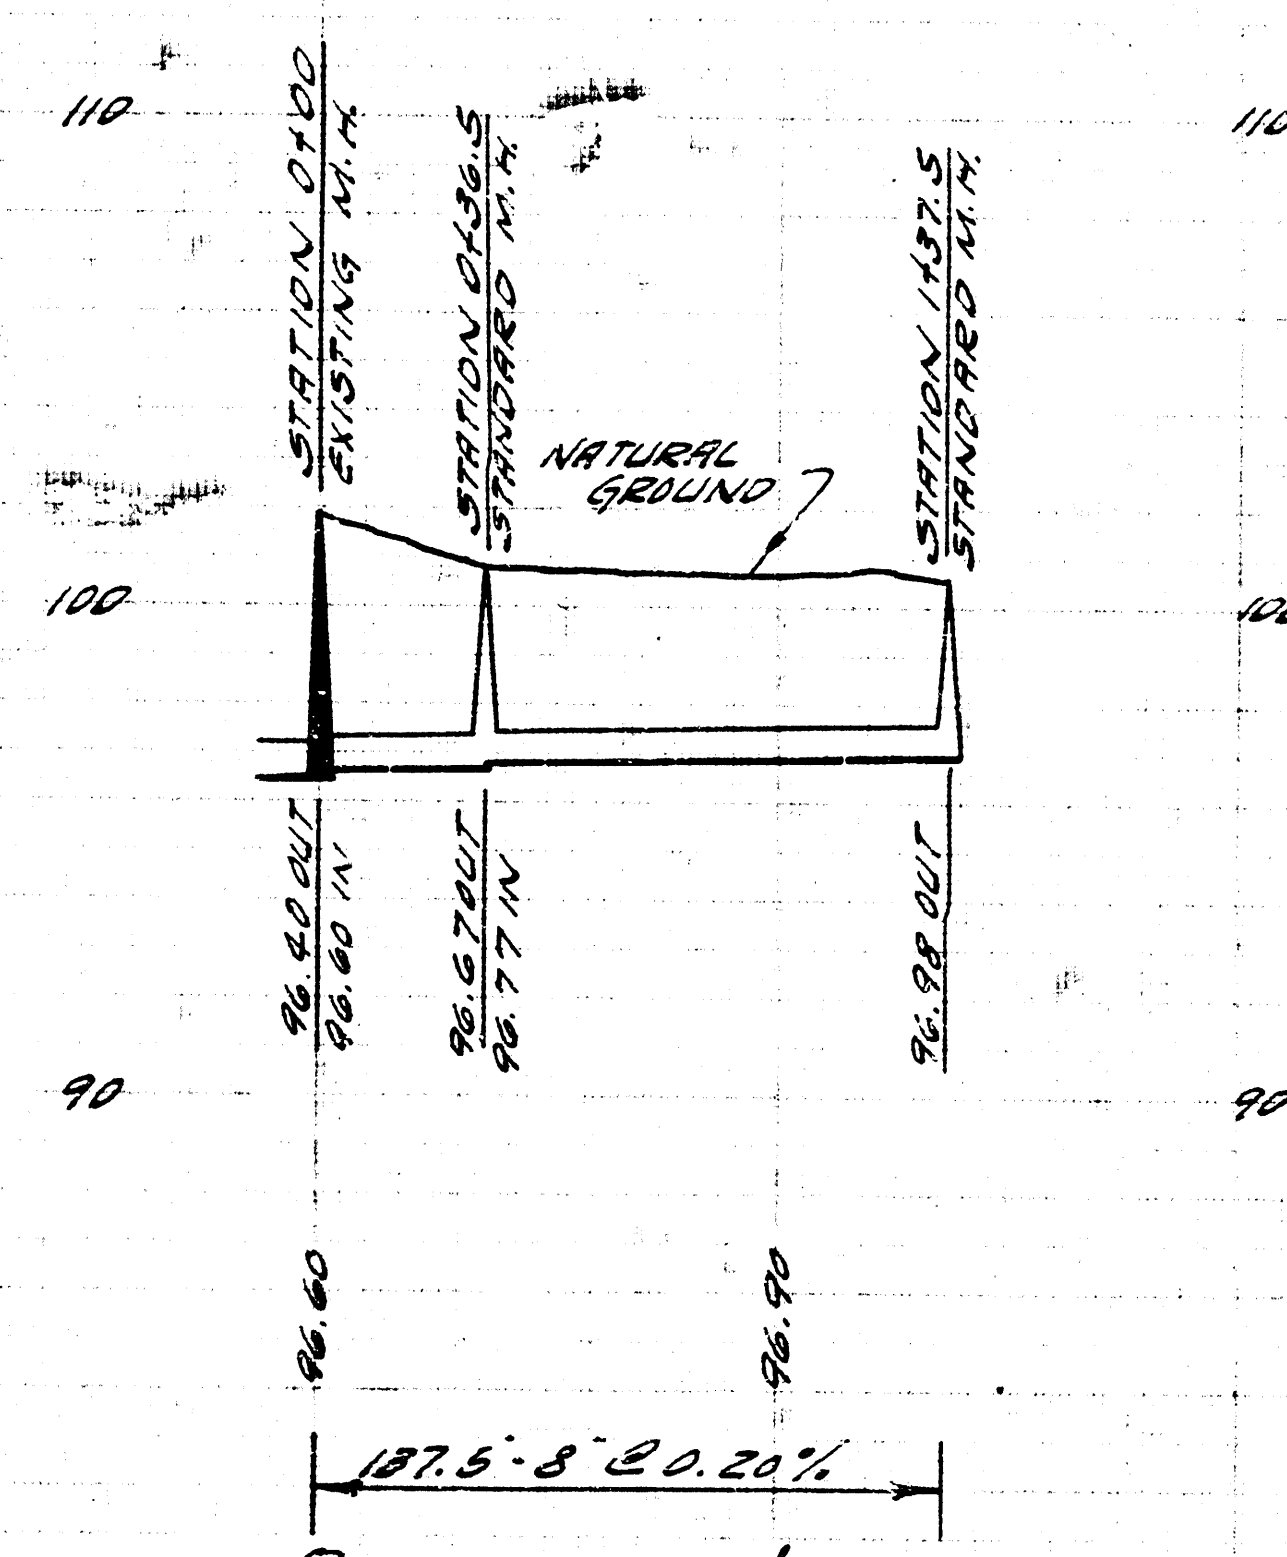

AS BUILT PLANS

PRIVATE SAN. SEWER AT SE
COR. SENECA & SAVANNAH
B.E. SMITH CITY ENGINEER
CITY OF WICHITA, KANSAS
PRIVATE JOB DEC. 1960