
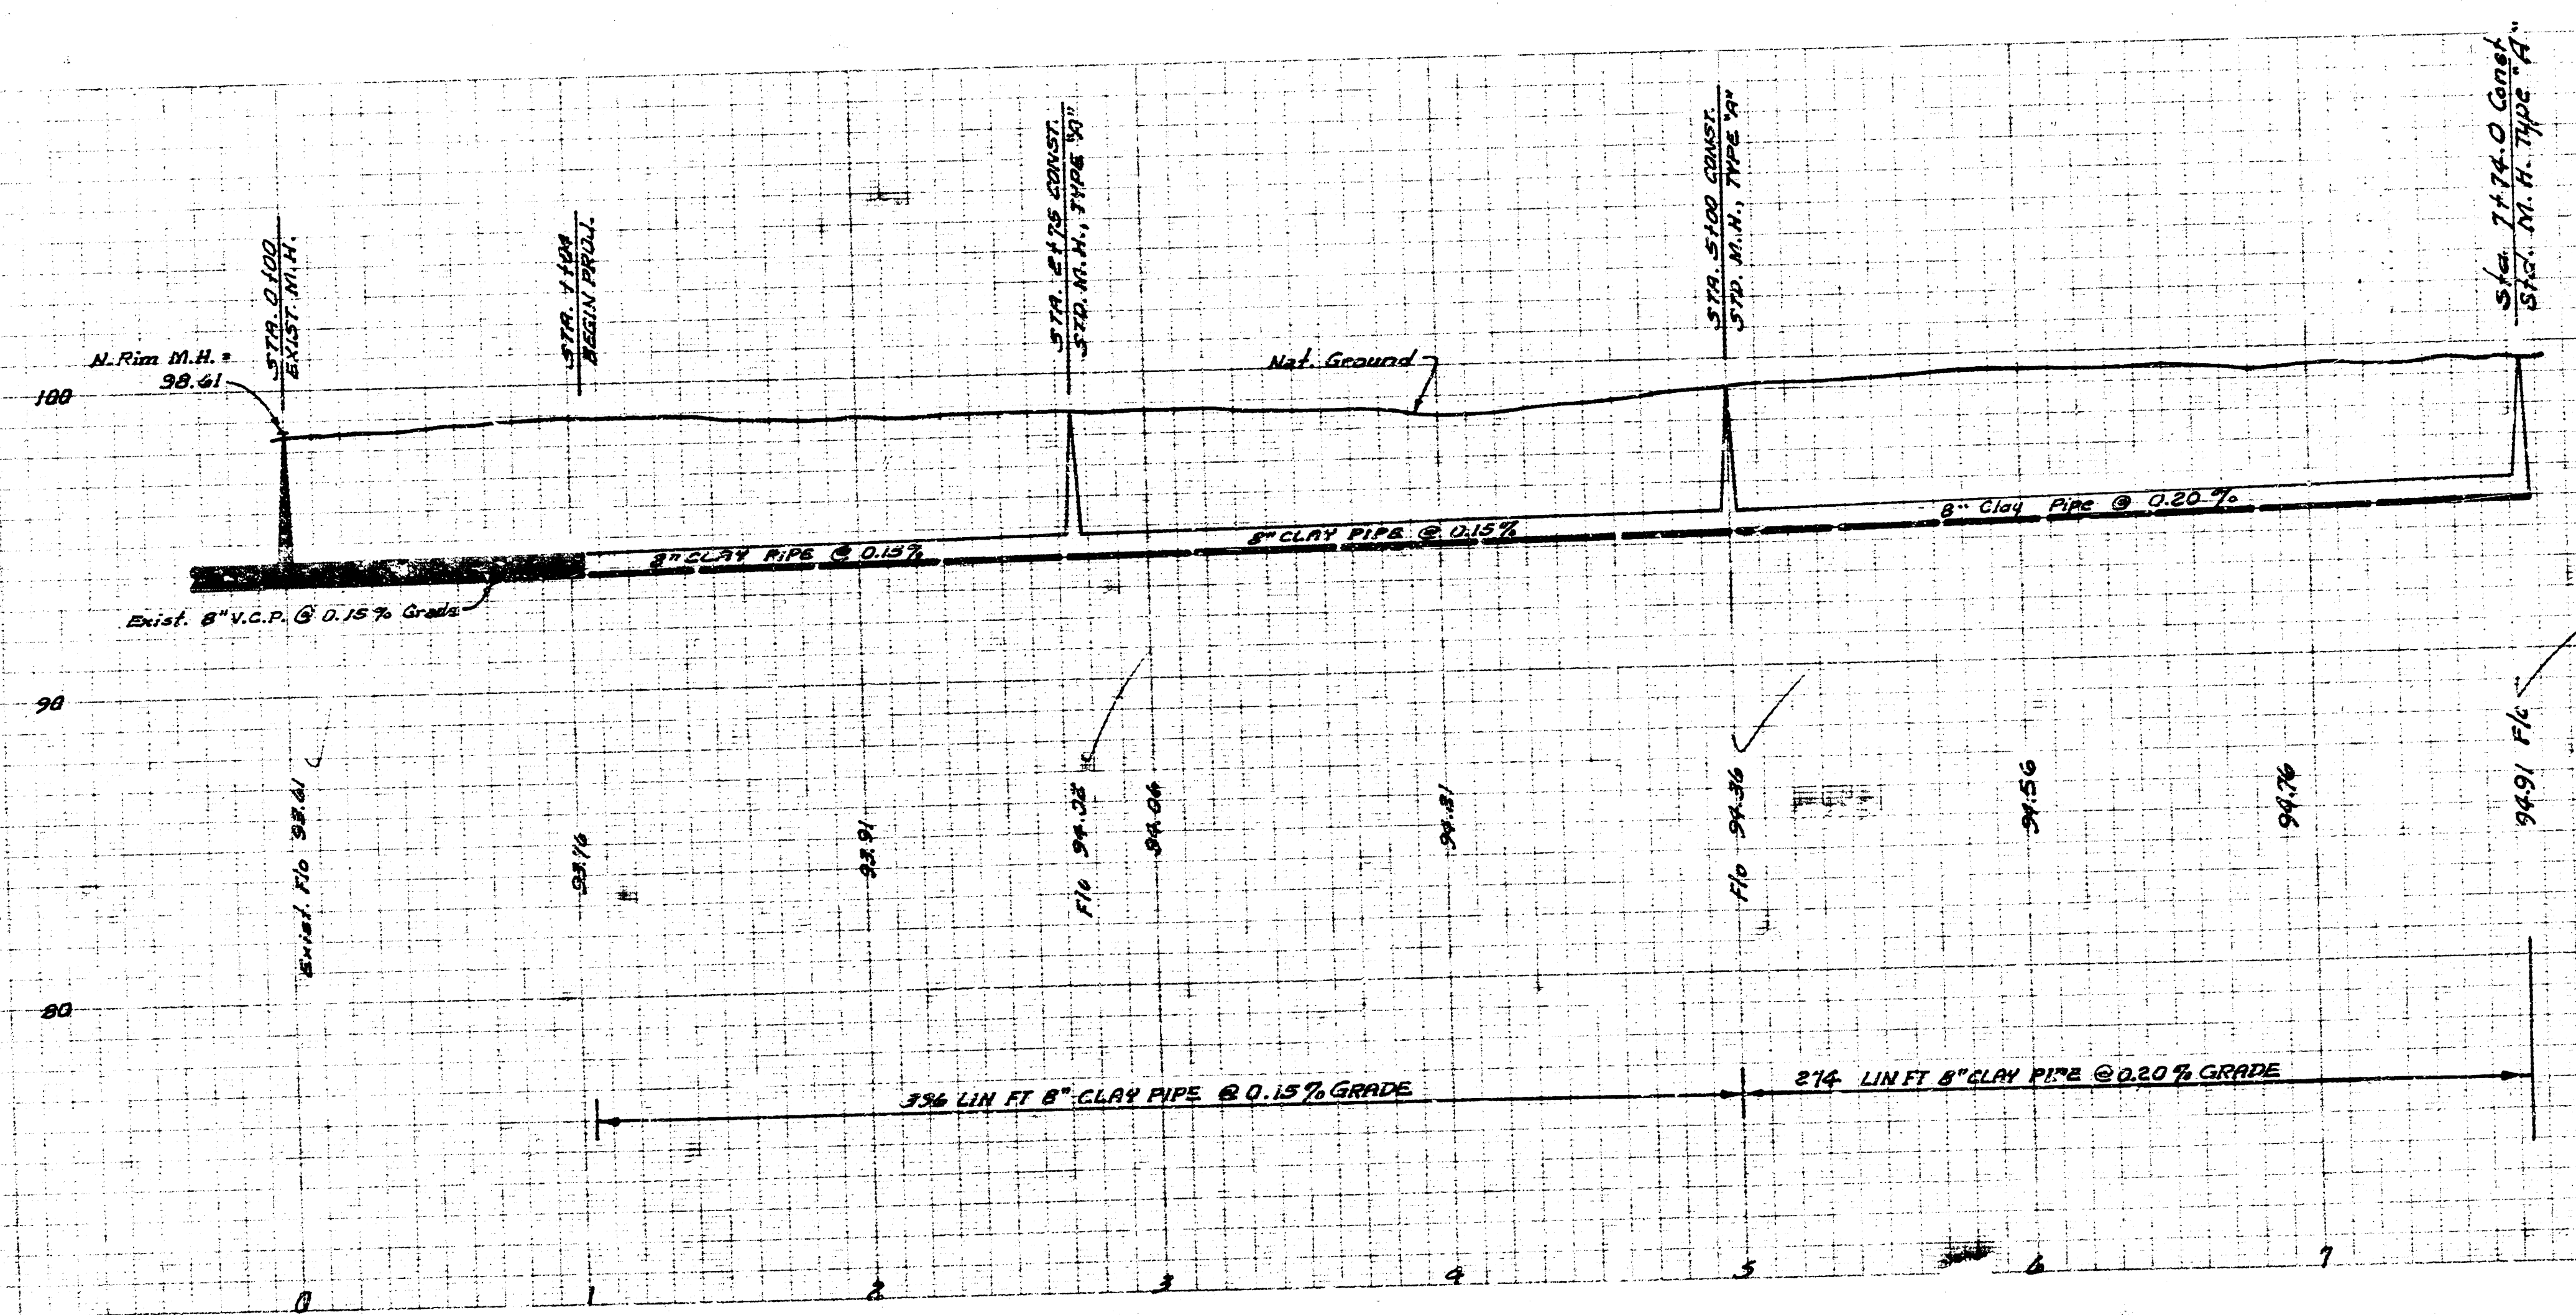


Steve Larson, D.L.L.E.
 Plan, D. Granger
 11/15/73

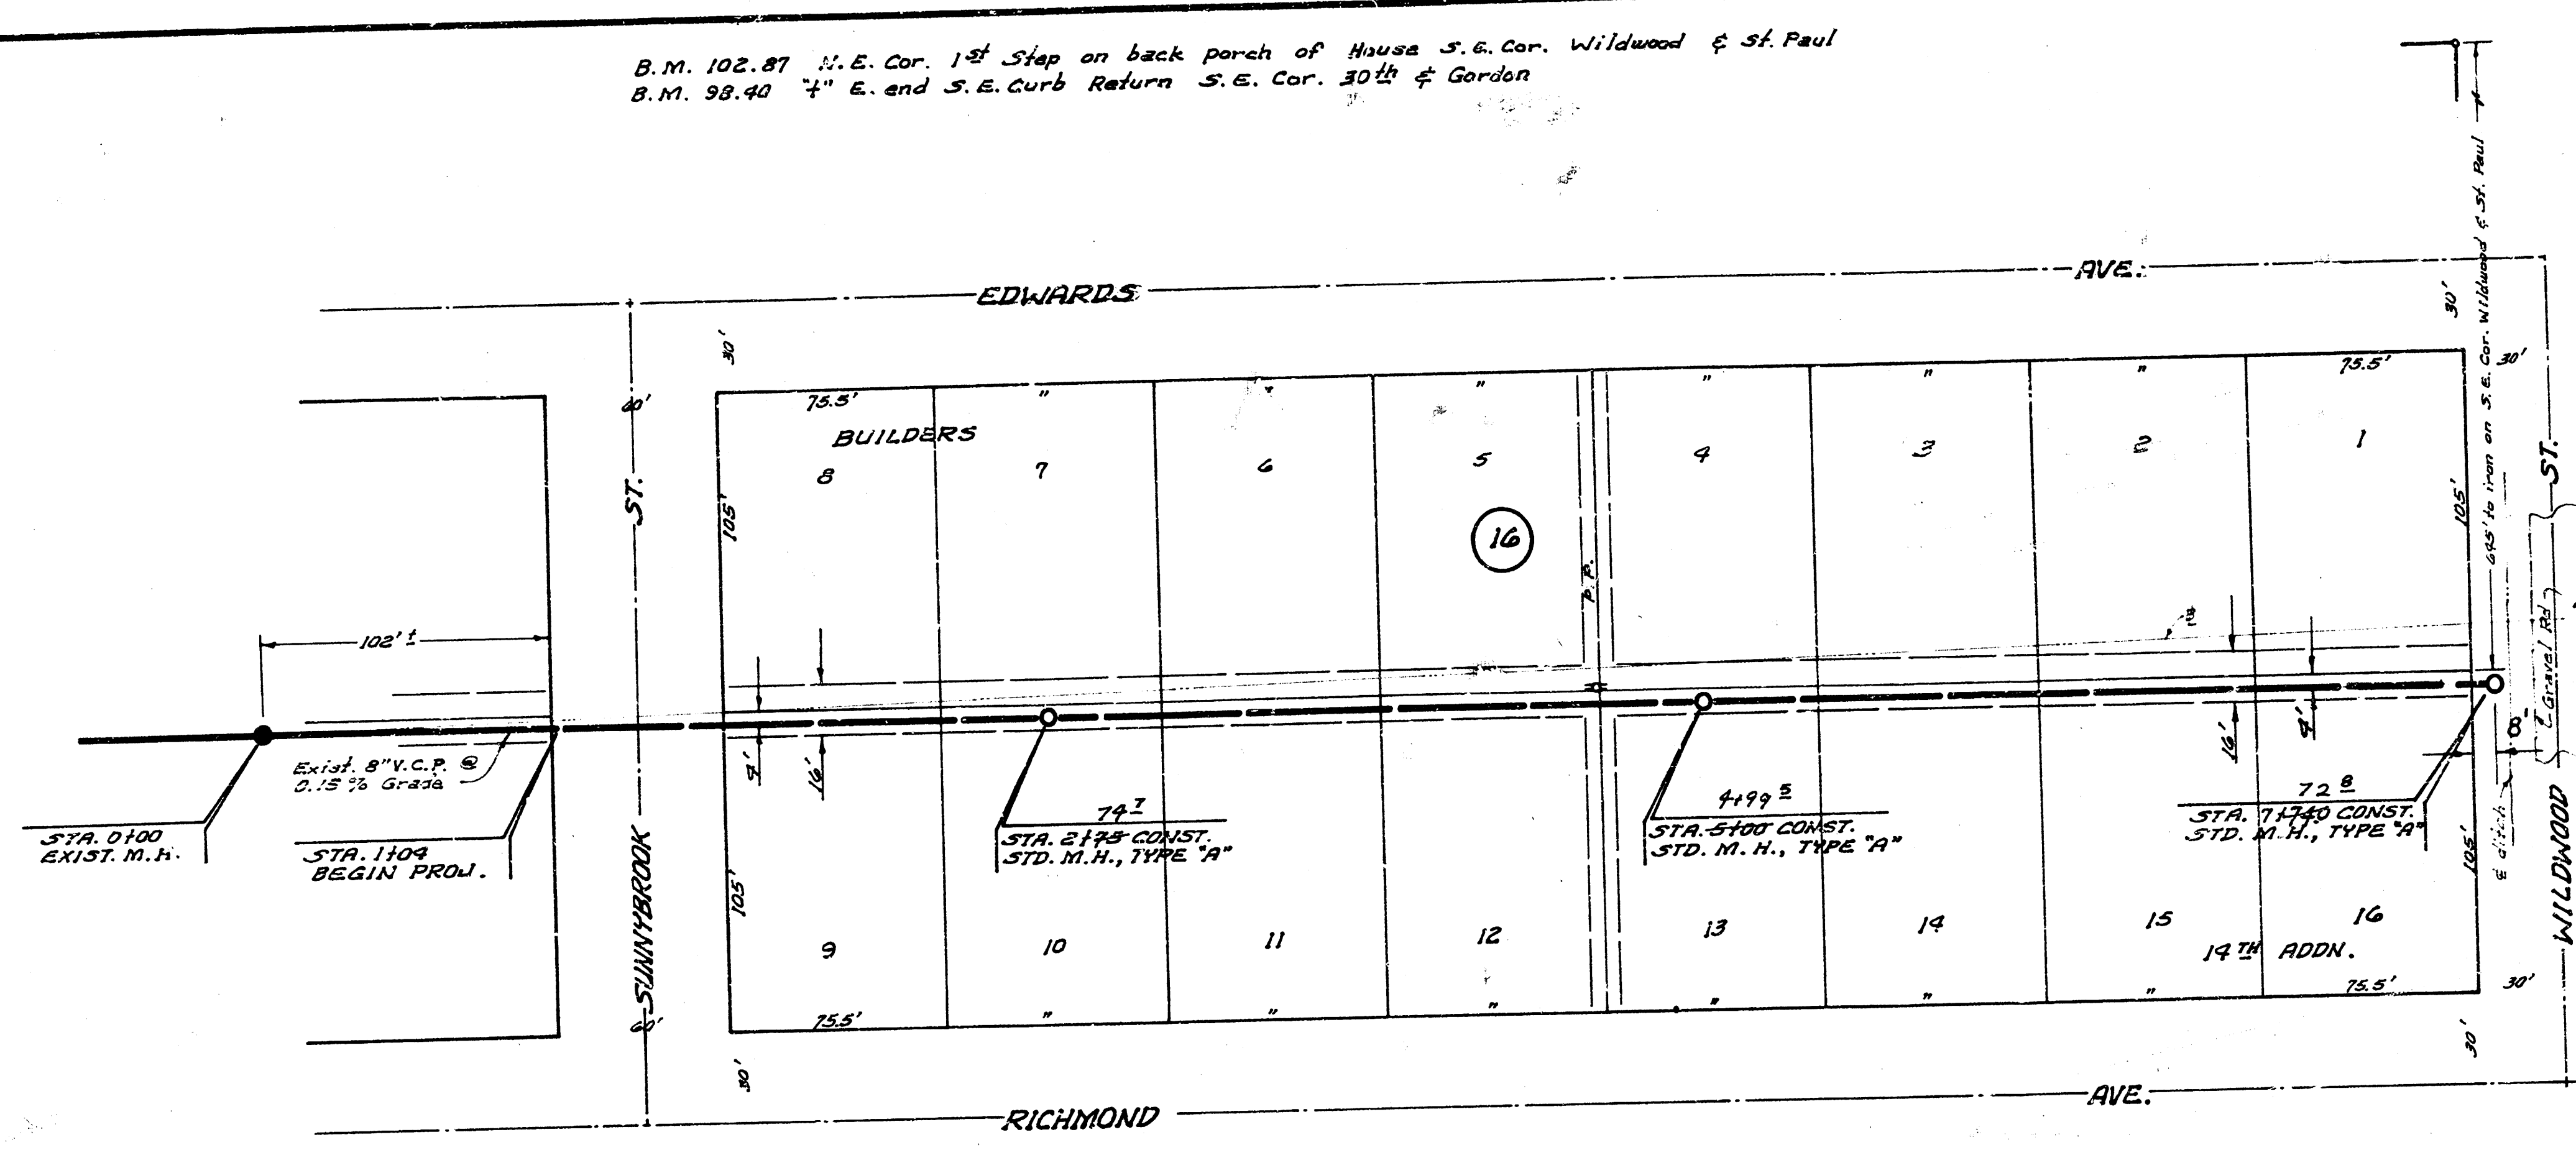

*As Built - Final Meas. 5/11/74 JAK

LAT. 105, SAN. SEWER 22
 CITY OF WICHITA, KANSAS
 R. W. LINN, CITY ENGINEER
 PROJ. NO. DBXL568005
 DATE: NOV. 1973