

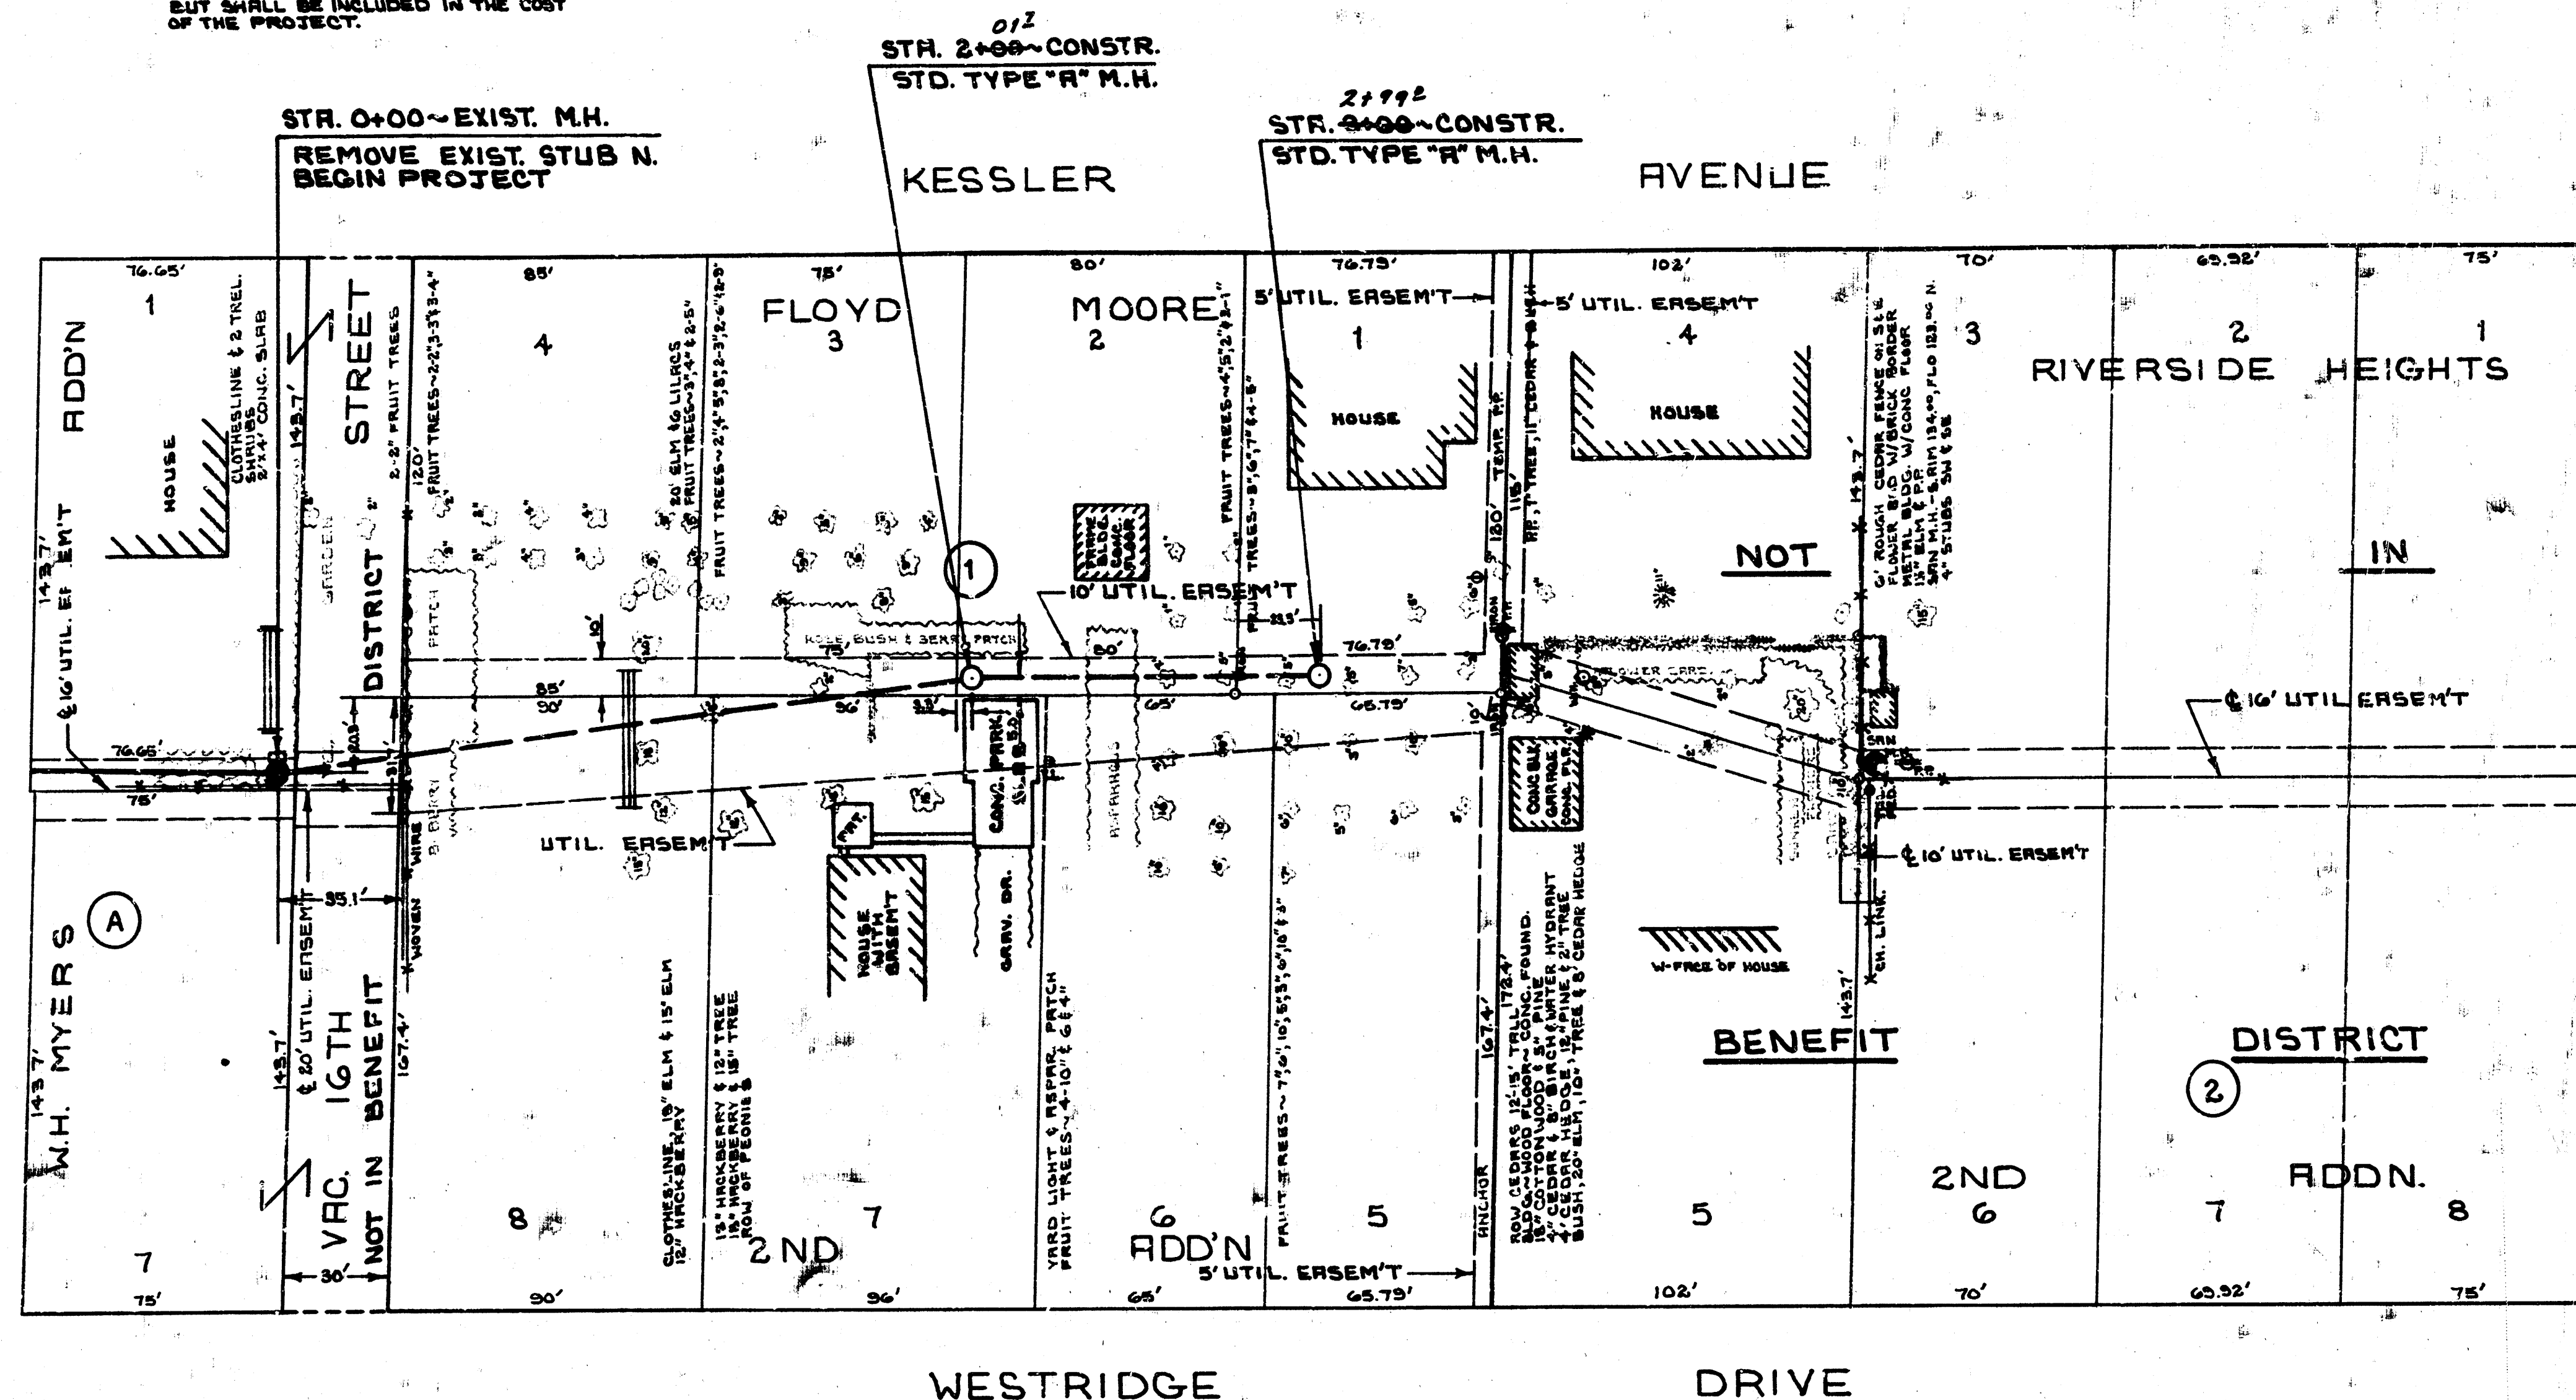
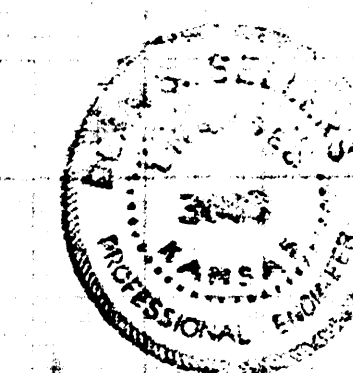


NOTE: REMOVAL OF EXIST. STUB N. SHALL NOT BE PAID FOR DIRECTLY, BUT SHALL BE INCLUDED IN THE COST OF THE PROJECT.

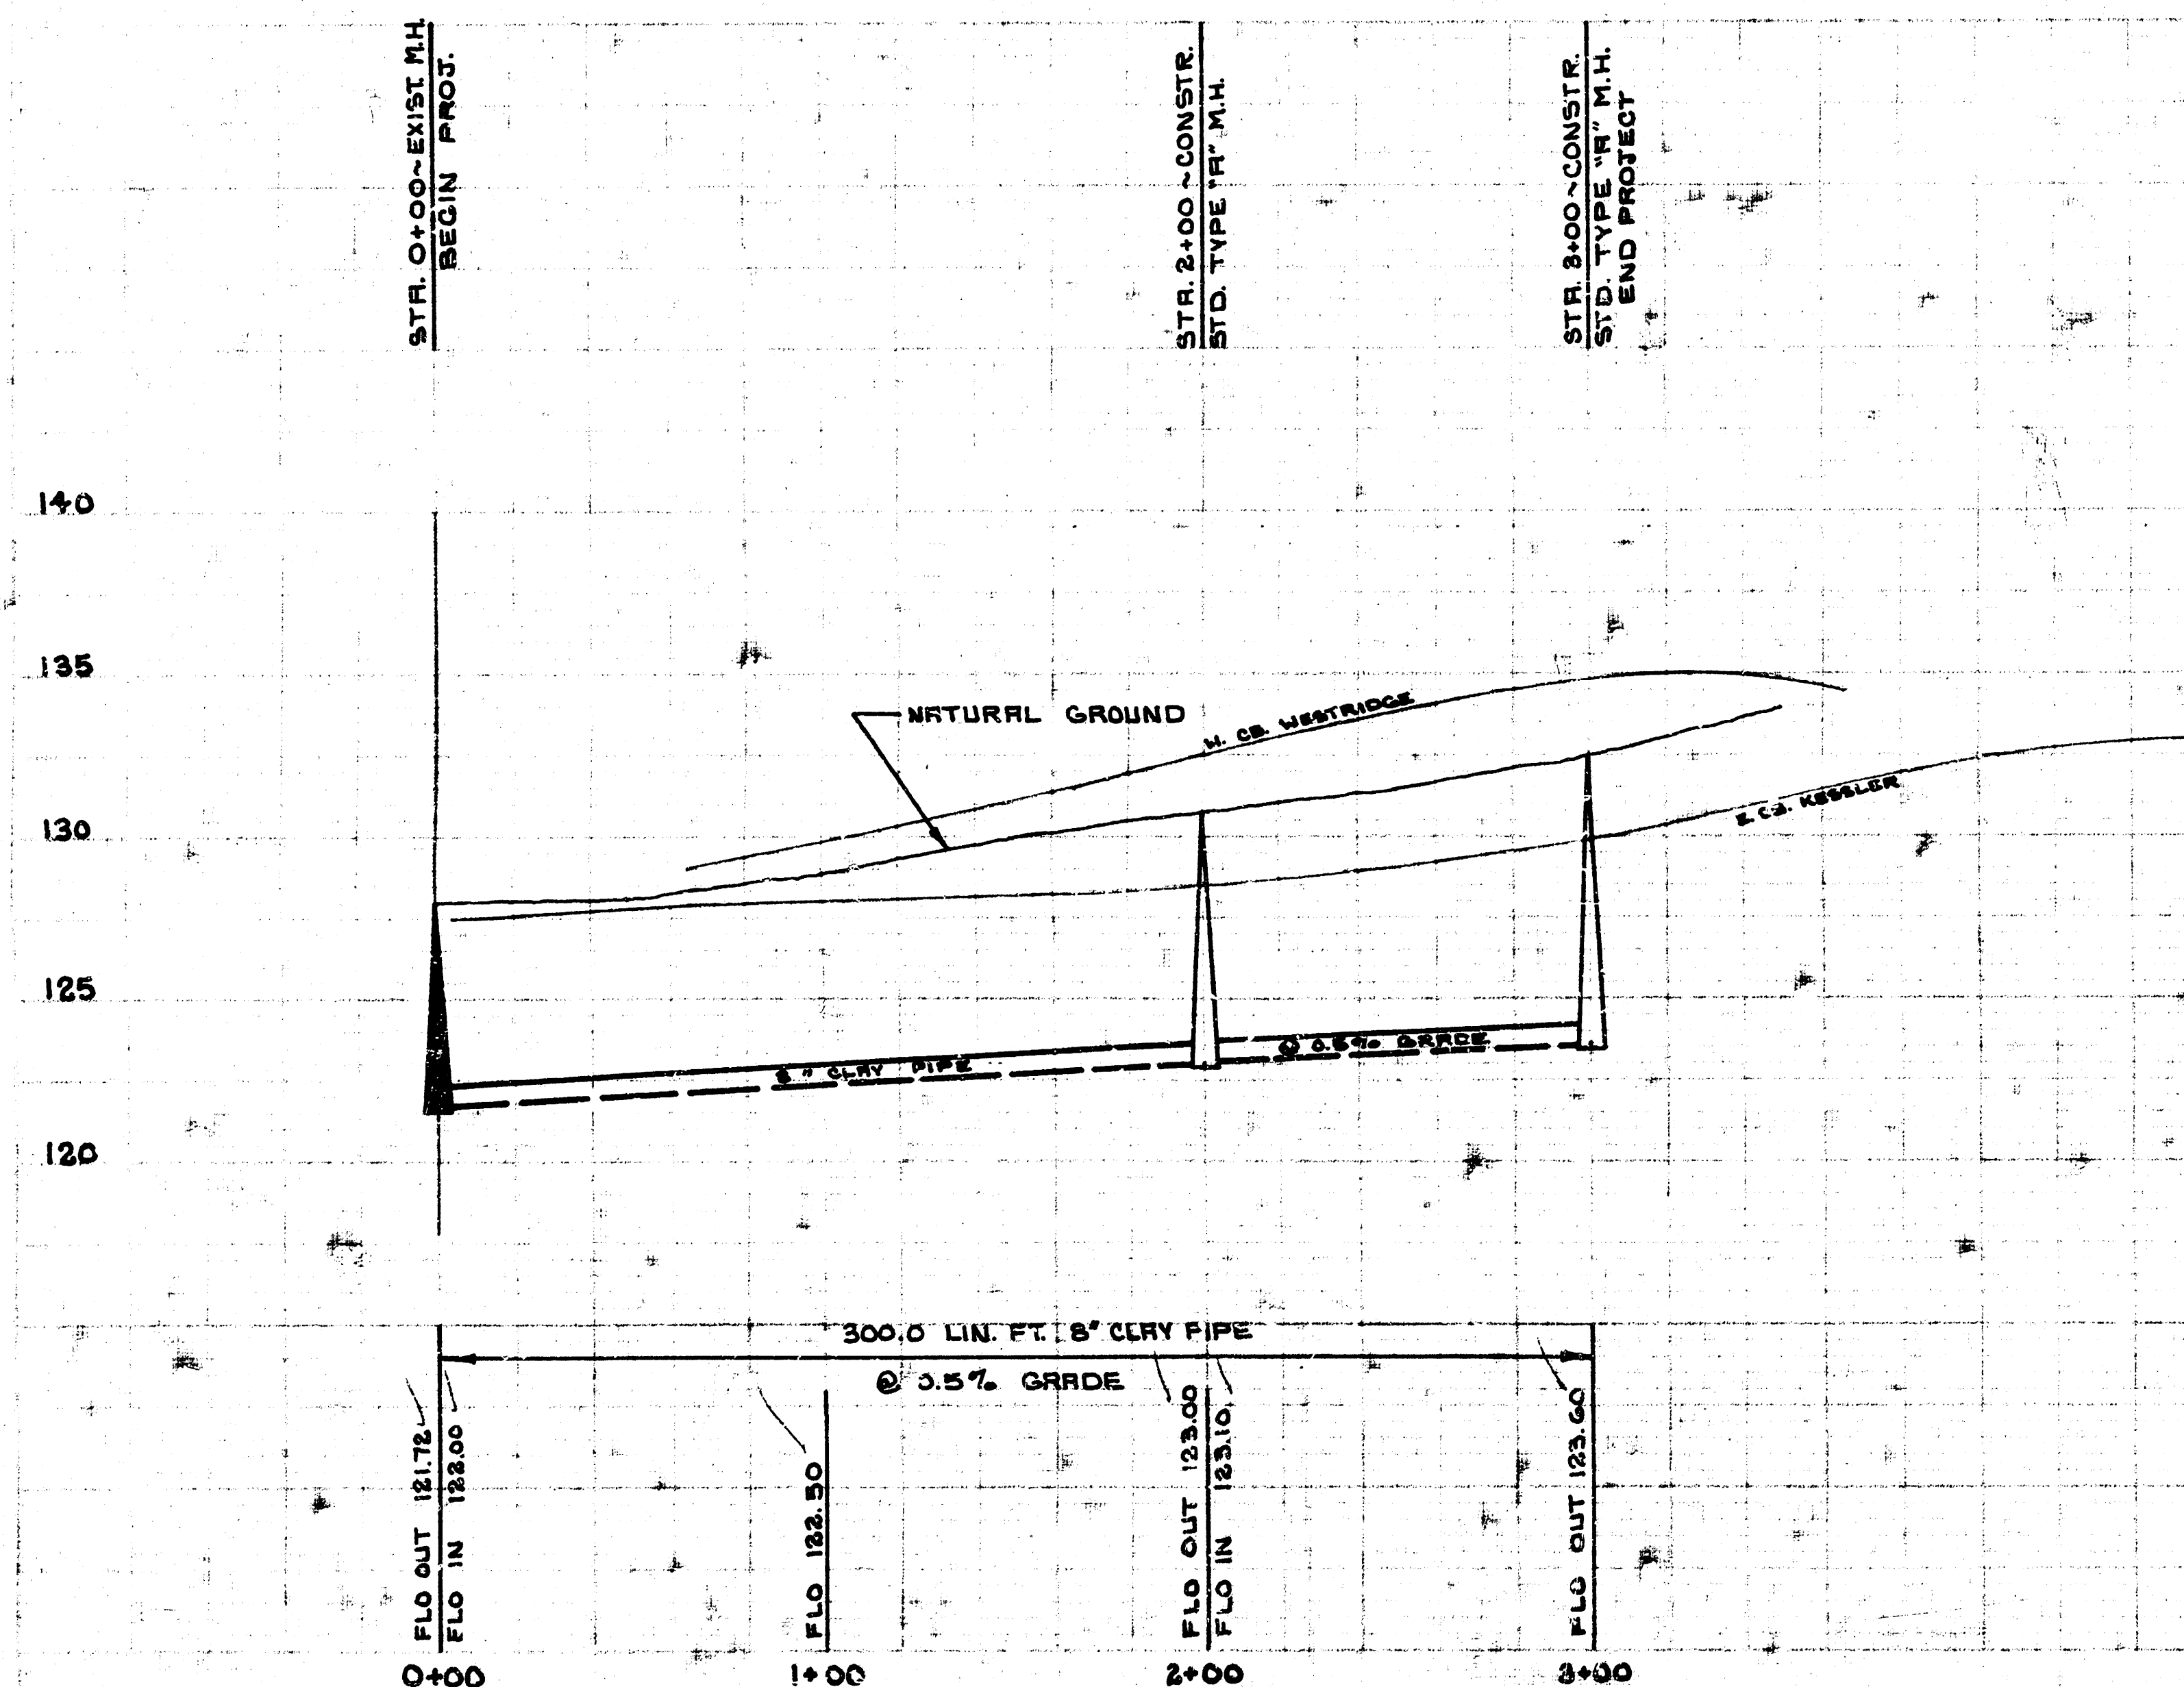

BM*1~129.423 ~ NE COR. CONC. PORCH HOUSE
 *1649 N. KESSLER
 BM*2~130.95 ~ "H" IN RITCHIE TOP WEST CB. ON
 KESSLER AVE. 1 FT. N. OF N.L. 17TH ST.

PLAN SCALE 1"=40'
 PROFILE SCALE 1"=40' HORIZONTAL
 1"=5' VERTICAL

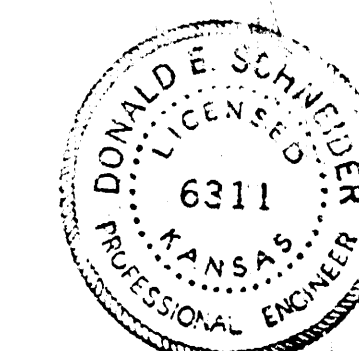

As Built Final Map K-111
 LAT. 212-MAIN 5~ S.S. 22
 CITY OF WICHITA
 R.W. LINN ~ CITY ENGINEER
 DATE FEB. 1978 PROJ. NO. DSKL 572028

10. Engr
 10. Water

FILMED FROM THE BEST