



NOTE: REMOVAL OF EXIST. STUB N. SHALL NOT BE PAID FOR DIRECTLY, BUT SHALL BE INCLUDED IN THE COST OF THE PROJECT.



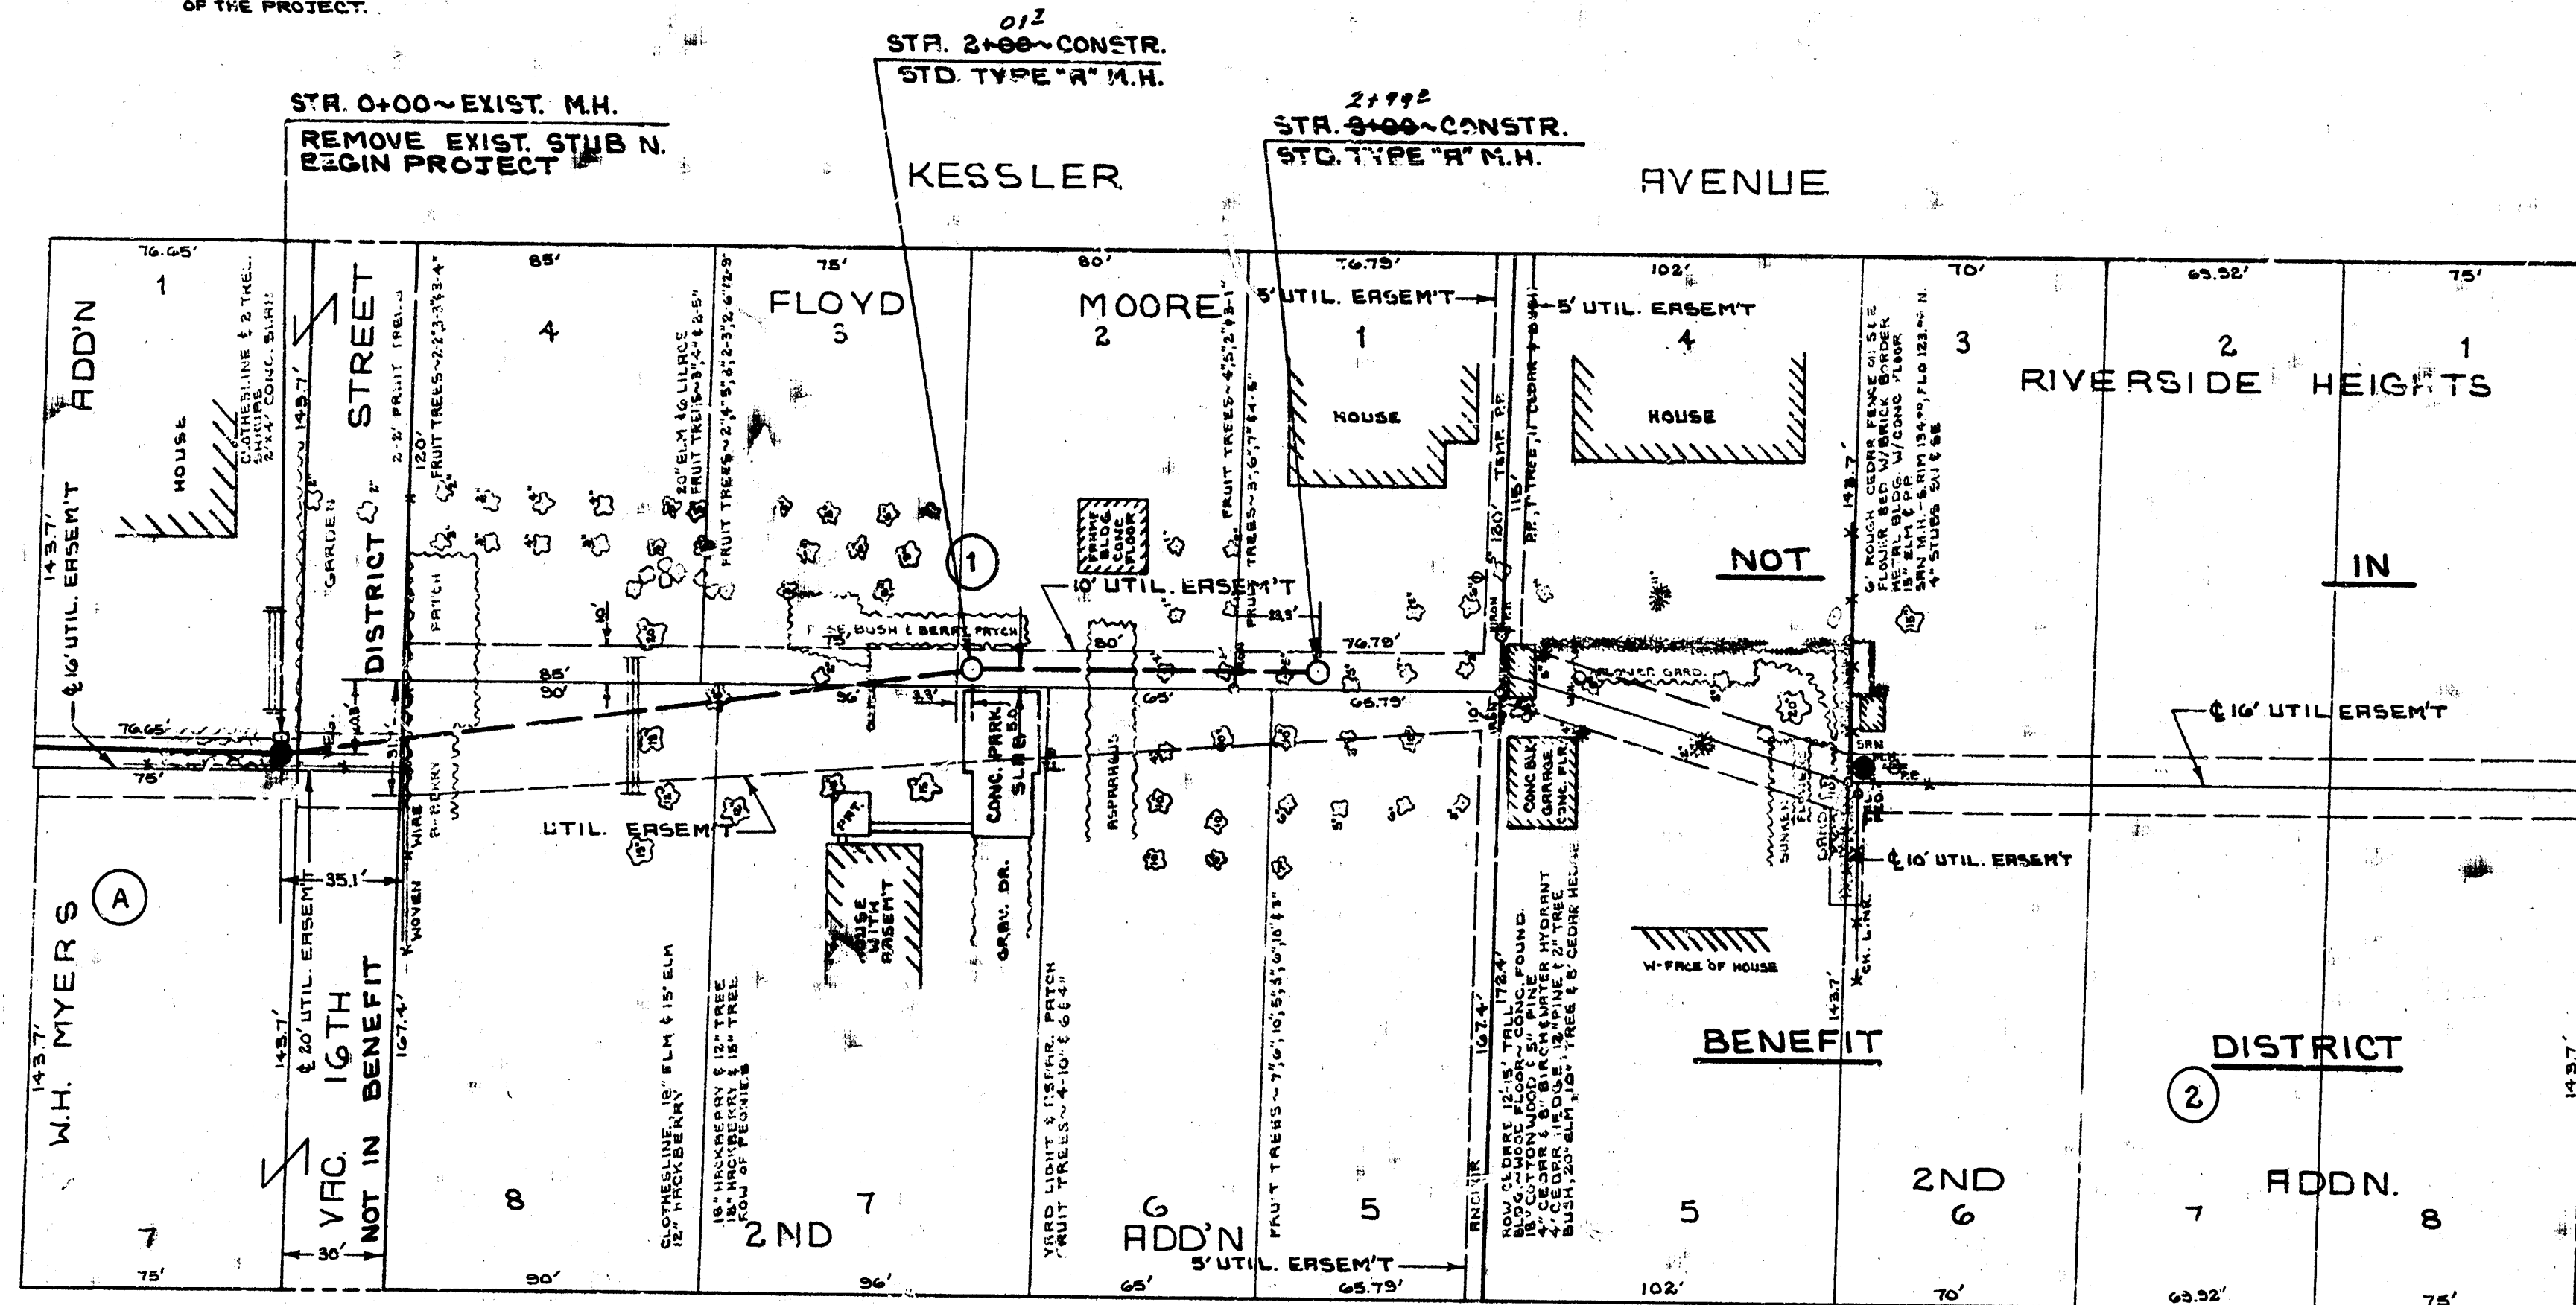


BM*1~129.423~NE COR. CONC. PORCH HOUSE
 #1649 N. KESSLER
 BM*2~130.95~"H" IN RITCHIE TOP WEST CB. ON
 KESSLER AVE. 1 FT. N. OF N.L. 17TH ST.

PLAN SCALE 1"=40'
 PROFILE SCALE 1"=10' HORIZONTAL
 1"=5' VERTICAL

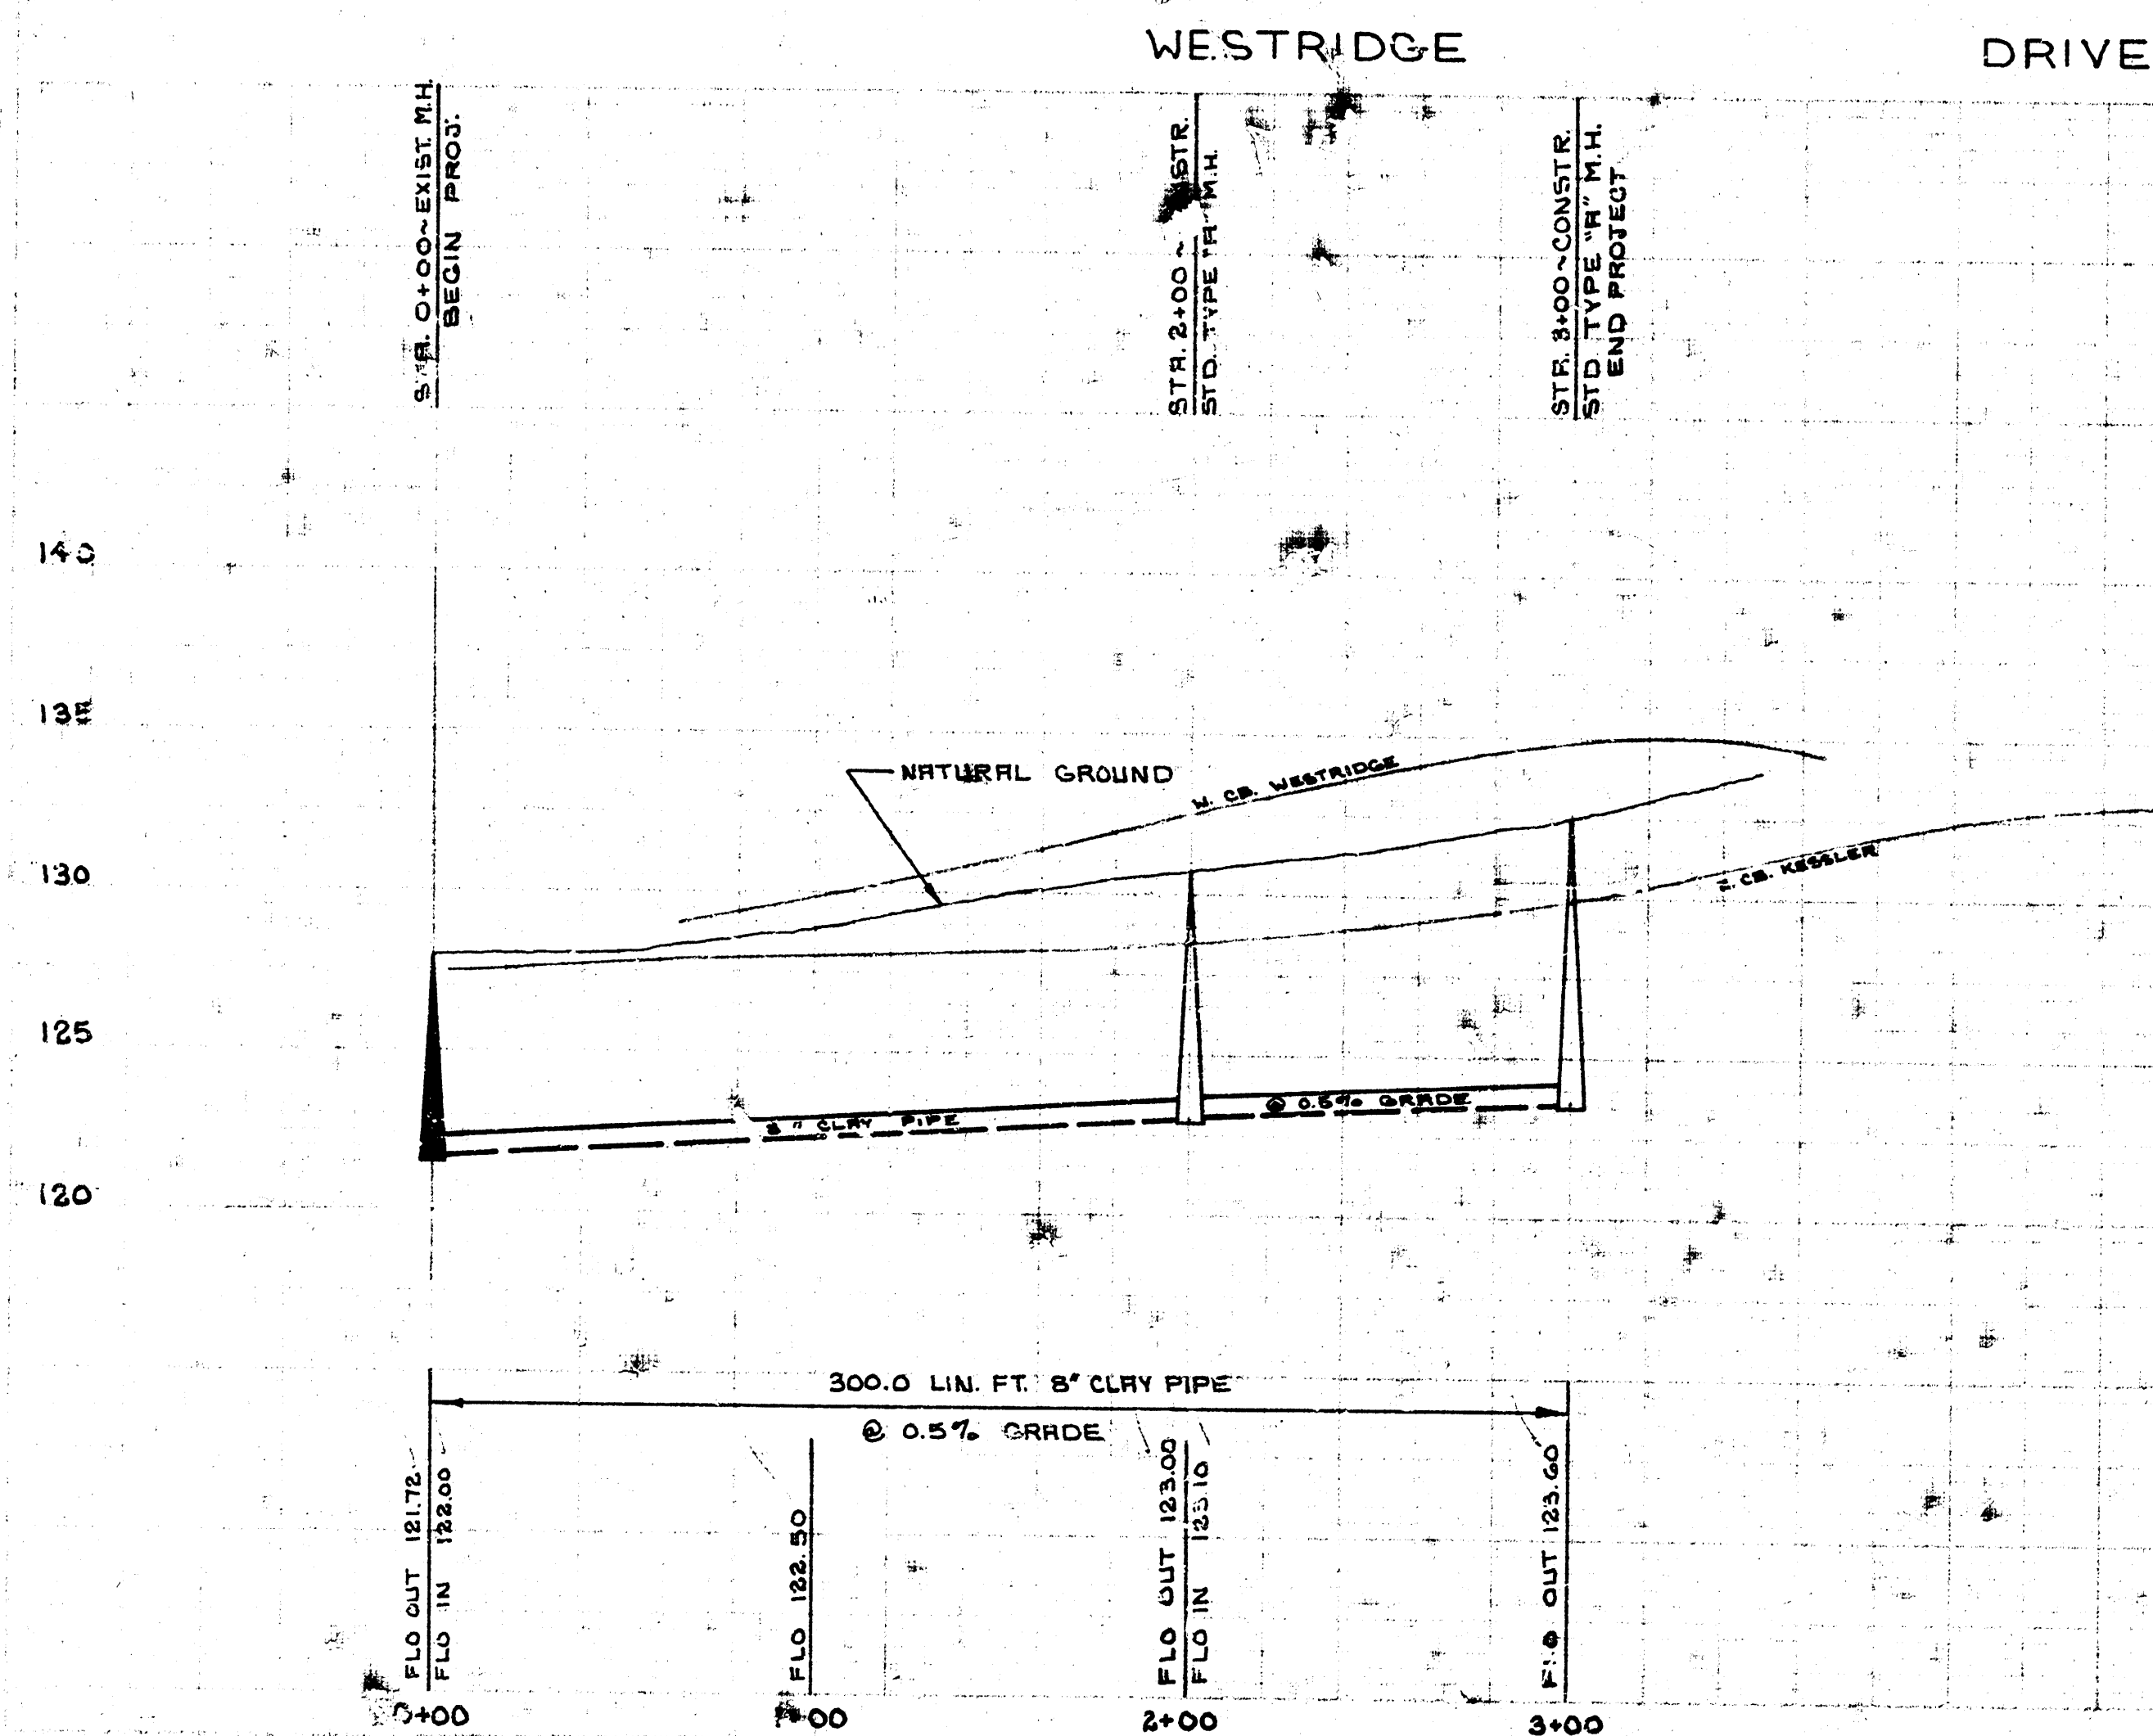

As Built Final Map 5-111
 LAT. 212-MAIN 5~ S.S. 22
 CITY OF WICHITA
 R.W. LINN ~ CITY ENGINEER
 DATE FEB. 1978 PROJ. NO. D8KL572028

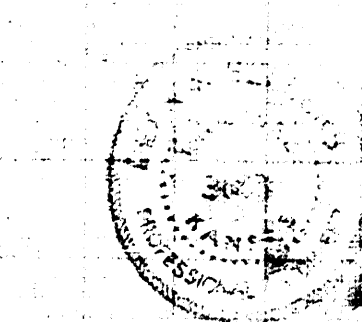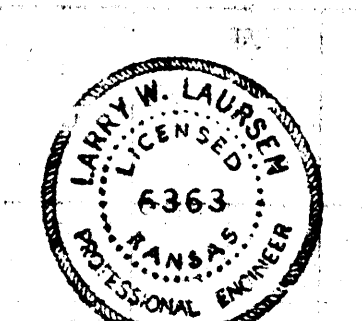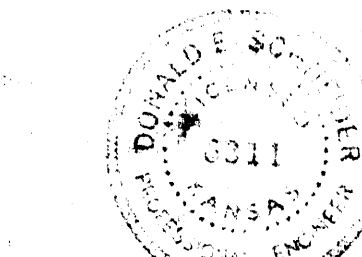

14 2 1 3