



B.M. 12508 R.R. Spike on West Side p. pole on @ DOUGHERTY & WHITENALL H.
 B.M. 12499 R.R. Spike on North South Side 15TH & 13TH BICKEL

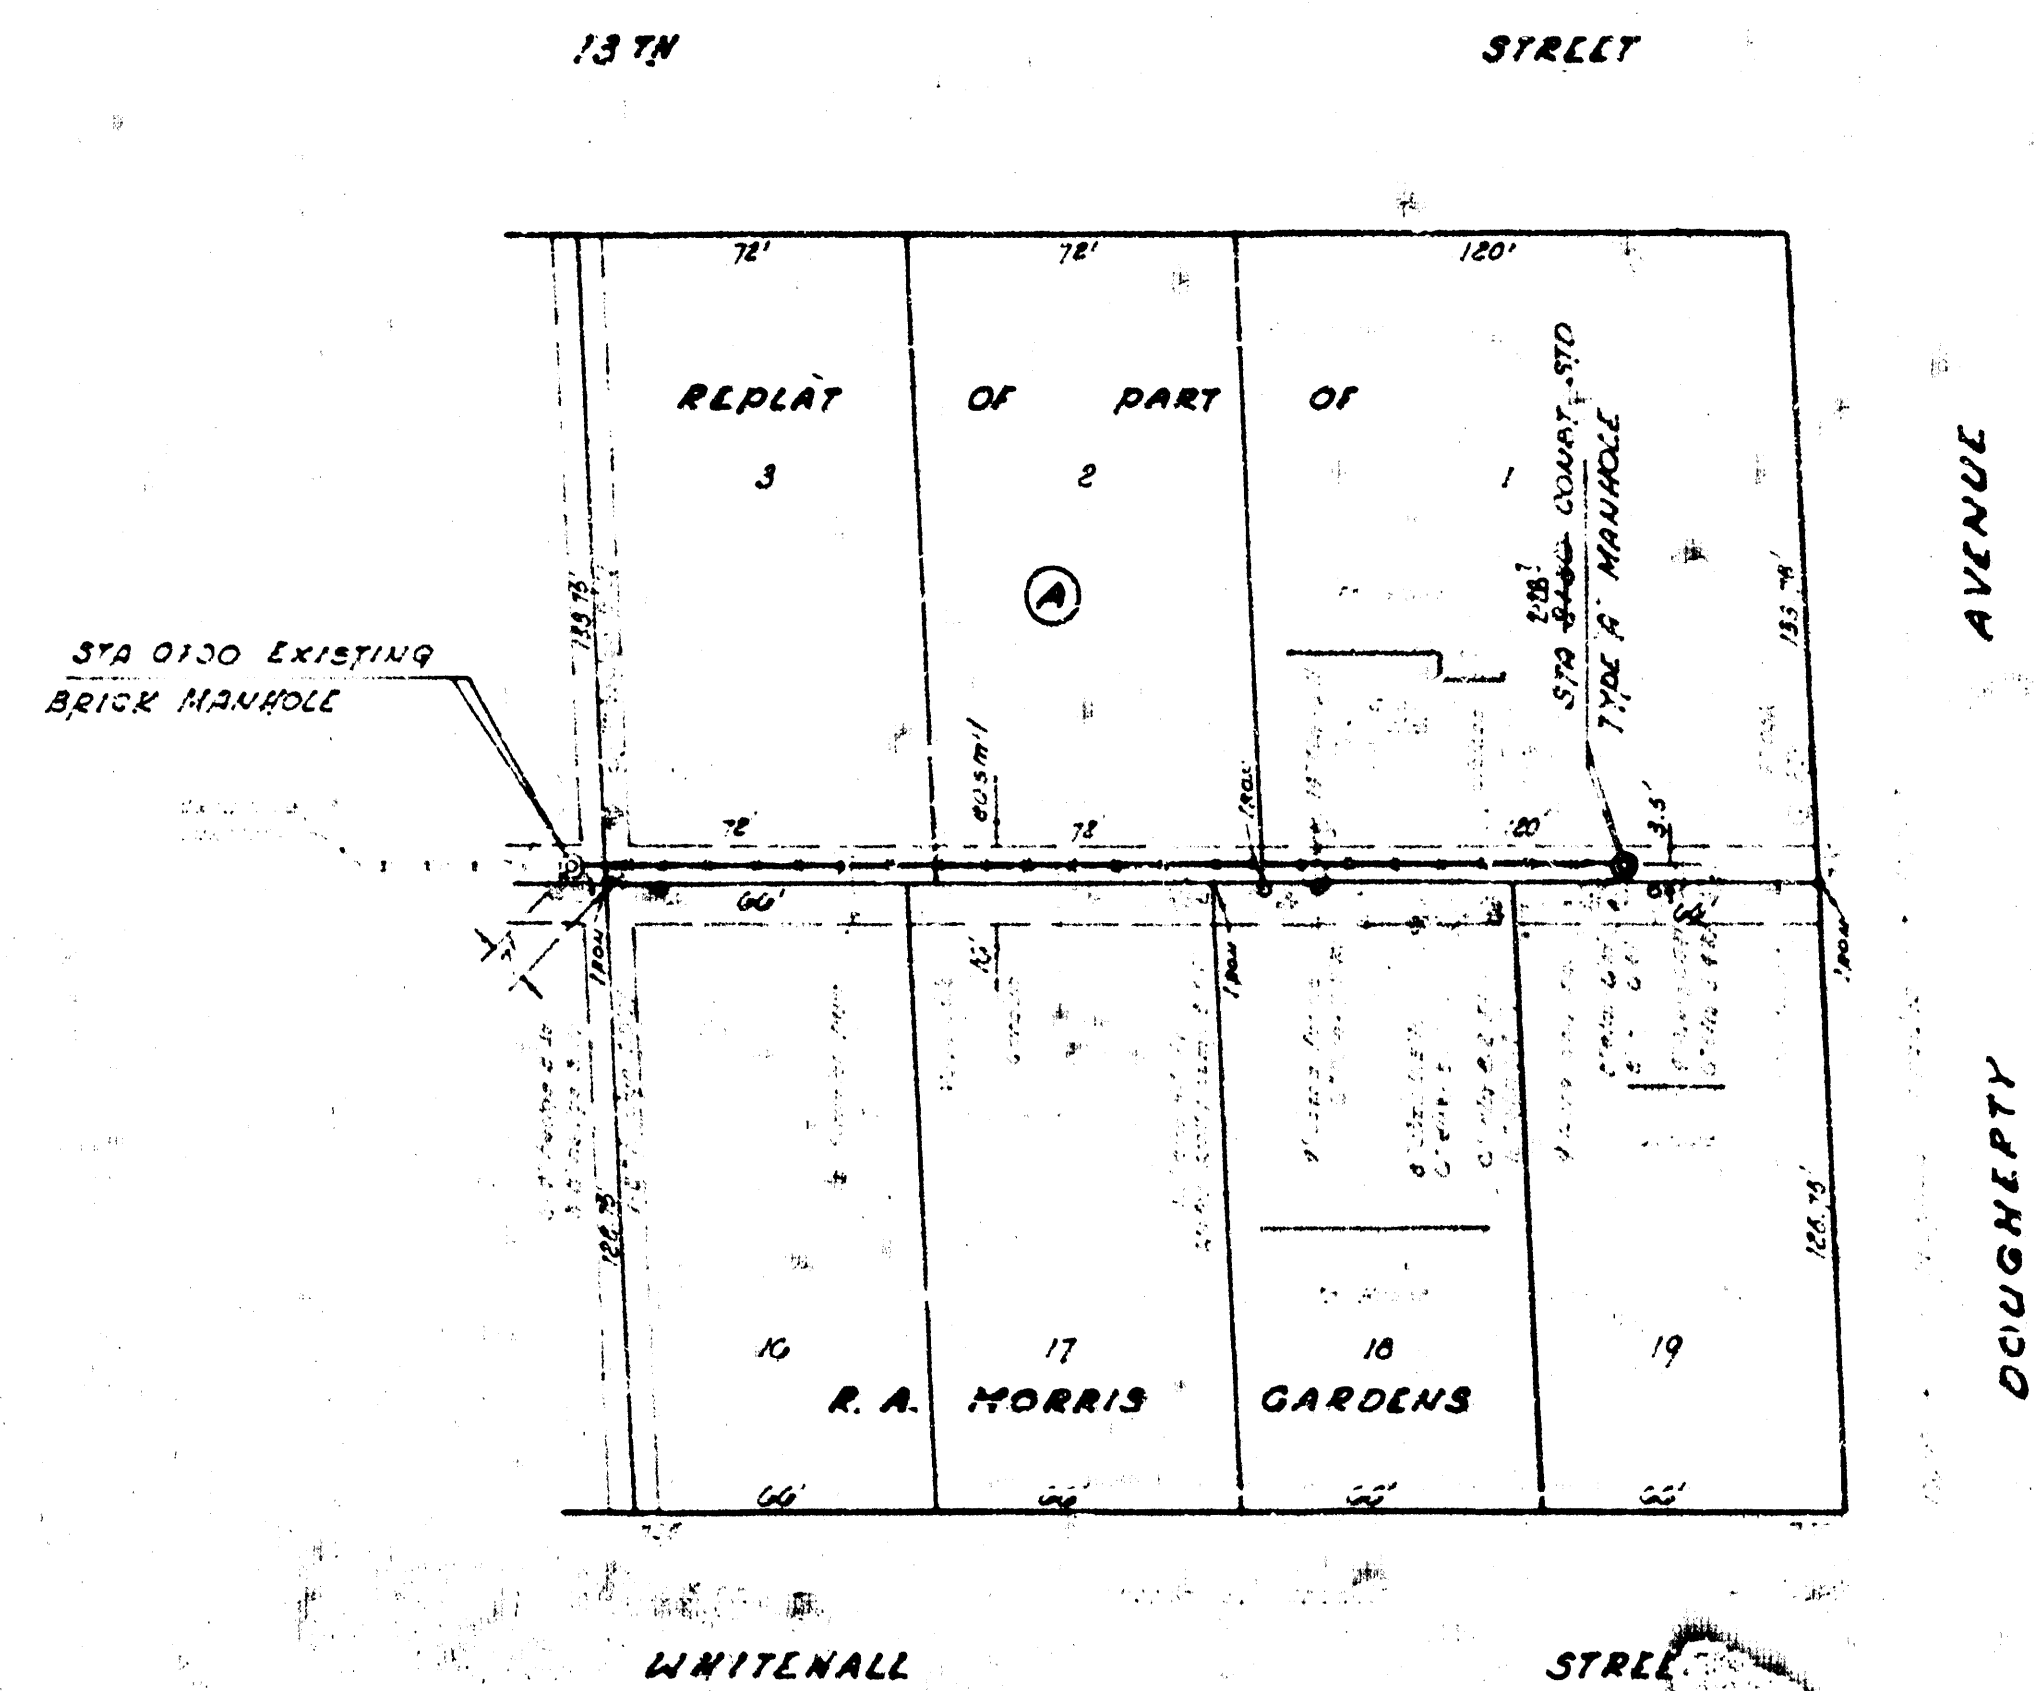

PLAN SCALE 1" = 40'
 PROFILE 1" = 40' HORIZ.
 1" = 5' VERT.

130
 125
 120
 115

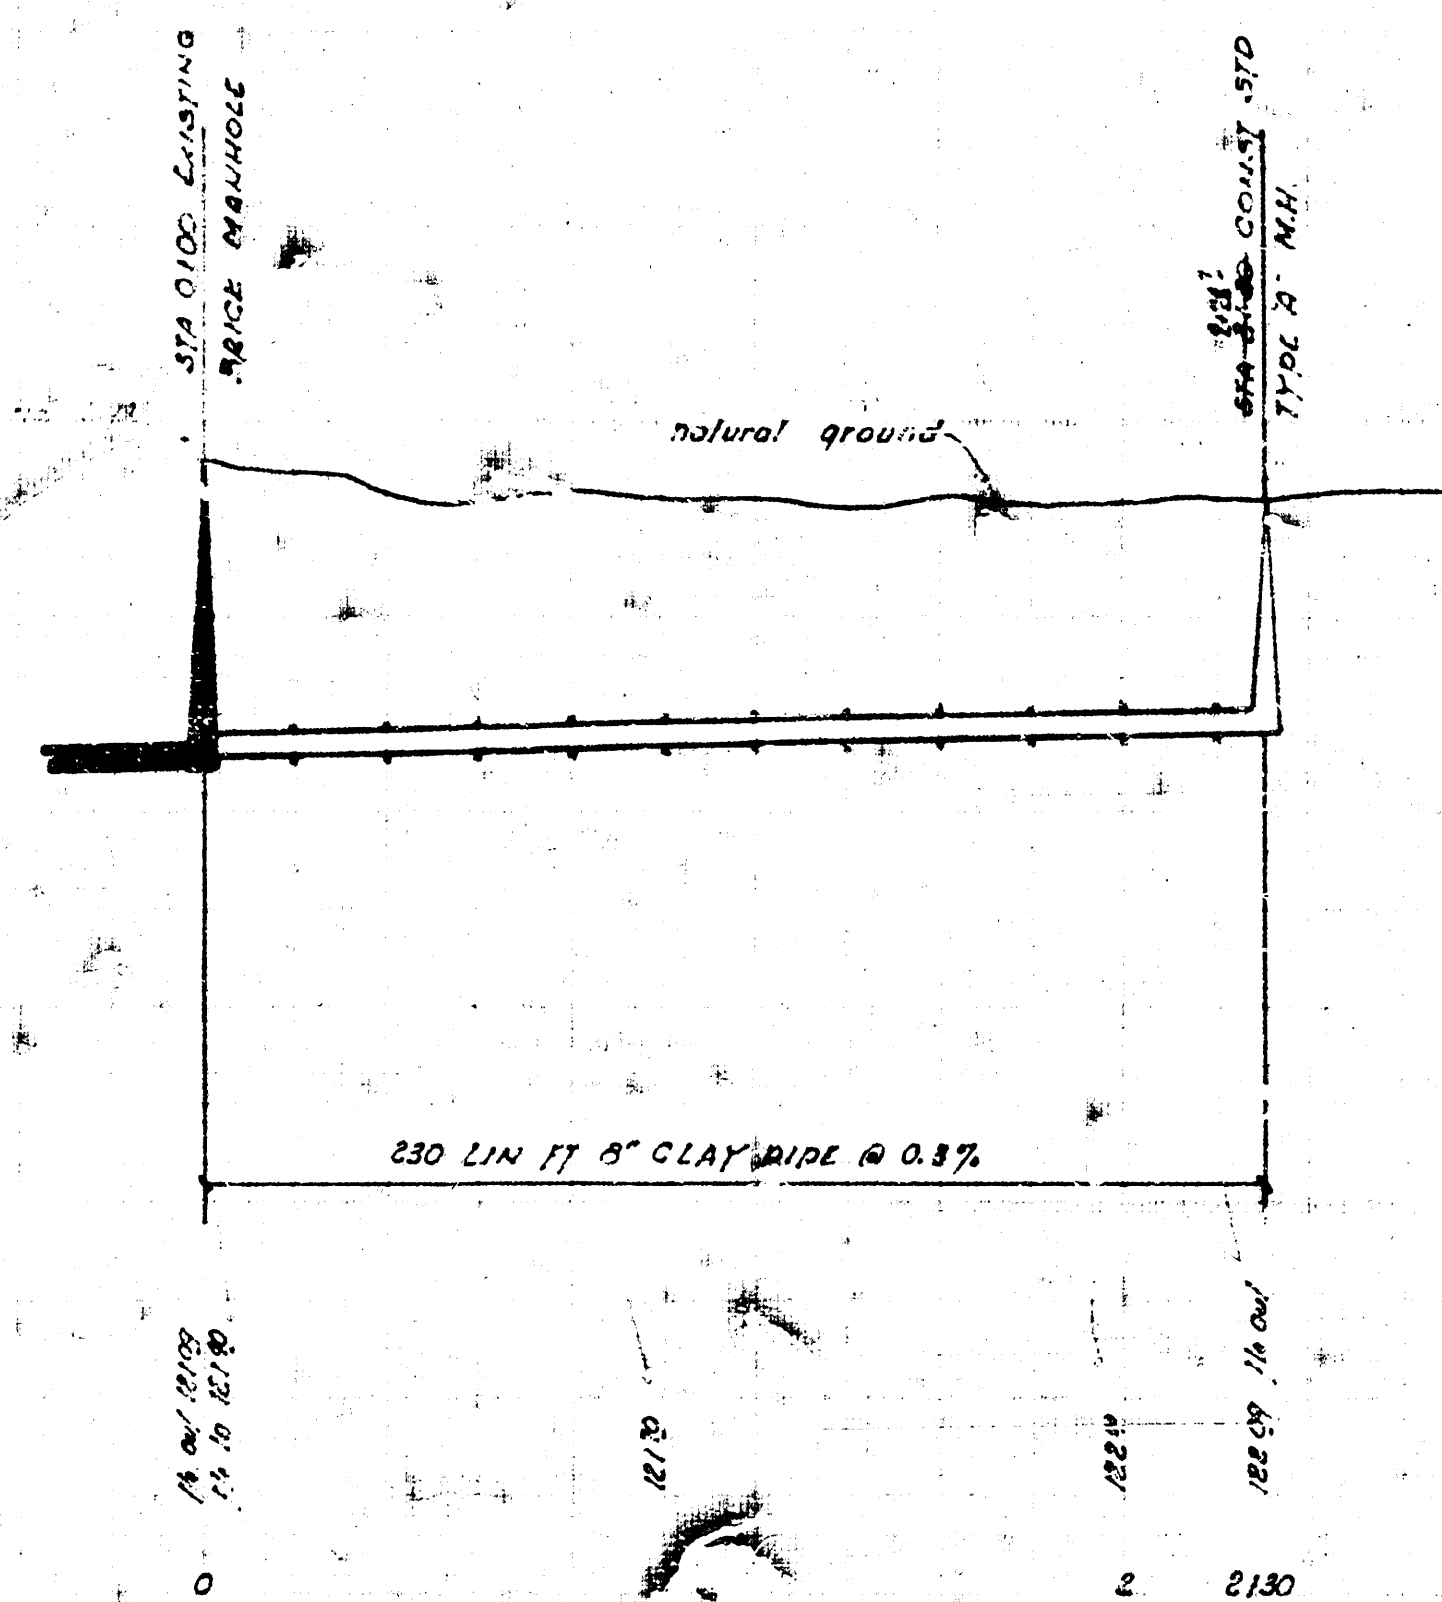

As Built 13 SEP 72 FINAL MEASUREMENT IN S.S. JK-5
LATERAL 213, MAIN 5, S.S. 22
 CITY OF WICHITA, KANSAS
 R.W. LINN CITY ENGINEER
 DATE SEPT. 1972 PROJ. NO. DBKL 572638

14 4 5 11