



PLAN
 SHEET NO. 1
 DATE: 11-19-78
 BY: Steve R. Linn
 CHECKED: [Signature]
 TITLE: [Blank]

PROFILE
 SHEET NO. 1
 DATE: 11-19-78
 BY: Steve R. Linn
 CHECKED: [Signature]
 TITLE: [Blank]

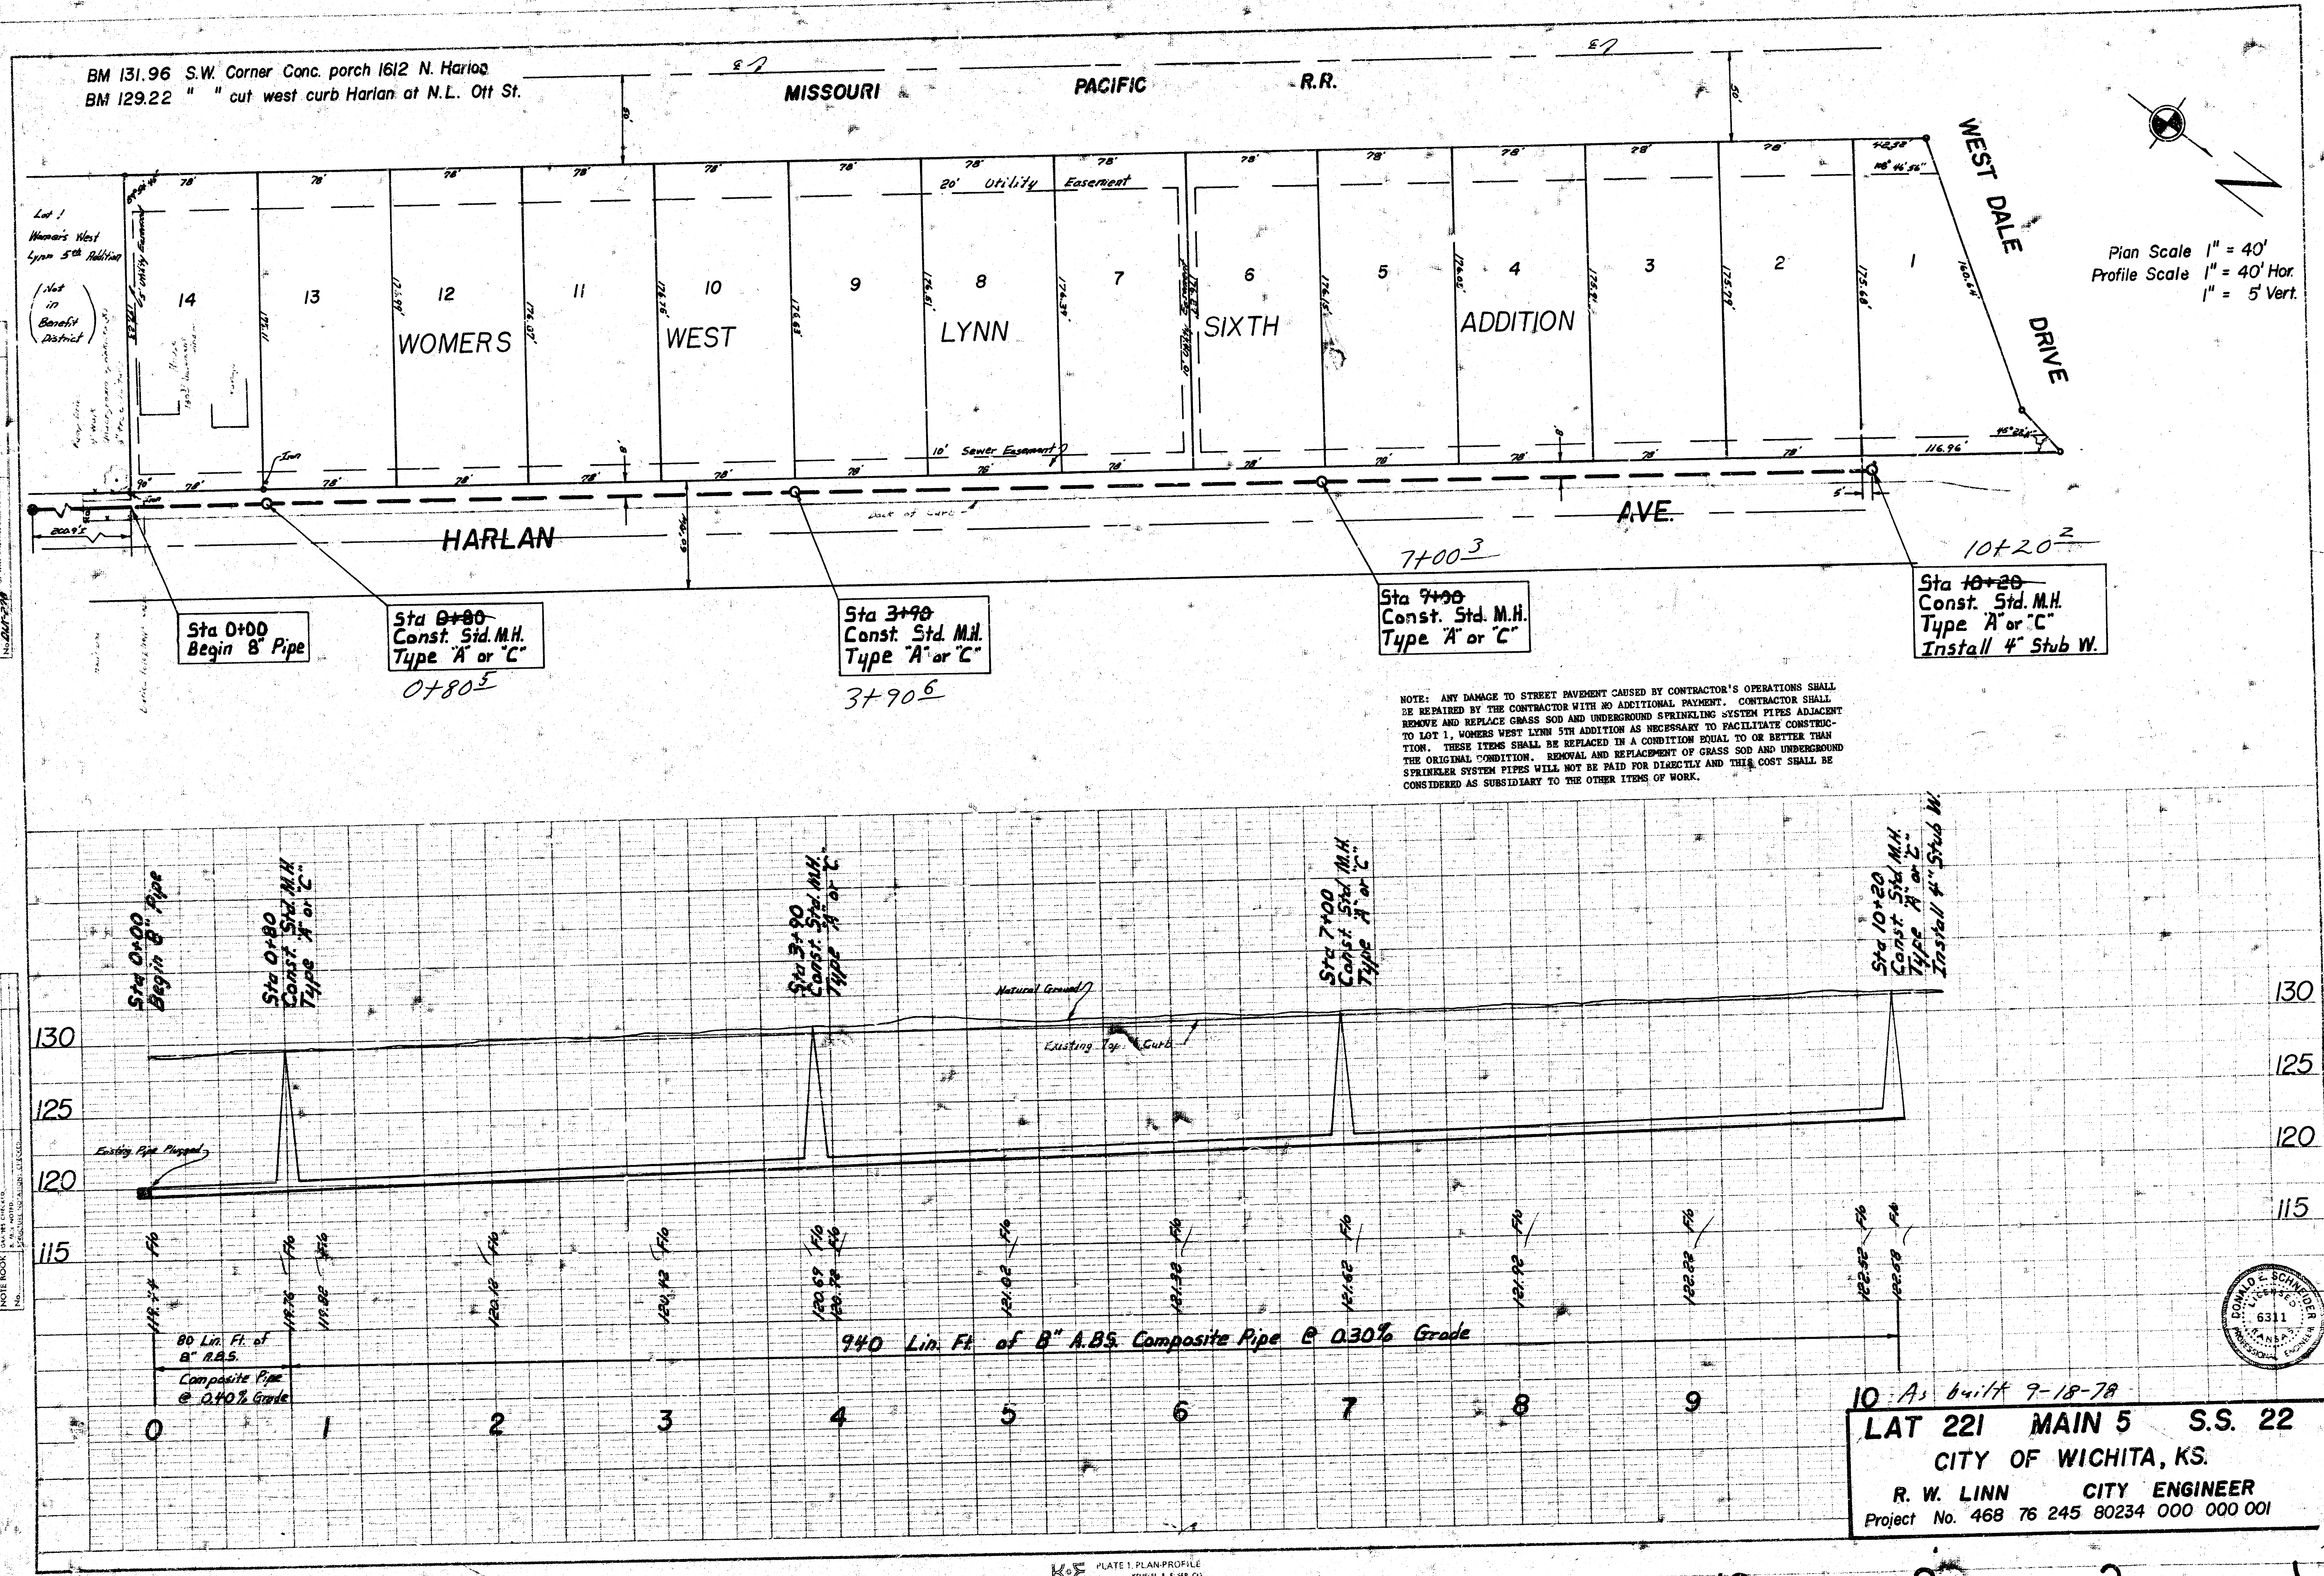

Plan Scale 1" = 40'
 Profile Scale 1" = 40' Hor.
 1" = 5' Vert.

NOTE: ANY DAMAGE TO STREET PAVEMENT CAUSED BY CONTRACTOR'S OPERATIONS SHALL BE REPAIRED BY THE CONTRACTOR WITH NO ADDITIONAL PAYMENT. CONTRACTOR SHALL REMOVE AND REPLACE GRASS SOD AND UNDERGROUND SPRINKLING SYSTEM PIPES ADJACENT TO LOT 1, WOMERS WEST LYNN 5TH ADDITION AS NECESSARY TO FACILITATE CONSTRUCTION. THESE ITEMS SHALL BE REPLACED IN A CONDITION EQUAL TO OR BETTER THAN THE ORIGINAL CONDITION. REMOVAL AND REPLACEMENT OF GRASS SOD AND UNDERGROUND SPRINKLER SYSTEM PIPES WILL NOT BE PAID FOR DIRECTLY AND THIS COST SHALL BE CONSIDERED AS SUBSIDIARY TO THE OTHER ITEMS OF WORK.

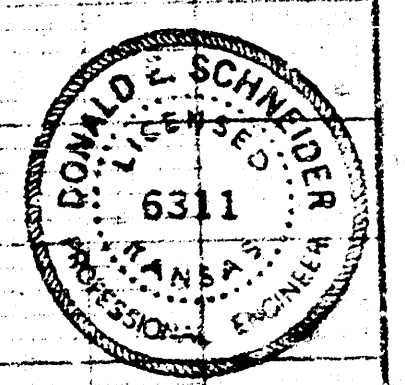

10 As built 7-18-78
LAT 221 MAIN 5 S.S. 22
CITY OF WICHITA, KS.
R. W. LINN CITY ENGINEER
 Project No. 468 76 245 80234 000 000 001