


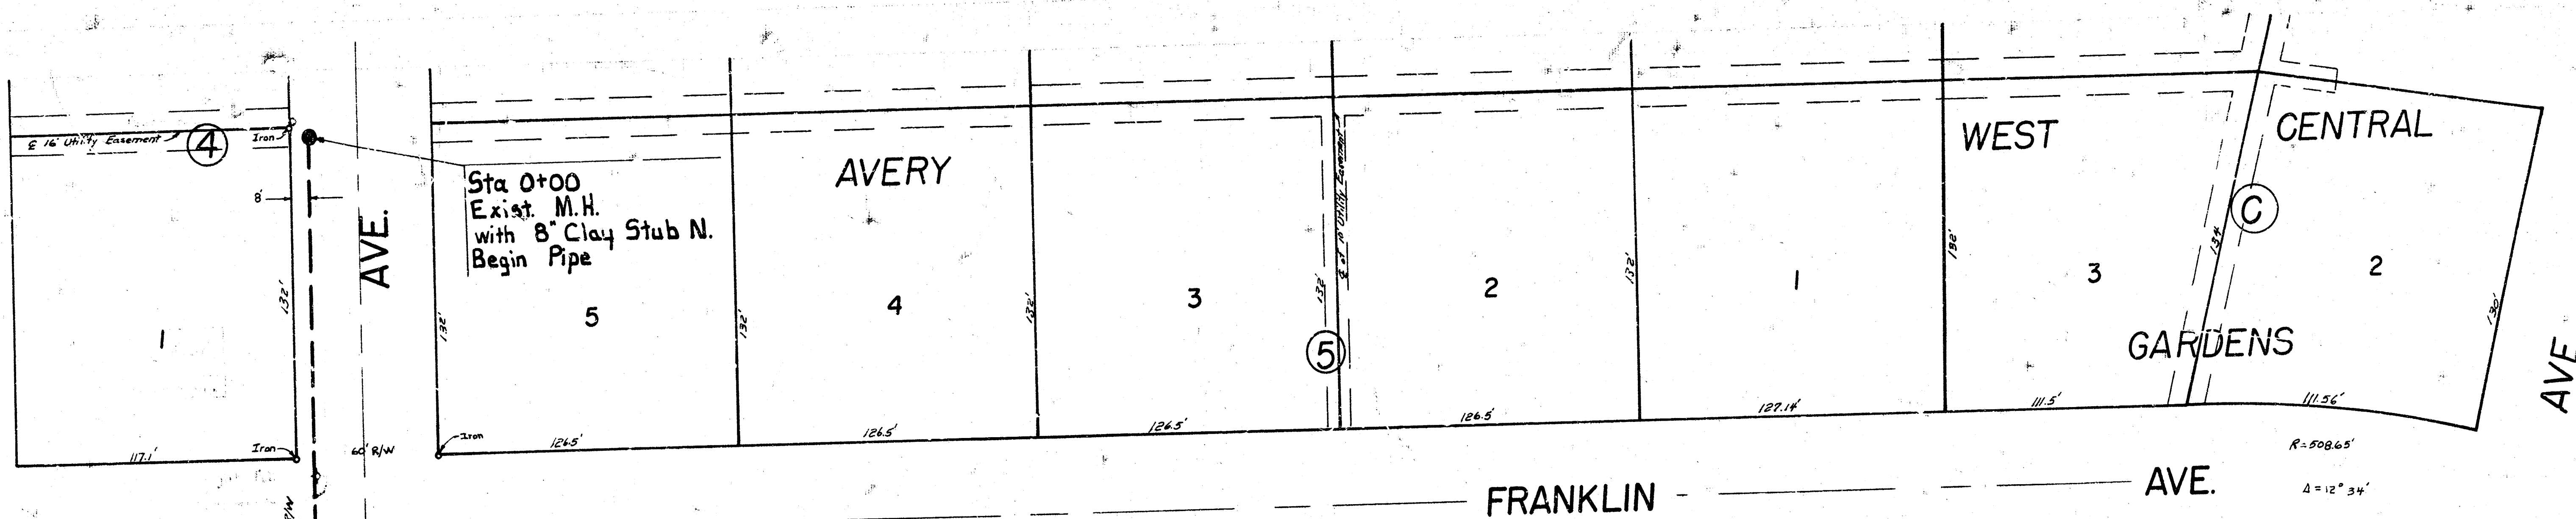

Plan Scale 1" = 40'
 Profile Scale 1" = 40' Hor.
 1" = 5' Vert.

NOTE: CONTRACTOR SHALL GIVE OWNERS OF DEVELOPED PROPERTY A MINIMUM OF 24 HOURS ADVANCE NOTICE PRIOR TO STARTING CONSTRUCTION. SEPTIC TANK LATERALS ARE LOCATED IN THE TEMPORARY CONSTRUCTION EASEMENT AREA ON LOT 1, BLOCK D, WEST CENTRAL GARDENS. THIRD ADDITION CONTRACTOR WILL BE REQUIRED TO REPAIR ANY DAMAGE TO THESE SEPTIC TANK LATERALS.

Sta 11+28
 Const. Std. M.H.
 Type 'A' or 'C'
 Install 4" Stub SW.

B.M. 12329 City Std. Disc 34' East & 42' N. of C. of Hoover & Central
 B.M. 12629 Hoover & 9th Street North
 Bench Mark Disc. 34' East and 42' South of C. Both.

Sta 0+00
 Exist. M.H.
 with 8" Clay Stub N.
 Begin Pipe

Sta 3+15
 Const. Std. M.H.
 Type 'A' or 'C'
 Install 4" Stub NE.

Sta 3+15
 Const. Std. M.H.
 Type 'A' or 'C'
 Install 4" Stub NE.

Sta 5+45
 Const. Std. M.H.
 Type 'A' or 'C'


Sta 7+75
 Const. Std. M.H.
 Type 'A' or 'C'

Sta 10+02
 Const. Std. M.H.
 Type 'A' or 'C'

Sta 7+75
 Const. Std. M.H.
 Type 'A' or 'C'

Sta 10+02
 Const. Std. M.H.
 Type 'A' or 'C'

Sta 11+28
 Const. Std. M.H.
 Type 'A' or 'C'
 Install 4" Stub SW

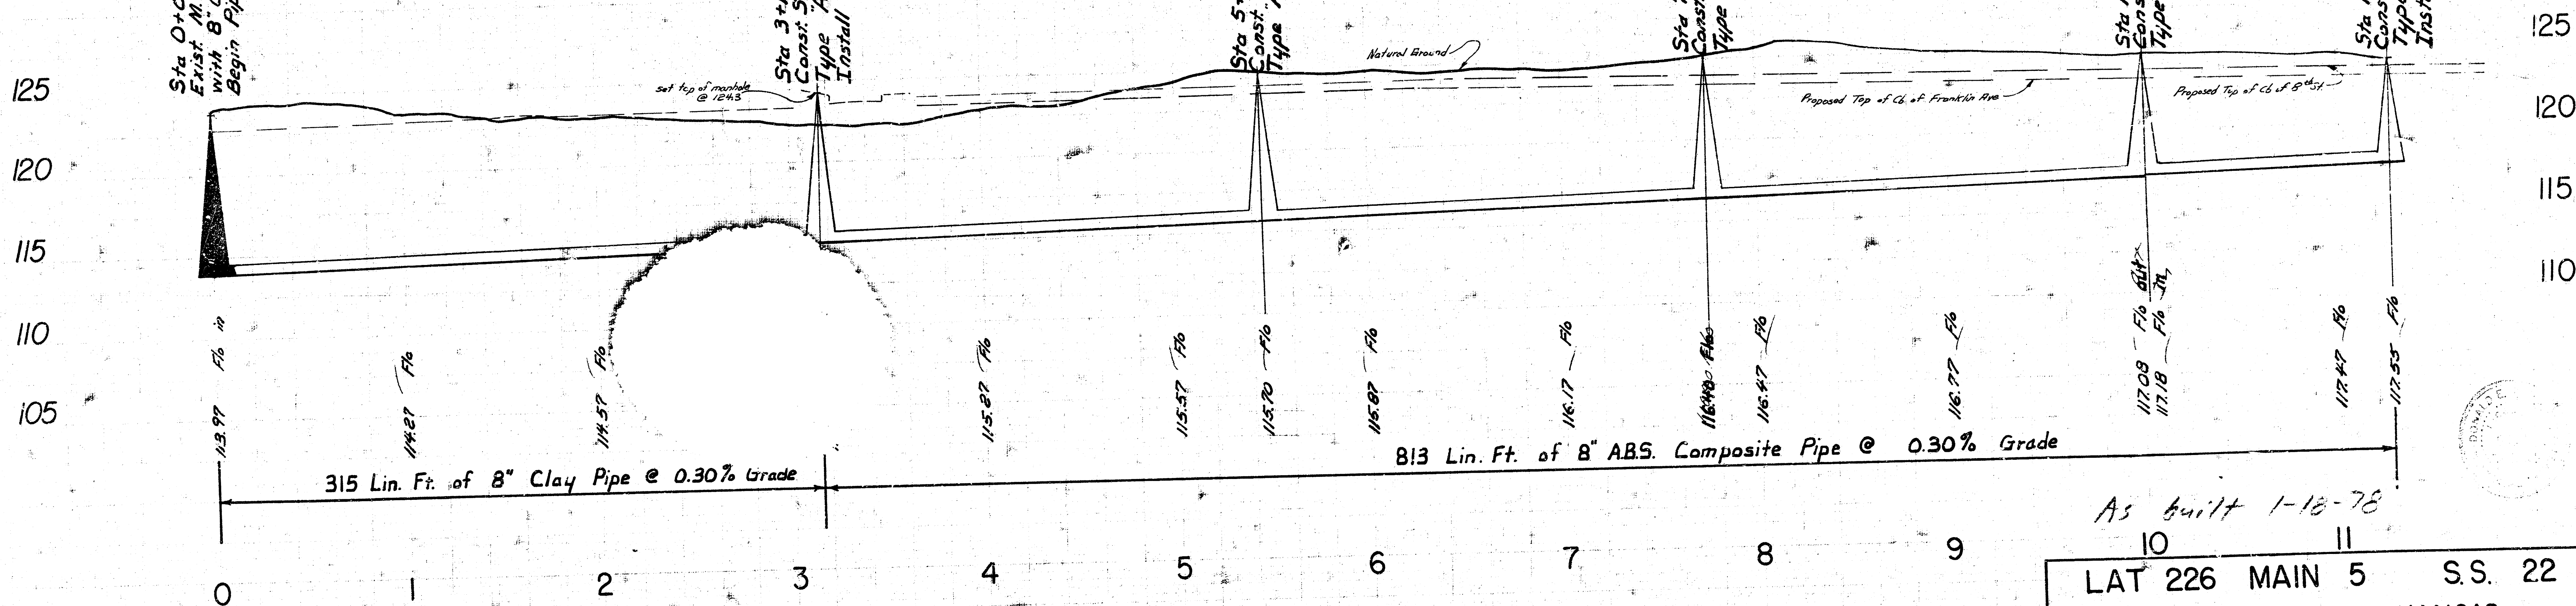

As built 1-18-78
 LAT 226 MAIN 5 S.S. 22
 CITY OF WICHITA, KANSAS
 R.W. LINN CITY ENGINEER
 DATE: PROJECT NUMBER DBKL577023