


BENCH MARK: City Standard Disc. 24" S. 1 5/8" W. of West Street 10th Street N. Elevation = 121.83 City Datum
 BENCH MARK: "V" Notch over iron at S.W. Cor. of Murdock & Nevada Elevation = 123.06 City Datum
 BENCH MARK: S Rim Manhole, Located 86' Right of Station 0100. Elevation = 122.05 City Datum

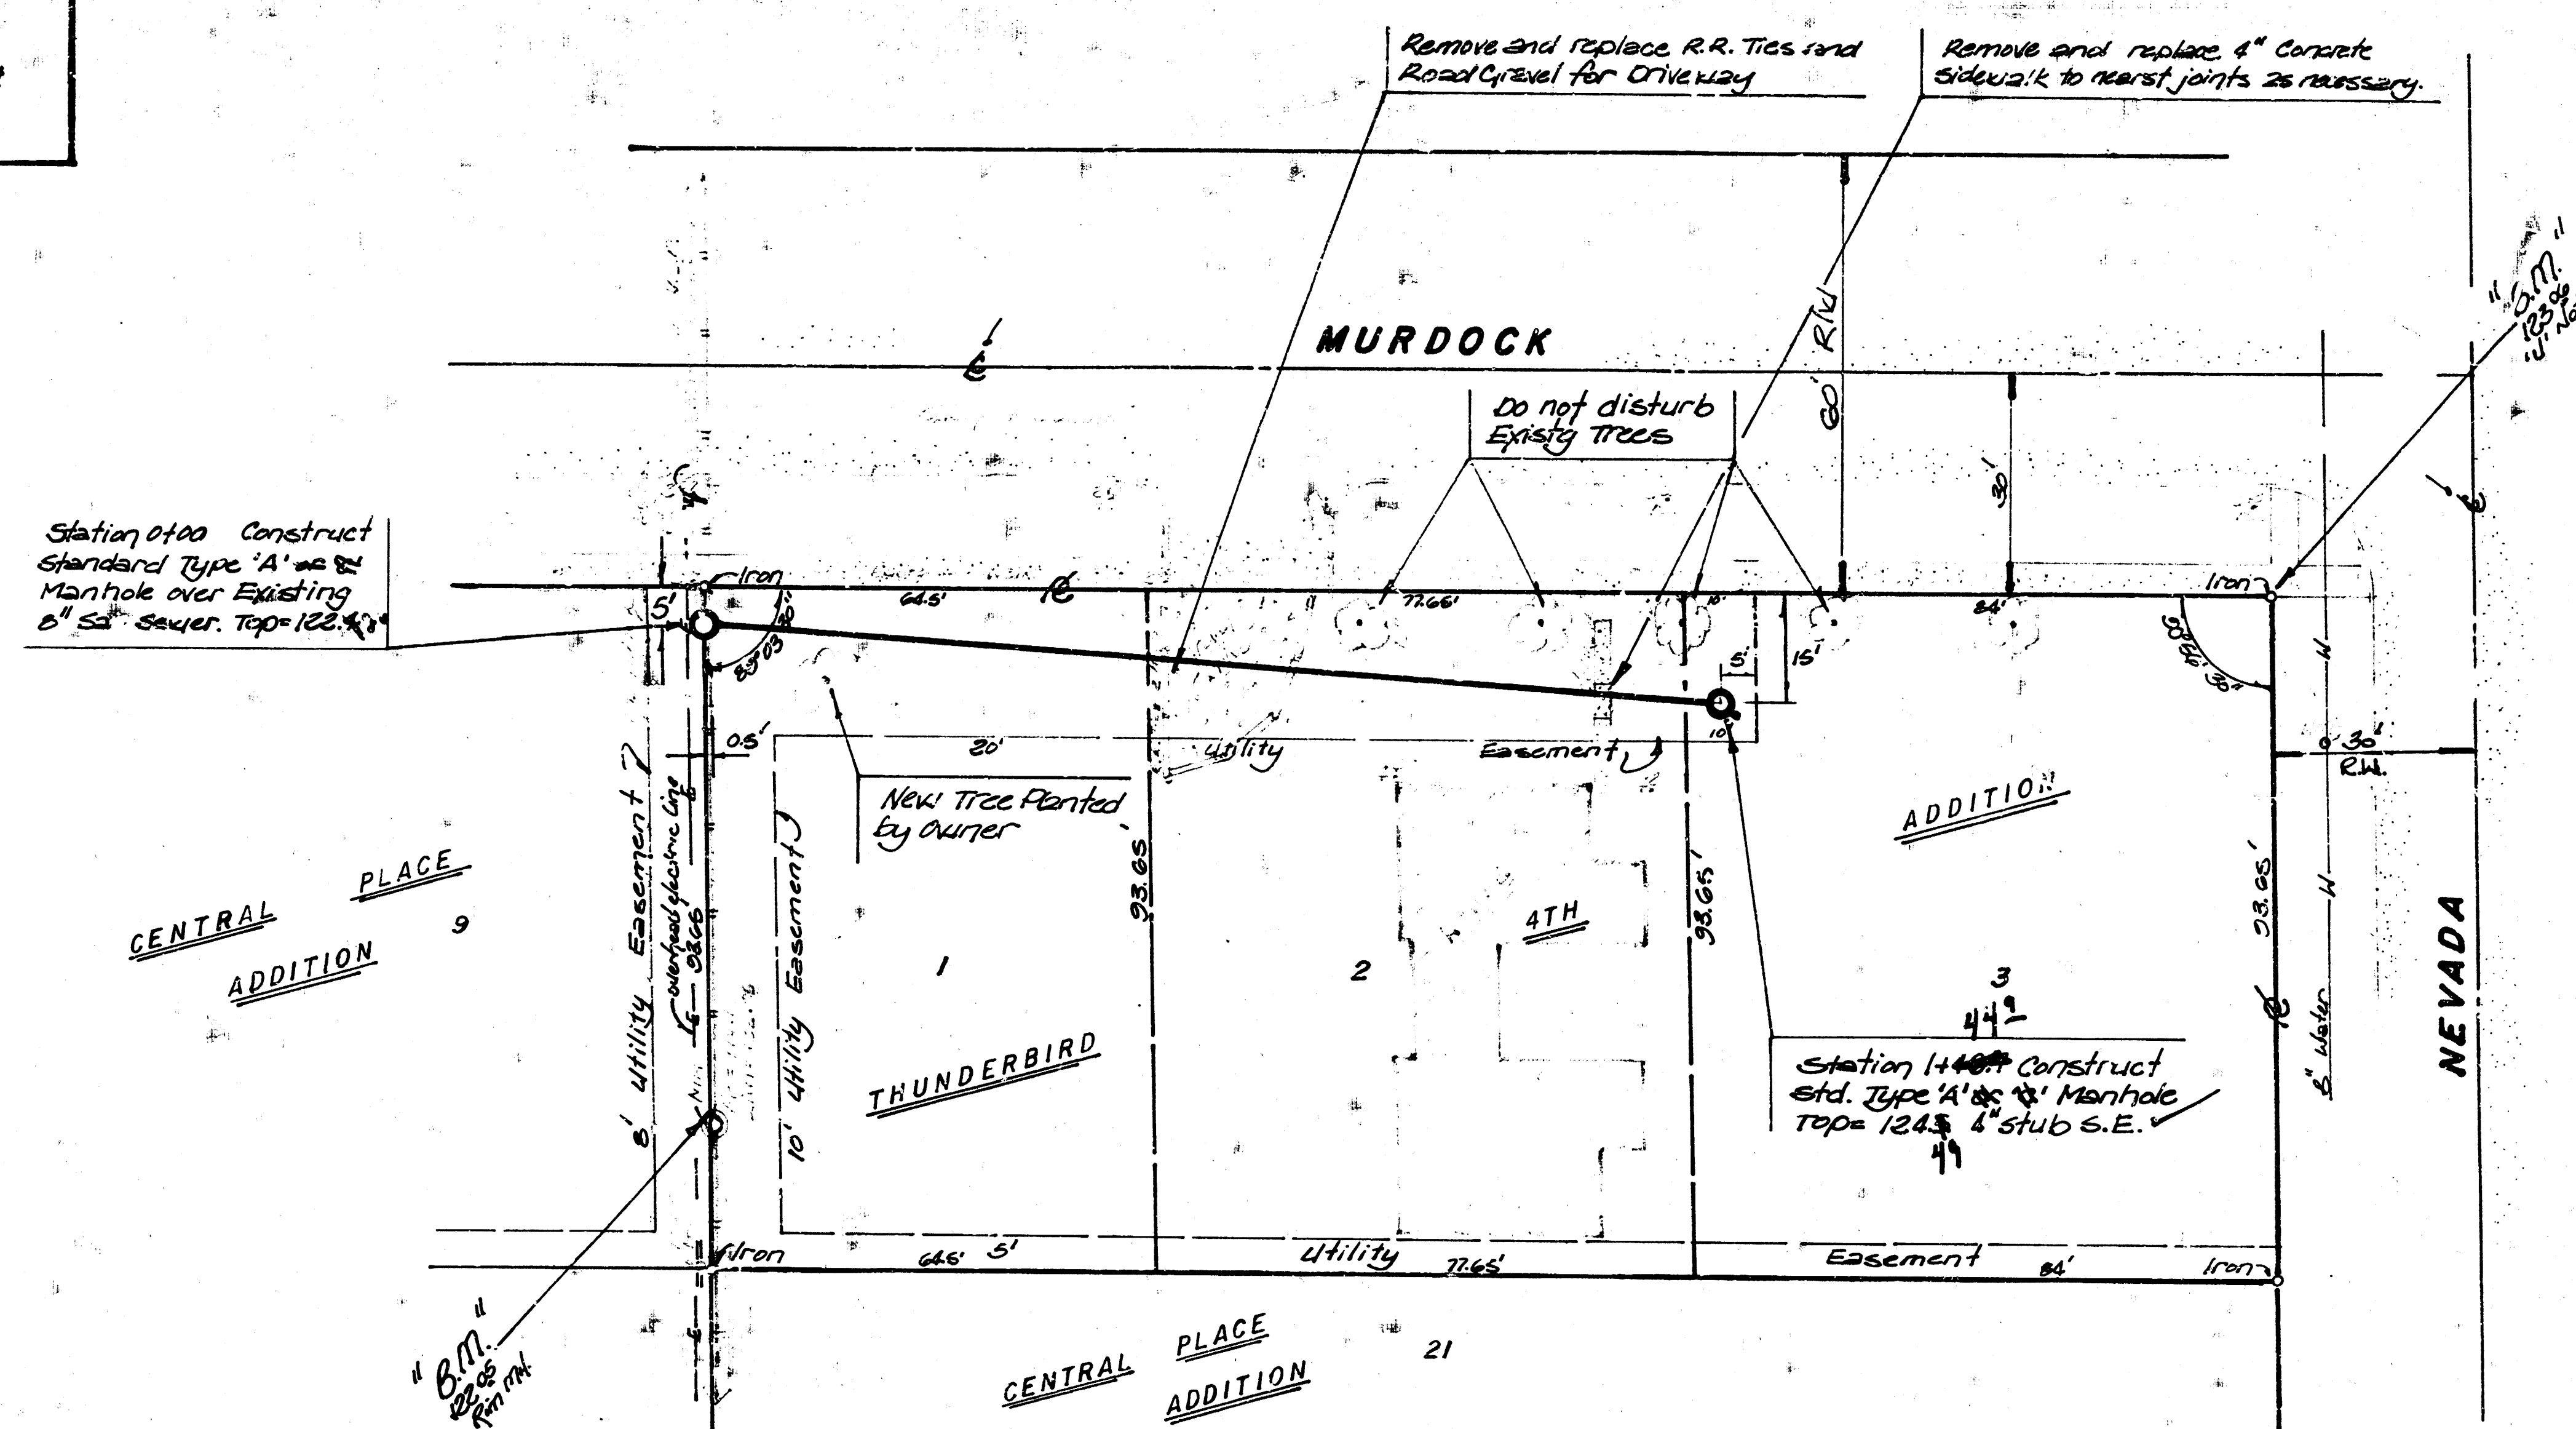


Station 0100 Construct Standard Type 'A' Manhole over Existing 6\"/>

CENTRAL PLACE ADDITION


CENTRAL PLACE ADDITION

STATION 1467 Construct Std. Type 'A' Manhole Top = 124.5' 4\"/>

As Built S.L. 1-86


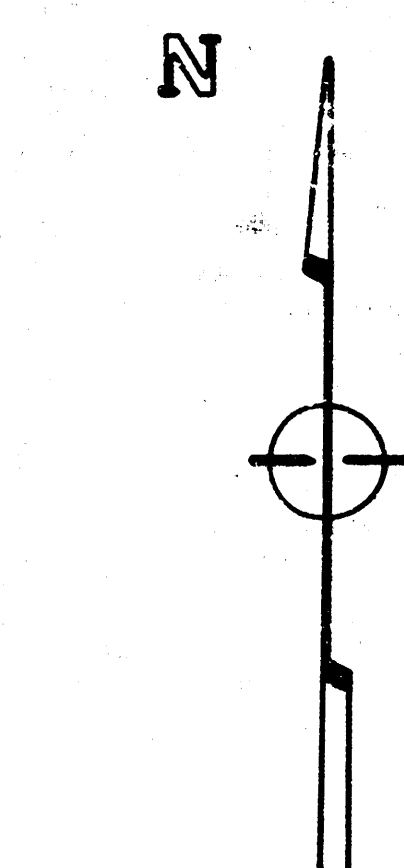


SCALE: 1\"/>

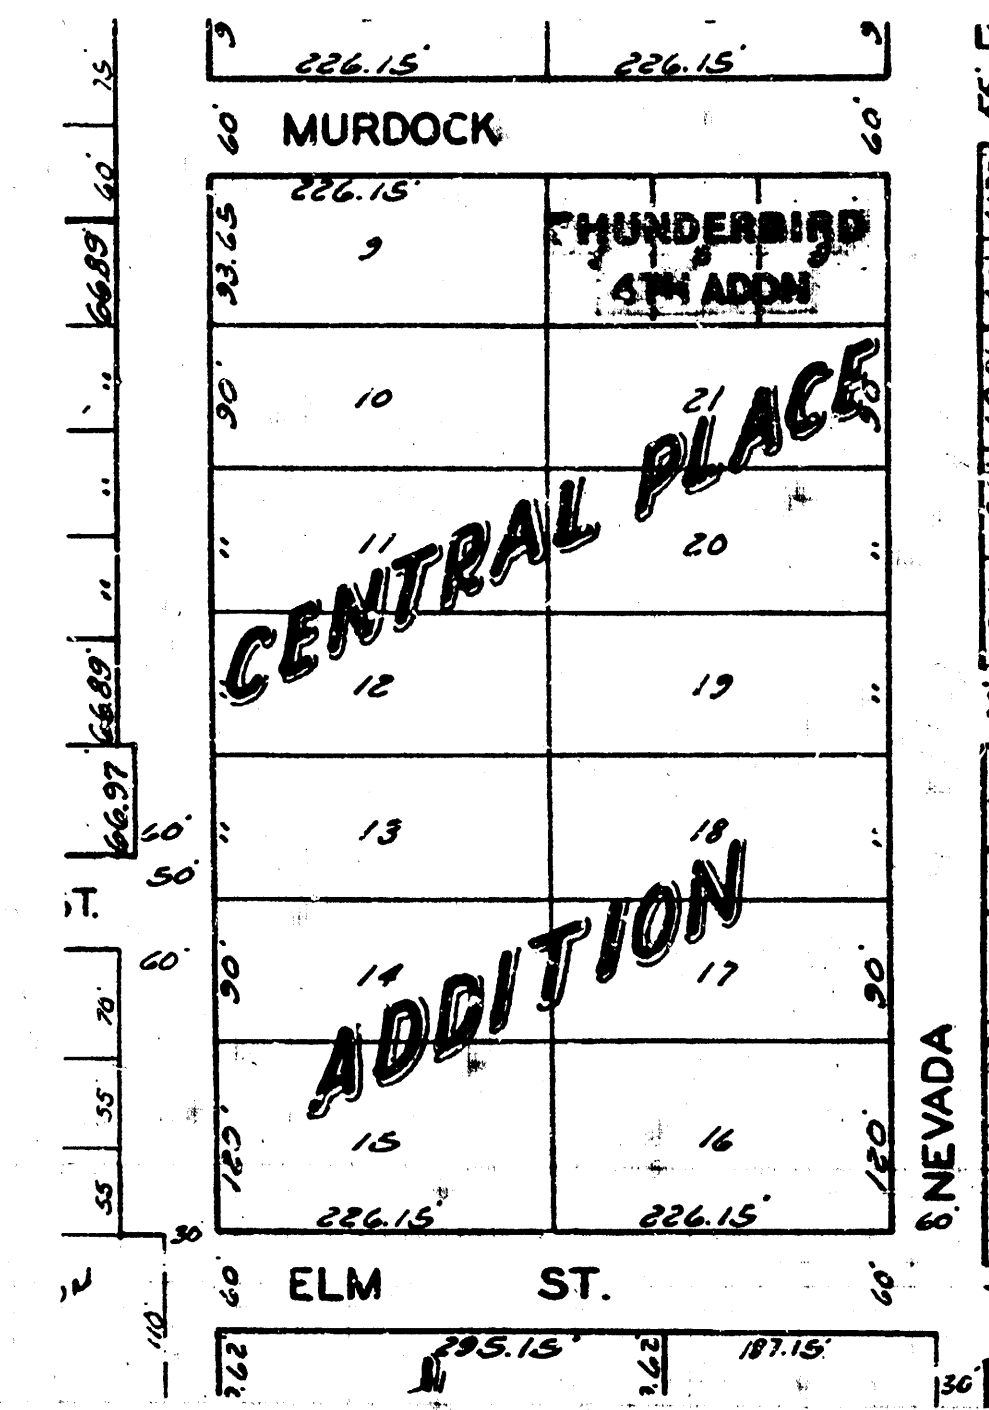

GENERAL NOTES
 Construction of homes on lots 1 and 3 will be underway prior to the sewer construction. The contractor shall coordinate construction of the sewer with the home builder. Contractor shall not damage any trees on this site.

125
120
115

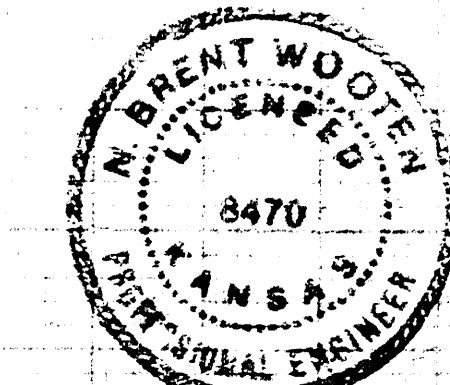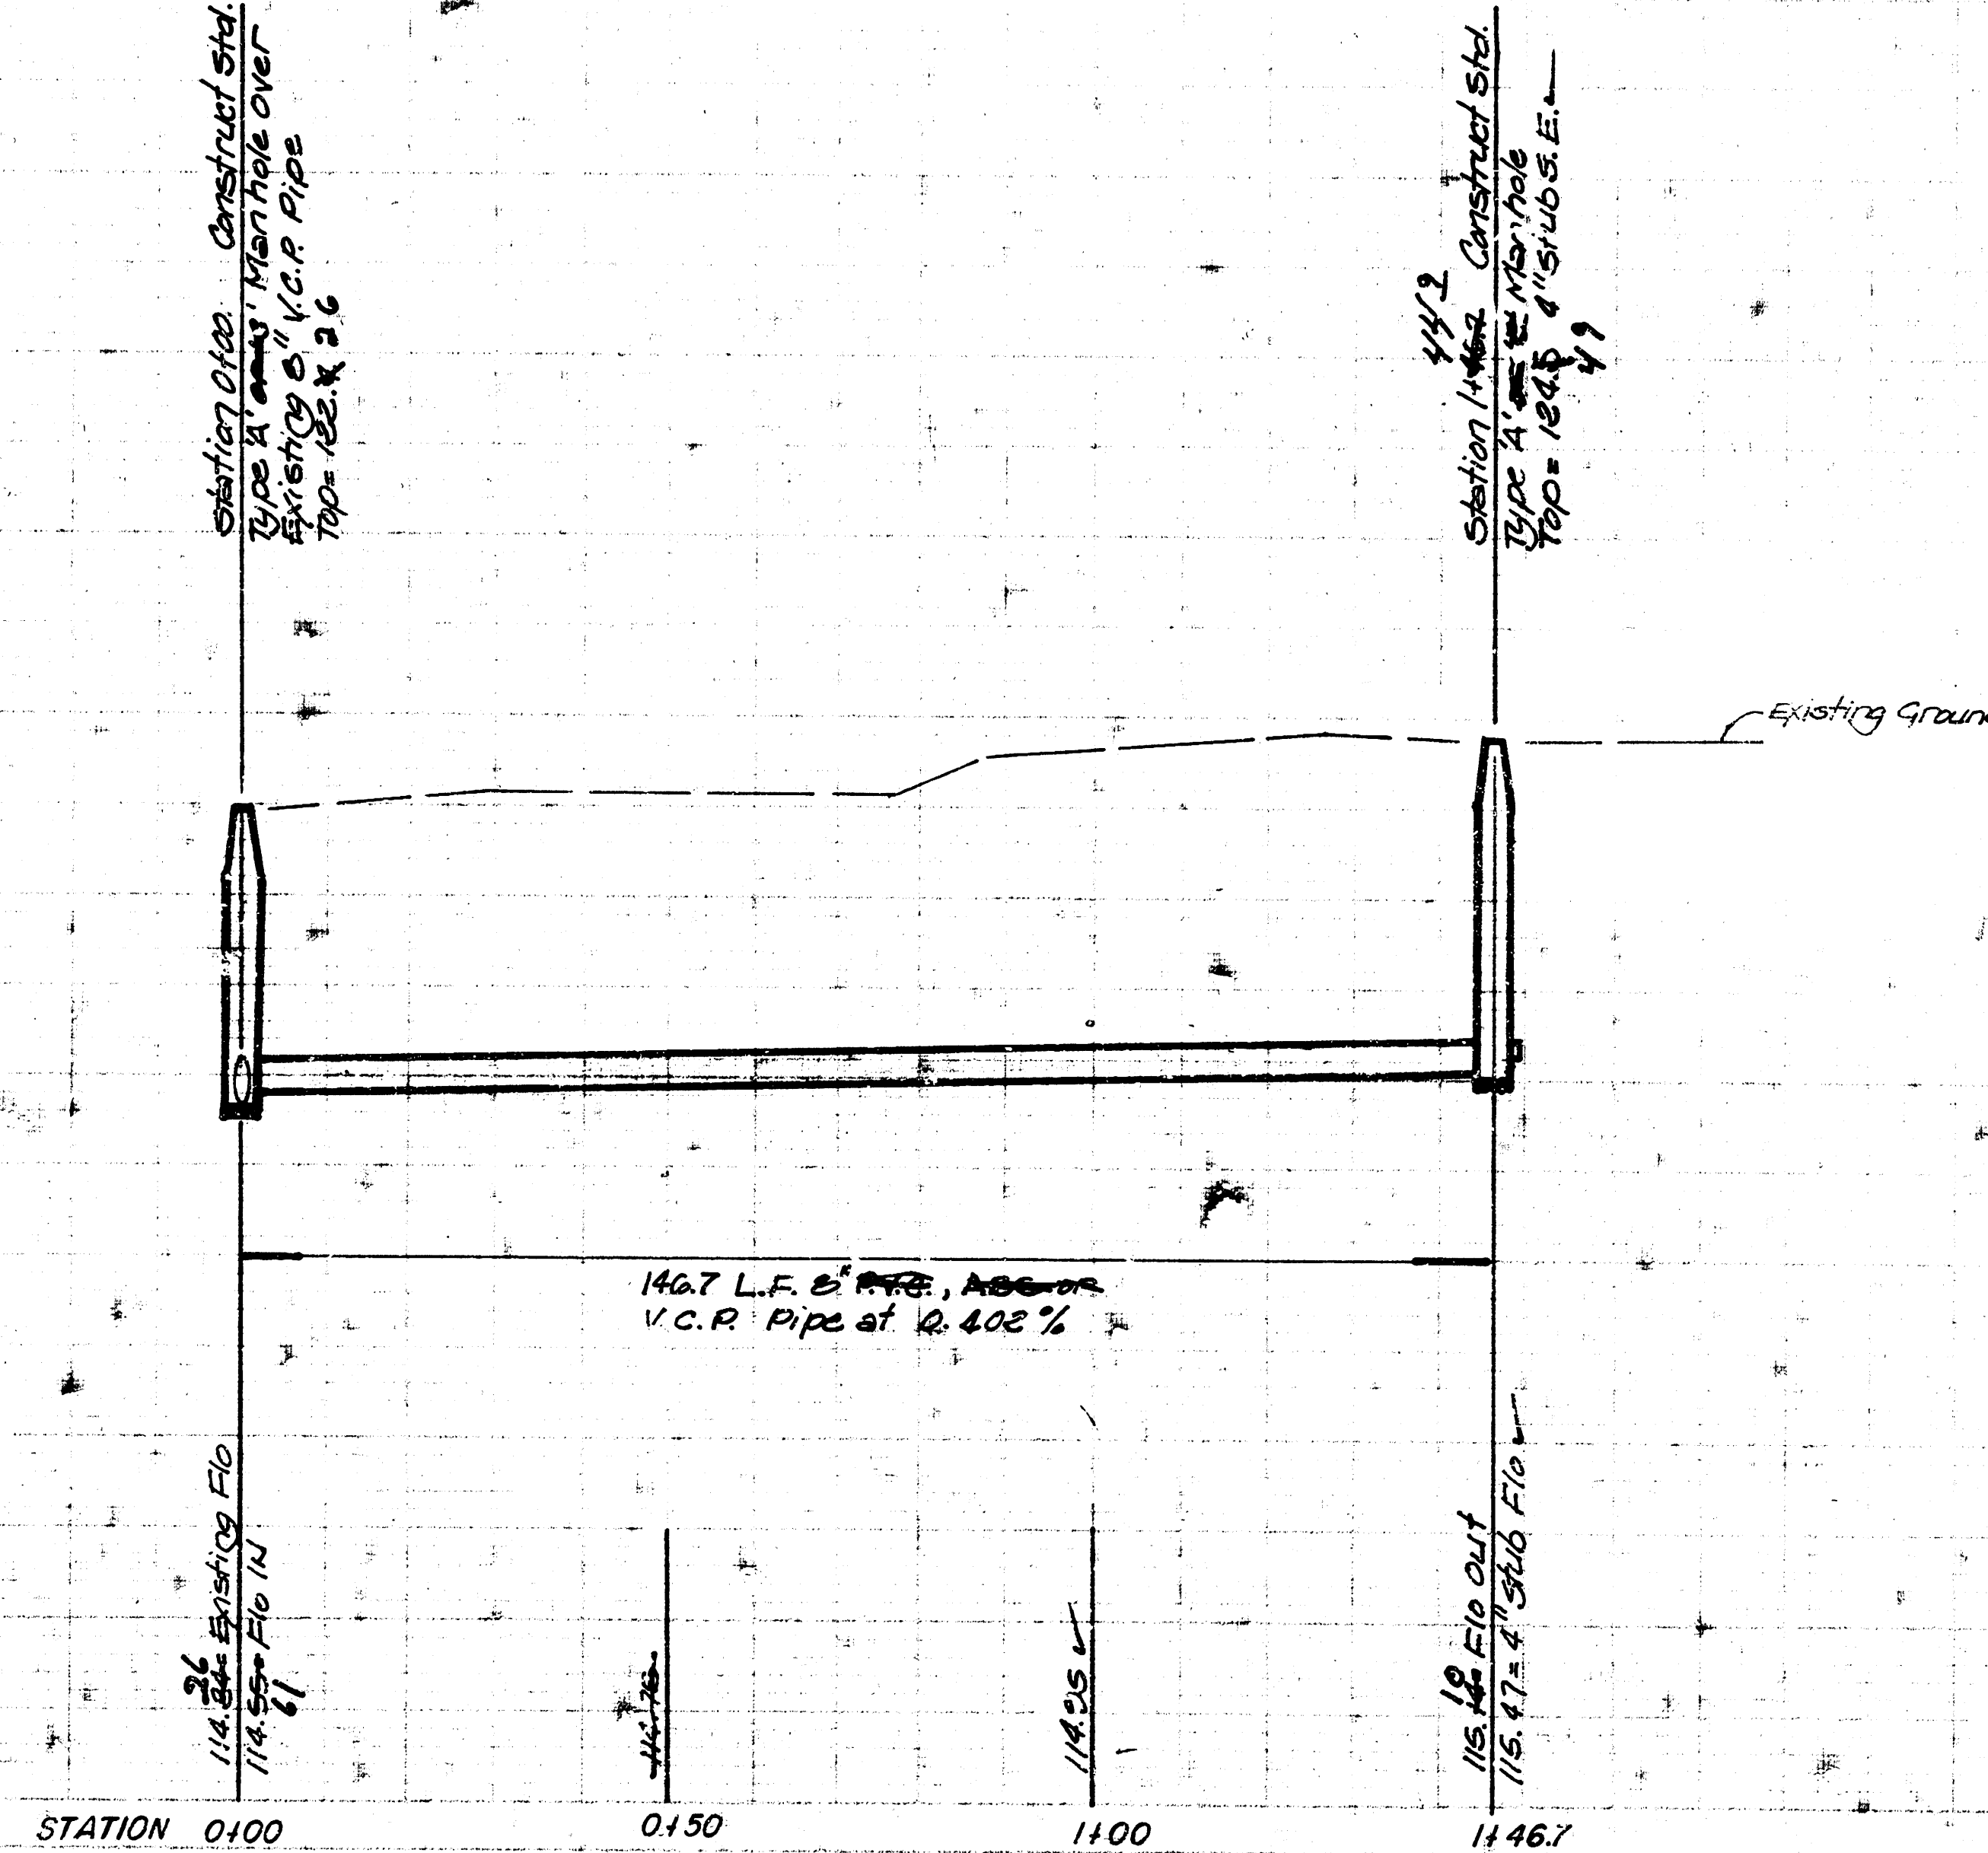

REVISED NOVEMBER 1985
 OCTOBER 1985

LAT 244, MAIN 5, SS 22

SANITARY SEWER EXTENSION TO SERVE
 LOTS 1-3 THUNDERBIRD 4TH ADDITION

CITY OF WICHITA, KS
 PROJECT NO 468-76-245-81485-000-000-001

BAUGHMAN COMPANY, P.A.
 SURVEYING & ENGINEERING
 316/262-7271 • 330 LAURA • WICHITA, KANSAS 67211

10 8 3 1

FILMED FROM THE BEST AVAILABLE COPY