



B.M. 117.70 NAIL IN S.W. CORNER 2ND AVE N. OF 13TH.

### AS BUILT PLANS

Private S.S. for St. Joseph Hospital

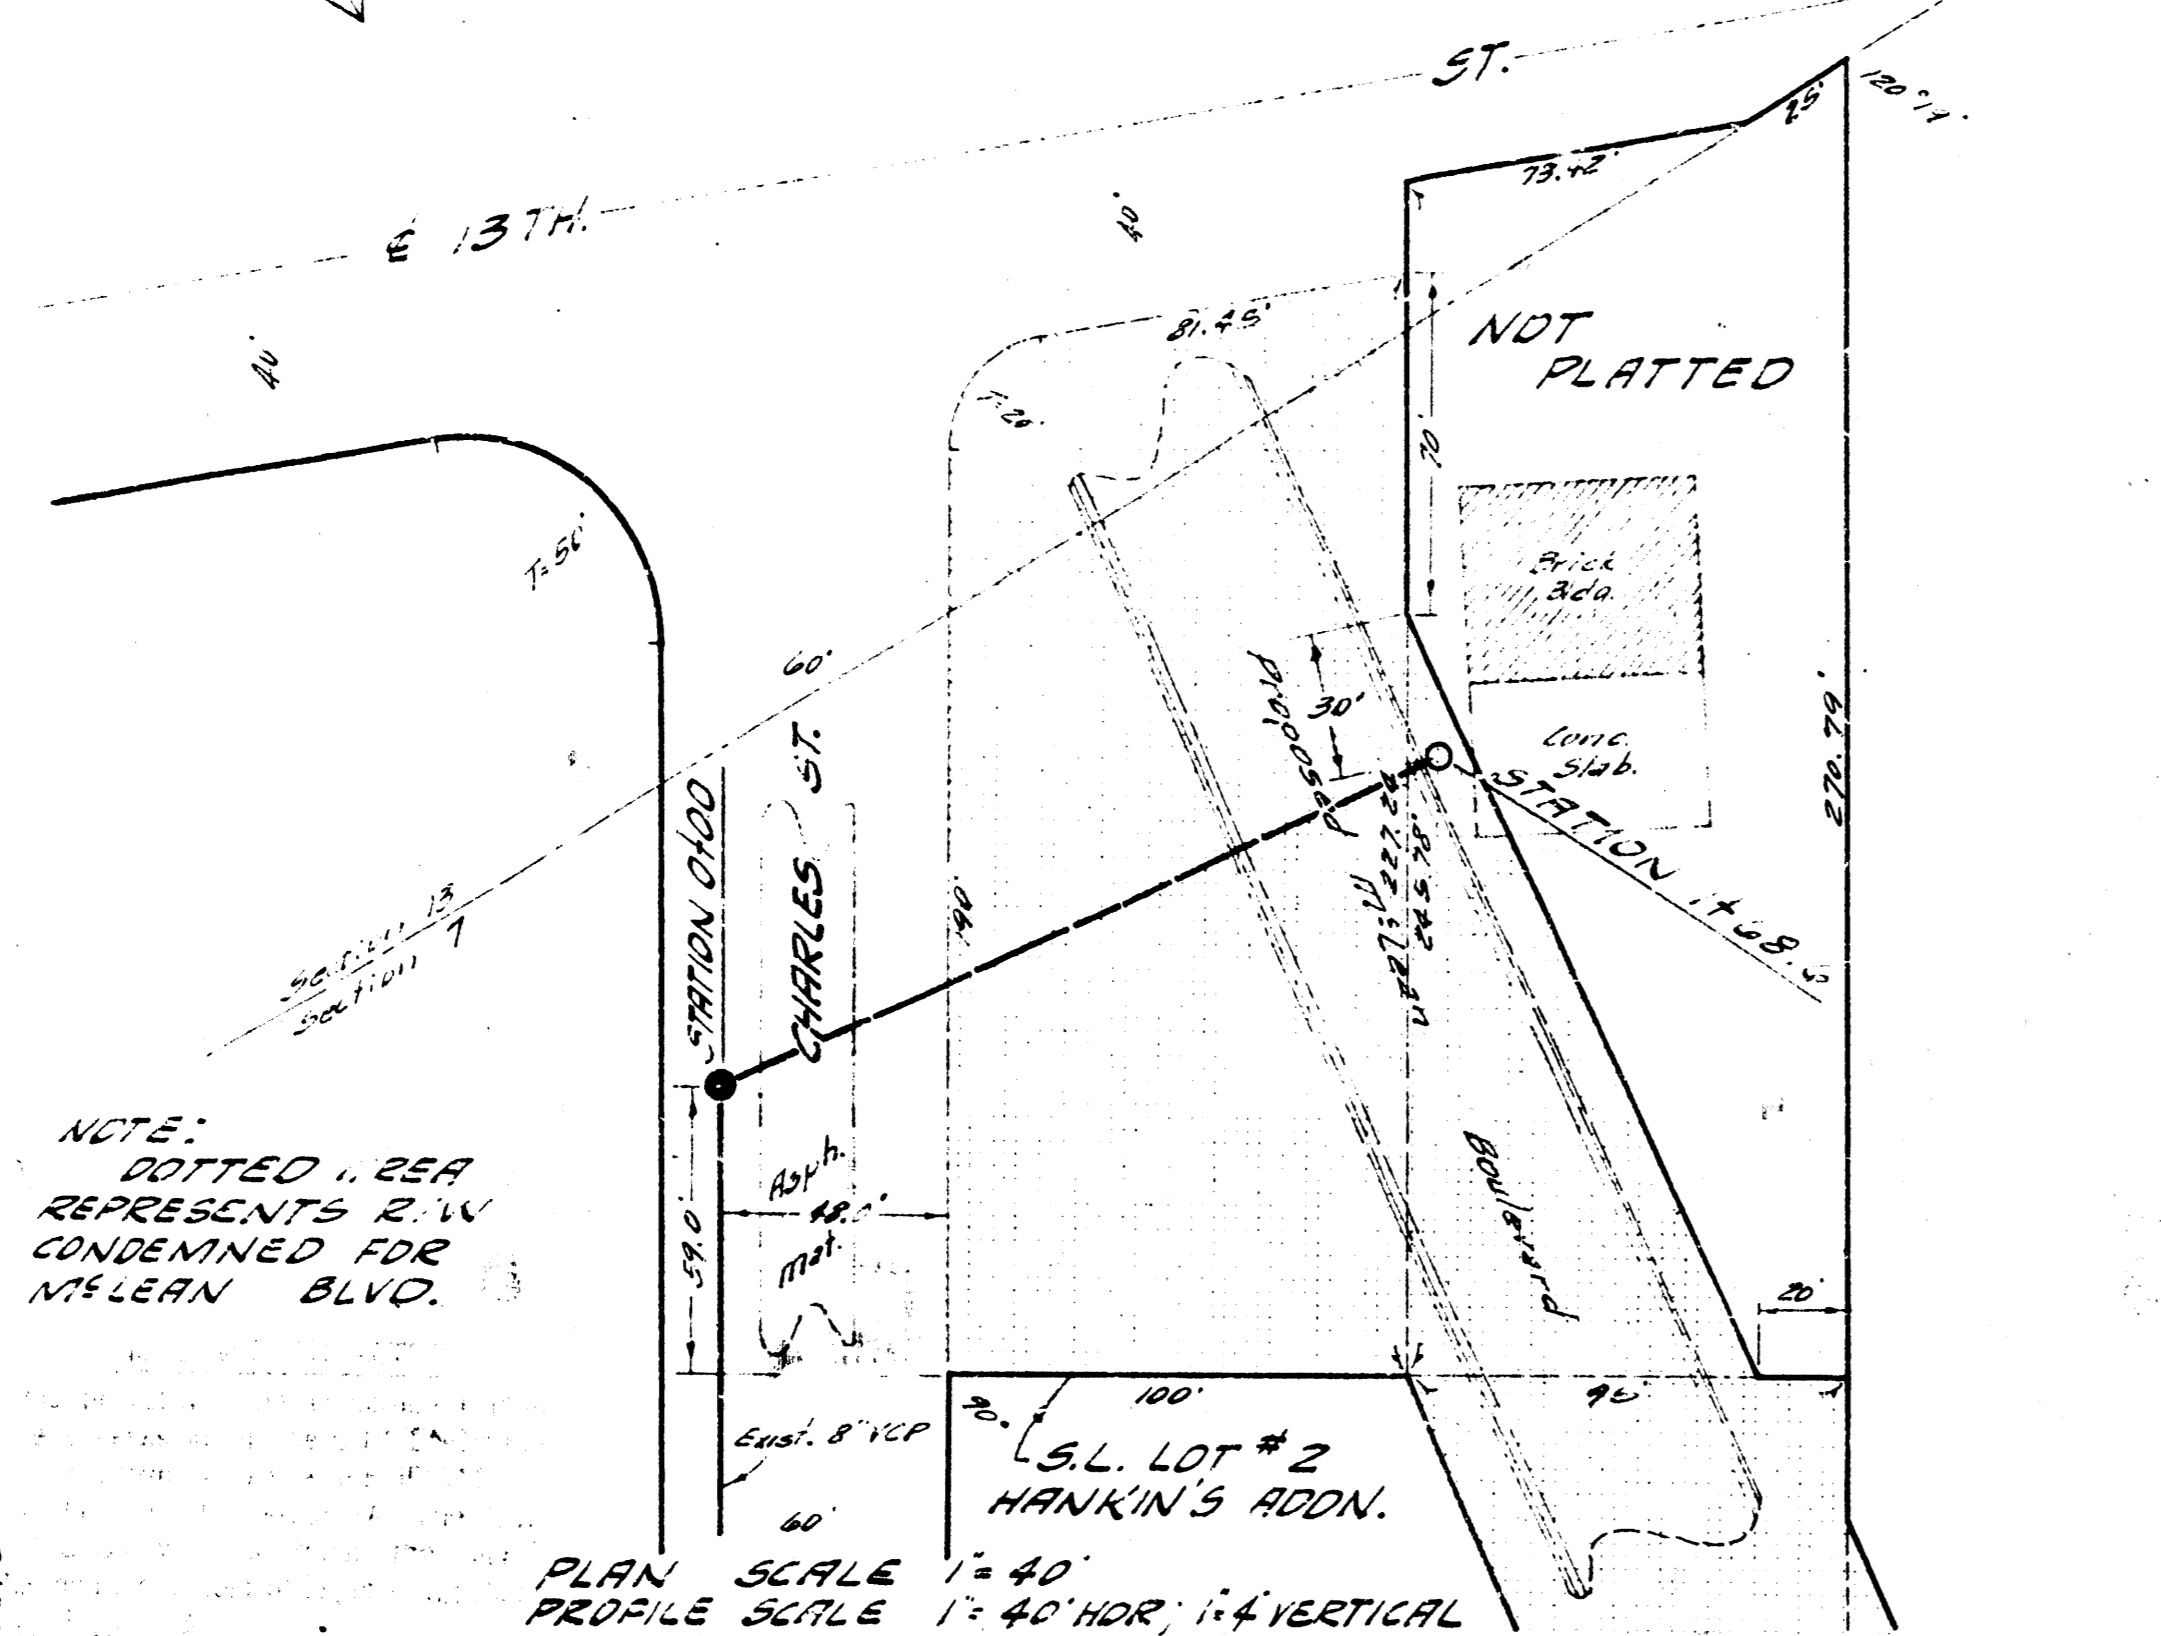


PLAN SCALE 1" = 40'  
PROFILE SCALE 1" = 40' HOR., 1" = 4' VERTICAL

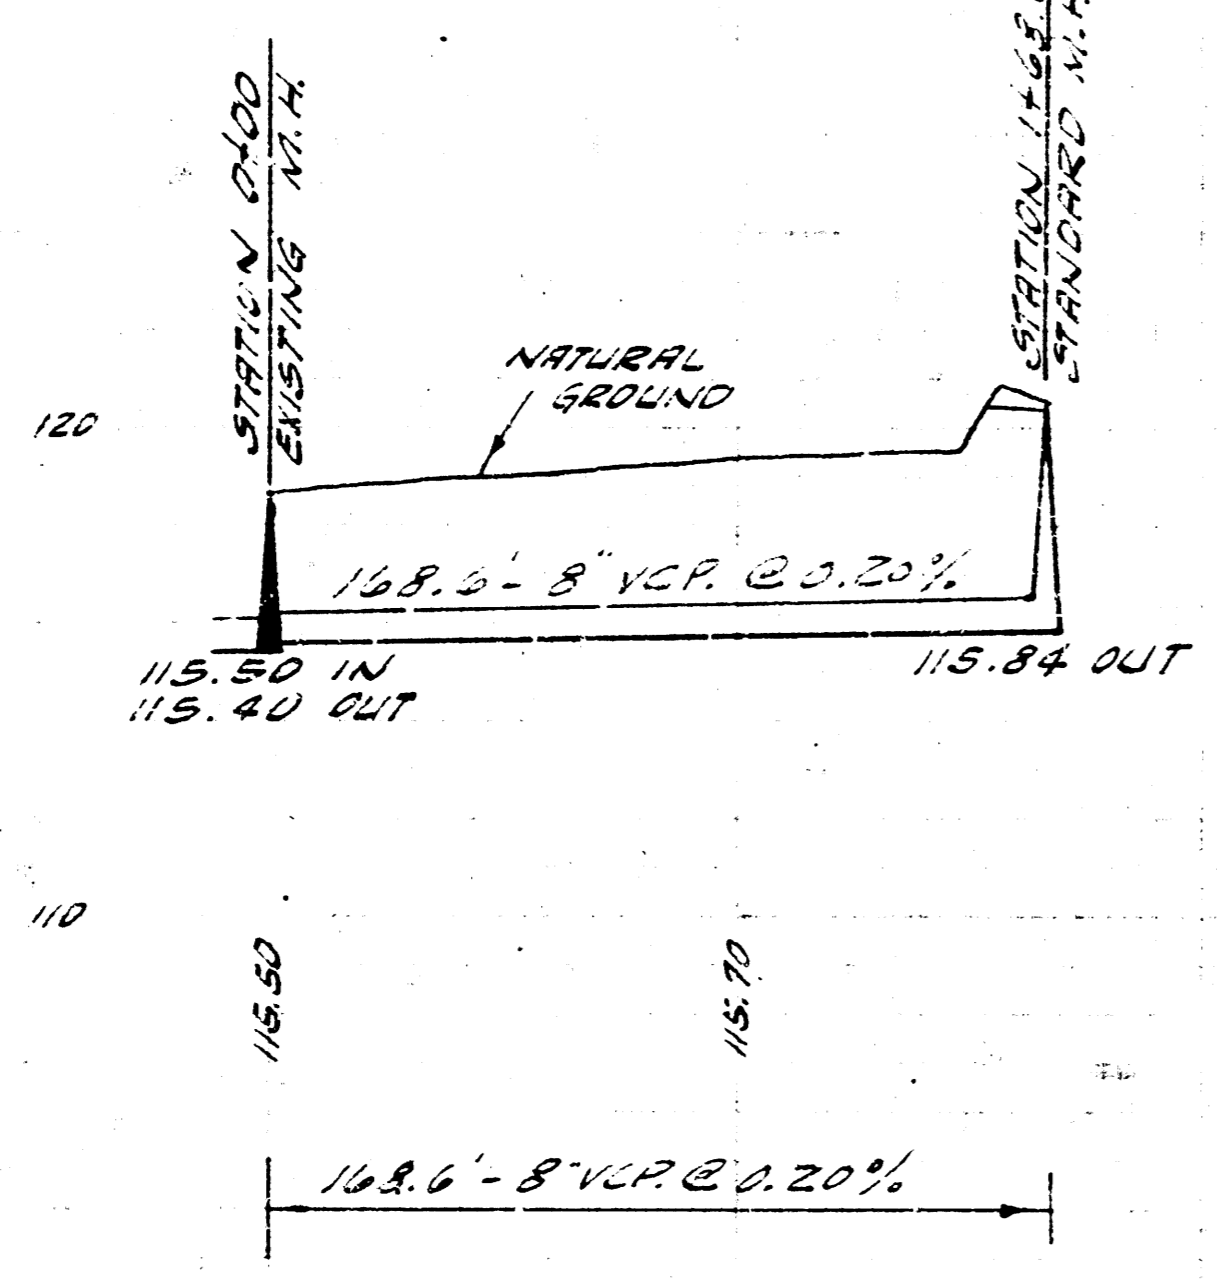


### AS BUILT PLANS


EXT. OF LAT 16 SUB. 13 SAN. SEWER 22  
 CITY OF WICHITA, KANSAS  
 B.E. SMITH CITY ENGINEER  
 PRIVATE JOB. MAY, 1960

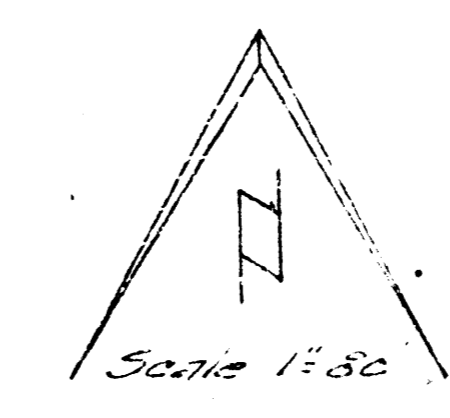

ST. JOSEPH HOSPITAL

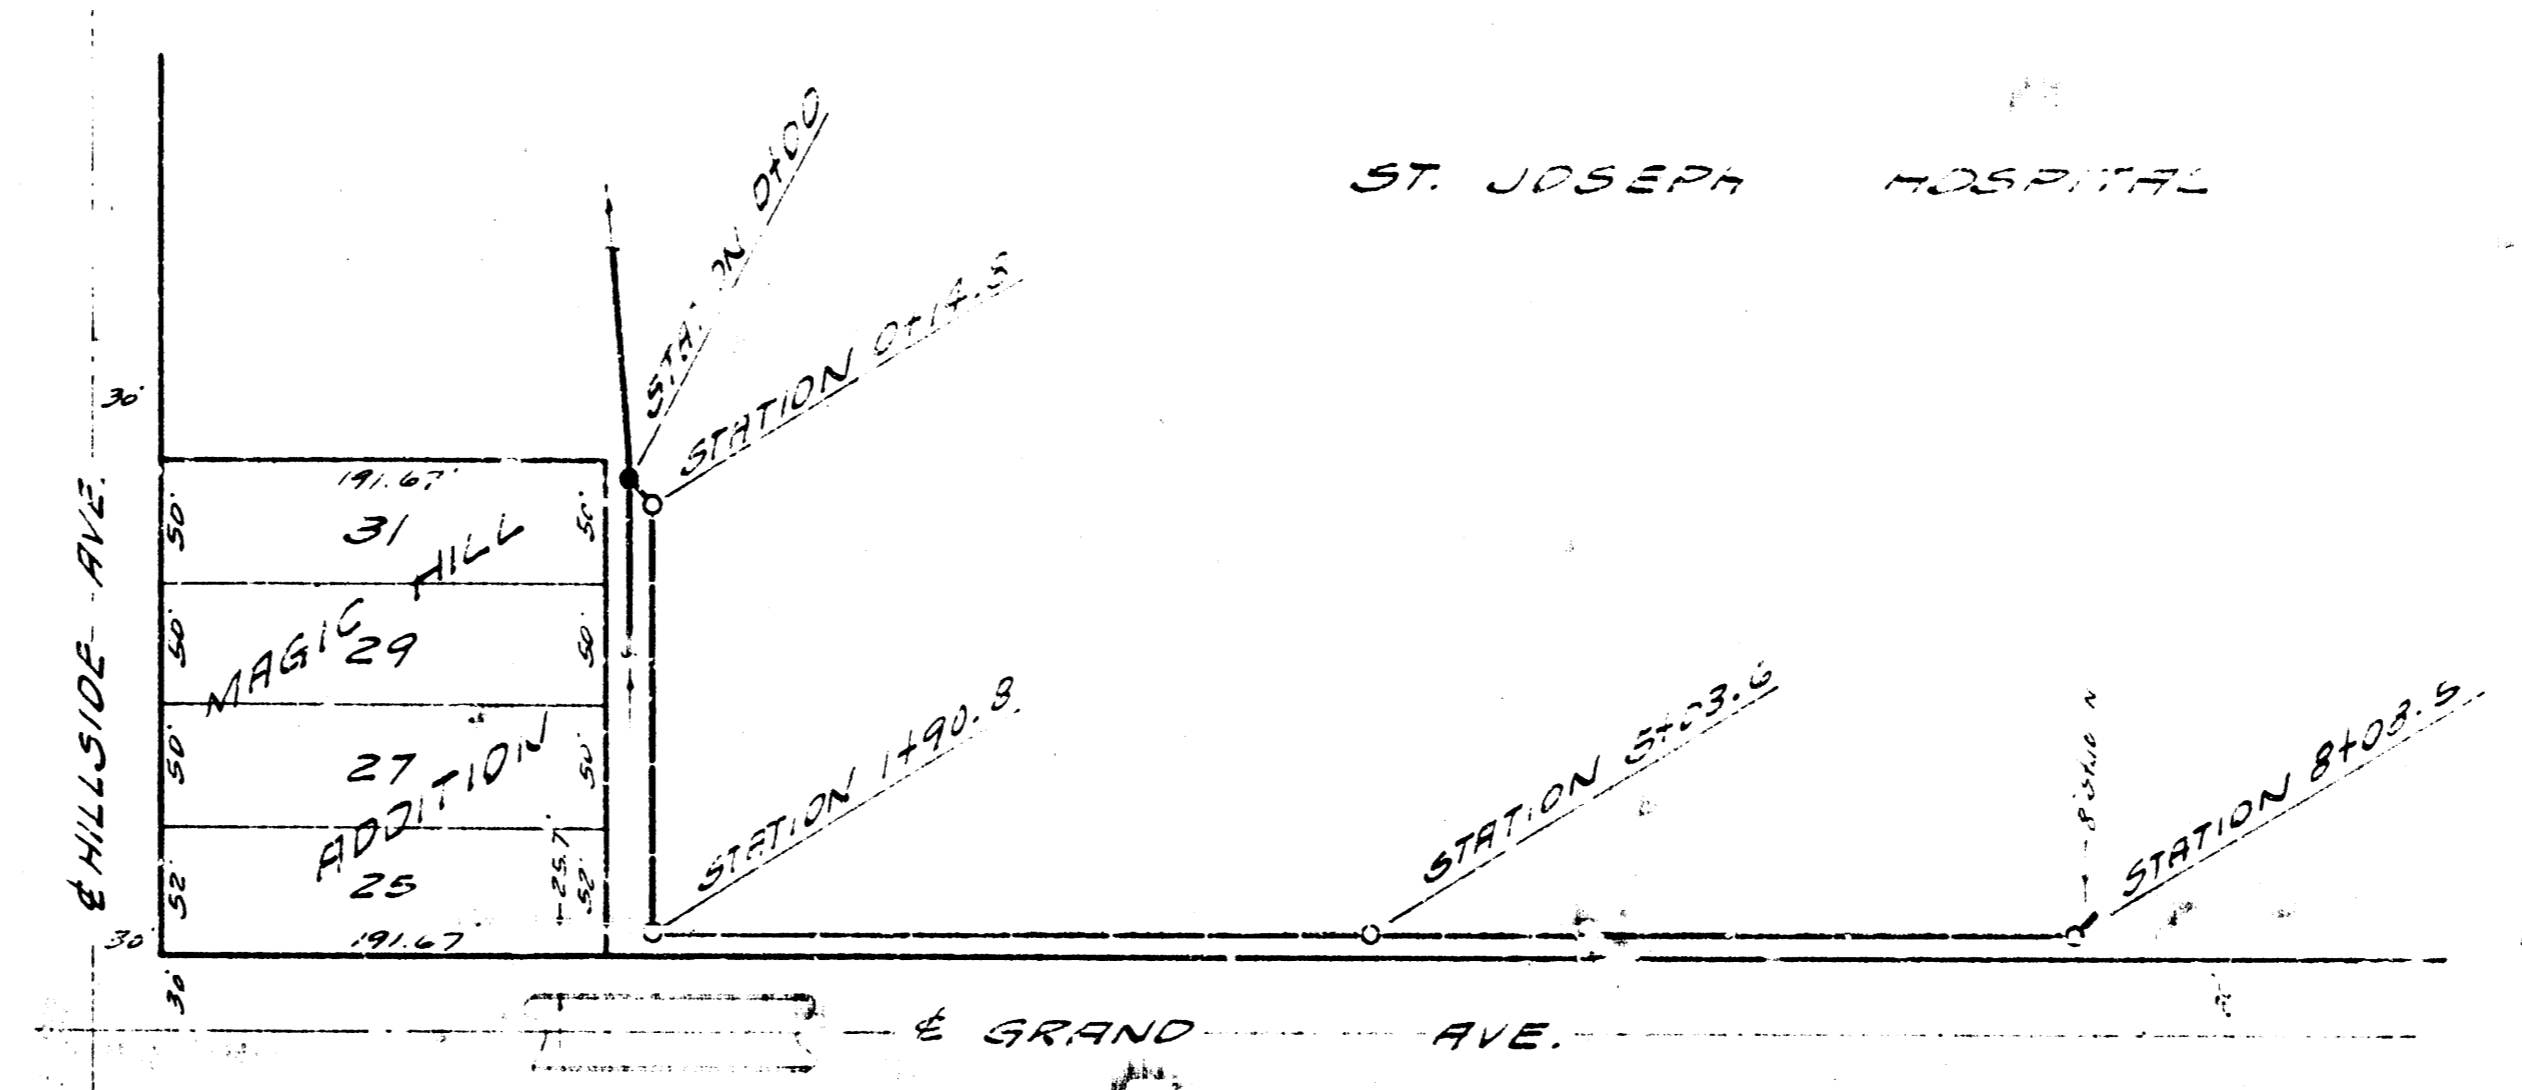

PLAN SCALE 1" = 80'  
PROFILE SCALE 1" = 40' HOR., 1" = 4' VERT.

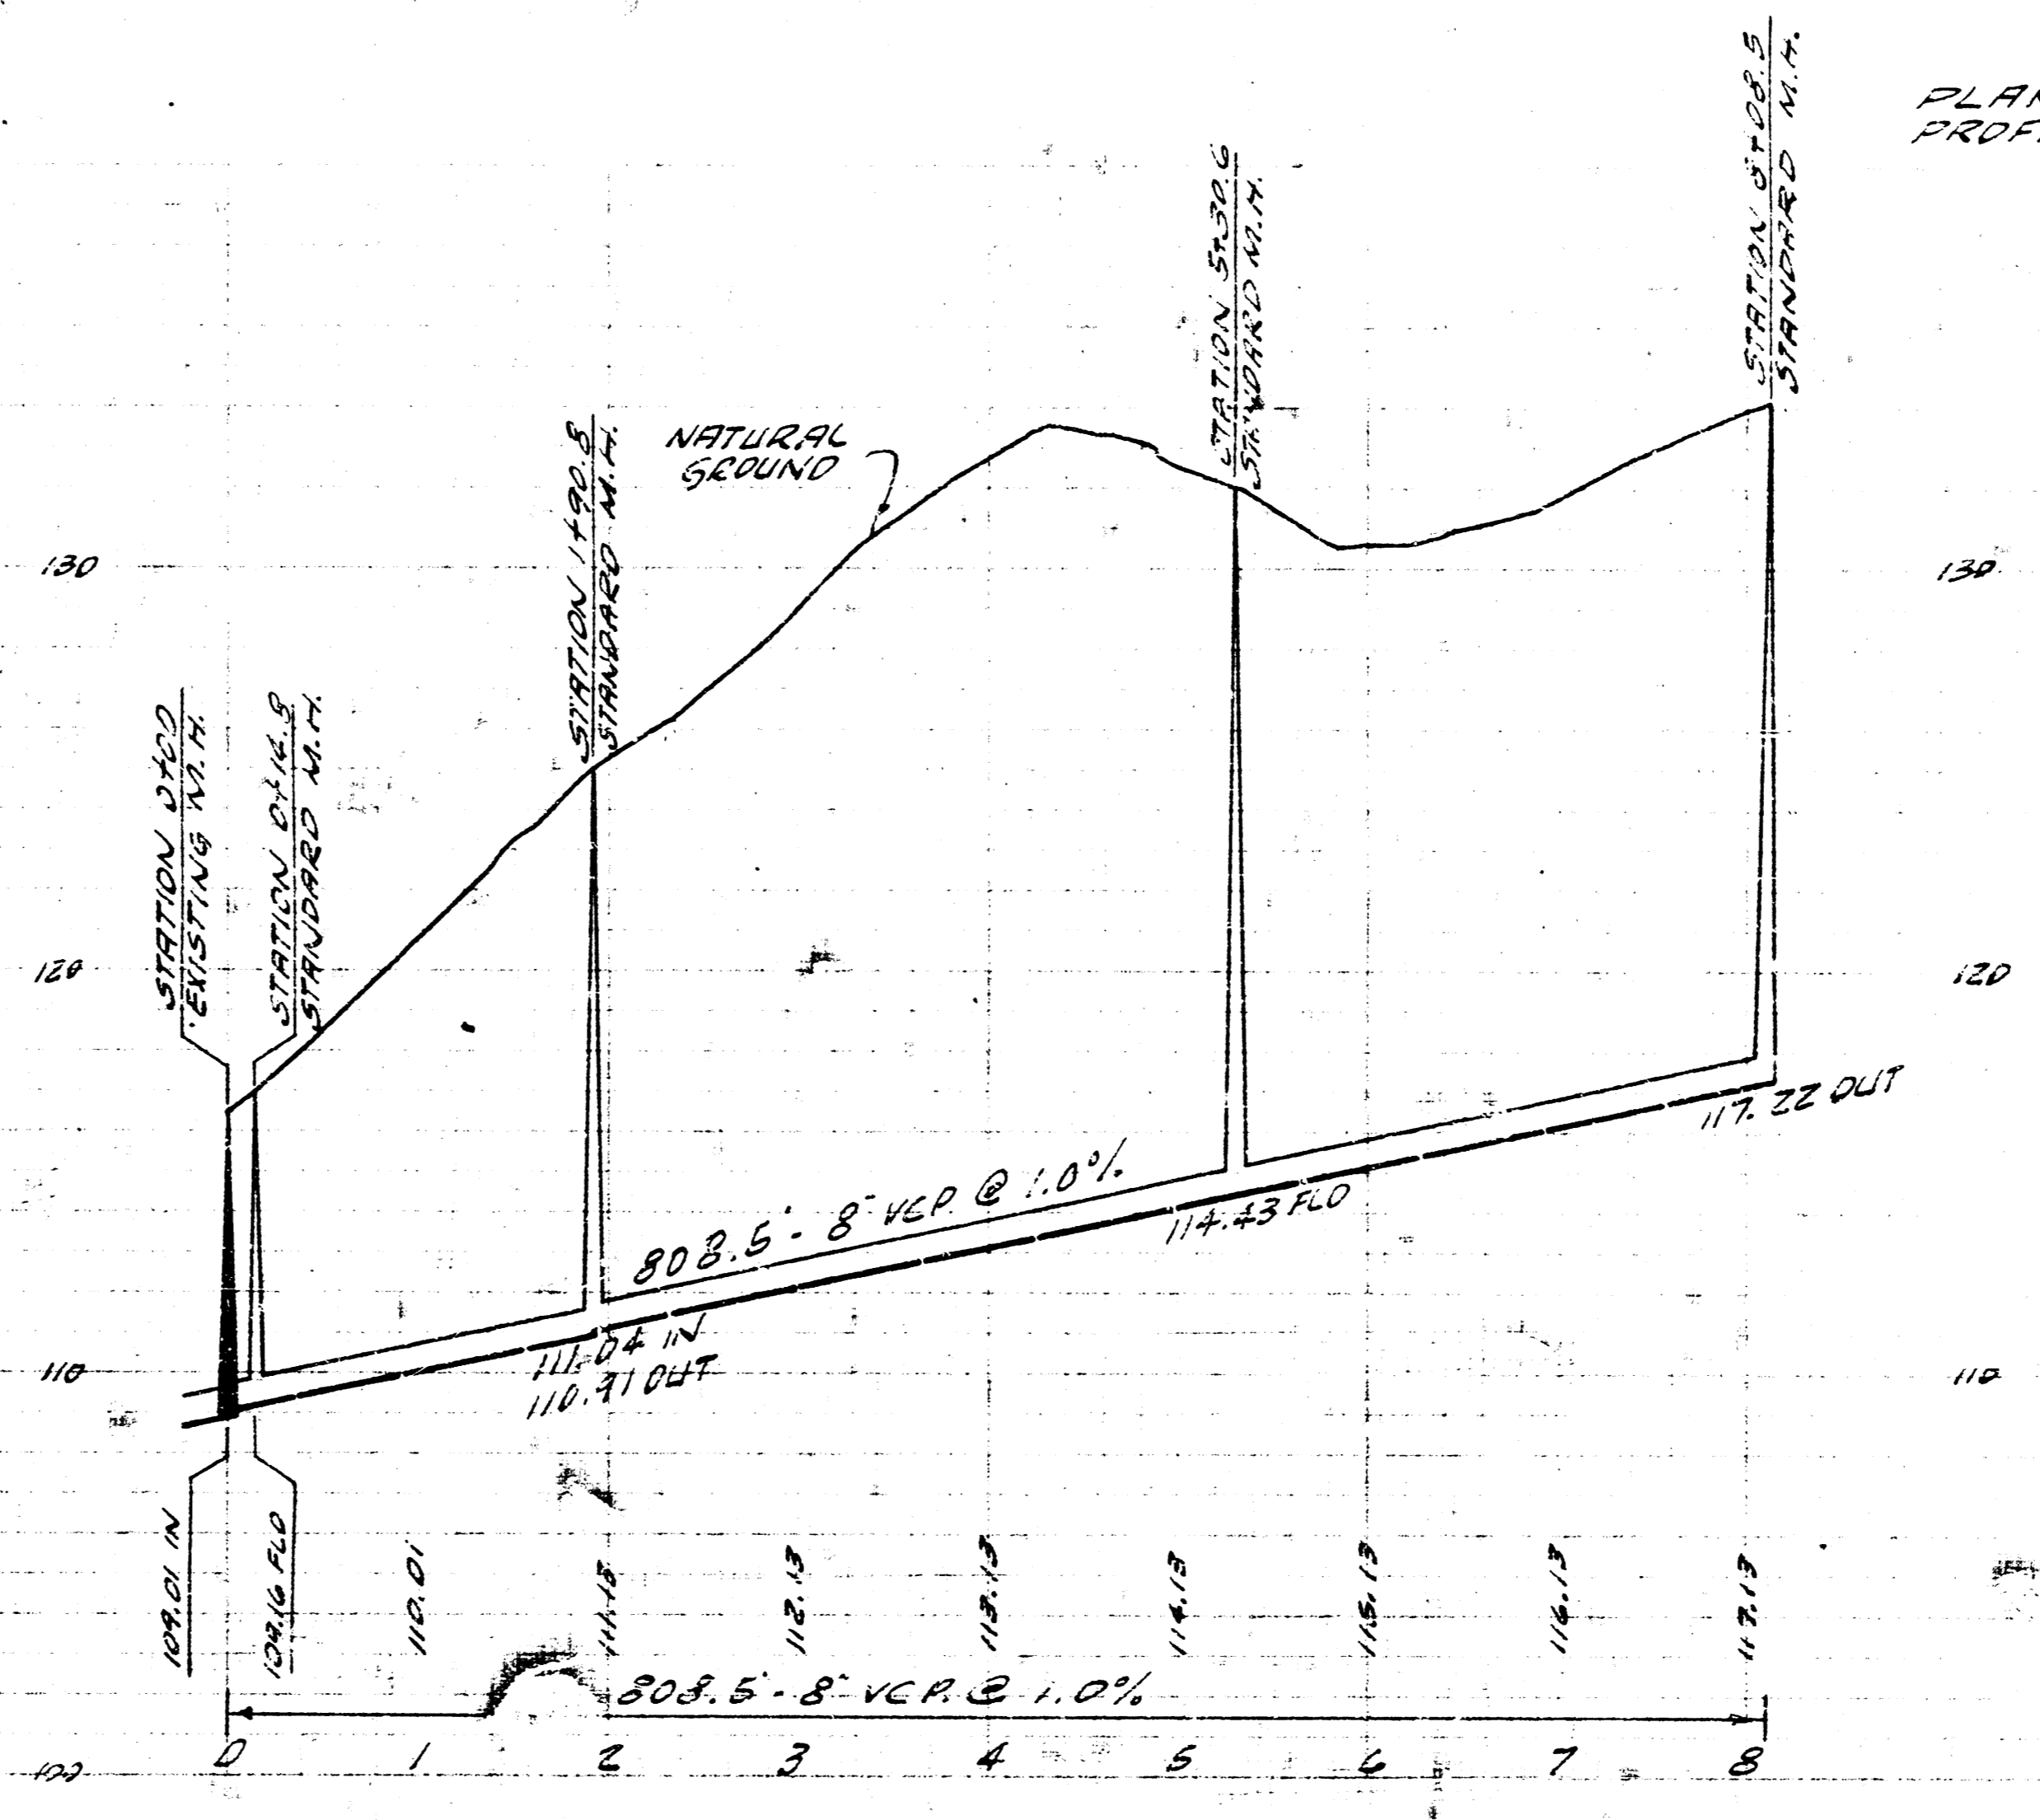

PRIVATE S.S. FOR ST. JOSEPH HOSPITAL  
 CITY OF WICHITA, KANSAS  
 B.E. SMITH CITY ENGINEER  
 PRIVATE JOB. JUNE 1960