



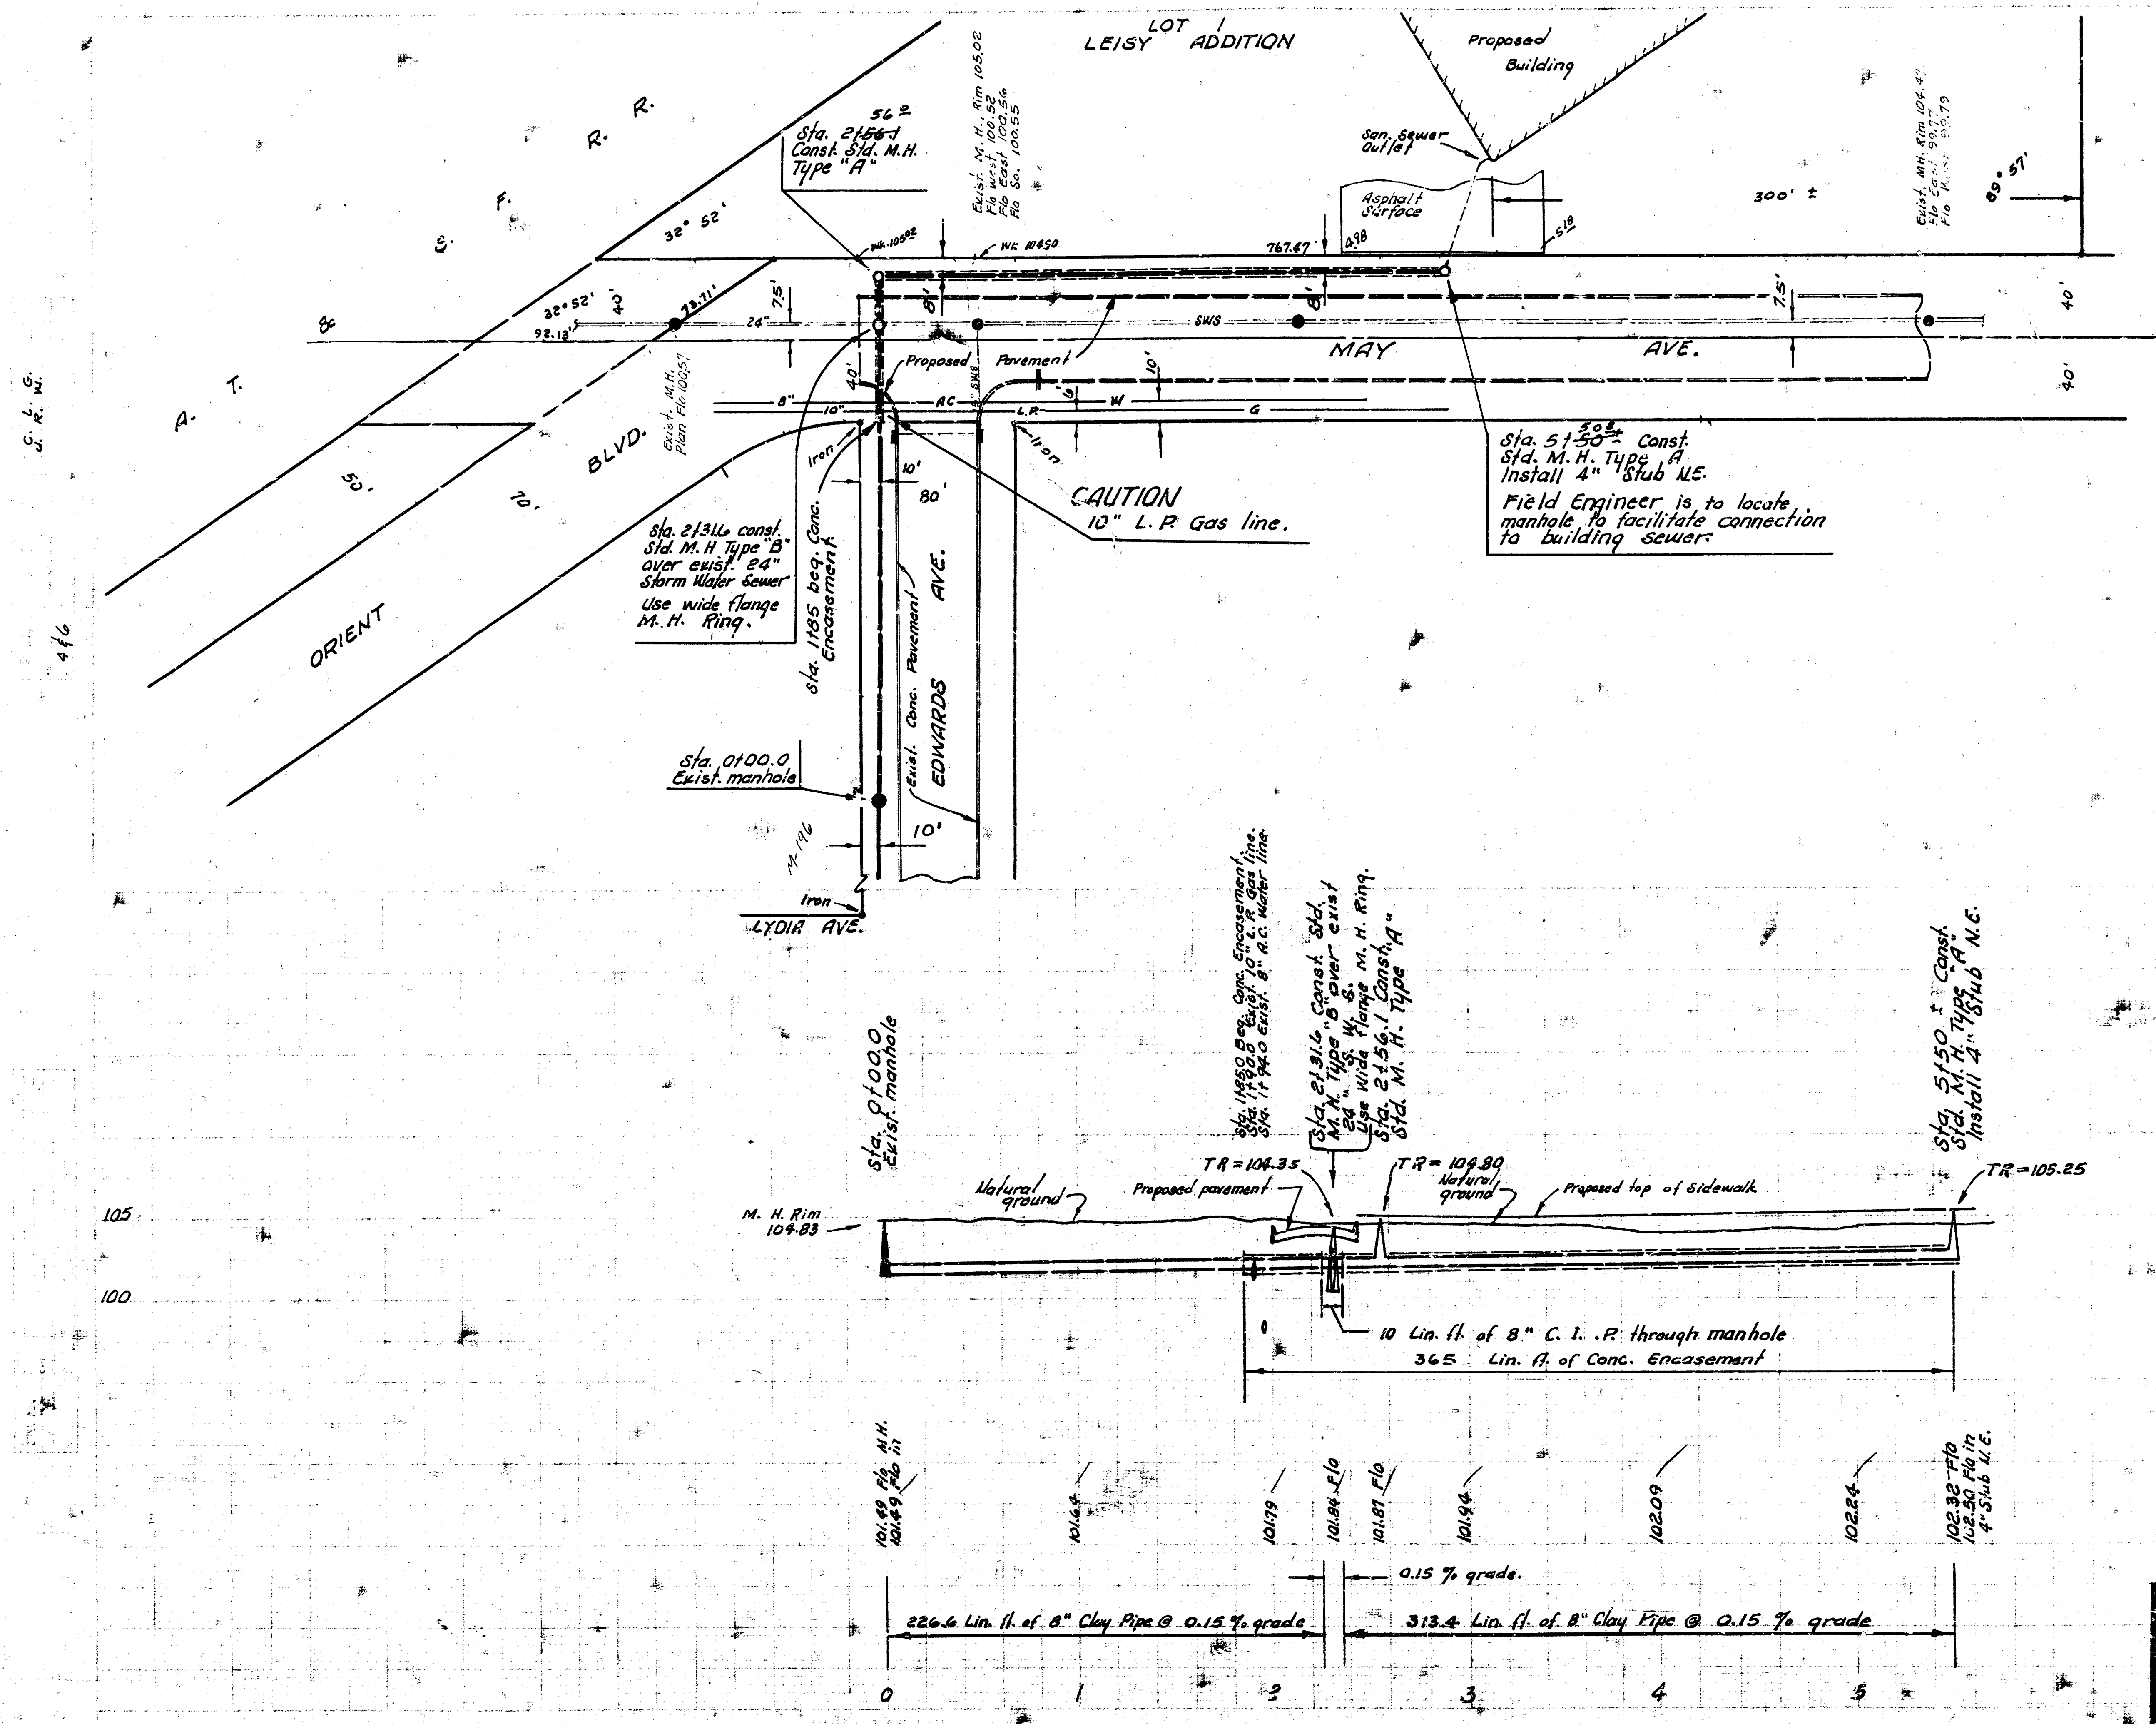

Plan Scale 1" = 40'
Profile Scale 1" = 40' Horiz.
1" = 5' Vert.

B.M. 104.49' on east curb of Edwards St. south of 81 May.

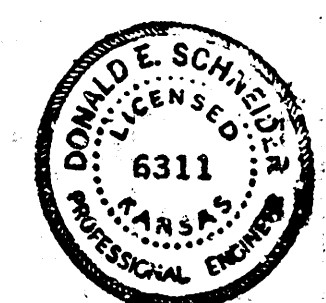

As Built Final Map S.S. 16-25
LAT. 6, MAIN 16, S. S. NO. 22
CITY OF WICHITA, KANSAS
R. W. LINN — CITY ENGINEER
DEC. 1973 PROJECT NO. BSKL 573053

FILMED BY THE BUREAU