


LATERAL 8, MAIN 16 SANITARY SEWER NO. 22

To Serve Lots 1 and 2, LaCount Addition

PROJECT NO.

468-76-245-81744-000-000-001

CITY OF WICHITA, KANSAS
Michael E. Lindebak - City Engineer

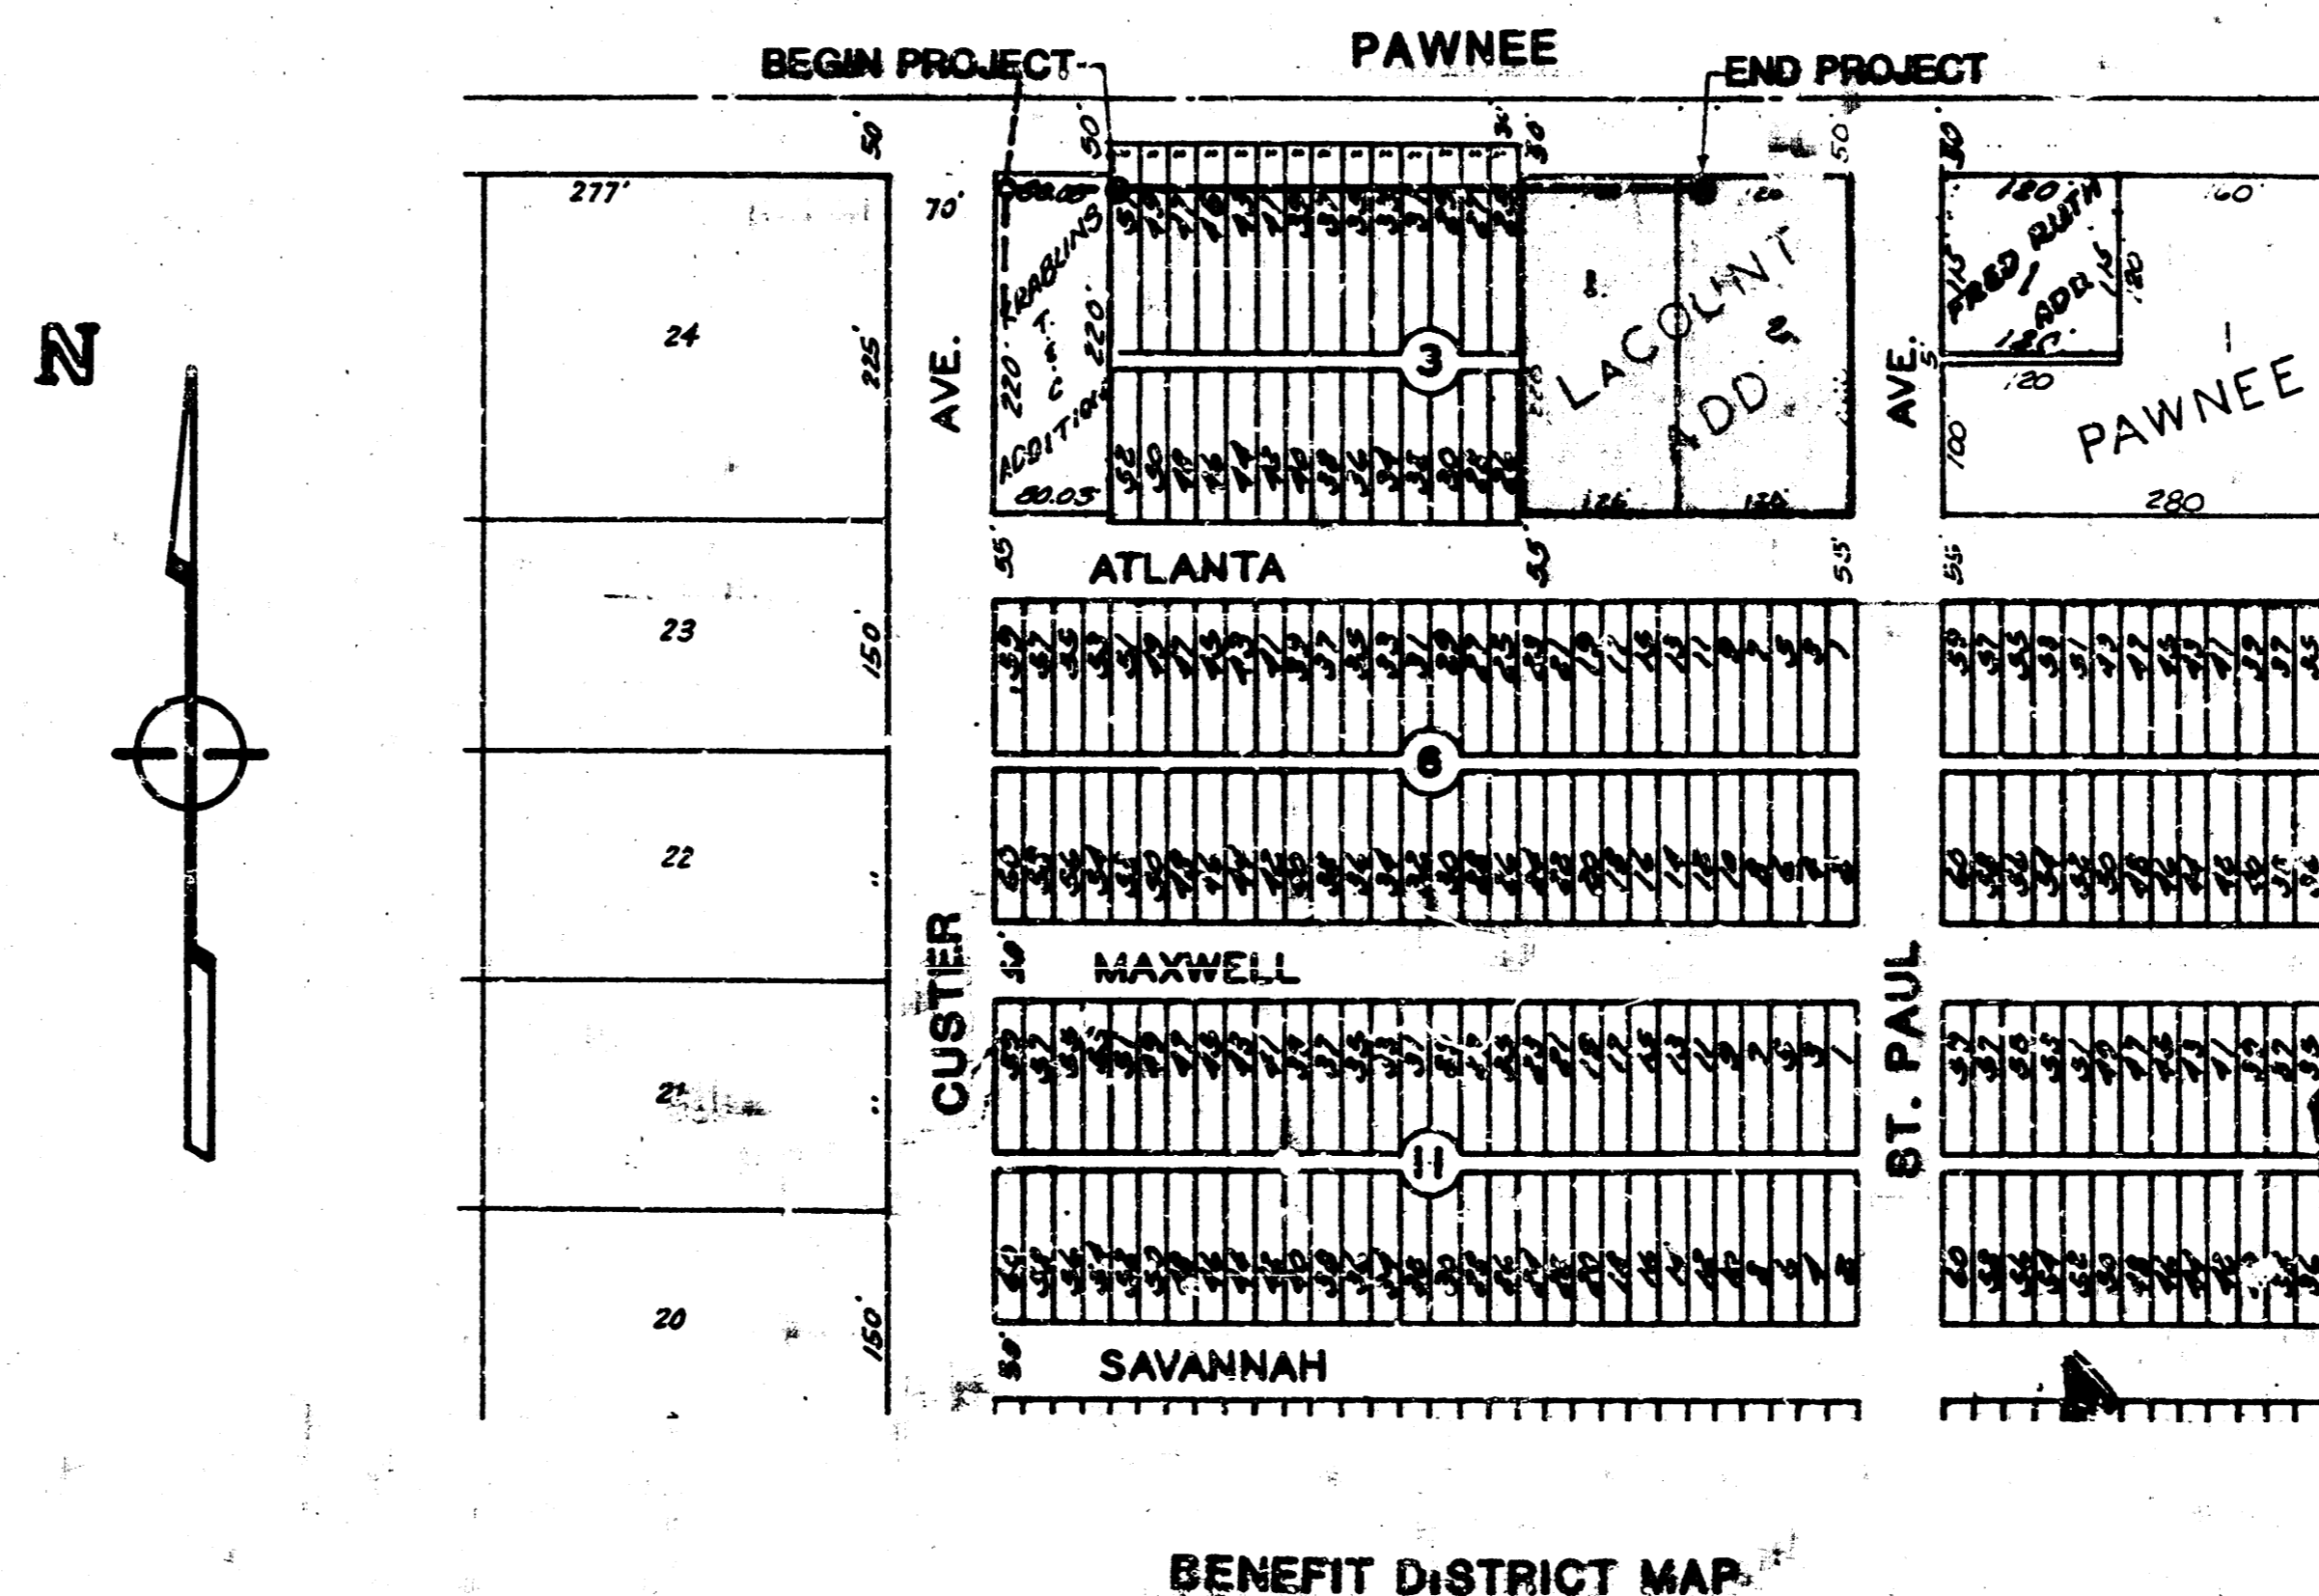

AS BUILT
20-
3-88

