

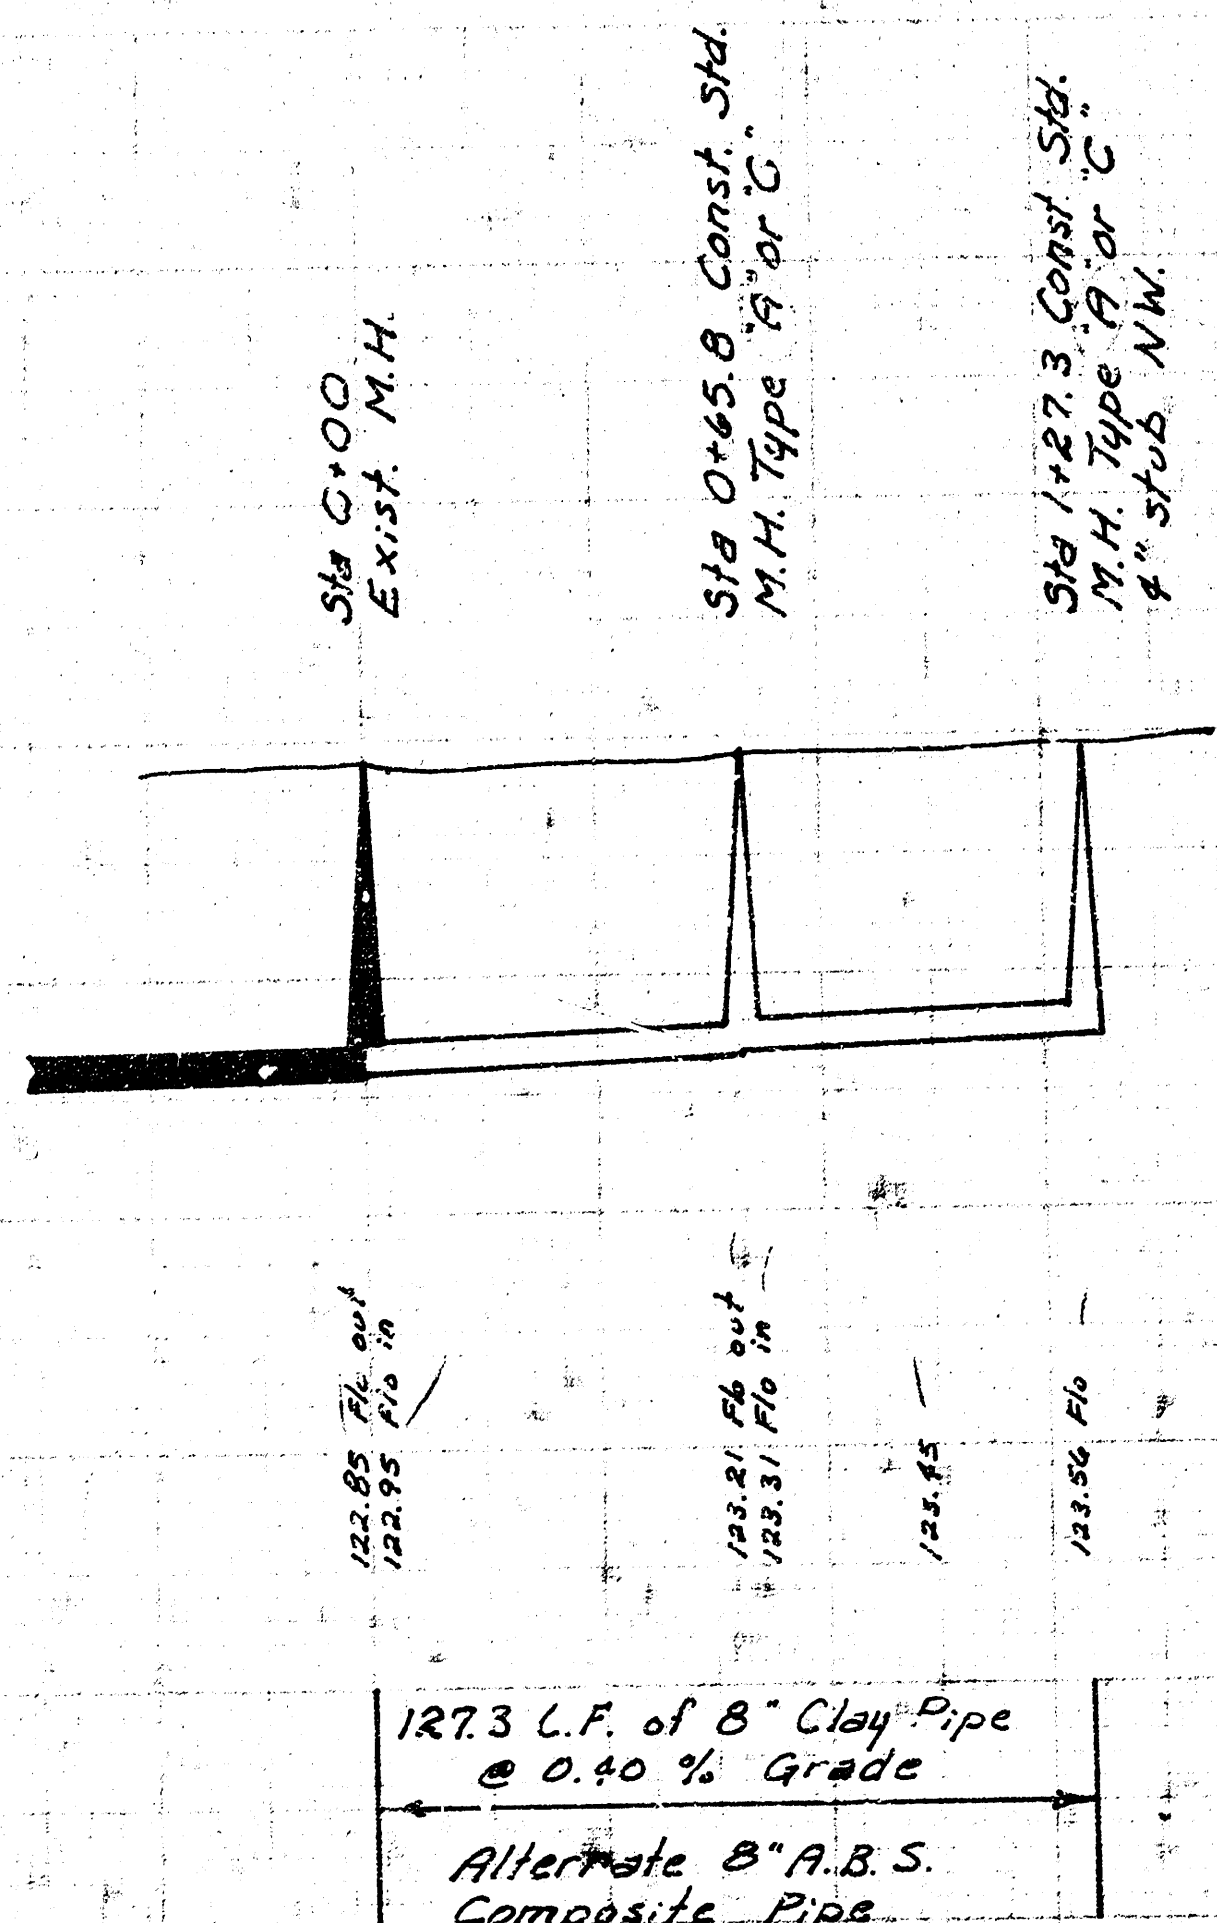


B.M. 129.04 City Std. Disc. 32' E. & 24' N.
of E. of Meridian & 29th St No.



SCALE PLAN 1" = 40'
PROFILE 1" = 40' Horiz.
1" = 5' Vert.

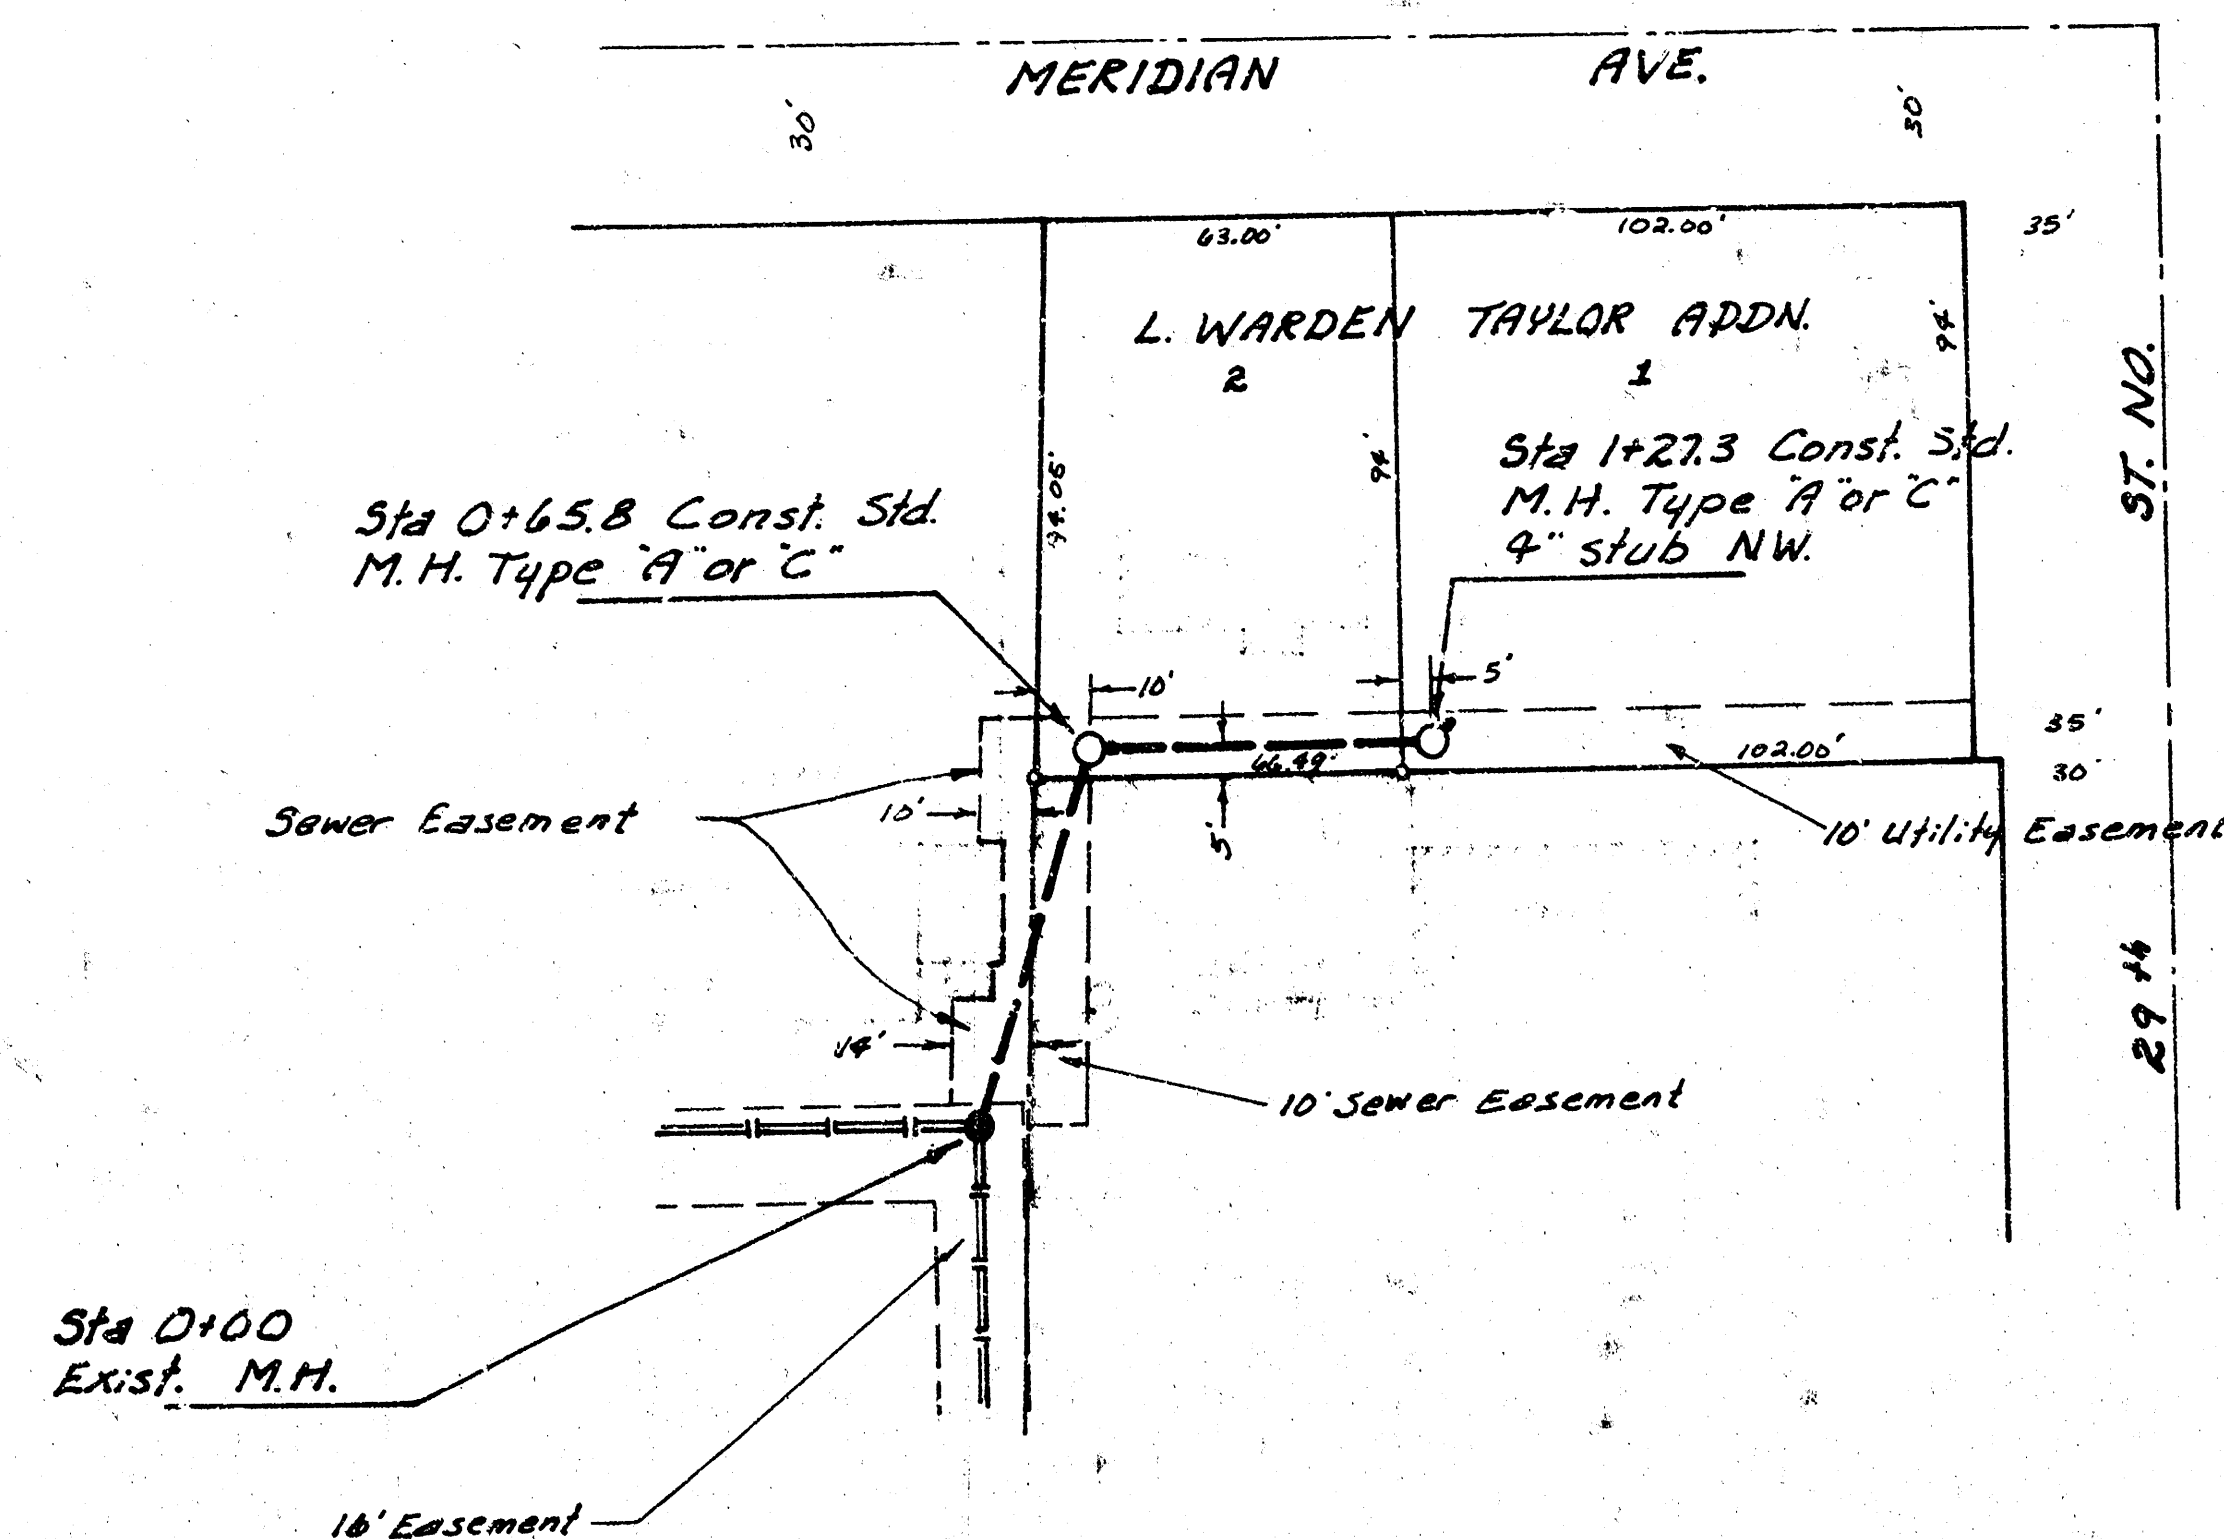

LAT 62, MAIN 17, SAN. SEW. #22
CITY OF WICHITA, KANSAS
R. W. LINN - CITY ENGINEER
PROJ. NO. 468-76245-80453-000-000-001

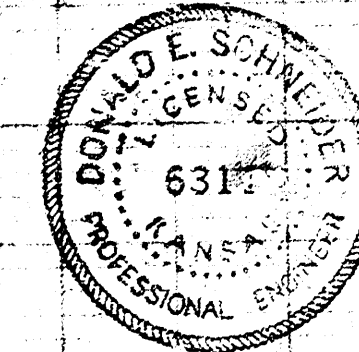

Scale Plan 1" = 40'
Profile 1" = 40' Horiz.
1" = 5' Vert.

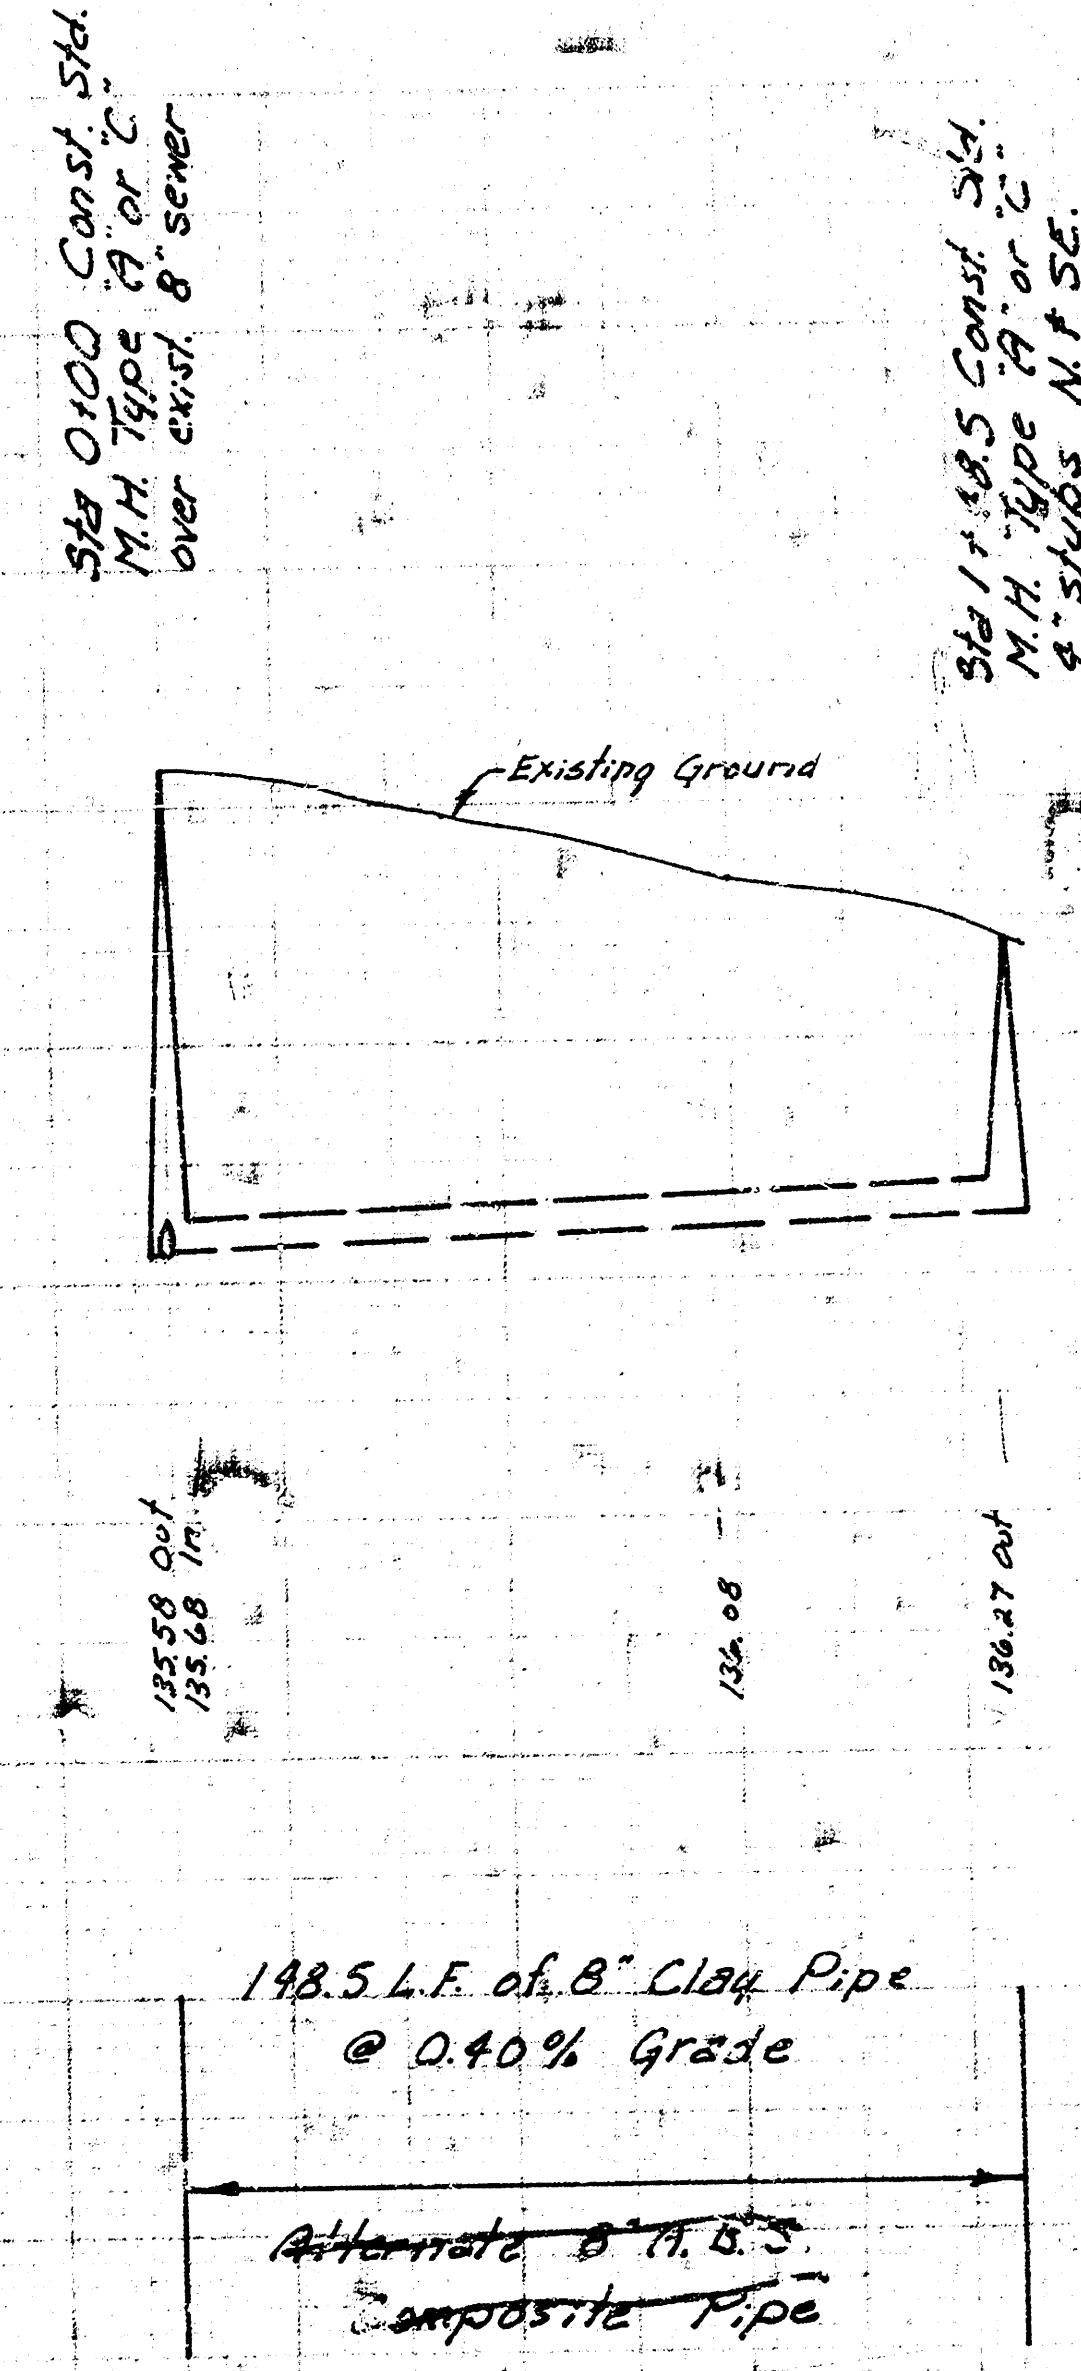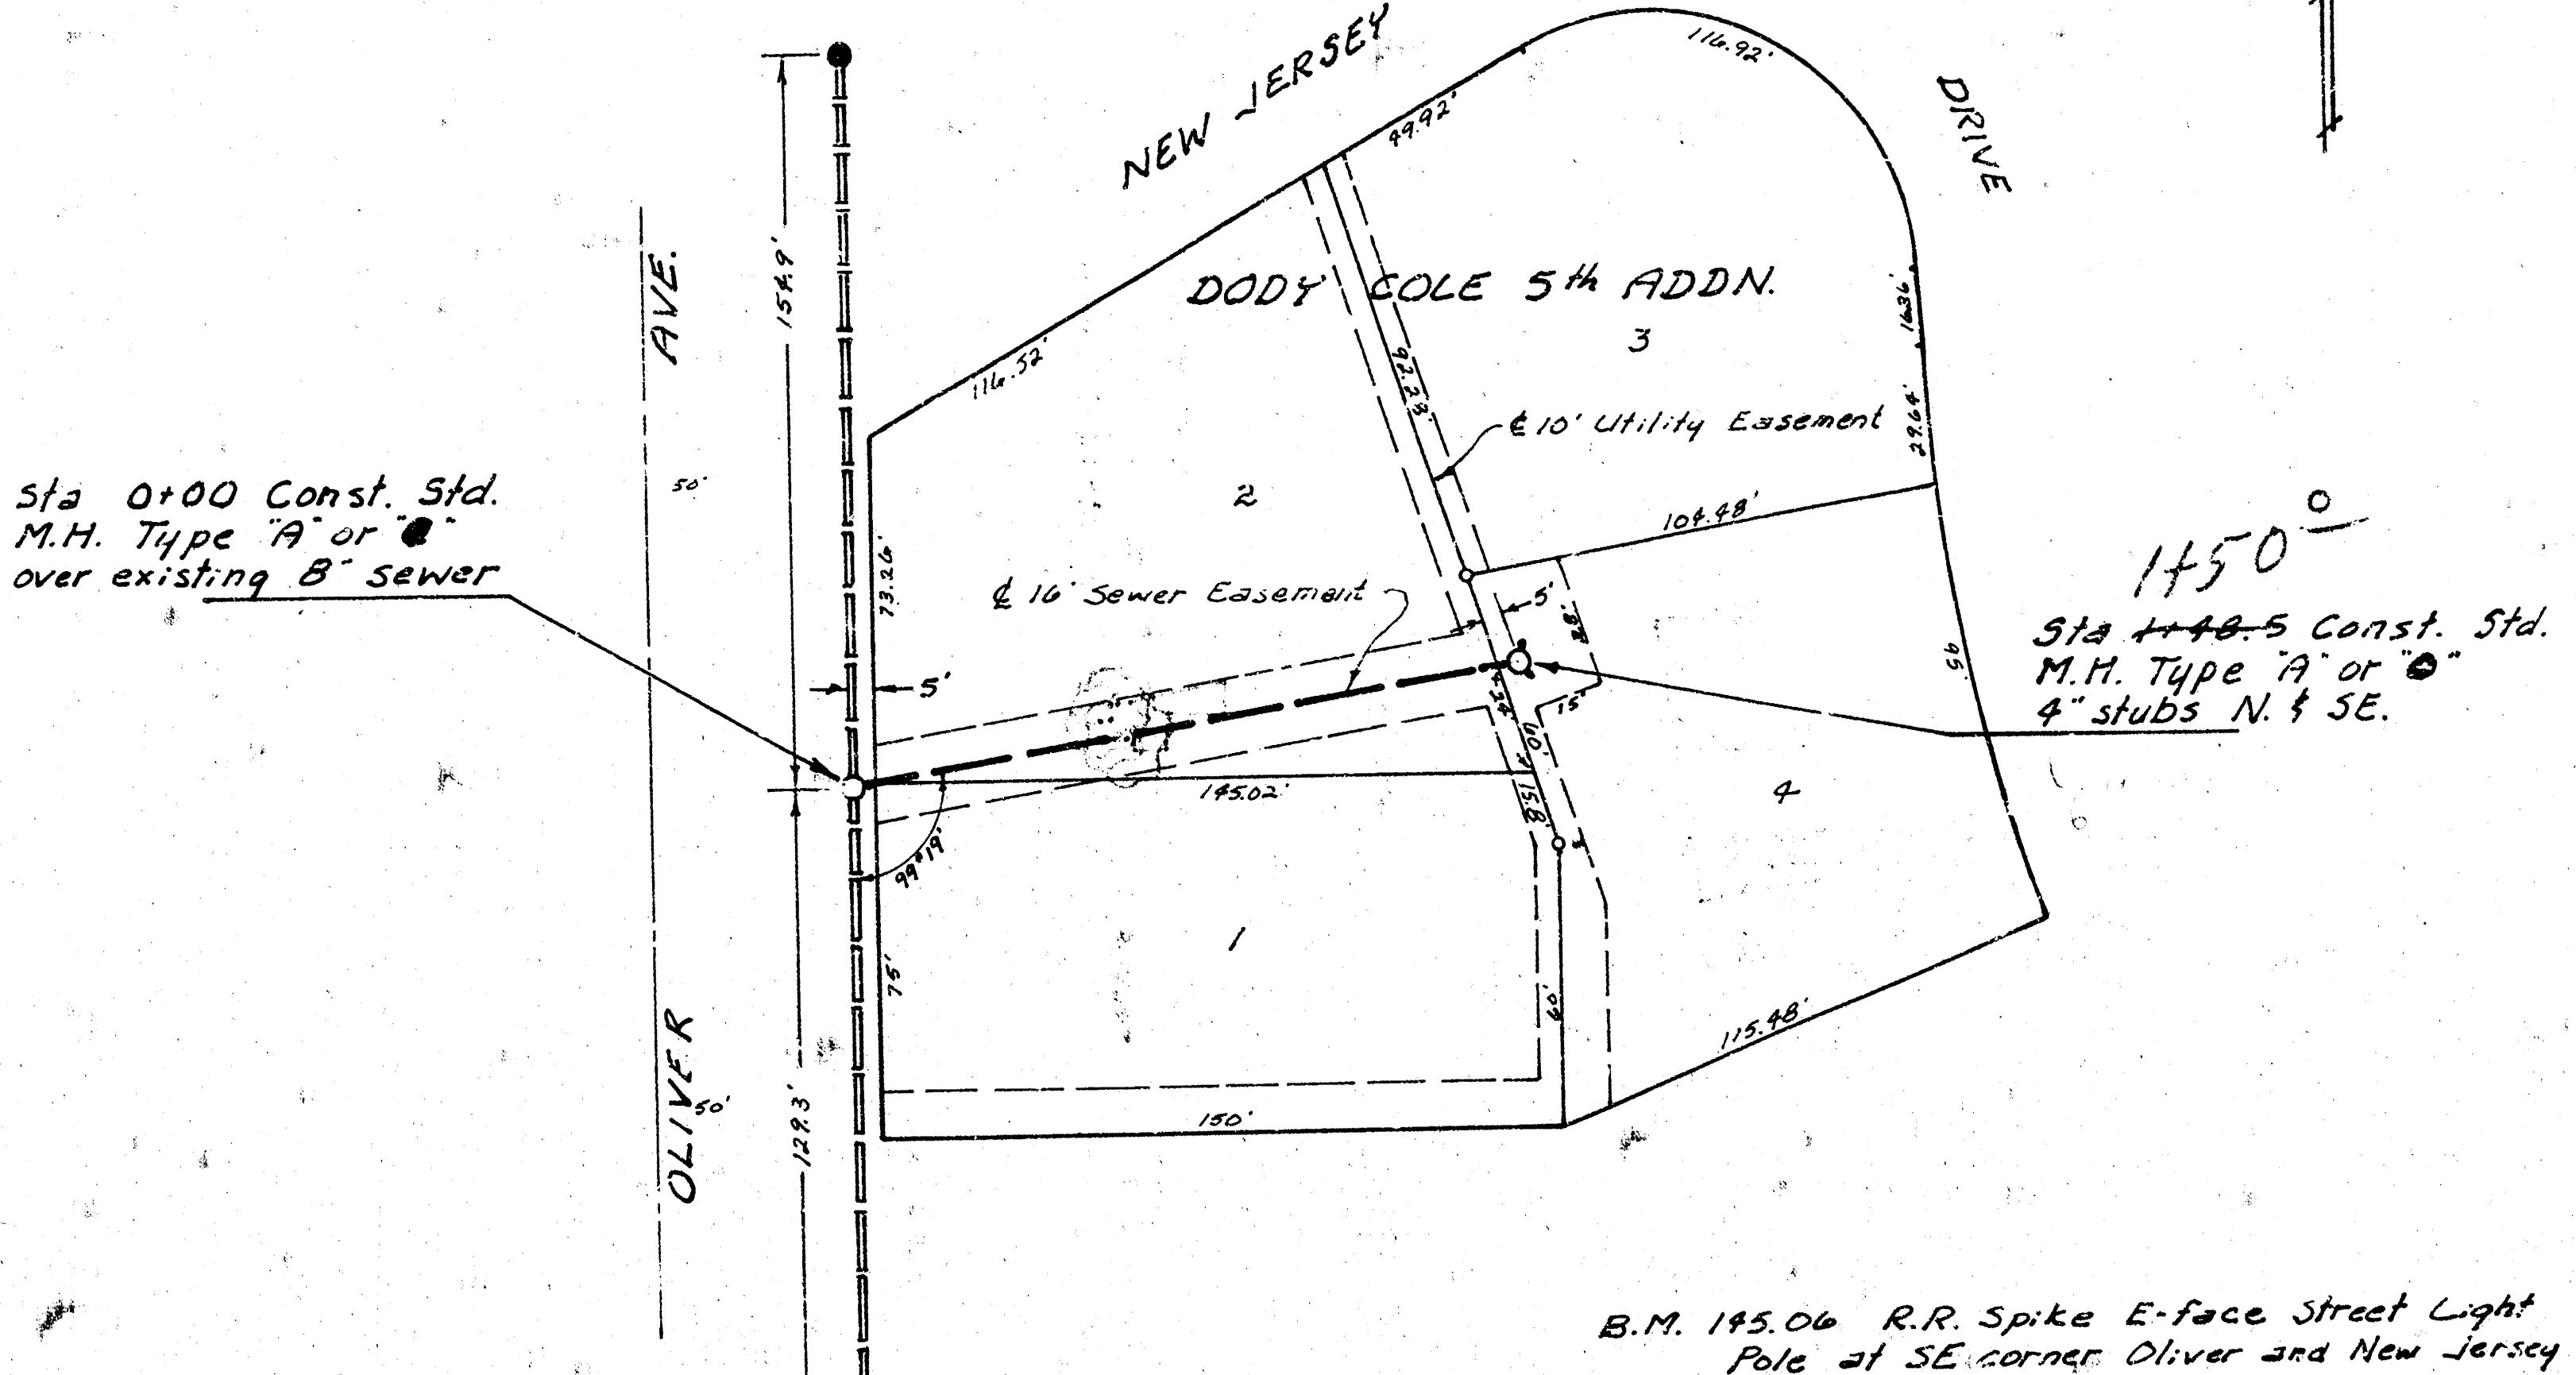

10-27-78 As built
LAT 16, MAIN 10, WAR INDUSTRIES SEWER
CITY OF WICHITA, KANSAS
R. W. LINN - CITY ENGINEER
DATE PROJ. NO. 468-76245-80514-000-000-001

