
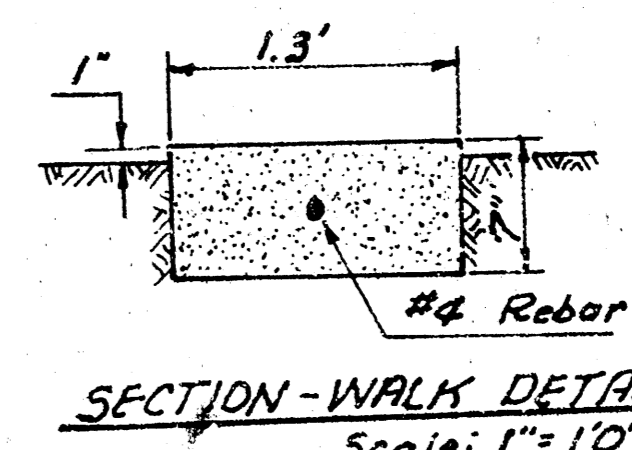


SCALE PLAN 1" = 20'
 PROFILE 1" = 20' HORIZ.
 1" = 5' VERT.

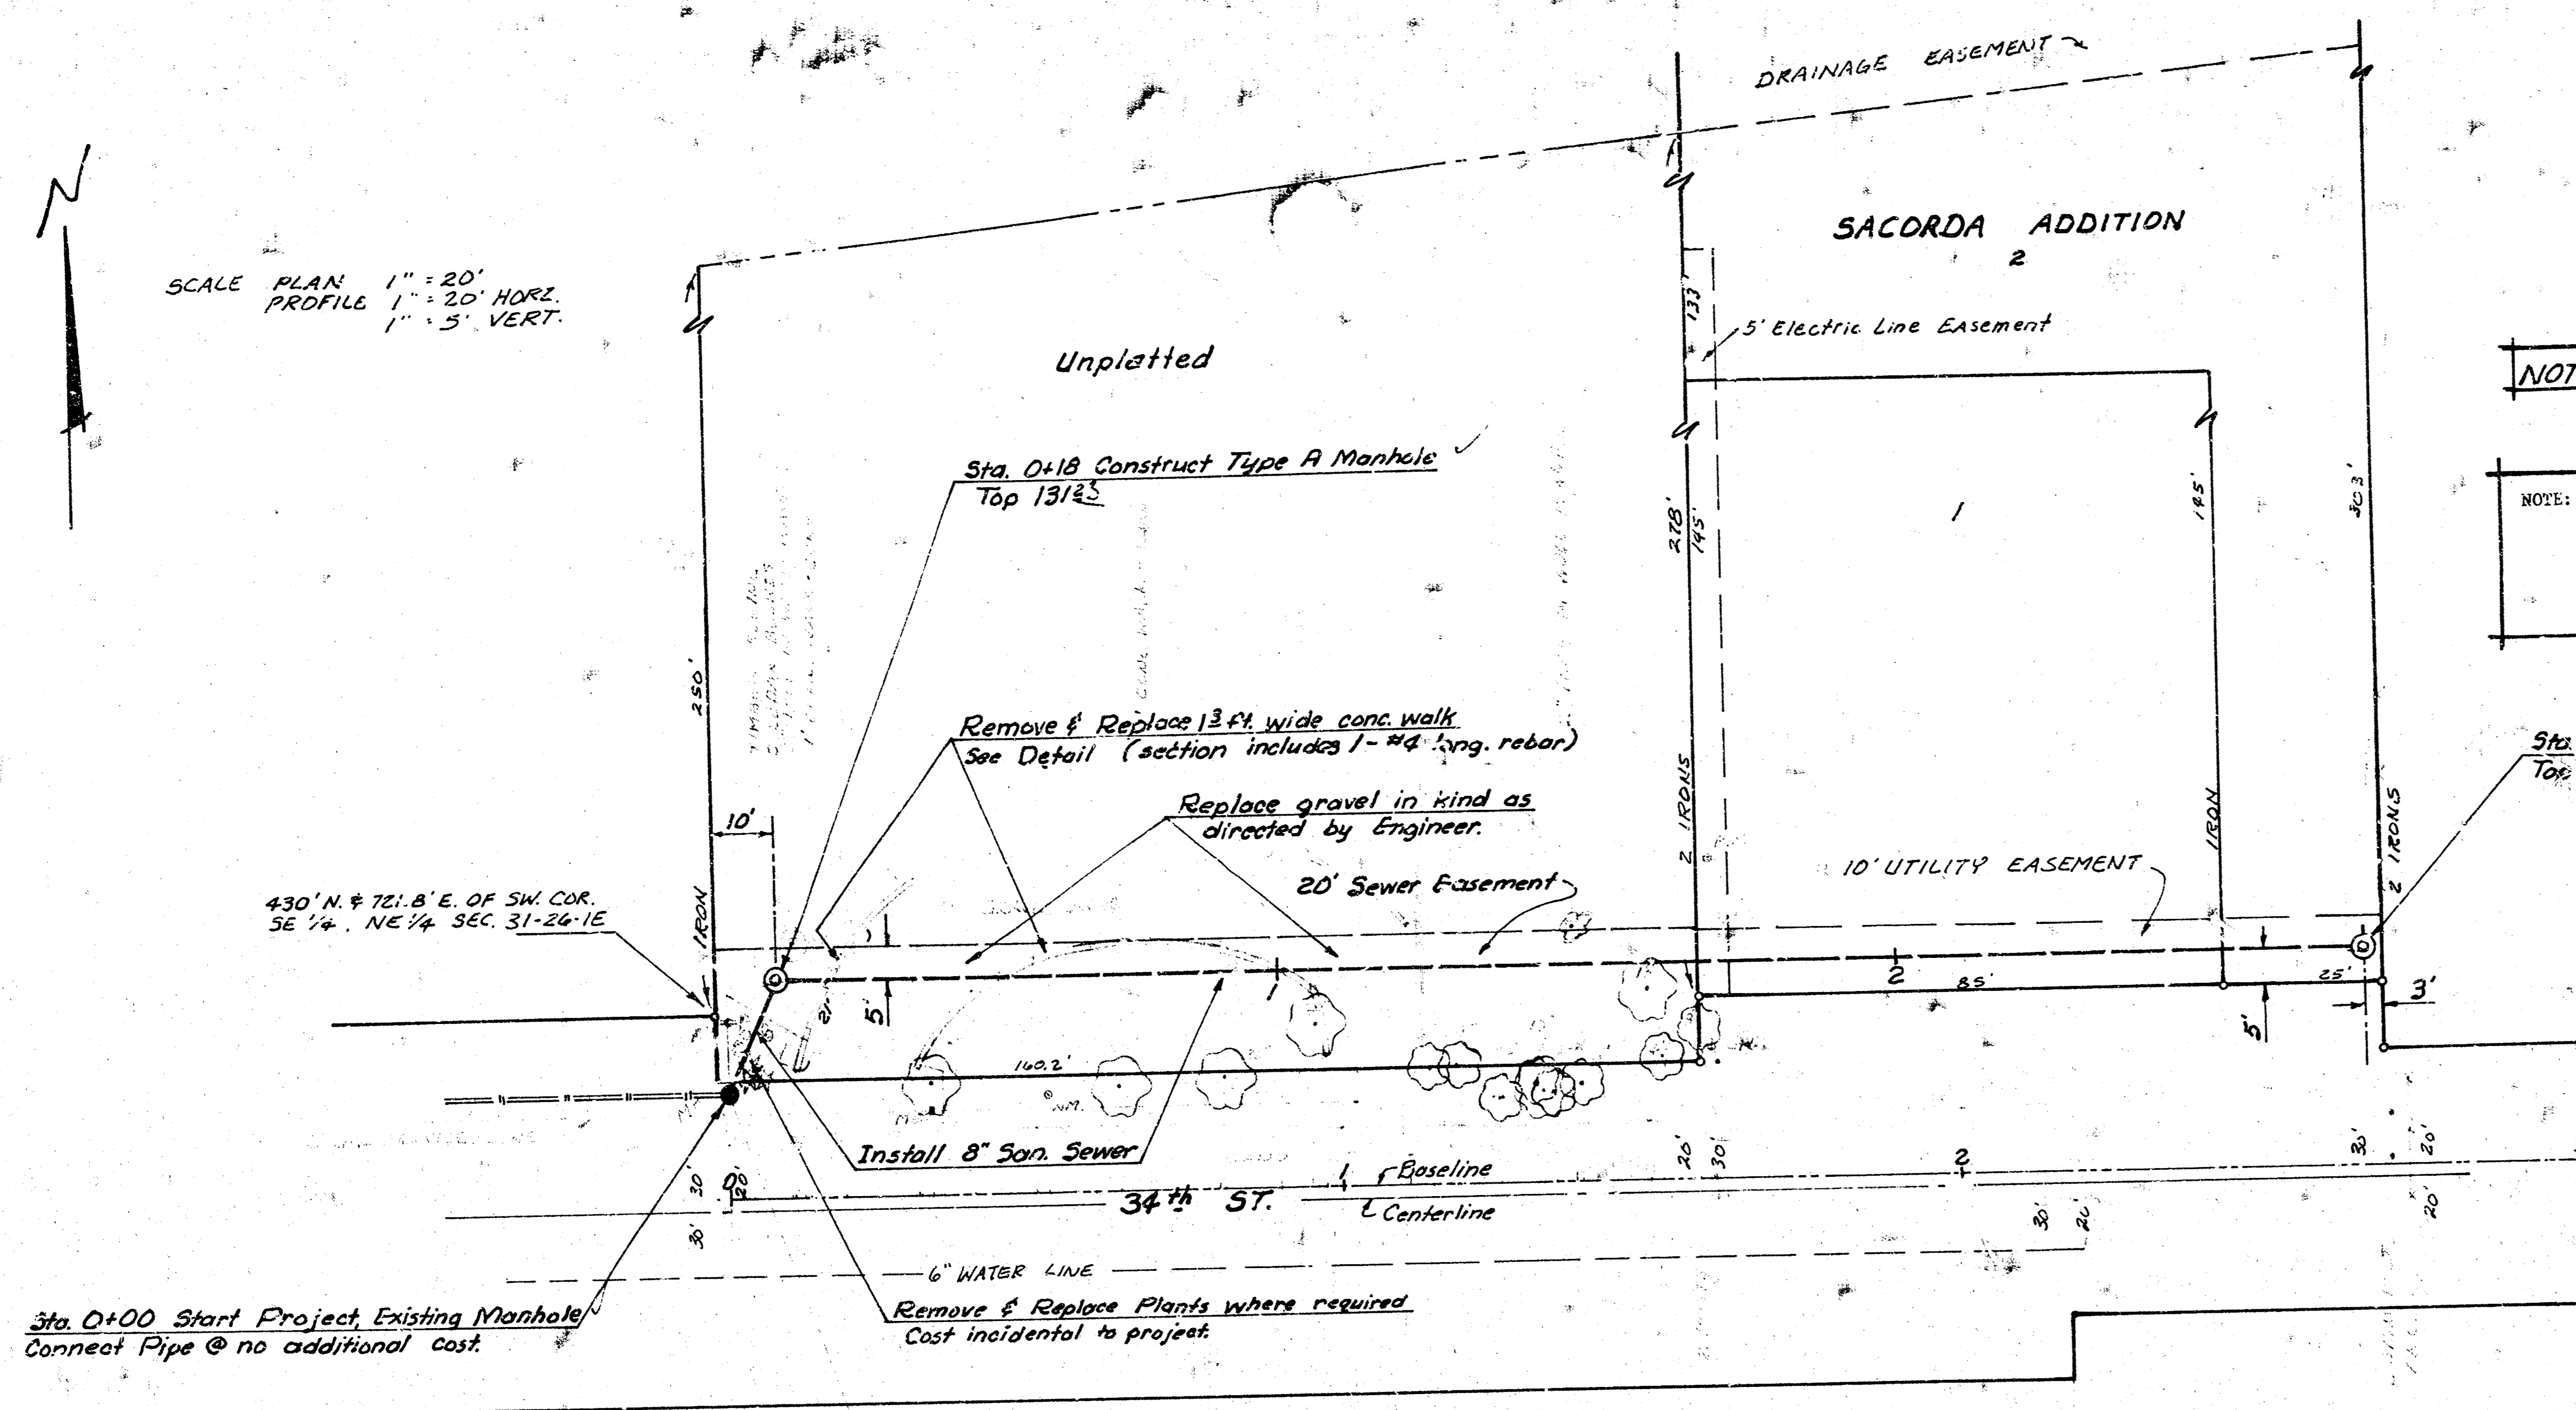


Remove 2' (3 Sections) of north walk. Replace with walk as shown in detail.

B.M. 13078 R.R. SPIKE IN N. SIDE OF H.L.P. 40 FT. N. OF E. 34th ST. NO. @ E. PL. HOUSE # 1240 W. 34th ST. NO.
 B.M. 131359 CITY STD. DISC. 42 FT. E. & 34 FT. N. OF E. BOTH AMIDON & 33rd ST. NO.


As Built
 J.M.
 10/85

Sta. 0+00 Start Project Existing Manhole Connect Pipe @ no additional cost.

Remove & Replace Plants where required Cost incidental to project.

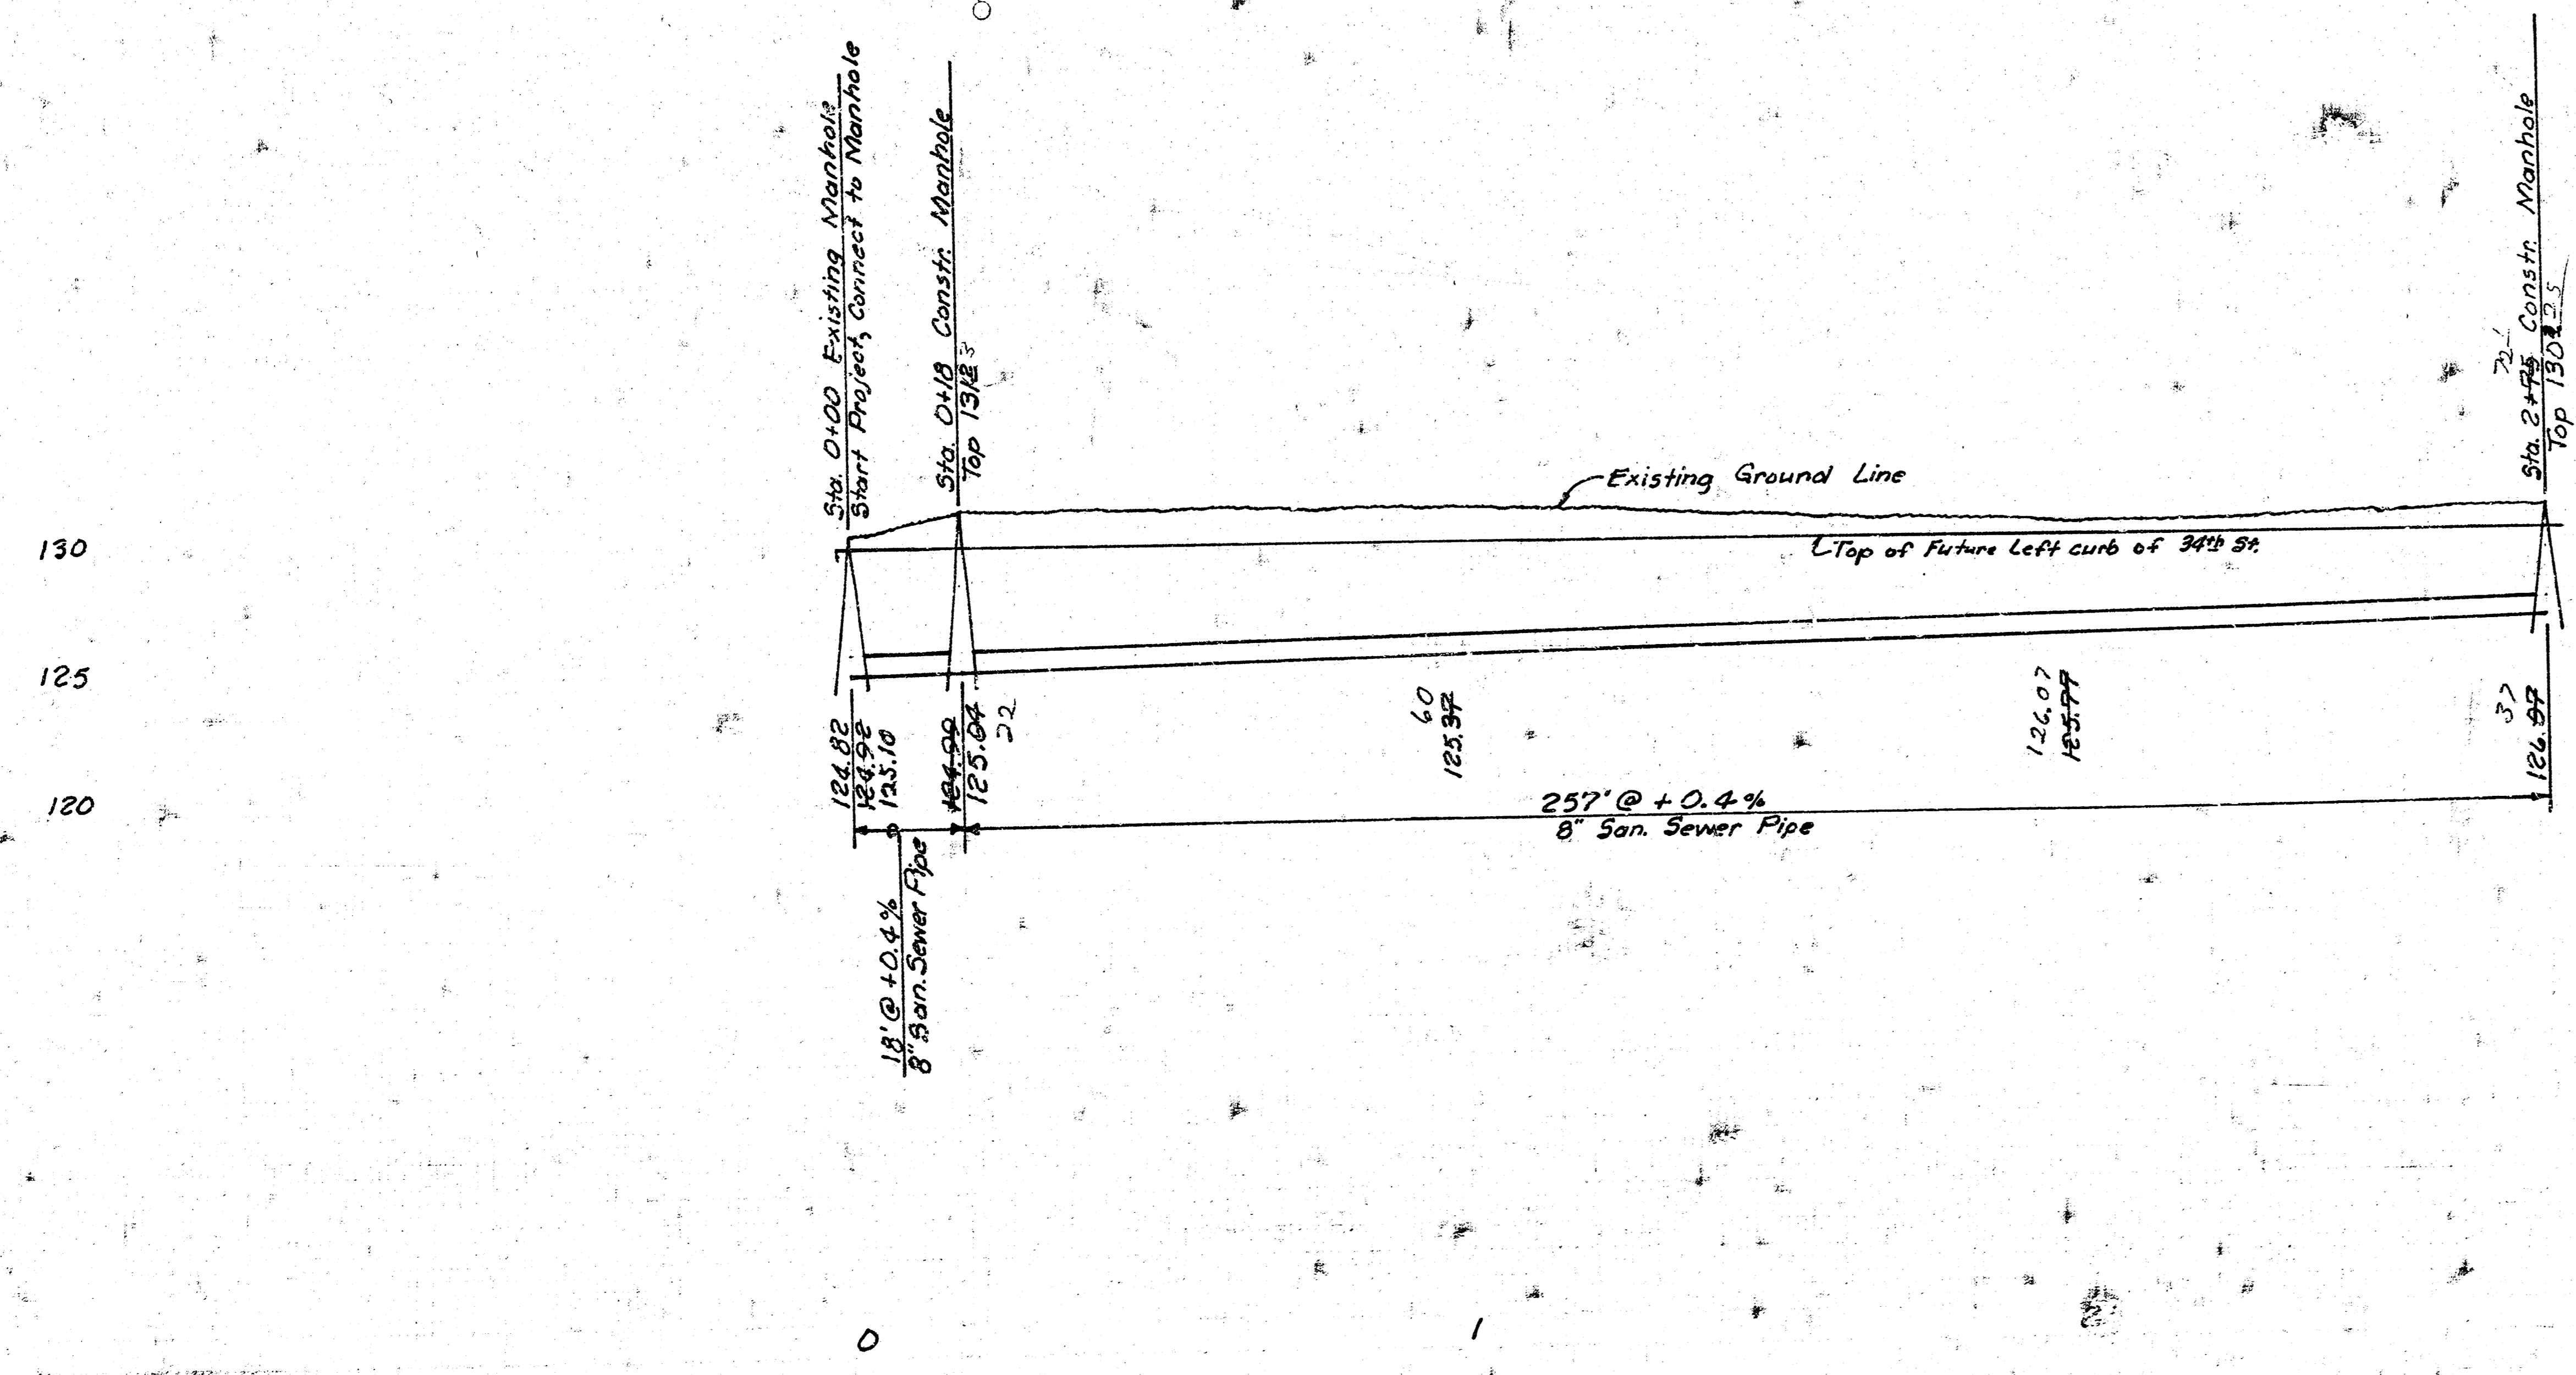

130
 125

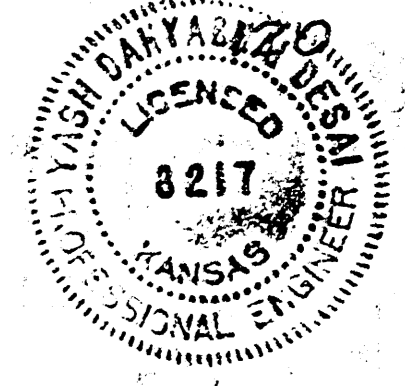

PROJECT DESCRIPTION	
LAT 70, MAIN 17, S. S. NO. 22	
PROJECT NUMBER	
468-76-245-81264-000-001	
BOOK NO. DWV-7	APPROVED BY
DRAWN BY 400415	DATE 5/83
CITY OF WICHITA	
DEPARTMENT OF ENGINEERING	
DIRECTOR OF ENG. CITY ENGINEER	SCALE
R. W. BRUGGEMAN	