



Survey by U.F.G. Book No. U.F.G. 109
 Plan by U.M. Date
 Checked by

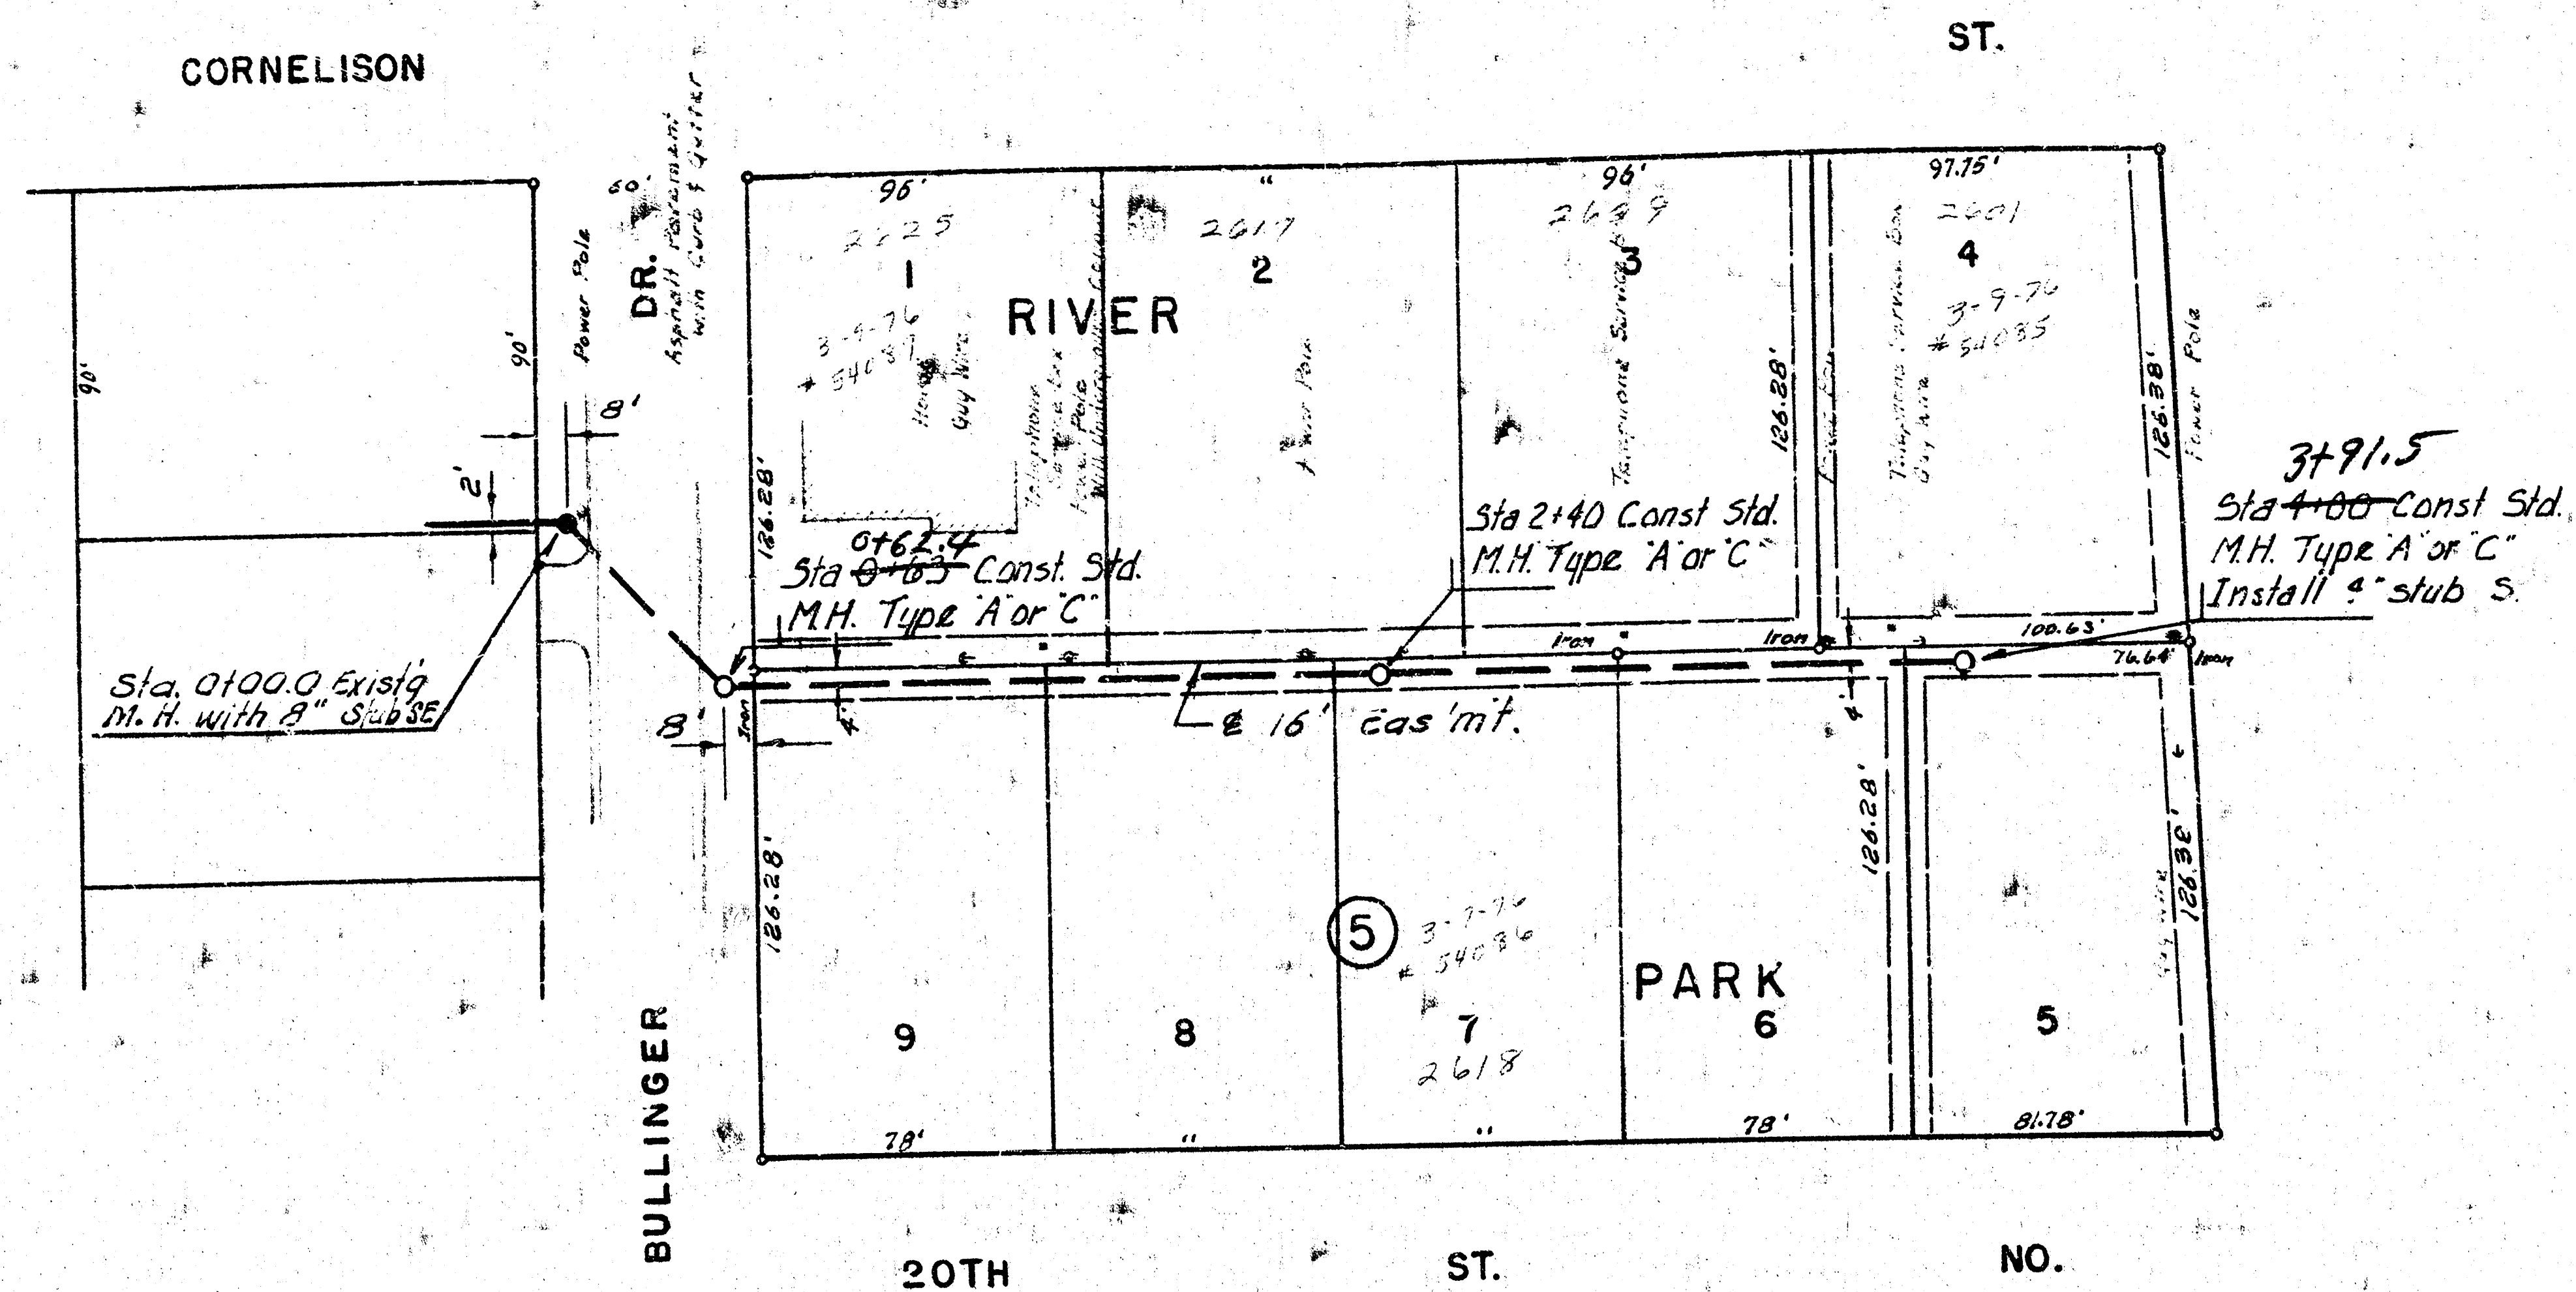

B.M. 12+20 "B" cut on top of South curb on River Park Dr. approximately 2' East of the W.L. Bullinger Dr.

NOTE: TOPS OF MANHOLES AT STA. 2+40 & STA. 4+00 TO BE SET TO MATCH FINISH GRADE. ELEVATION OF THE TOPS OF THESE MANHOLES SHALL BE DETERMINED BY THE FIELD ENGINEER.

Plan Scale 1" = 40'
 Profile Scale 1" = 4' Horiz.
 1" = 4' Vert.

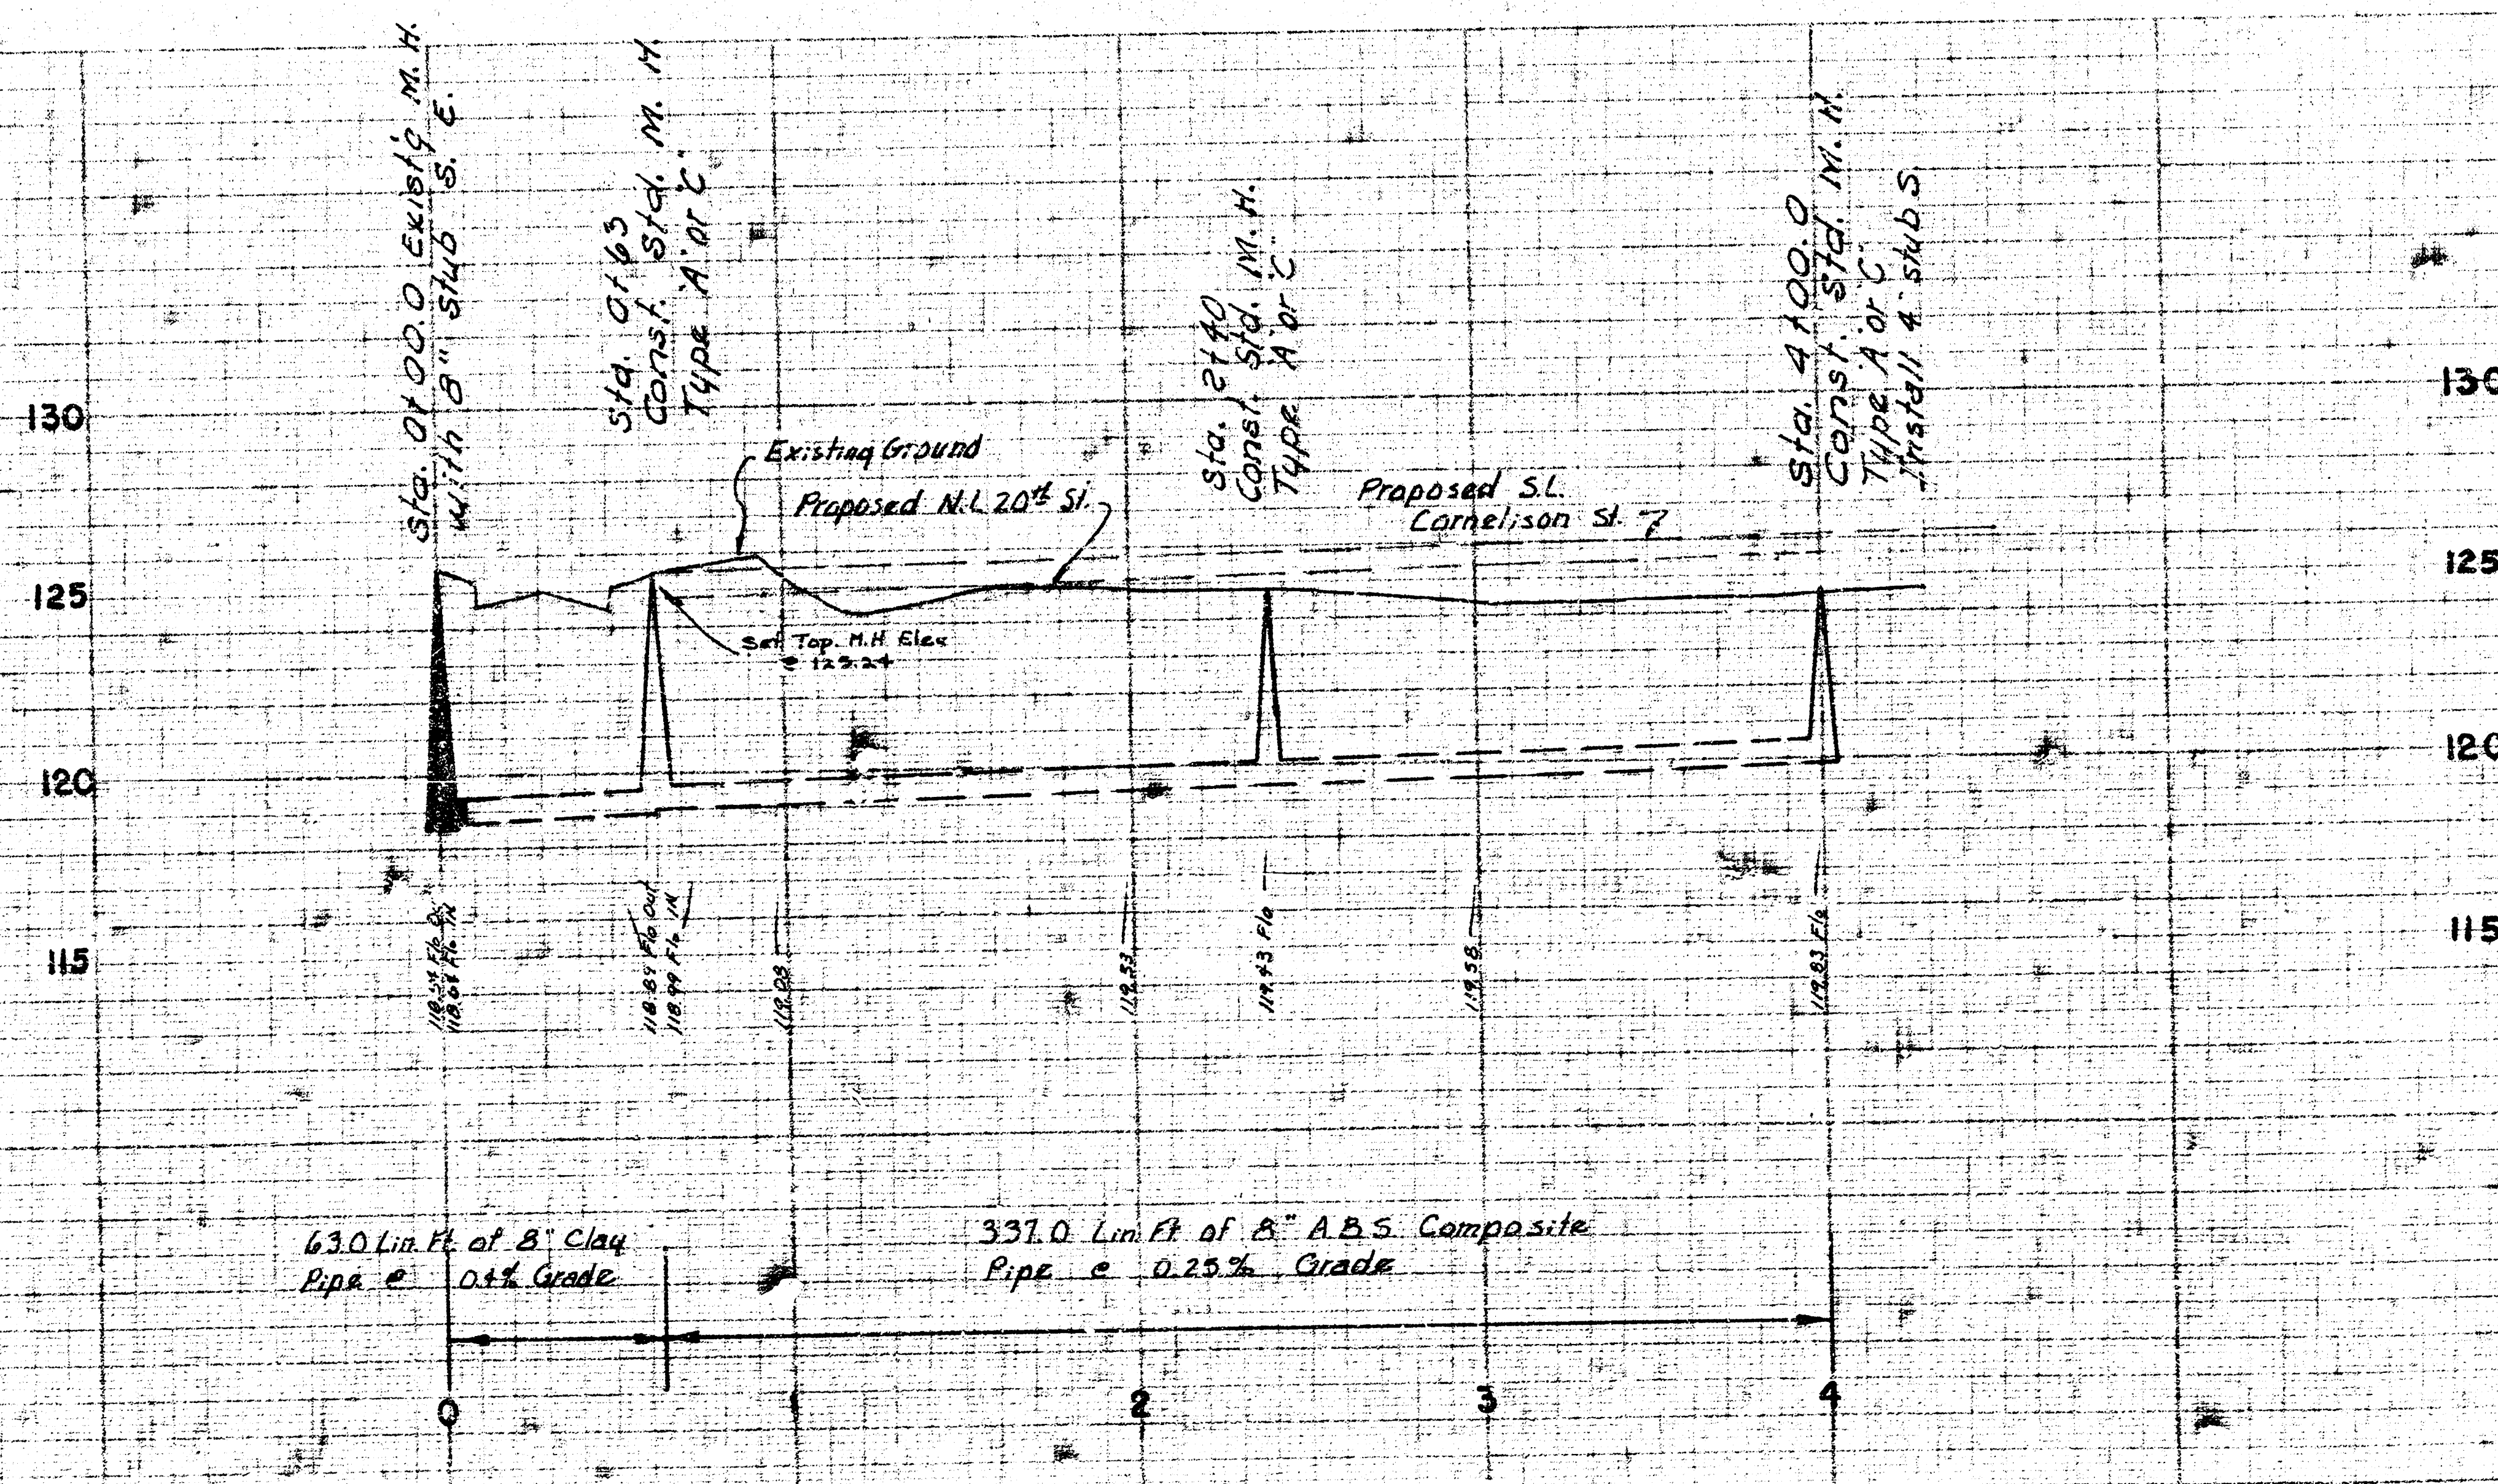

As Built 4-12-76

LAT. 5, SUBMAIN 19, S. S. NO. 22

CITY OF WICHITA, KANSAS

R. W. LINN — CITY ENGINEER

DATE Feb. 1976 PROJ NO DBKL564015