


Survey G. J. King, Bk. 230-4
 Plan D. Cranner, 9/14/12
 Exc. 5/19/13
 Checked 4/27

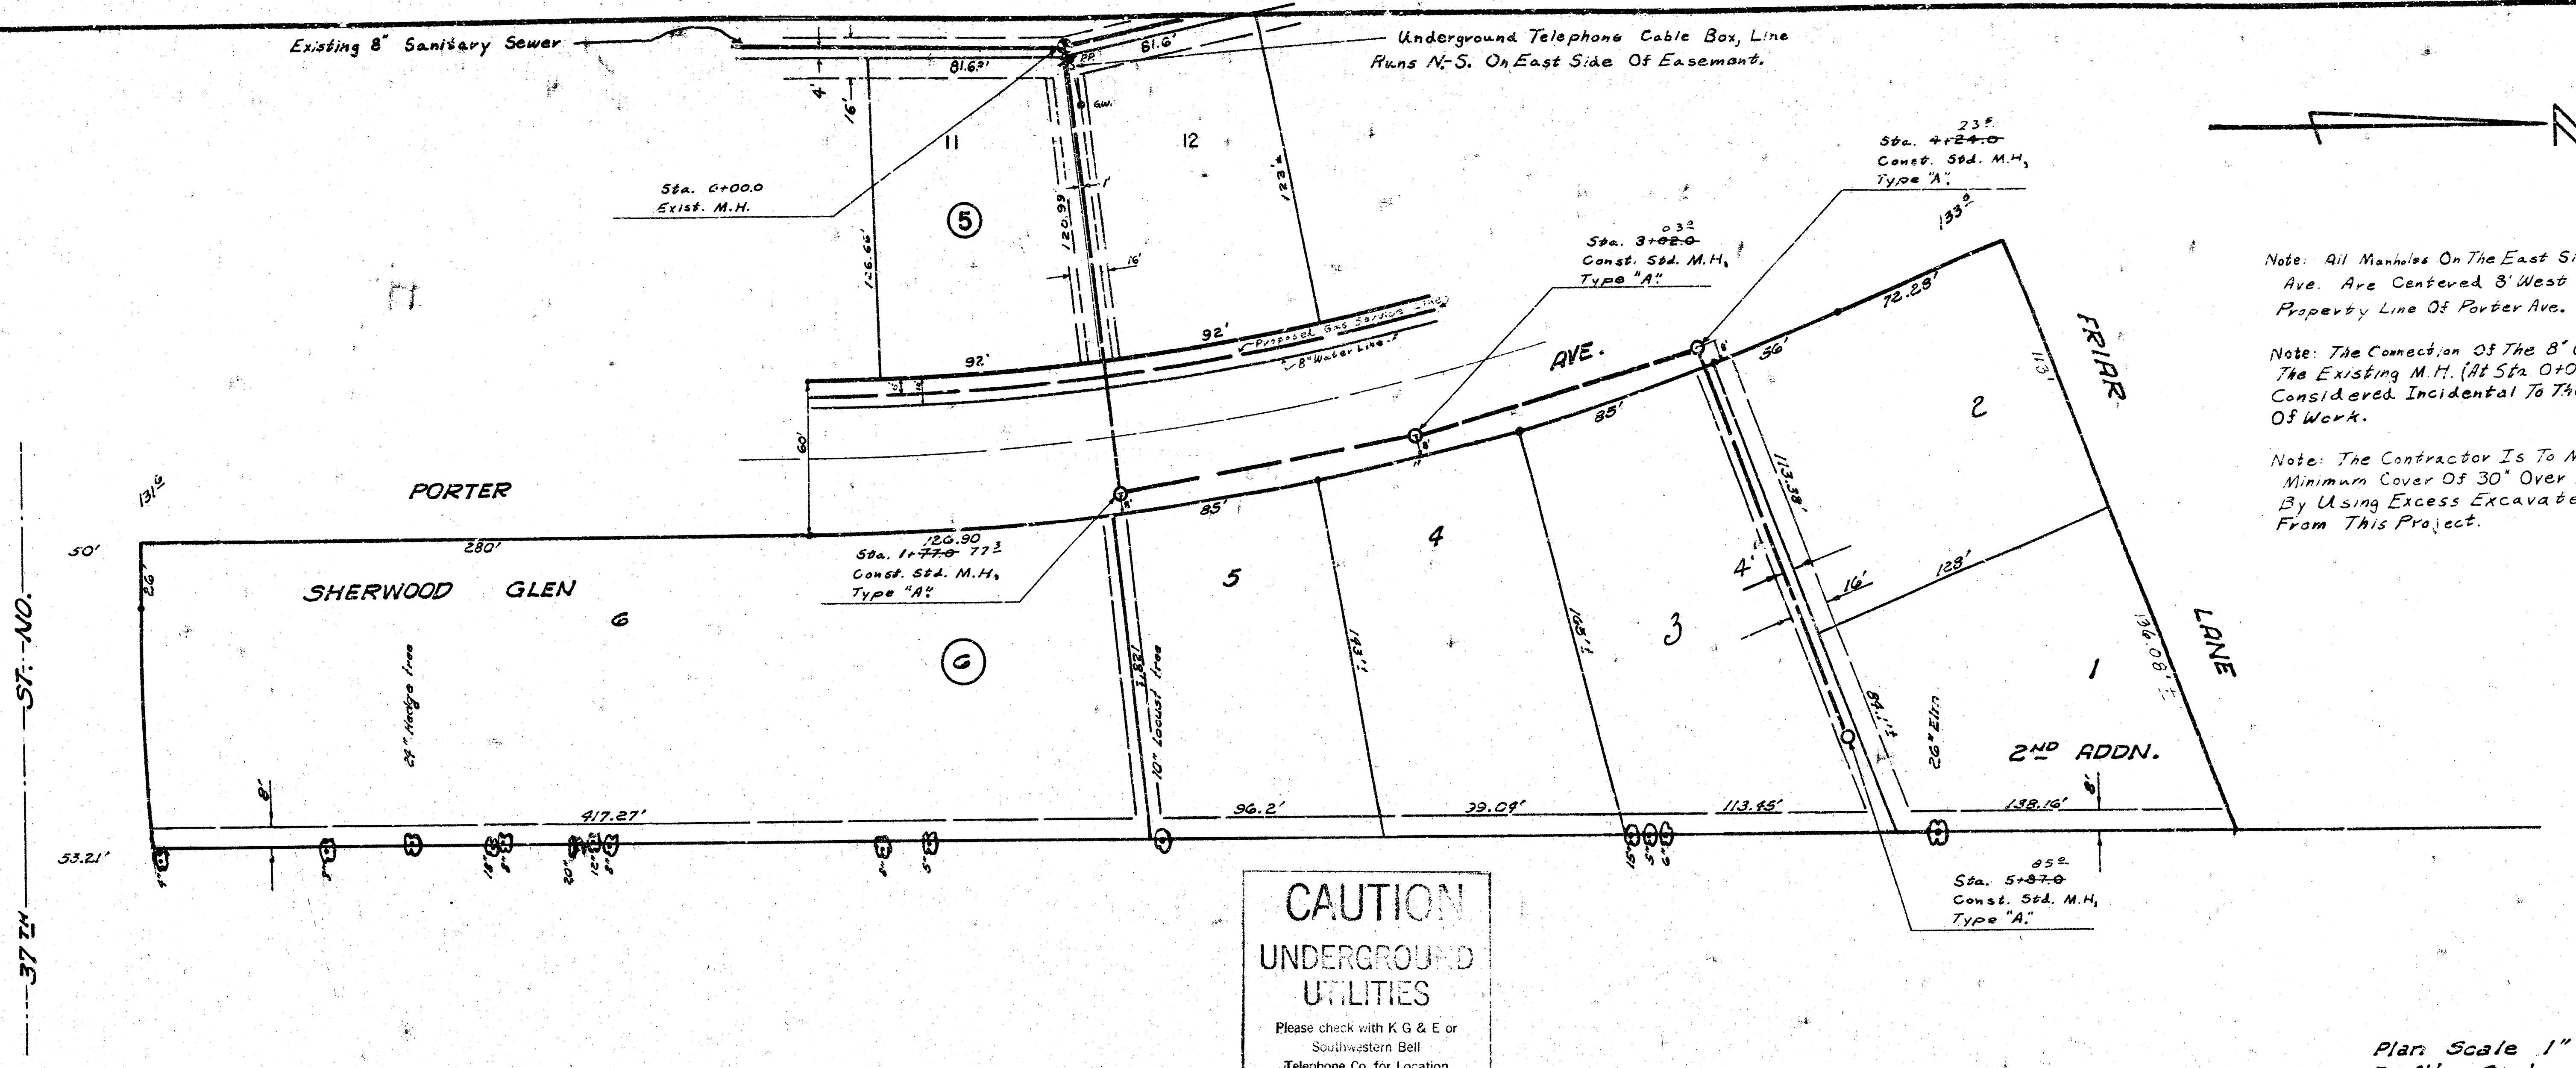



Note: All Manholes On The East Side Of Porter Ave. Are Centered 8' West Of The East Property Line Of Porter Ave.

Note: The Connection Of The 8" Clay Pipe To The Existing M.H. (At Sta. 0+00.0) Is To Be Considered Incidental To The Other Items Of Work.

Note: The Contractor Is To Maintain A Minimum Cover Of 30" Over The Sewer, By Using Excess Excavated Material From This Project.

Plan Scale 1"=40'
 Profile Scale 1"=40' Hor.
 1"=4' Vert.

B.M. 134.63 R.R. Spike N.S.P.P. S.S. 37th - 1/2 Mi. E. of Meridian

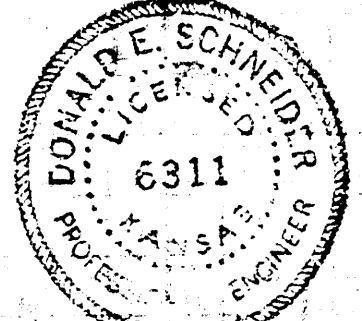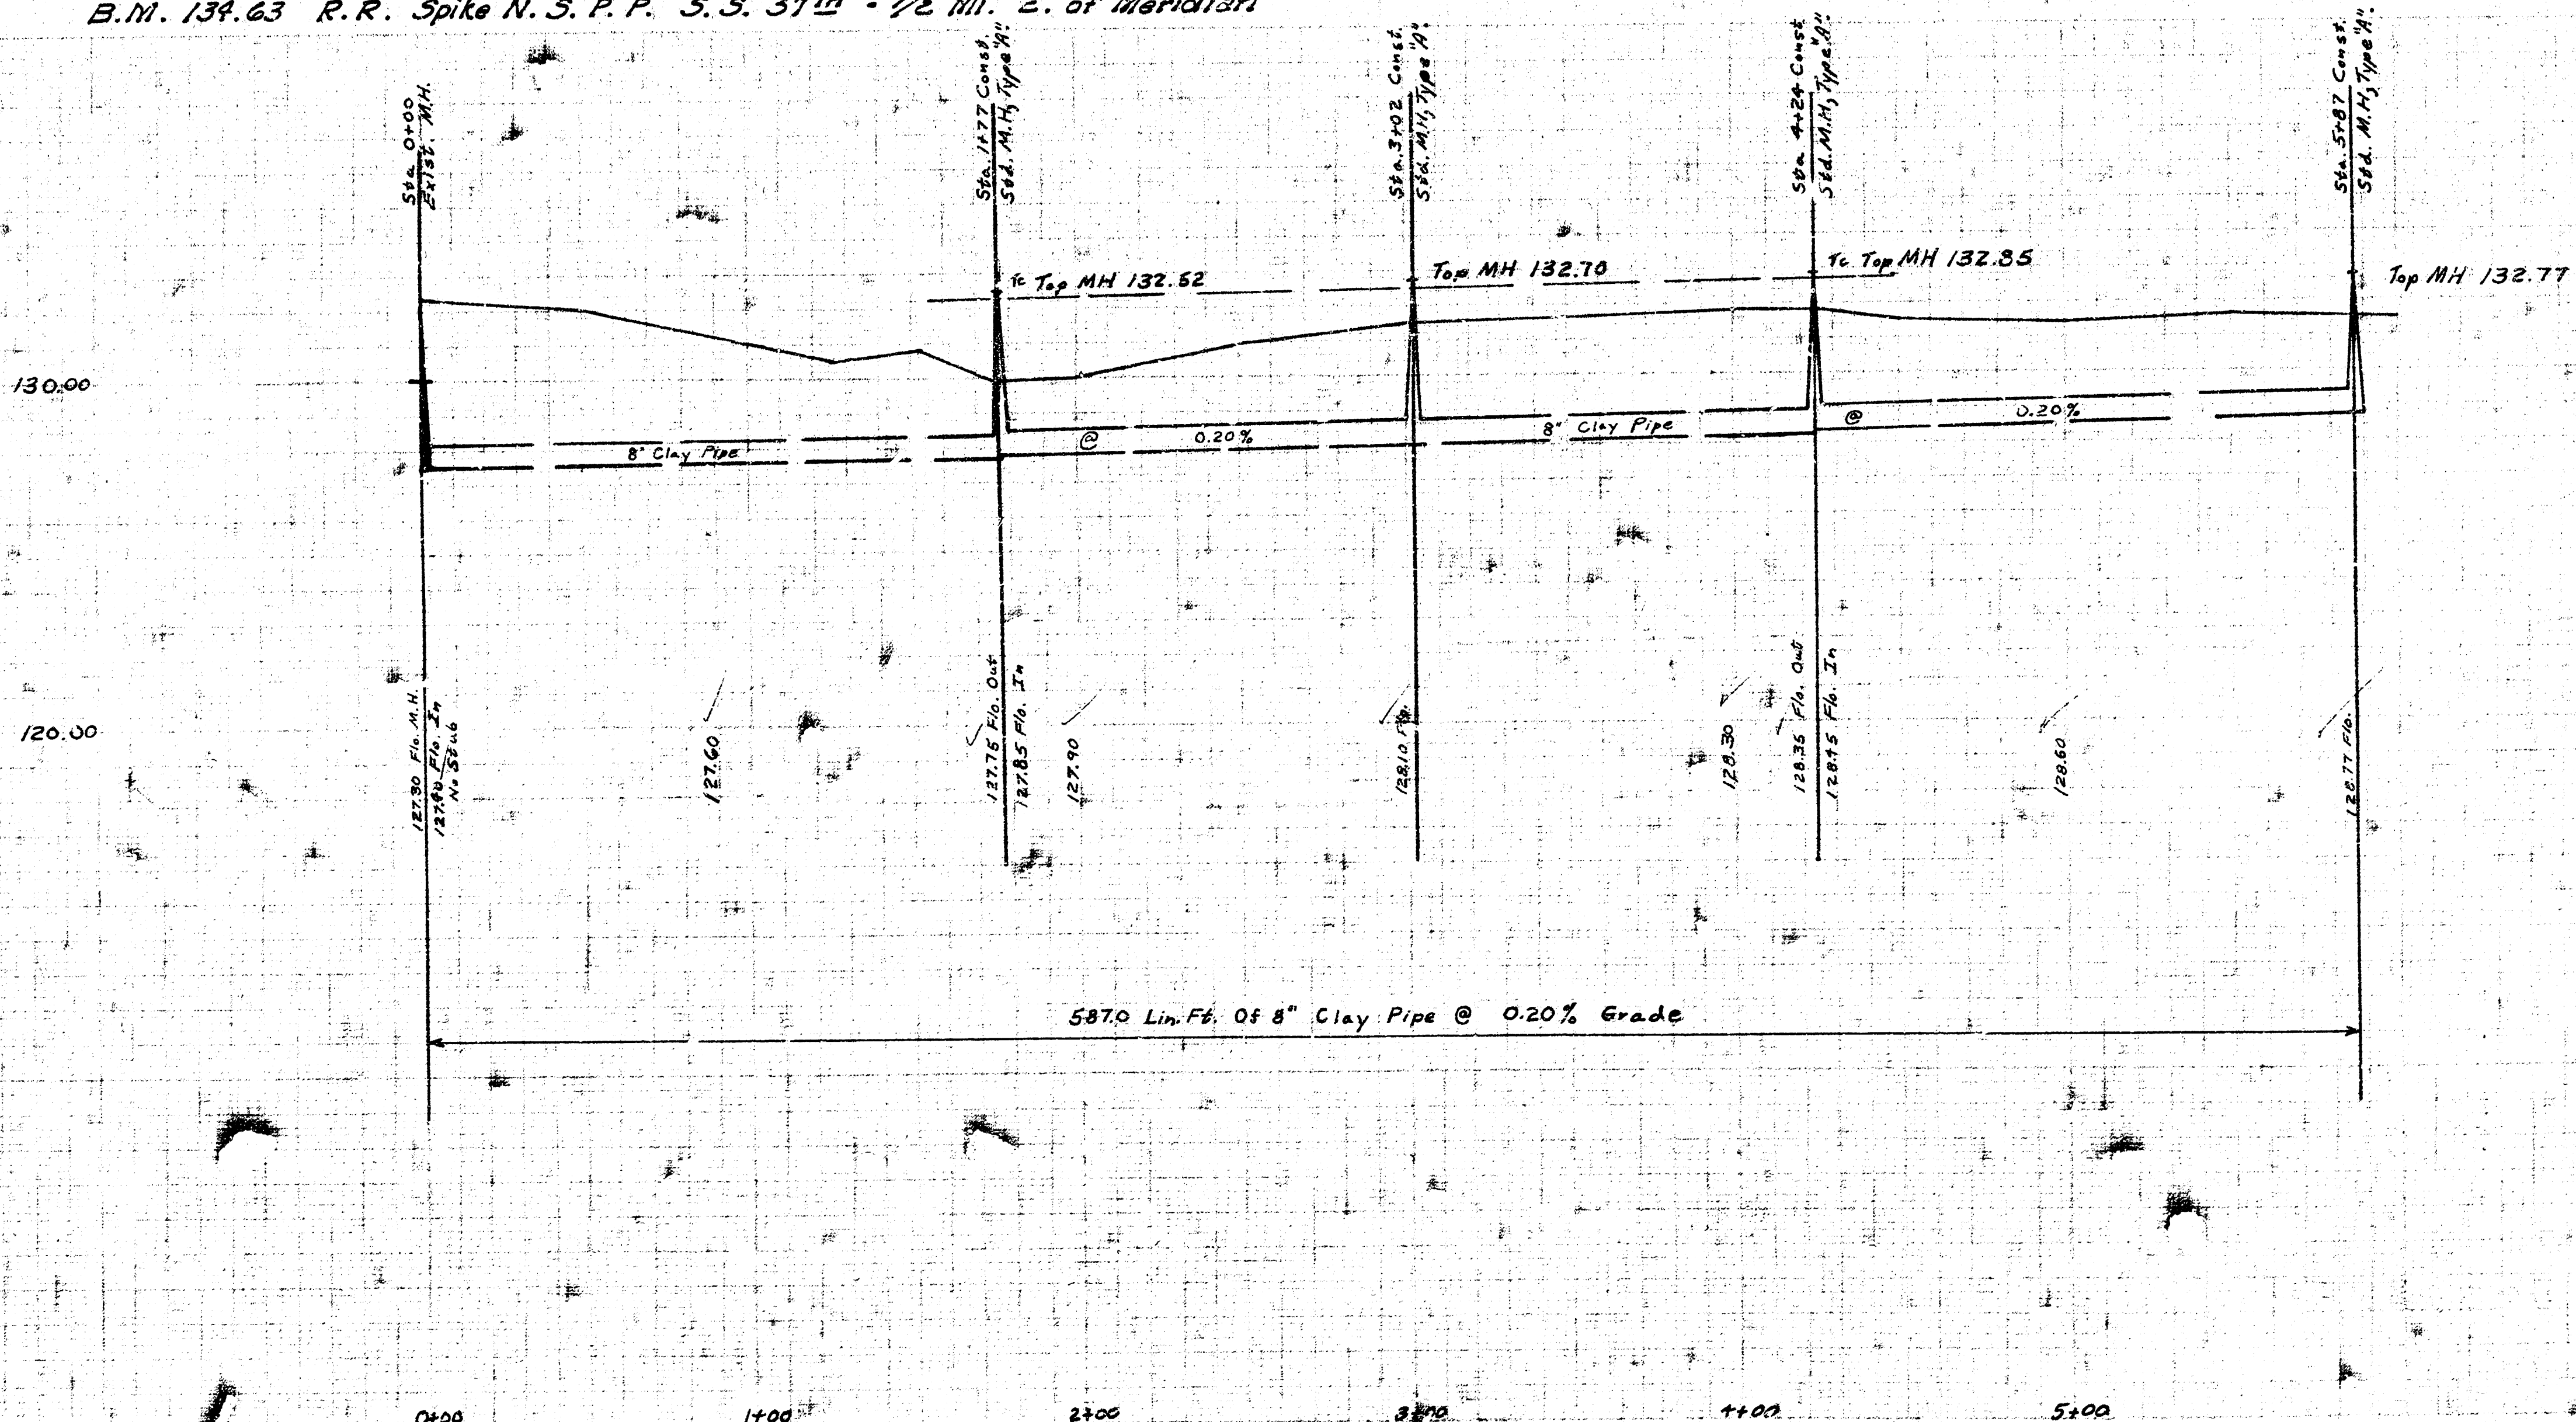

LATERAL 6, SUB. 21, S.S. NO. 22
 CITY OF WICHITA, KANSAS
 R.W. LINN, CITY ENGINEER
 PROJ. NO. DBKL565026
 June 1913

As Built Final Record K-111