


Survey
Plan
Ex.
Check

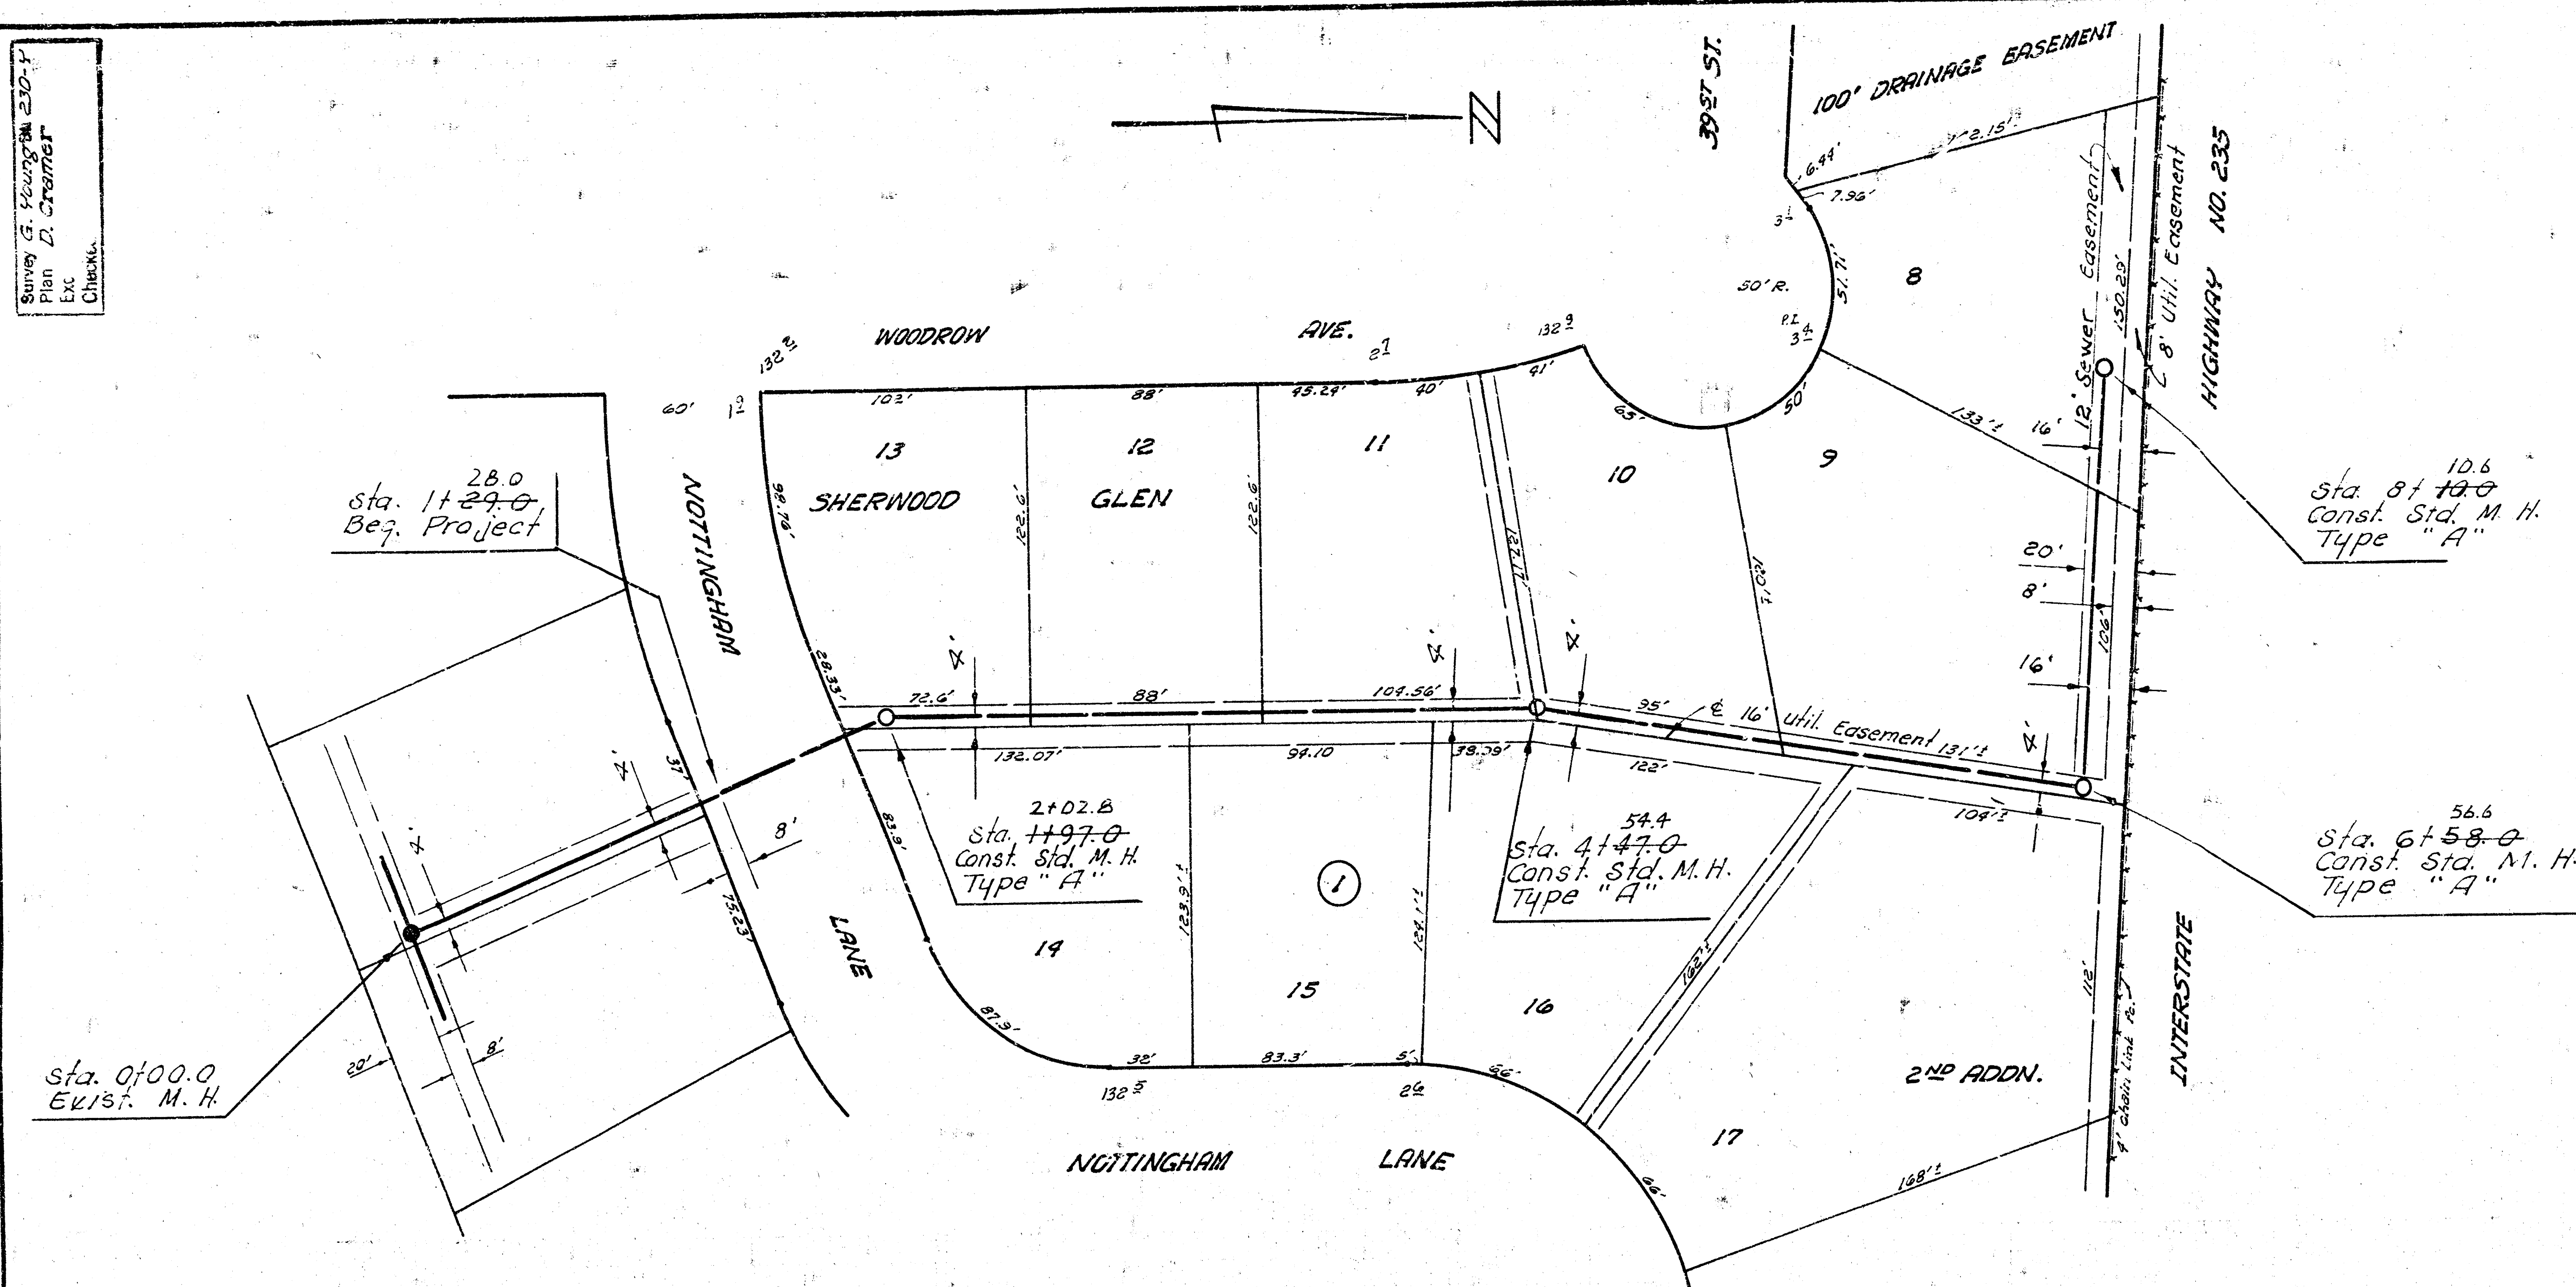


B. N. 135.03 60' Spike E. S. R. R.
W. S. Amidon @ S. L. 39th St. No. east.


B. M. 135.33 SE. cor. Step No. #
3841 Friar Lane.

B. M. 131.95 N. Rim M. H. in
Woodrow Ave North Side
of 37th St. North.

NOTE:
Contractor to construct fill over
sewer as required to maintain a
minimum of 30 inches of cover.
All work necessary to provide a
minimum of 30 inches of cover
shall be considered as subsidiary.

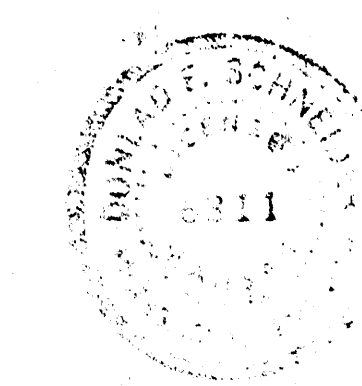

Plan Scale 1"=40'
Profile Scale 1"=4' Hor.
1"=4' Vert.

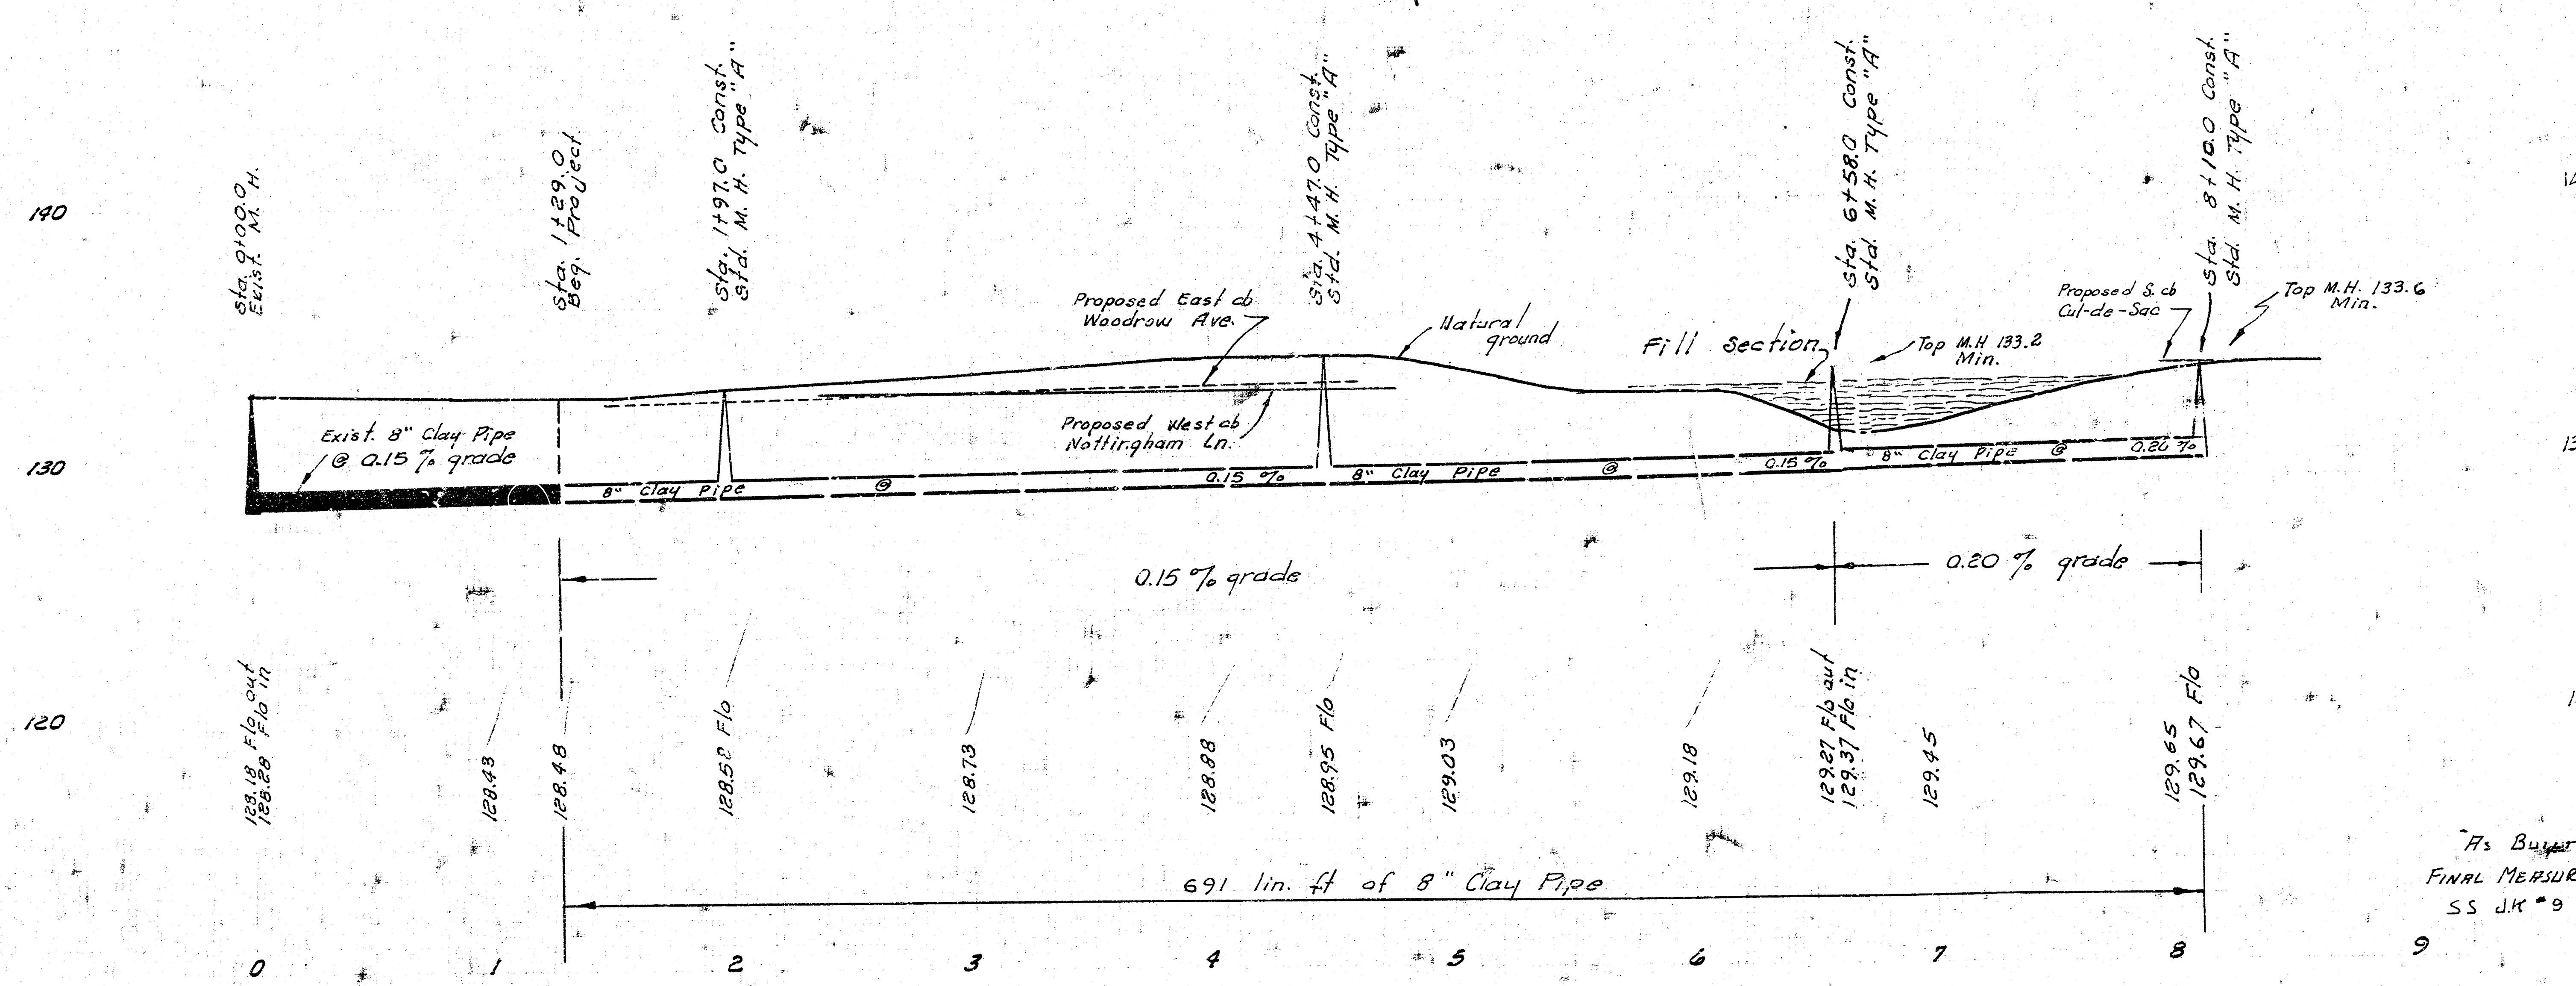

As Built
FINAL MEASUREMENTS
SS dk #9

LATERAL 23, MAIN 21, S.S. NO. 22
CITY OF WICHITA, KANSAS
B.E. SMITH, CITY ENGINEER
PROJ. NO. DBKLS71015
DATE: NOV. 1972