
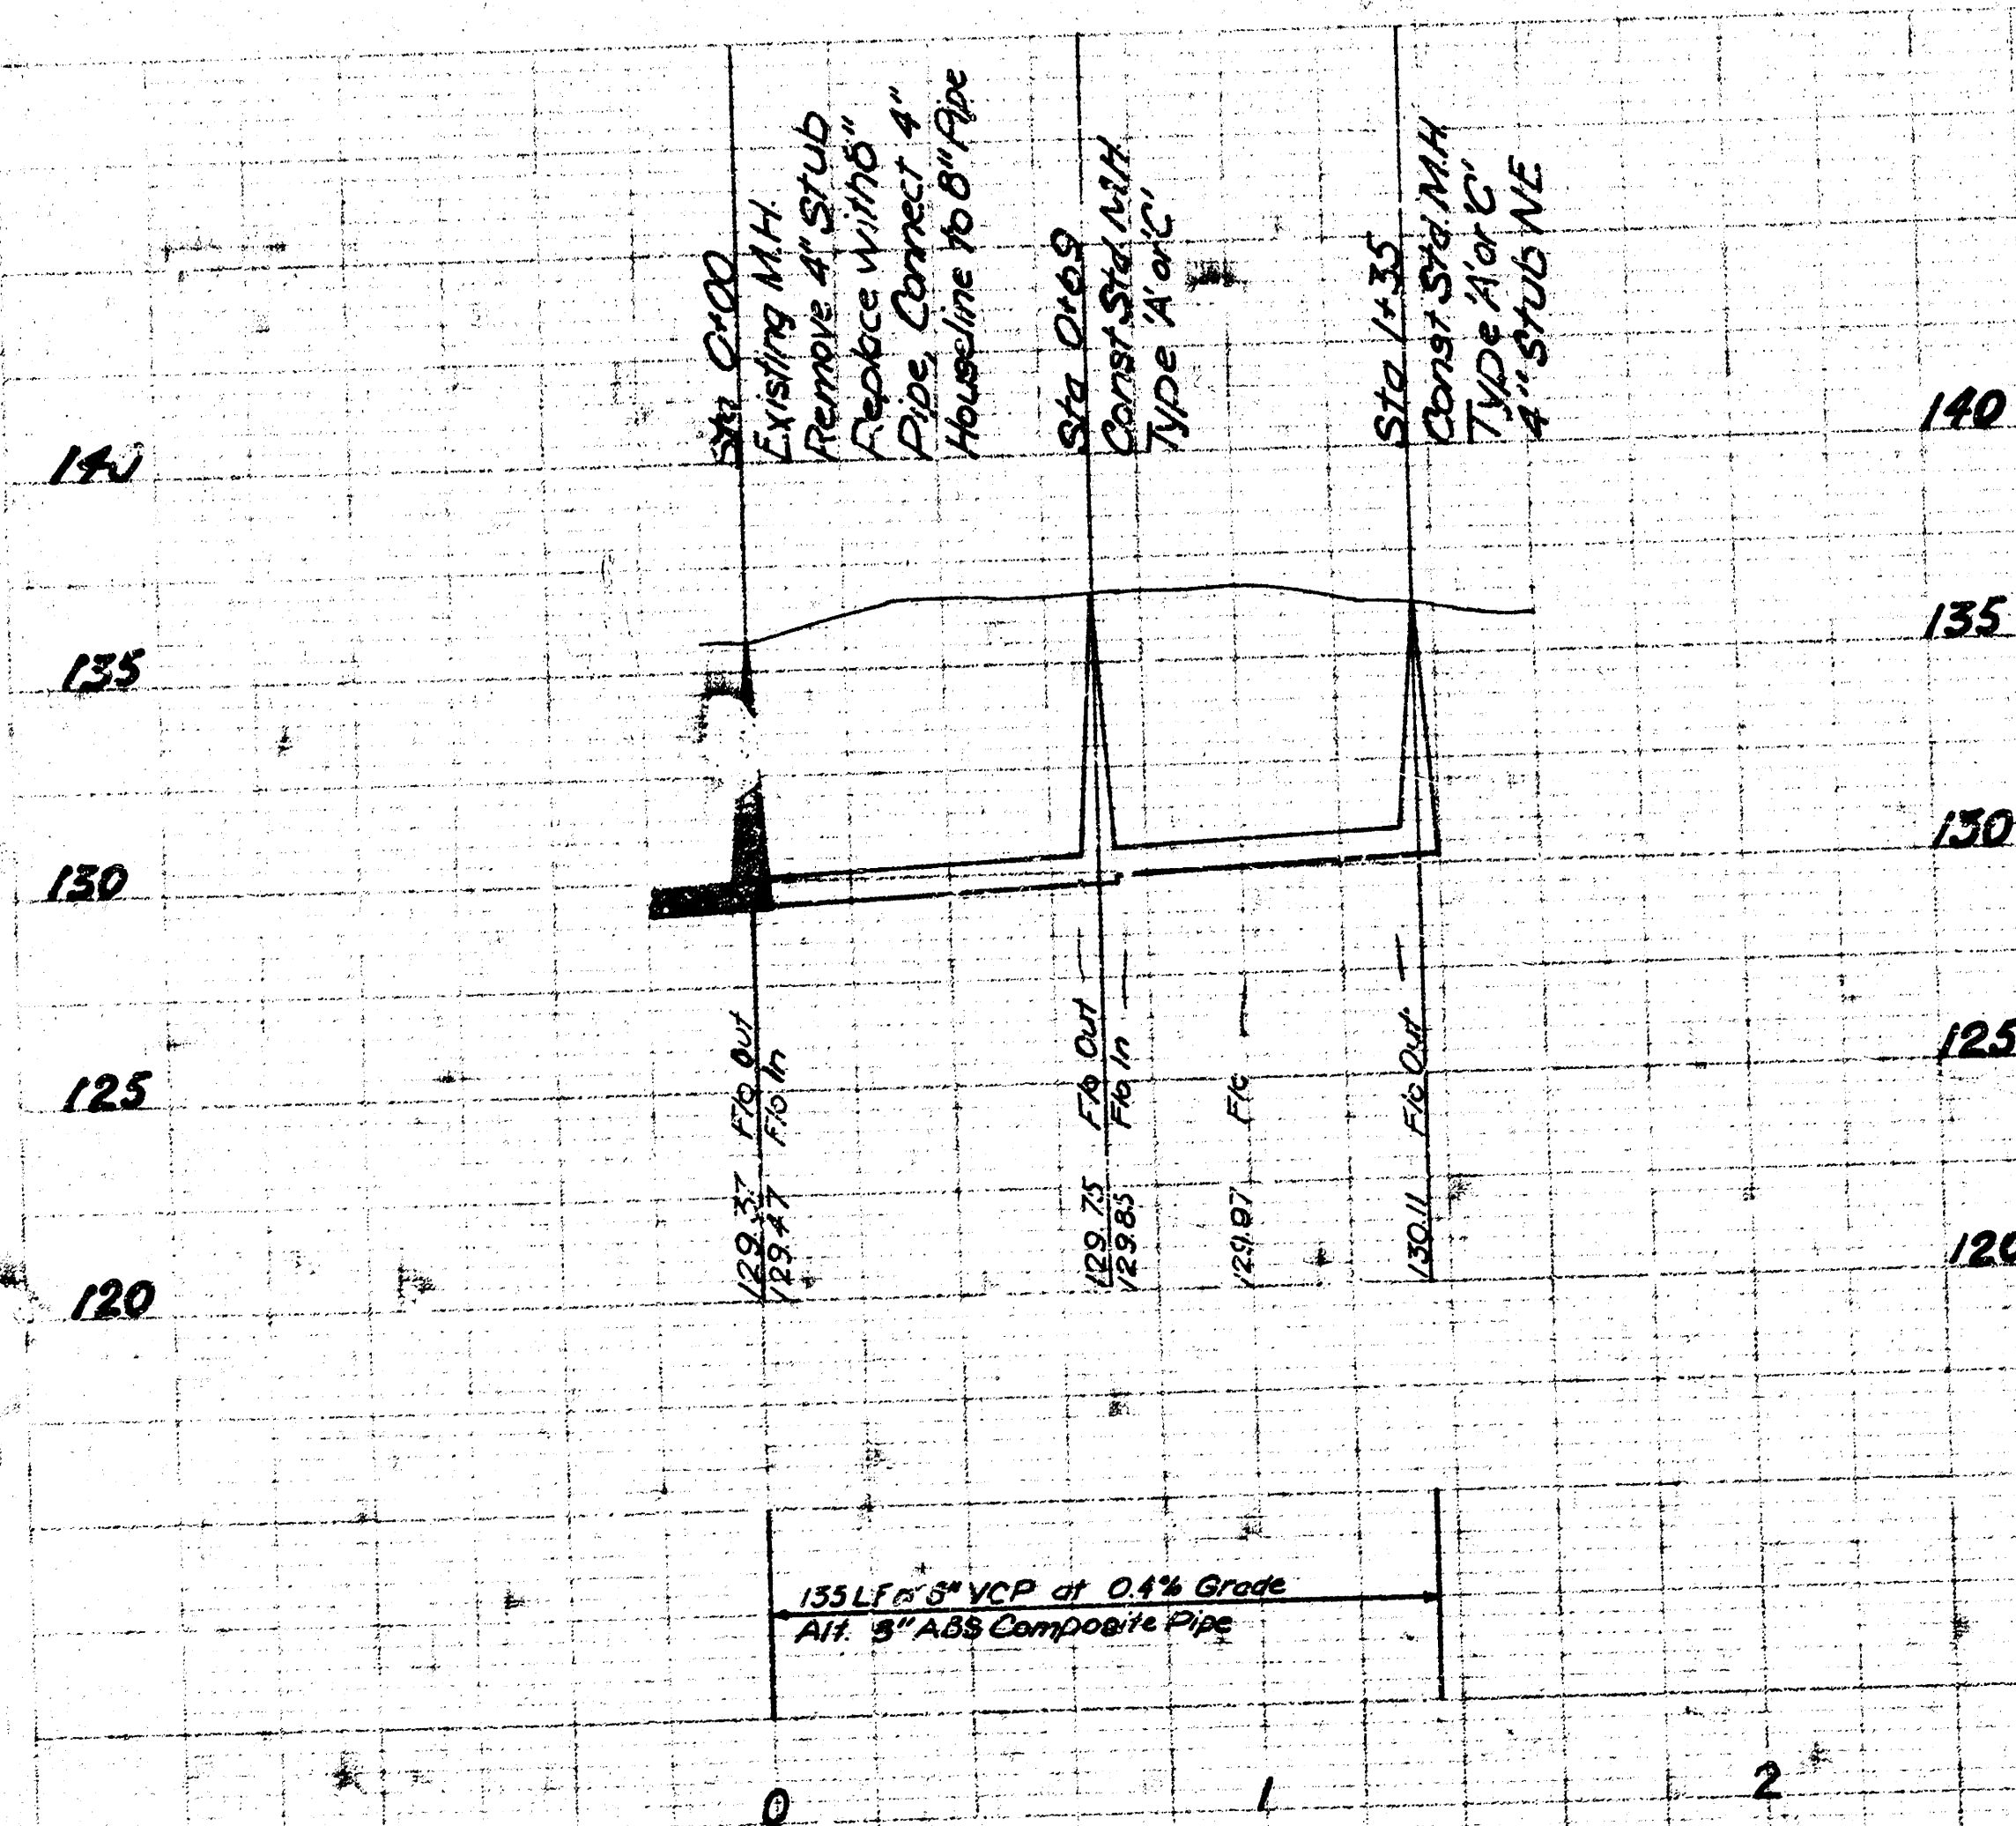


BM 133.39 City Std. Disc 35' East & 52' South of C. of Amidon & 37th St. North
 BM 135.05 R.R. Spike on west side of power pole on NE corner of 39th St. North & Charles
 BM 137.49 R.R. Spike on northwest side of power pole 32' South & 6.3' East of NW corner of Lot 6,
 Block 2, Womers Sherwood Glen Addition

Plan Scale 1" = 40'
 Profile Scale 1" = 40' Horiz.
 1" = 5' Vert.

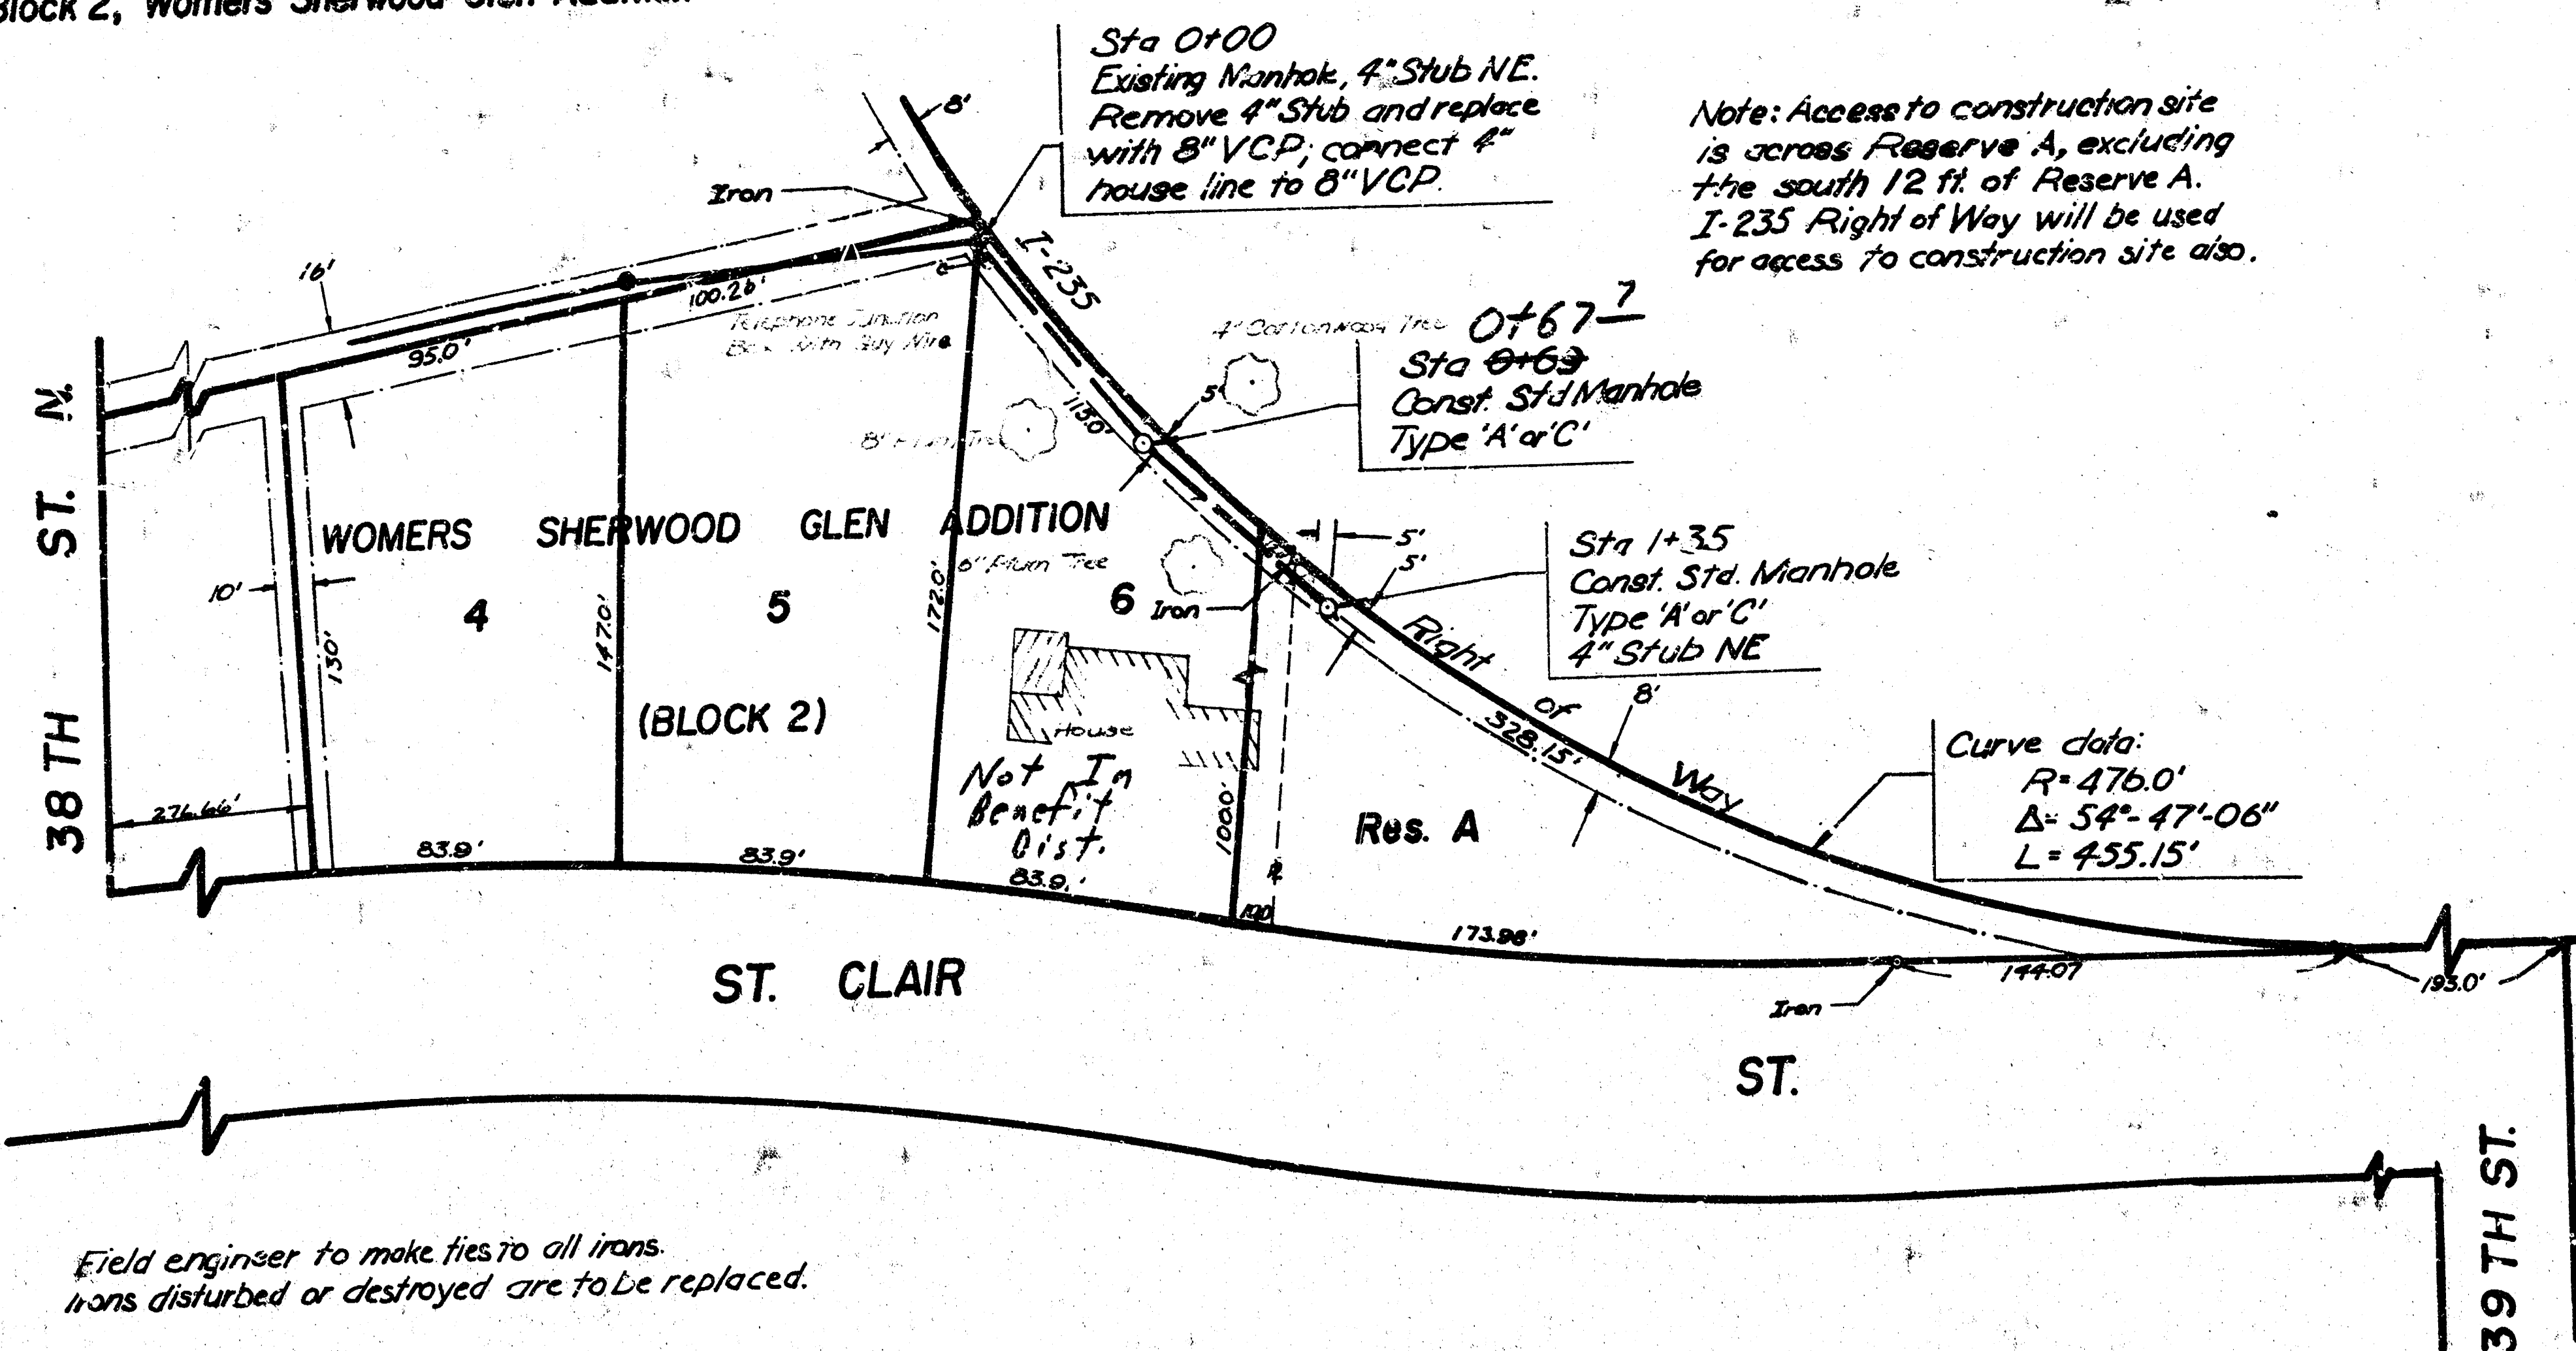

As built 4-8-77

LAT 28, MAIN 21, S.S. NO. 22
 CITY OF WICHITA, KANSAS
 R.W. LINN CITY ENGINEER
 DATE: Jan-1977 PROJECT NO: DBKL576065

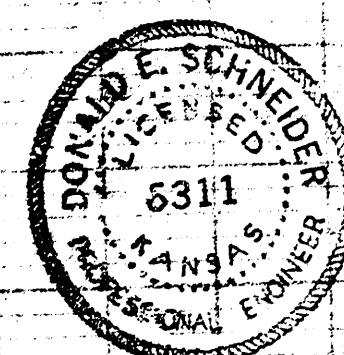


PLATE 1-SINGLE PLAN AND PROFILE FULL LINE
 10" X 10" SCALE