


D. DULLEA
J. LINDSEY

D. DULLEA
J. LINDSEY

D. DULLEA
J. LINDSEY

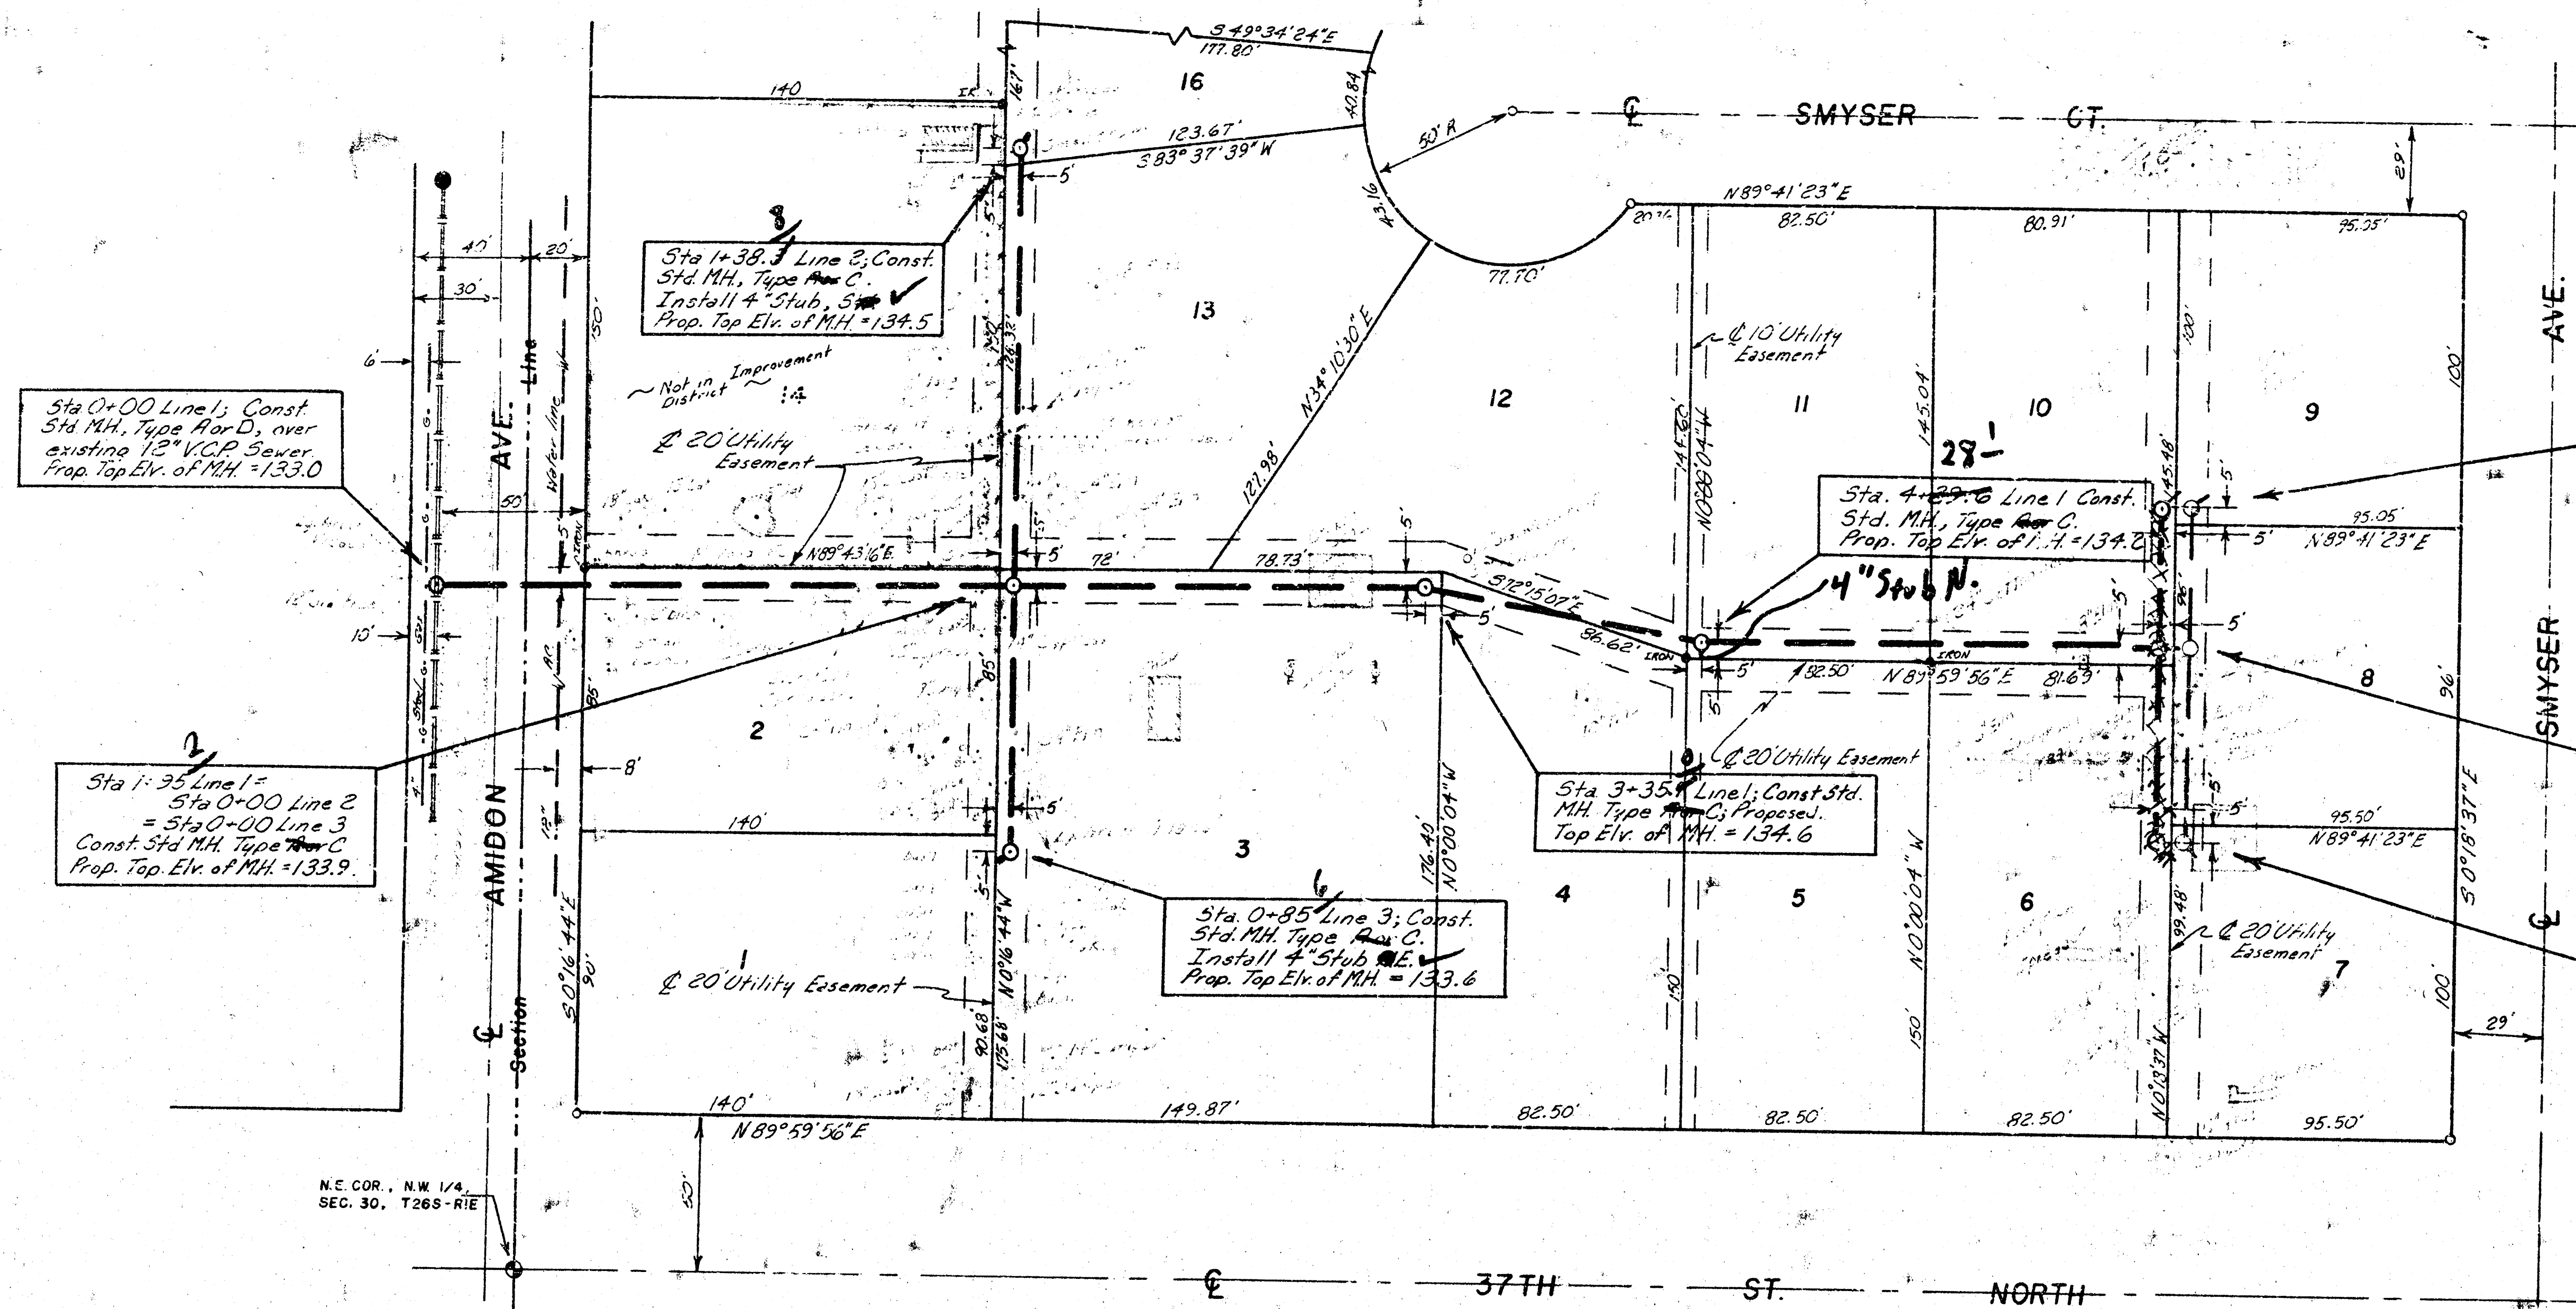


SHERWOOD ESTATES ADDITION
10
WICHITA, SEDGWICK COUNTY, KANSAS

44-
Sta. 0+00 Line 4; Const.
Std. MH, Type ~~A~~ C; Install
4" Stub; ~~Prop.~~ Proposed
Top Elev. of MH = 133.9


53-
Sta. 6+00 Line 1; Const.
Std. MH, Type ~~A~~ C; Install
4" Stub; ~~Prop.~~ Proposed
Top Elev. of MH = 134.3

Scale:
1" = 40' Plan
1" = 40' Horiz.
1" = 5' Vert. Profile

Note: Any tree in which in the opinion of the engineer
can be saved shall be spared.

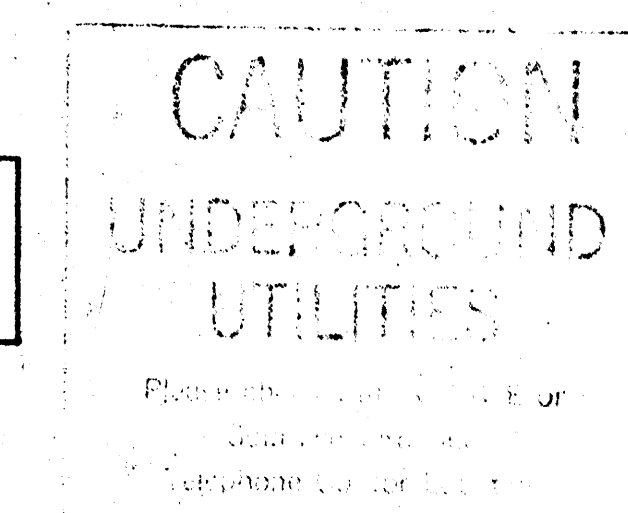

Bench Marks: 133.39 - City Sta. 1+39.5 E and 52' S. of
Smyser St. & Amidon
135.53 - S.E. Cor. of Front Conc. Arch at
3501 N. Clarence

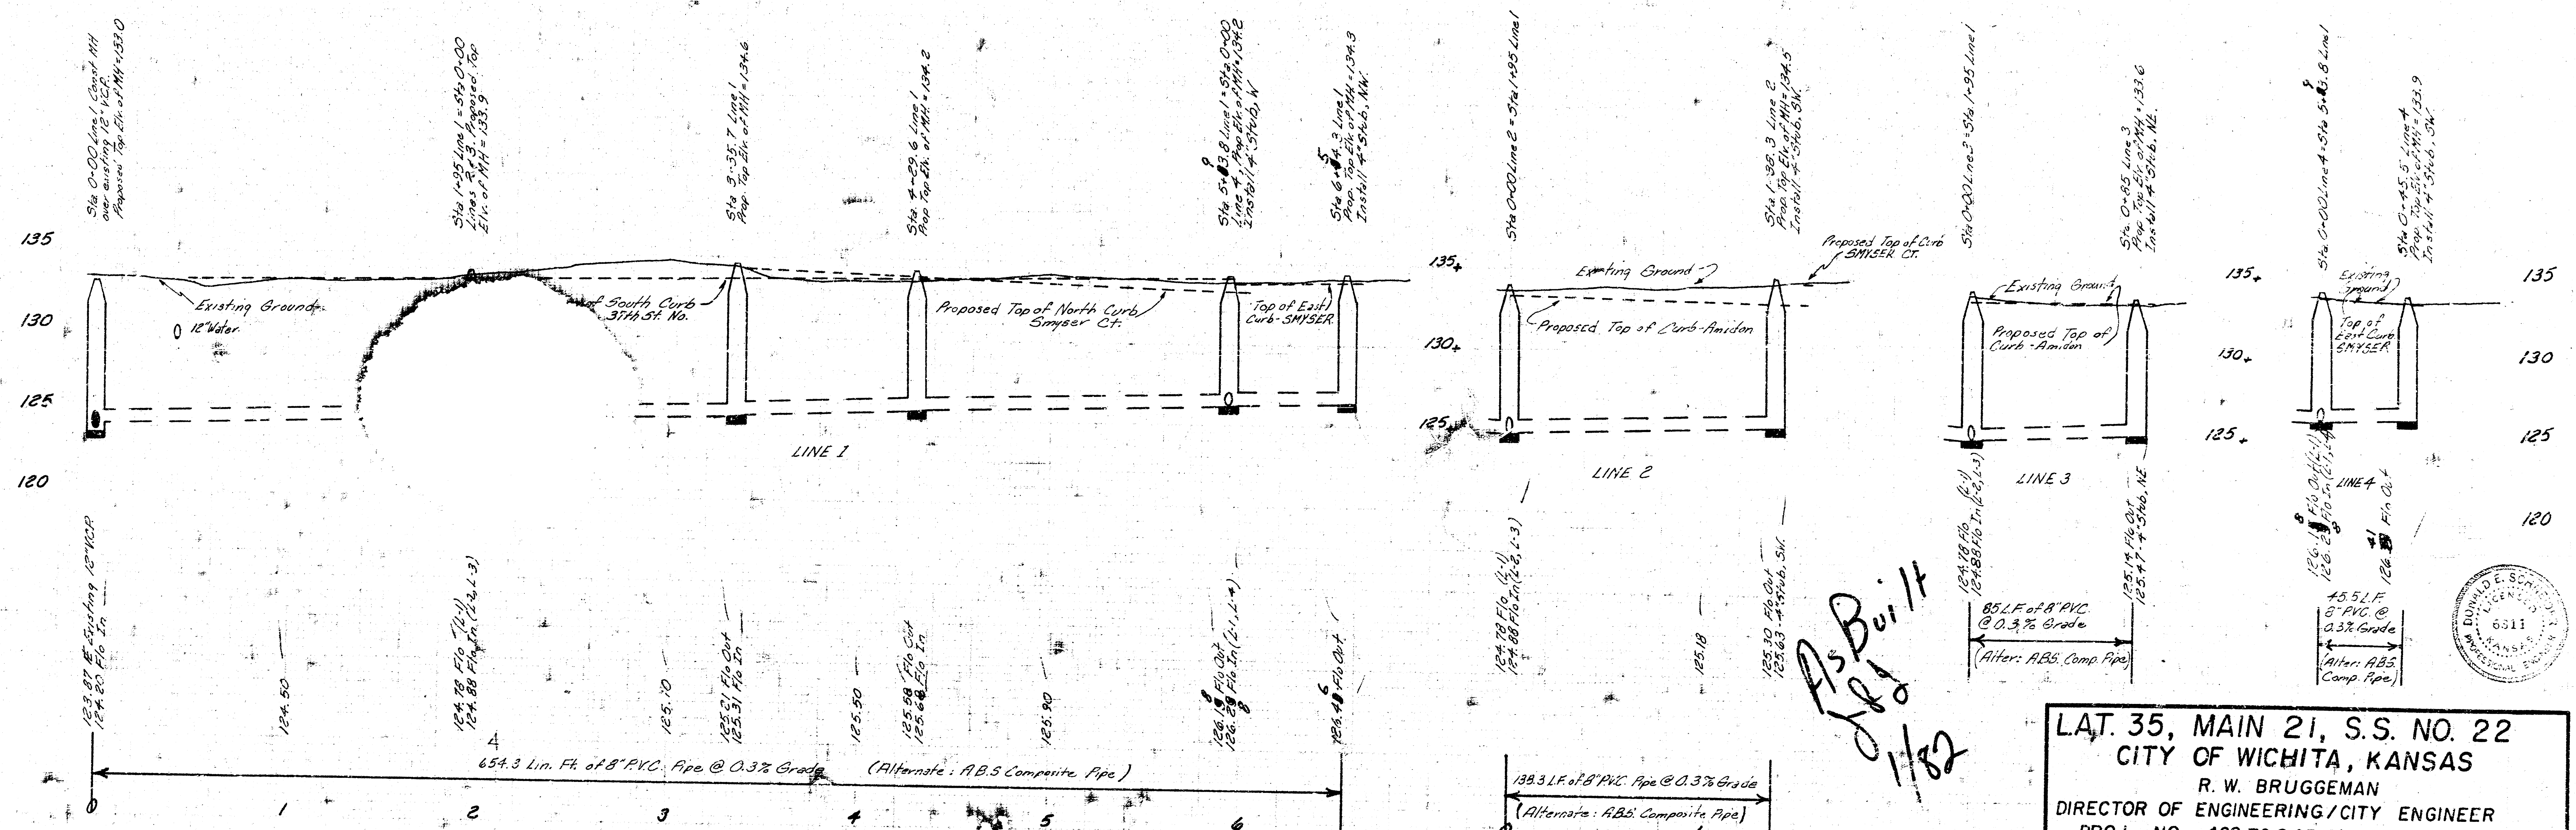

As Built
JLB
1/82

LAT. 35, MAIN 21, S.S. NO. 22
CITY OF WICHITA, KANSAS
R. W. BRUGGEMAN
DIRECTOR OF ENGINEERING/CITY ENGINEER
PROJ. NO. 468-75-245-81136-000-001
DATE _____ SHEET 1 of 1