



PLAN
NOTE BOOK
156 241
2000

PROFILE
NOTE BOOK
156 241
2000

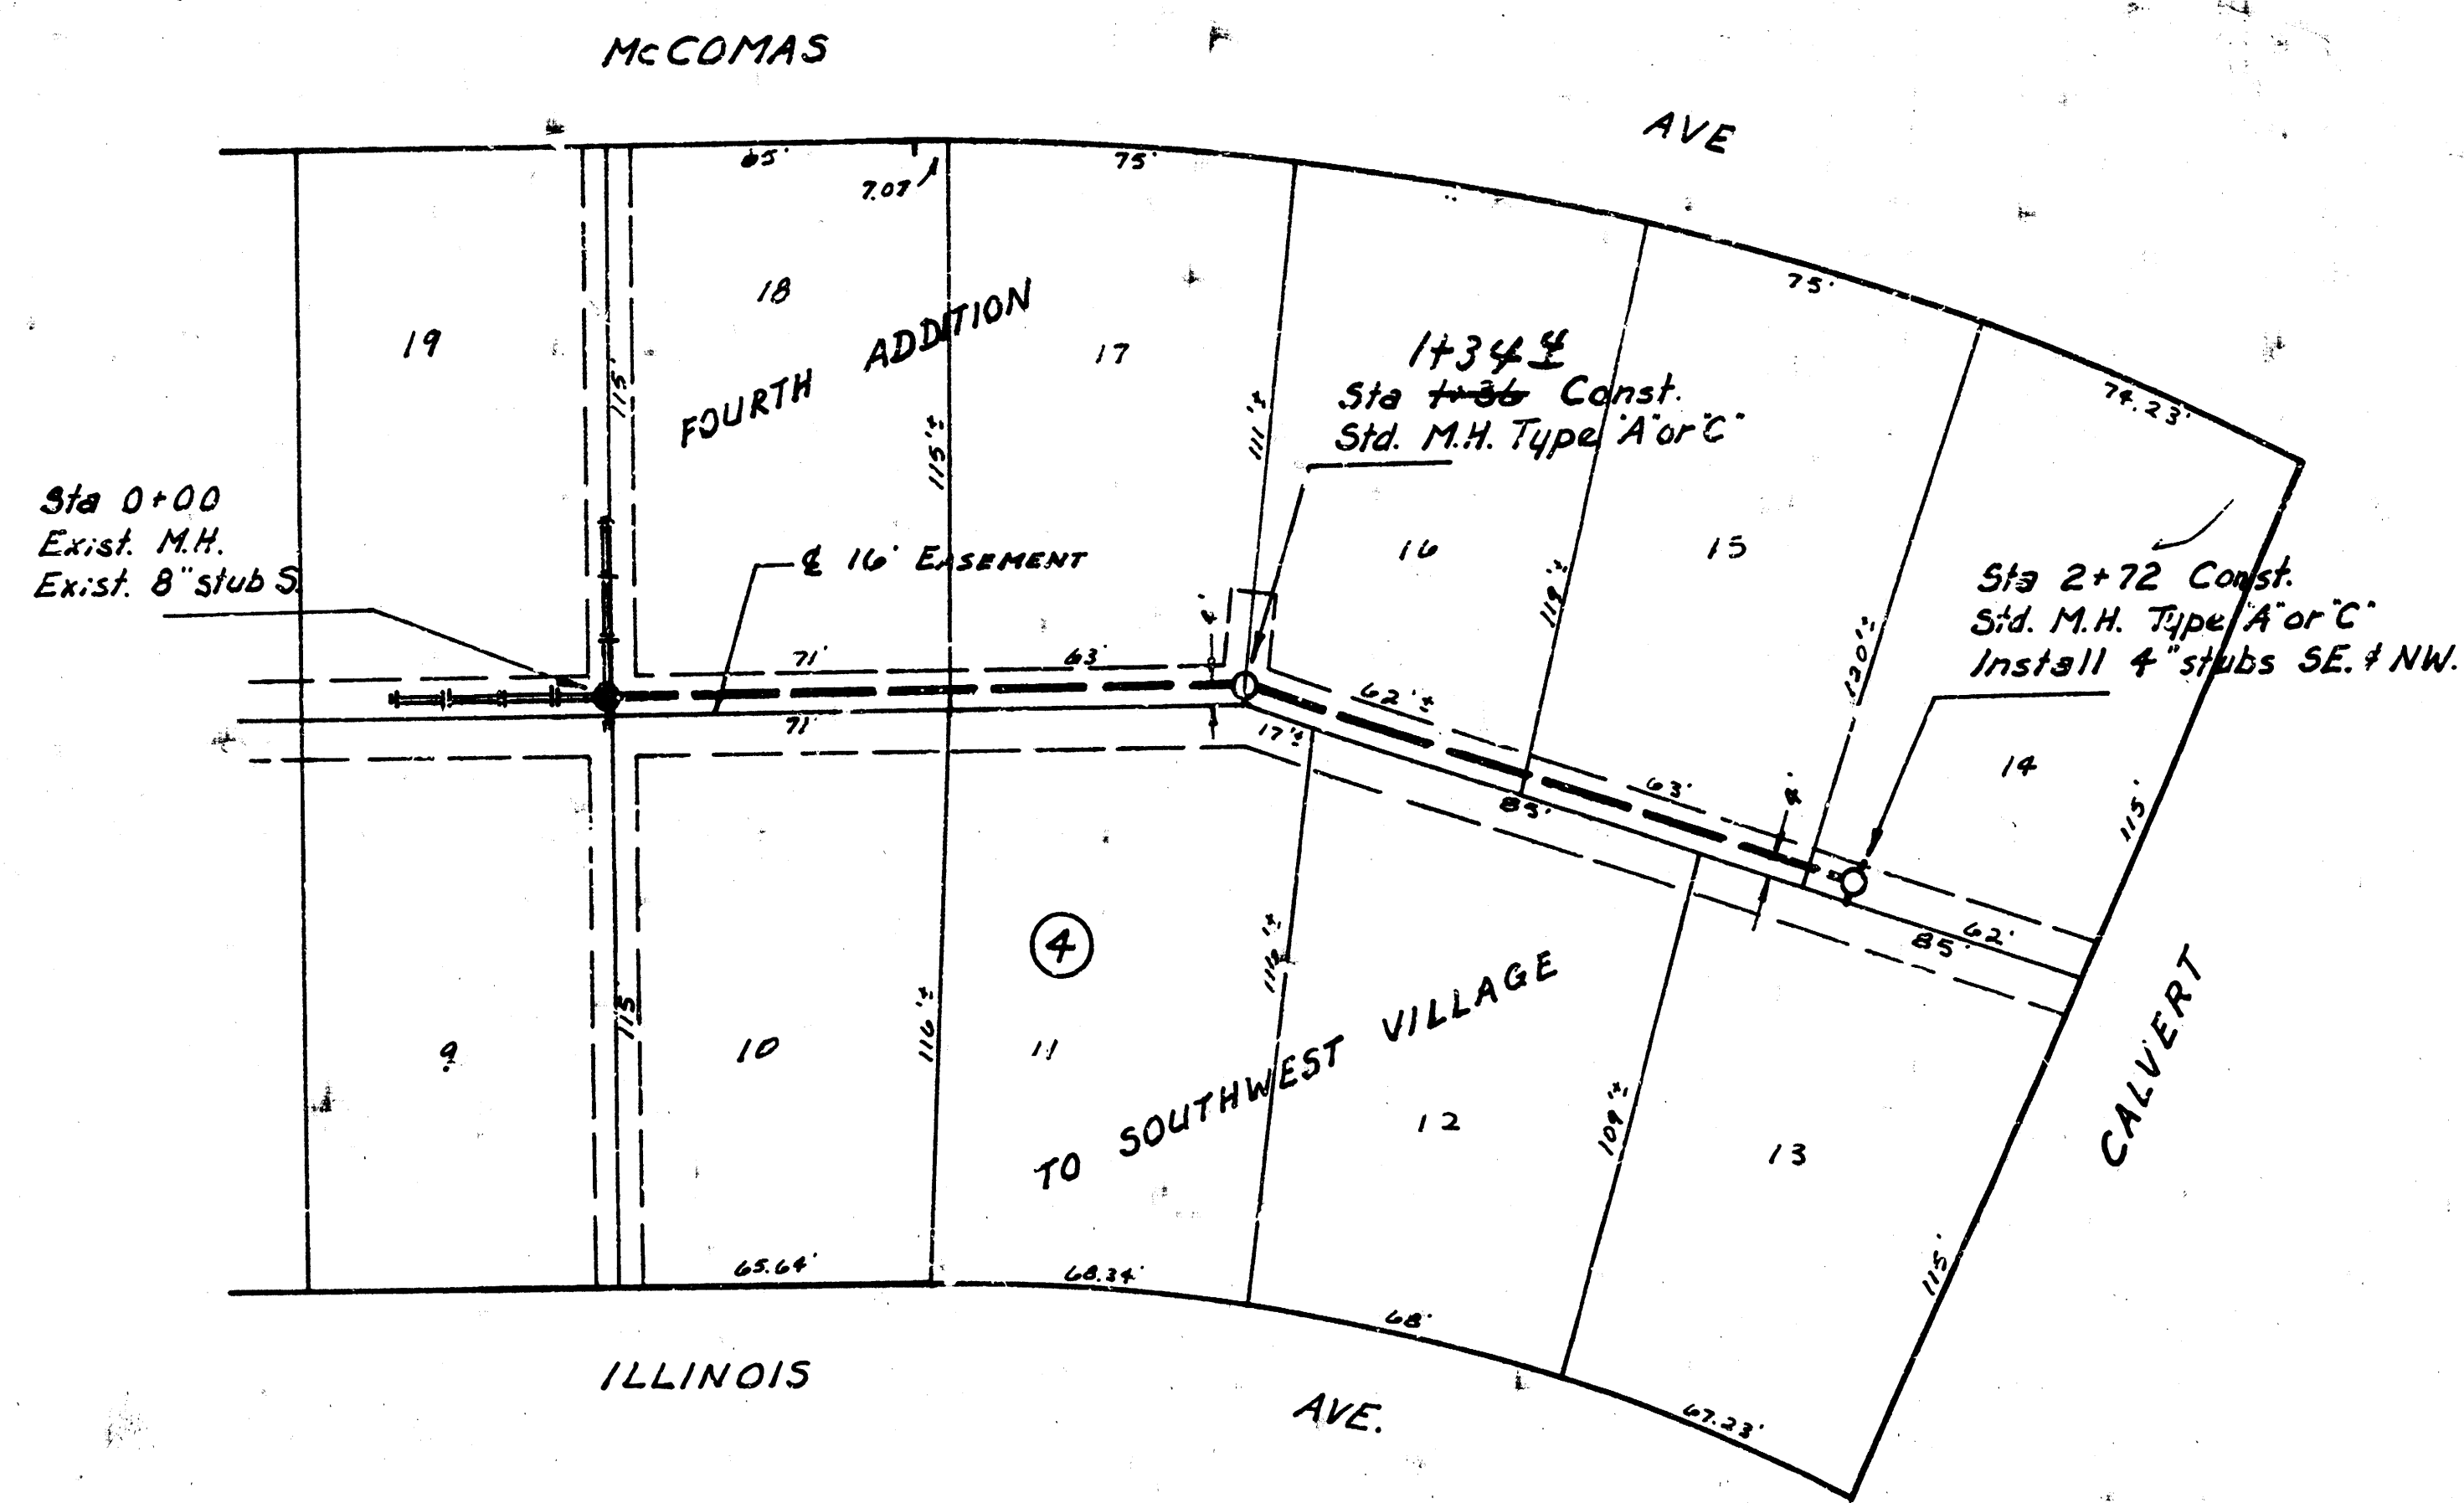


PLAN SCALE 1" = 40'
PROFILE SCALE 1" = 40' VERT.

B.M. 103.47 City Sid. 53' E. & 44' S.
of & West St. & 314' St. So.
B.M. 100.80 "B" cut on NW corner of
East Headwall to R.C.B. just N. of
81' 34" Pass S. of 314' St. So. on West St.

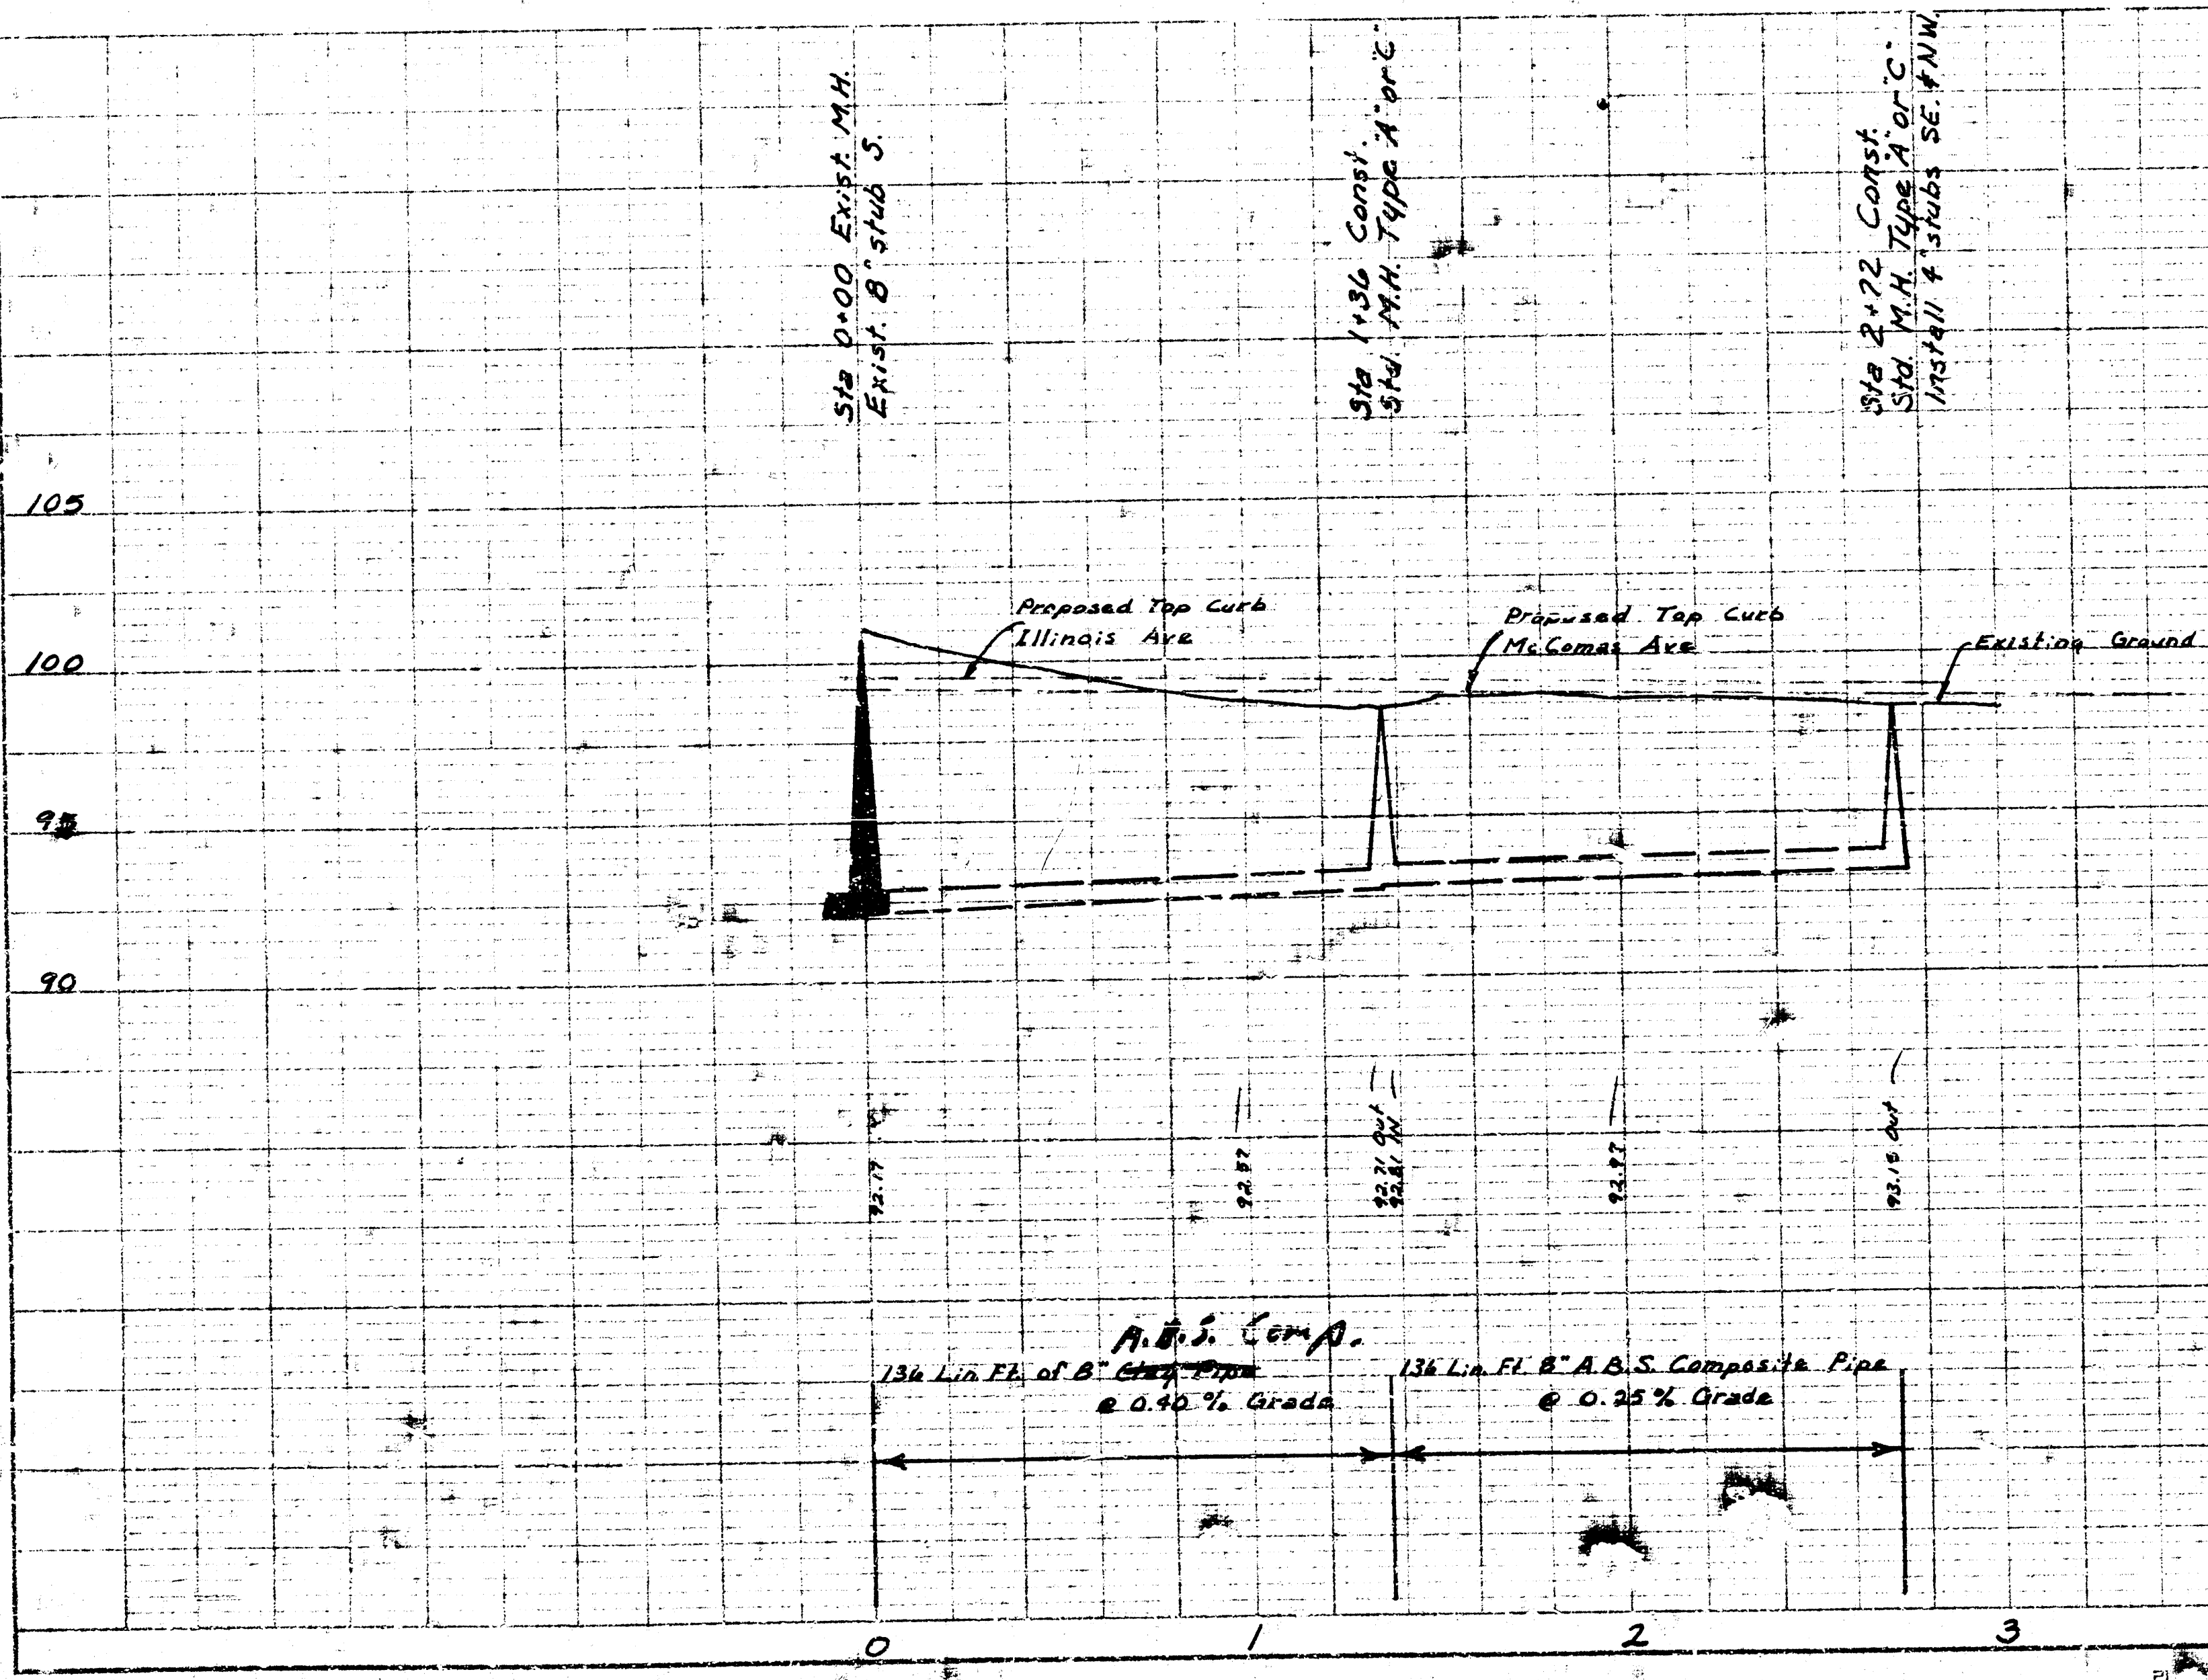

As built 7-5-77
LAT 4, MAIN 23, S.S. 22
CITY OF WICHITA, KANSAS
R. W. LINN — CITY ENGINEER
Feb. 1977 PROJECT NO. DBKL575011

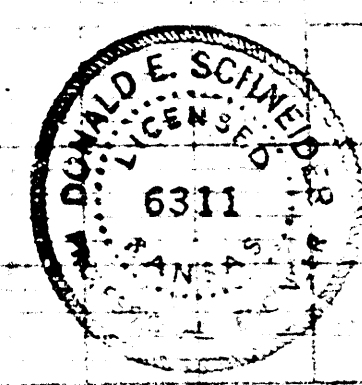

14 10 3 12