



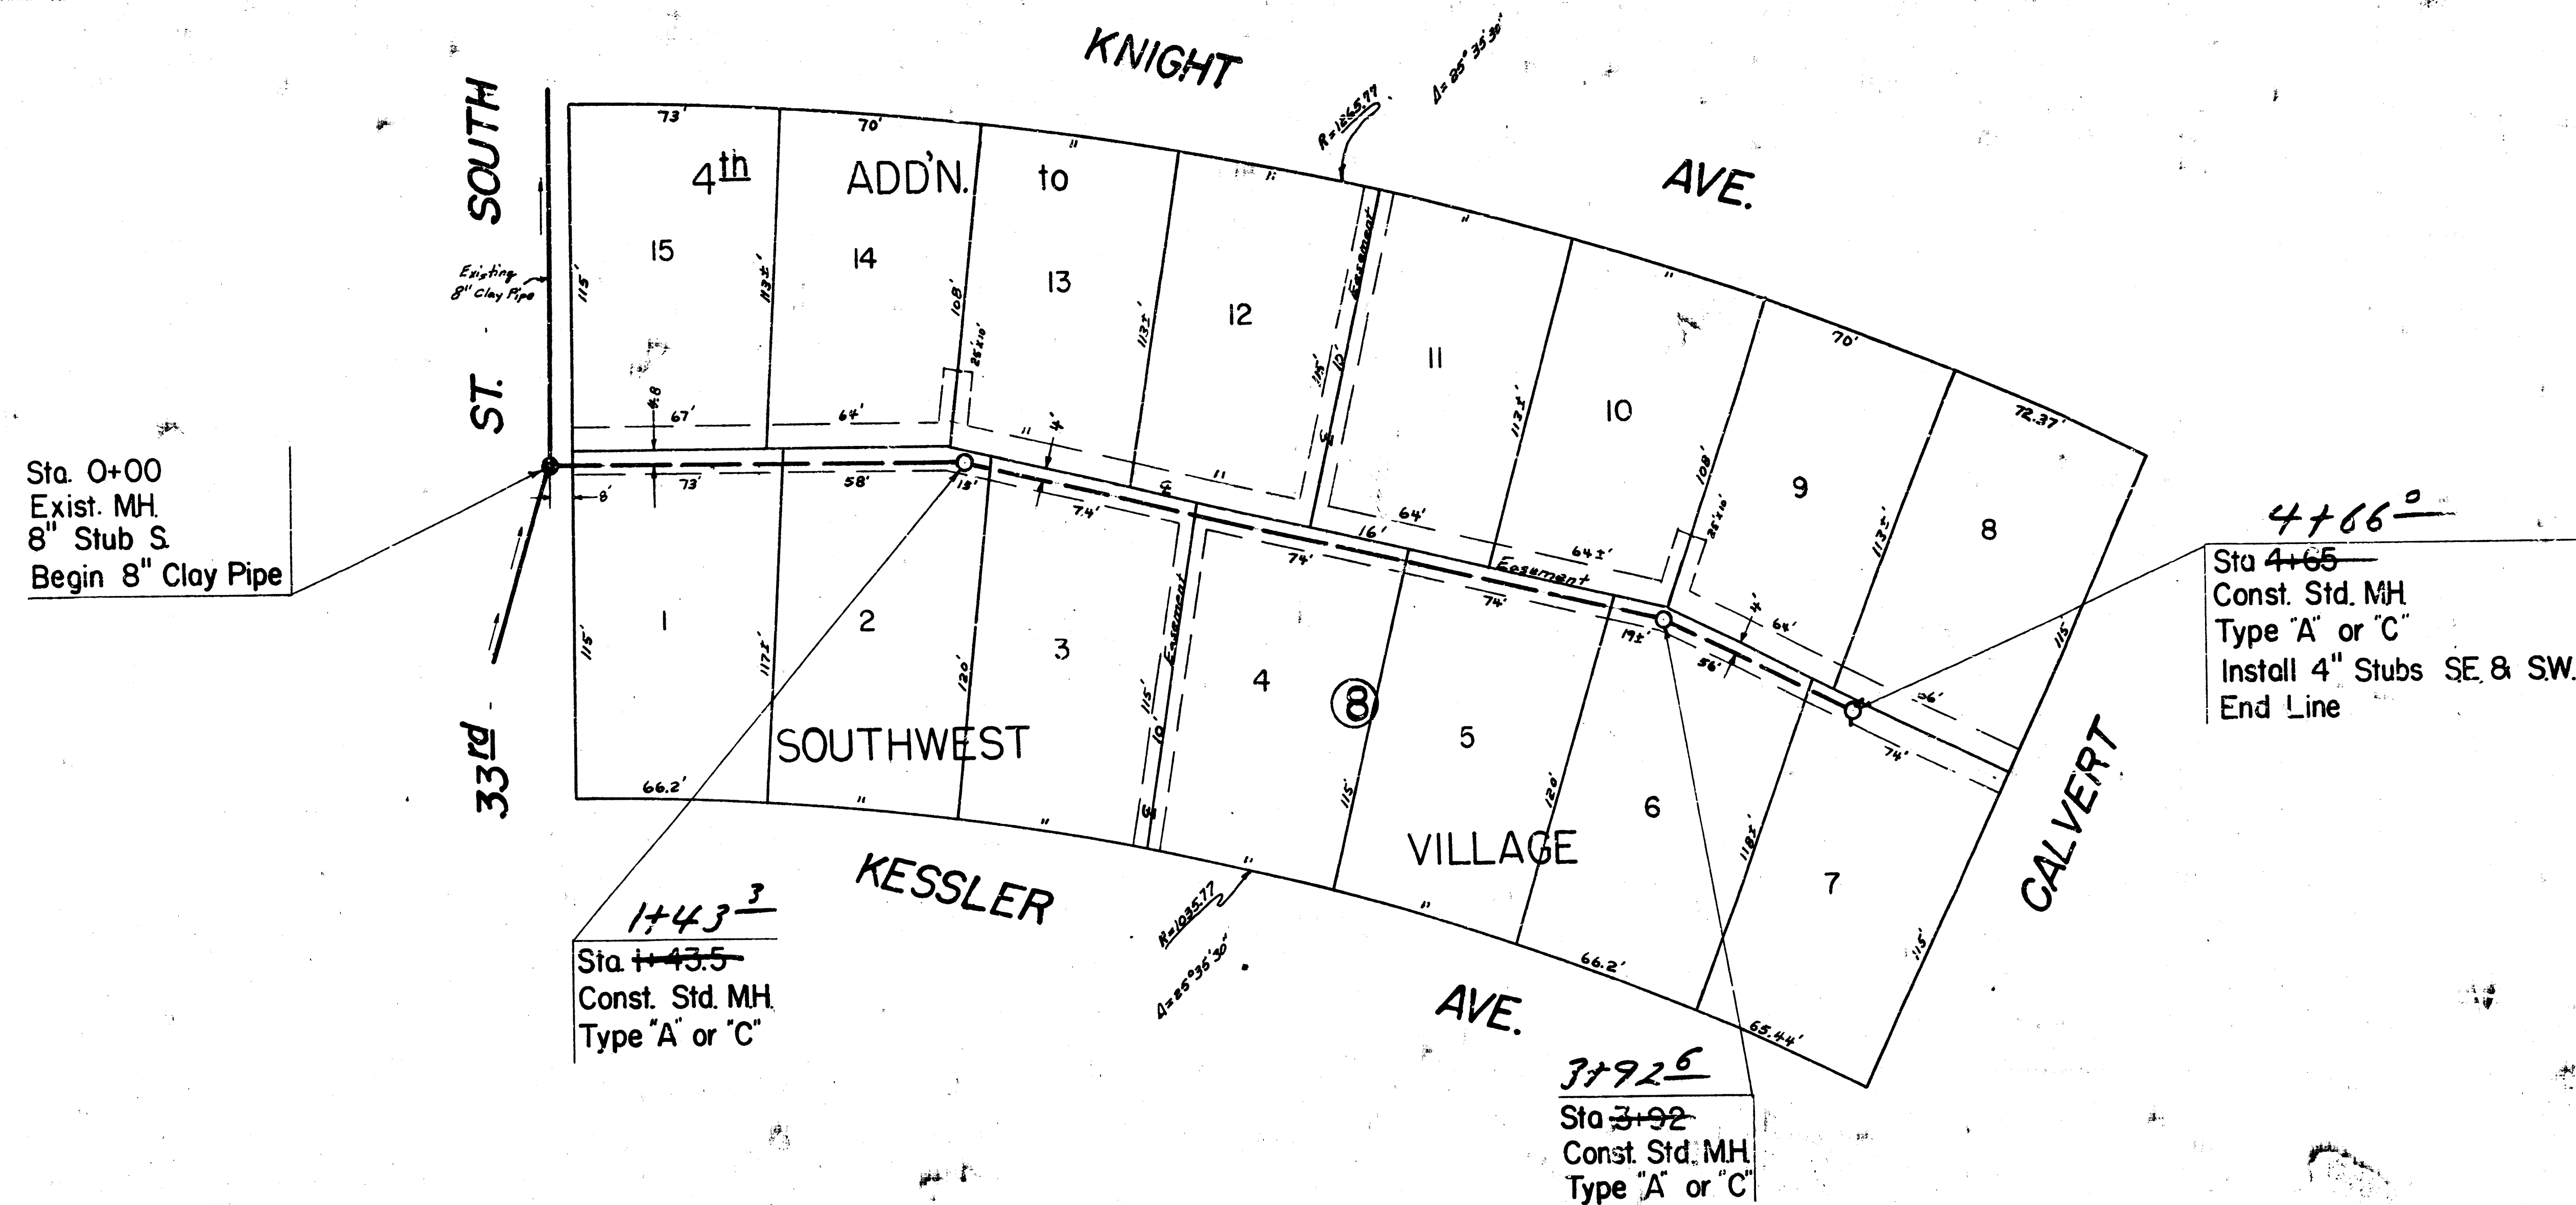

N
 Plan Scale 1" = 40'
 Profile Scale 1" = 40' Horz.
 1" = 5' Vert.

BM 100.68 "+" on top of curb at the east end of return SE corner of Kessler Ave. and 3rd St. South

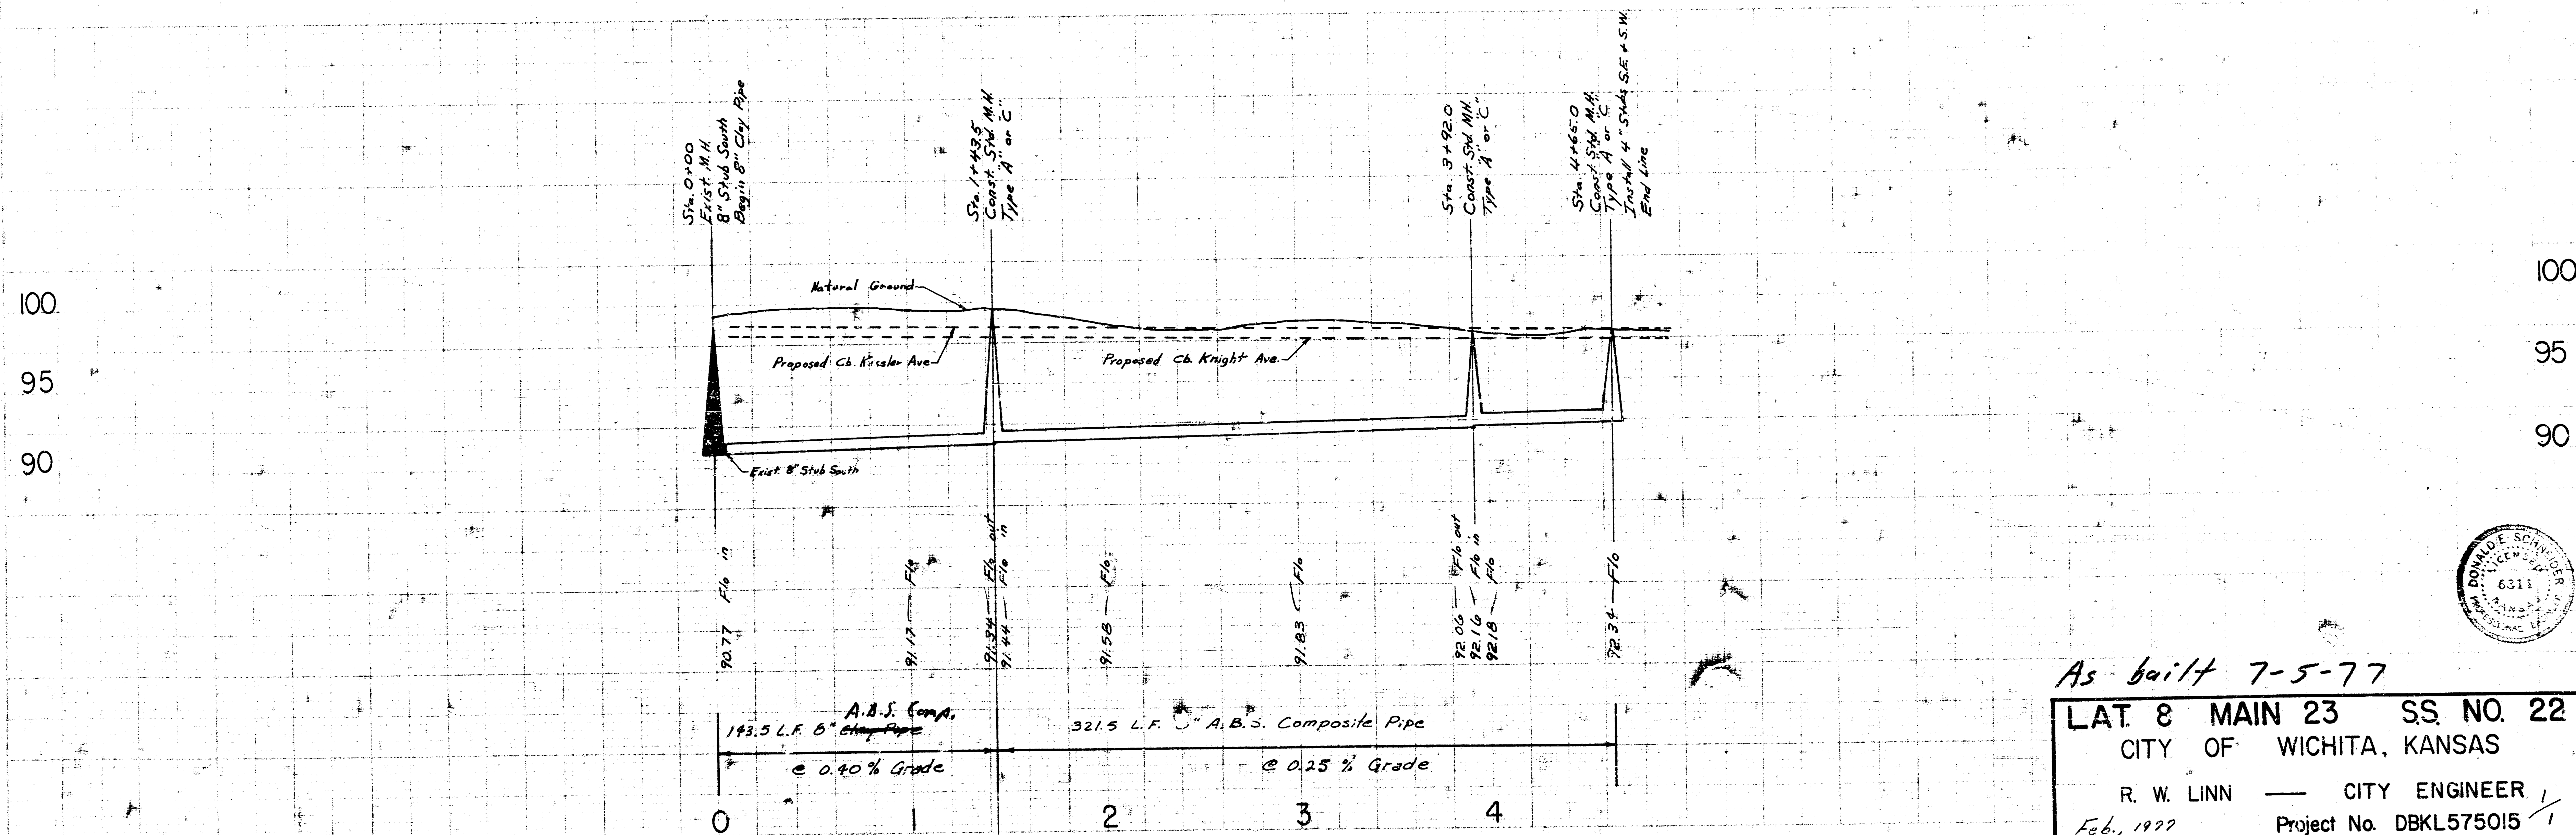

As built 7-5-77

LAT. 8 MAIN 23 SS. NO. 22
 CITY OF WICHITA, KANSAS
 R. W. LINN — CITY ENGINEER
 Feb., 1977 Project No. DBKL575015

