
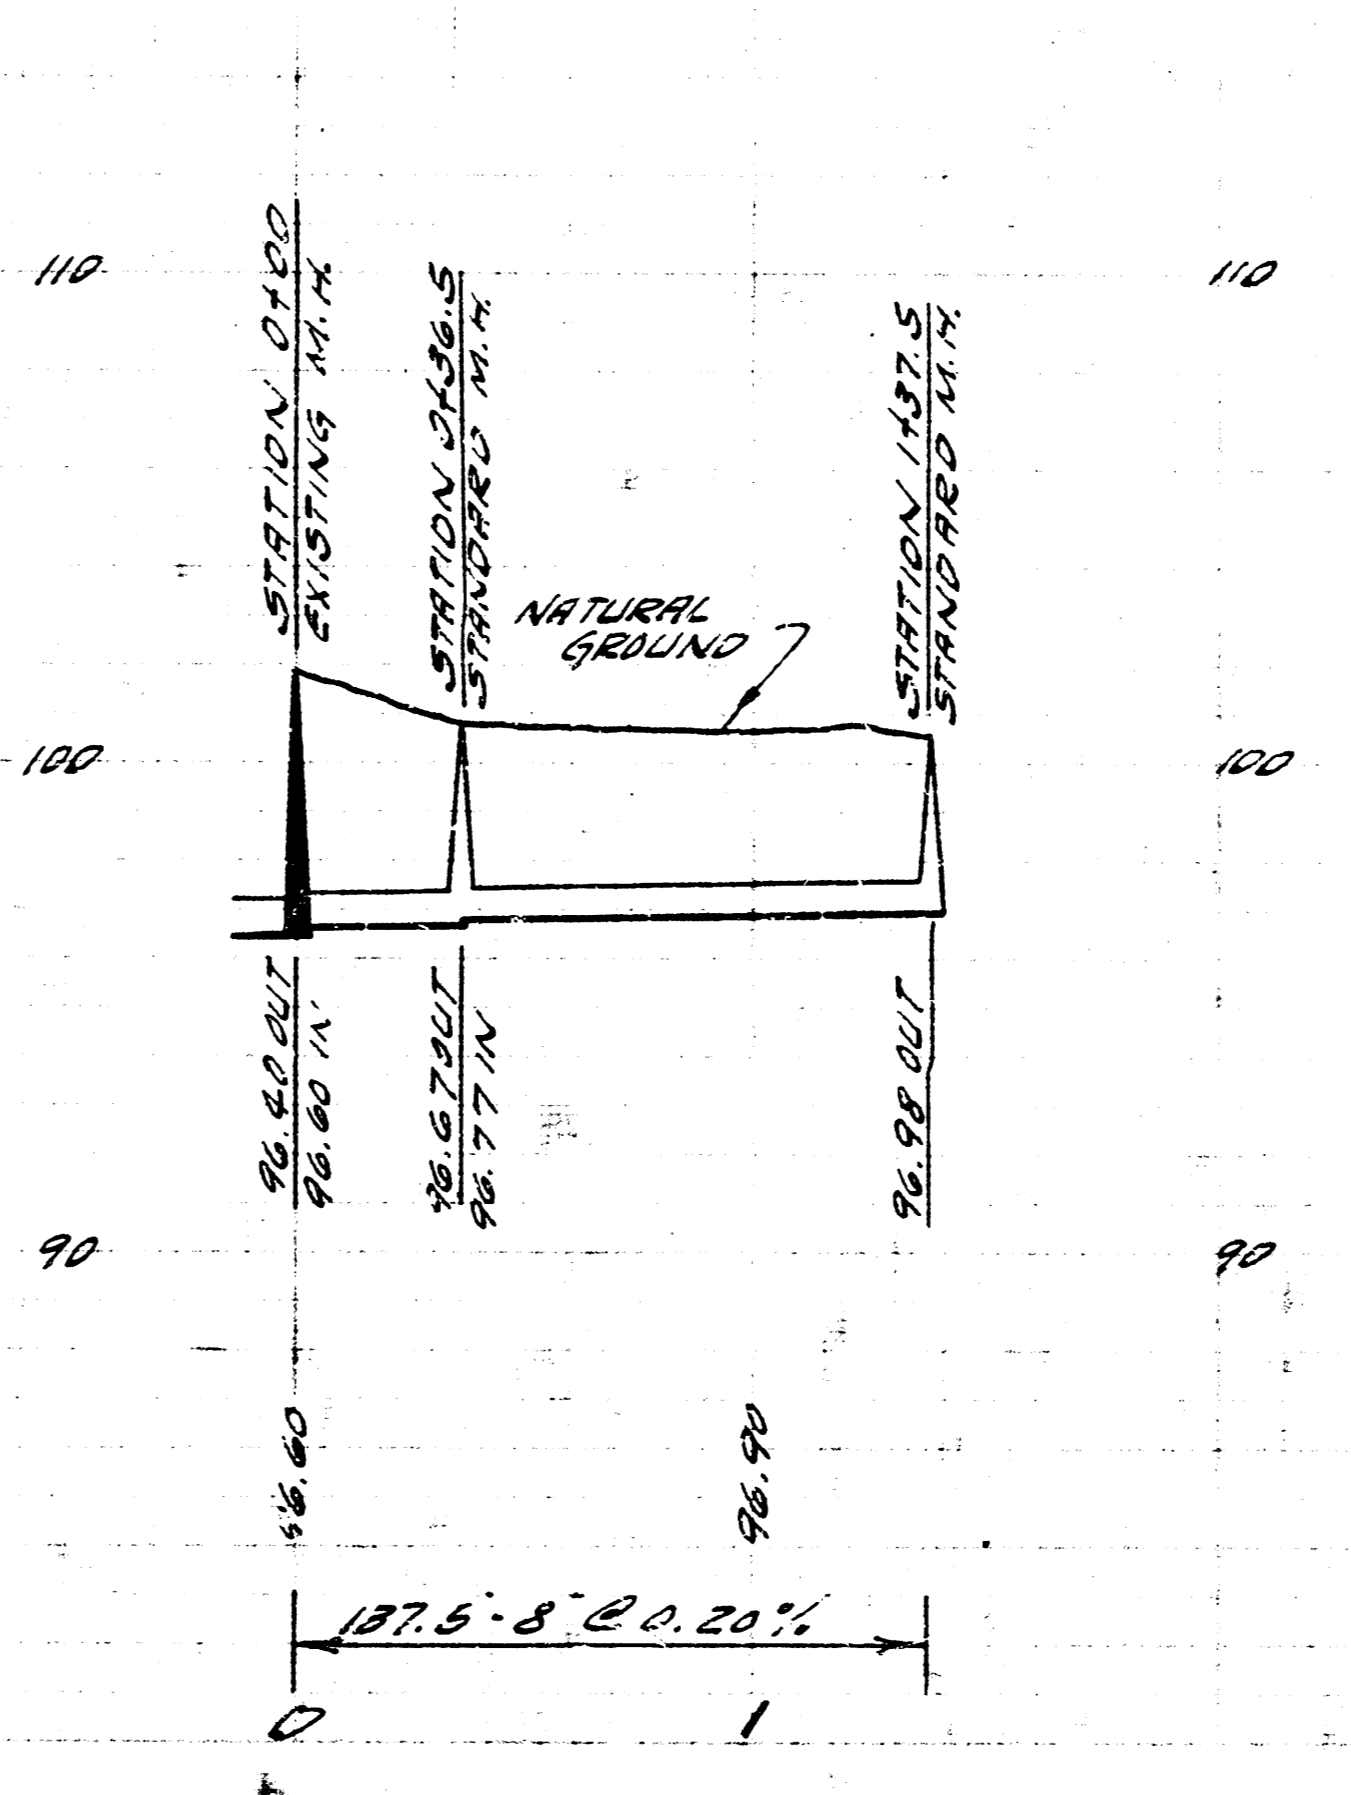


AS BUILT PLANS

EXT. OF LAT. 6 SAN. SEWER 23  
CITY OF WICHITA, KANSAS  
B.E. SMITH CITY ENGINEER  
PRIVATE JOB. DEC. 1960

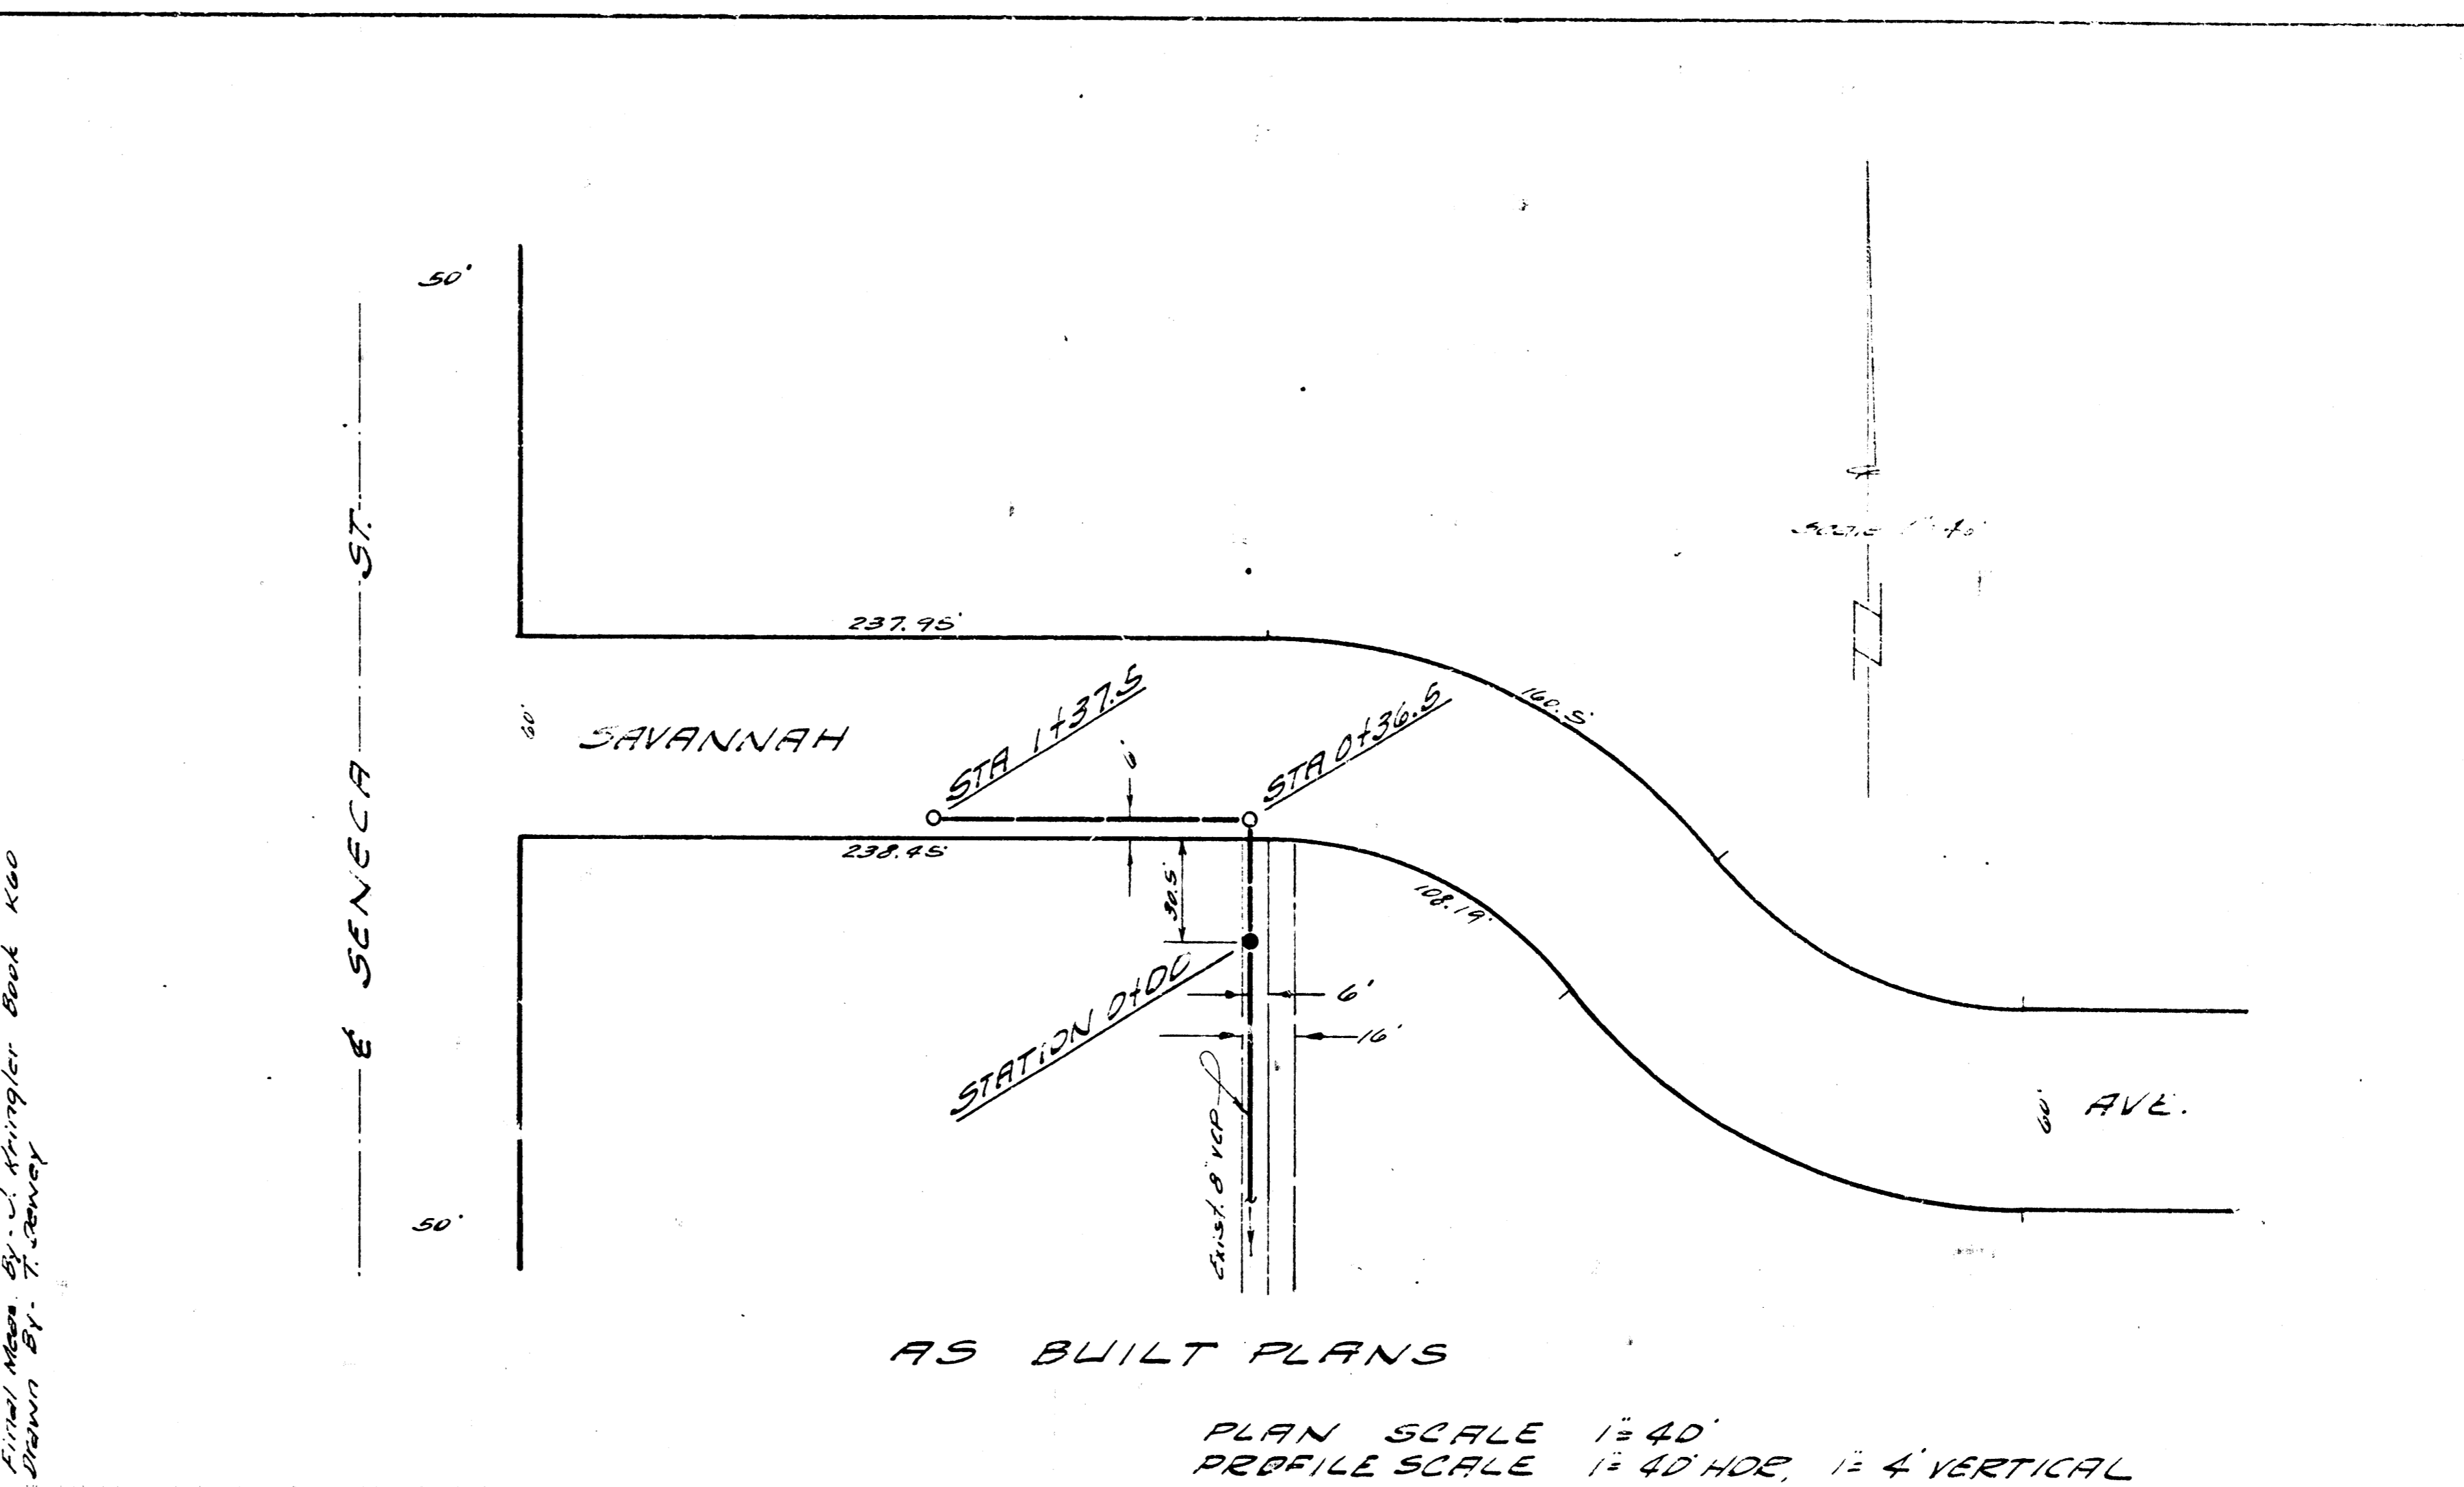

AS BUILT PLANS

PRIVATE SAN. SEWER AT SE  
COR. SENECA & SAVANNAH  
B.E. SMITH CITY ENGINEER  
CITY OF WICHITA, KANSAS  
PRIVATE JOB. DEC. 1960