

LATERAL 37 ——— S.S. NO. 23


PROJECT NO.
468-76-245-80595-000-000-001

CITY OF WICHITA, KANSAS
R.W. LINN CITY ENGINEER
SEPTEMBER, 1978

SYCAMORE VILLAGE THIRD ADDITION

INDEX TO DRAWINGS

SHEET NO.	DESCRIPTION
1	TITLE & LOCATION MAP
2	LINE 1, 1A, 1B
3	LINE 2, 3, 1C
4	LINE 3, 4, 4A
5	LINE 4, 4B, 4C

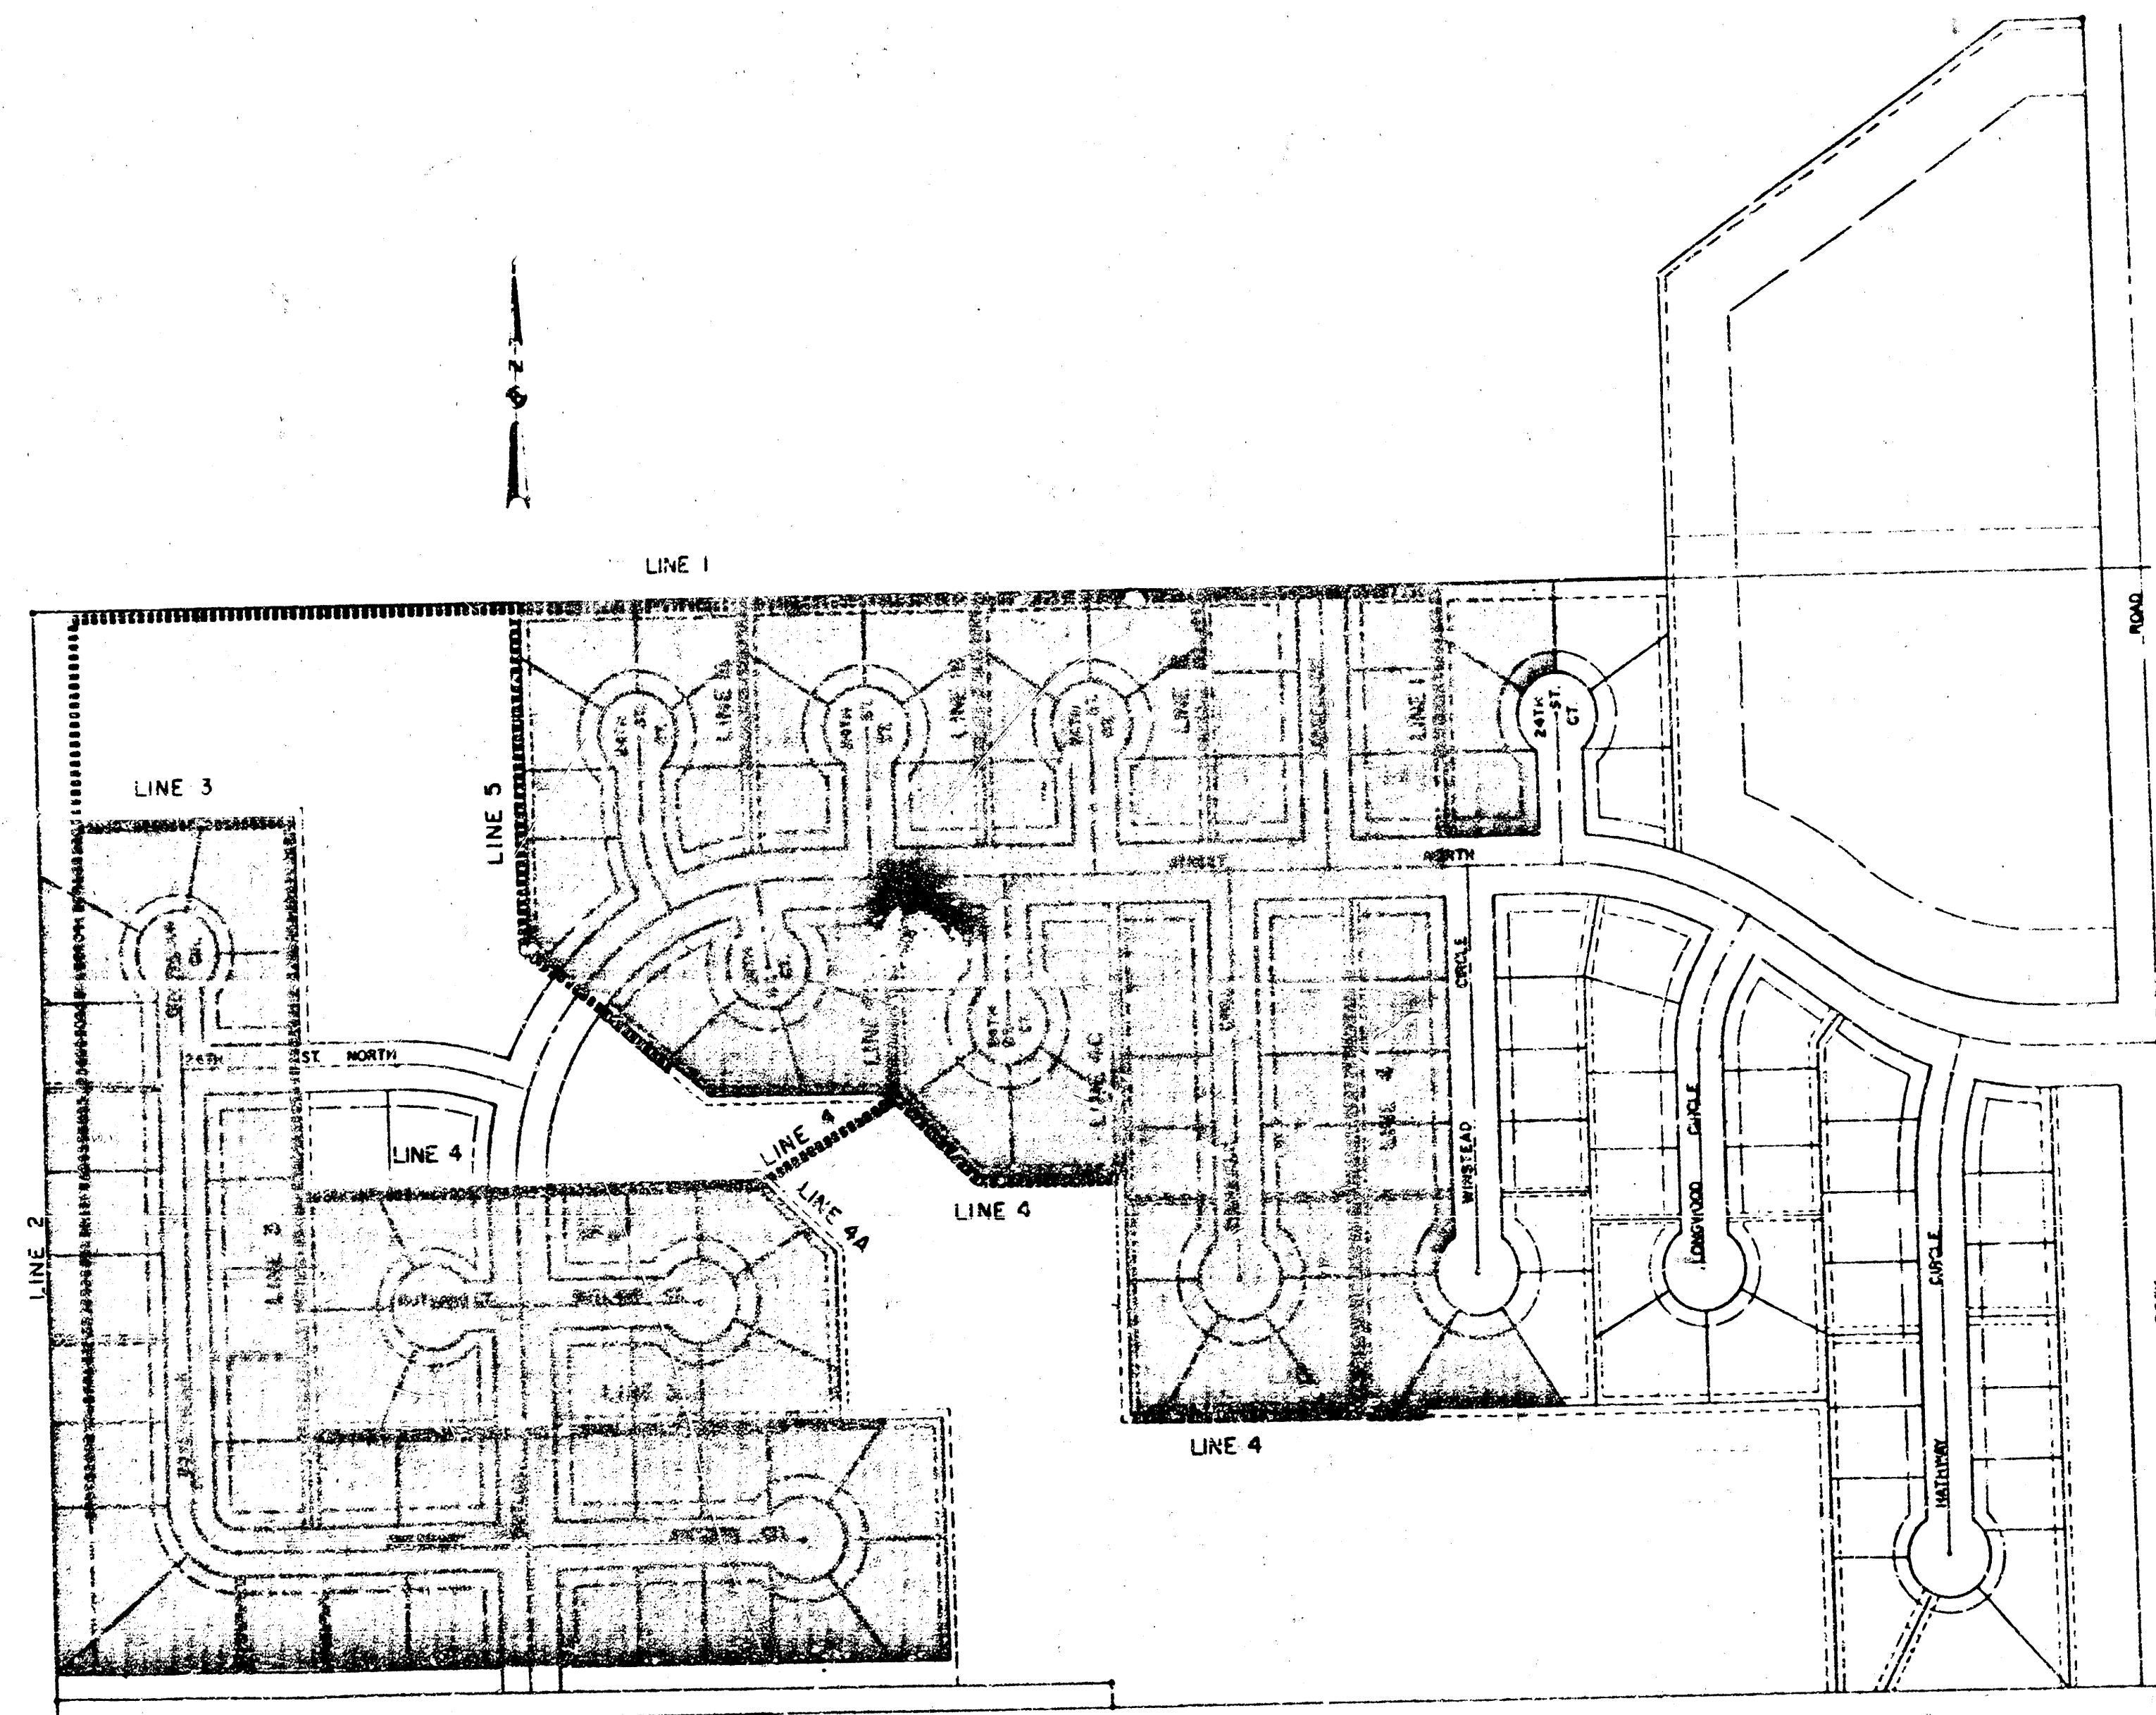

NOTE: WORK ORDER ON THIS PROJECT WILL NOT BE ISSUED UNTIL CONSTRUCTION OF PRIVATE PROJECT NO. 468-76-245-80536-000-000-003 HAS BEEN AUTHORIZED BY THE DEVELOPER.

Kenzie H. P. [Signature]

*As Built
[Signature]*

BENEFIT DISTRICT - ALL LOTS IN BLOCKS 1, 2, & 3; LOTS 1 THROUGH 6, BLOCK 4; AND LOTS 1 THROUGH 47, BLOCK 5, ALL IN SYCAMORE VILLAGE THIRD ADDITION.

VAN DOREN - HAZARD - STALLINGS
ARCHITECTS - ENGINEERS - PLANNERS
WICHITA, KANSAS 67202

SHEET
1
OF
5

