

SANITARY SEWER PLANS

LAT. 45 S.S. NO.23

PROJECT NO

468-76-245-80885-000-000-001

CITY OF WICHITA KANSAS

MICHAEL E. LINDEBAK, CITY ENGINEER

GENERAL NOTES


1. CONTRACTOR SHALL AVOID UNCOVERING EXISTING WATER LINES UNLESS ABSOLUTELY NECESSARY. UNCOVERING SHALL BE DONE ONLY IN THE PRESENCE OF A WATER DEPARTMENT ENGINEER.
2. THE CONTRACTOR SHALL BE RESPONSIBLE FOR PRESERVING PROPERTY IRONS. THE CONTRACTOR SHALL BE REQUIRED TO RE-ESTABLISH ANY PROPERTY IRONS WHICH ARE DAMAGED OR DESTROYED BY HIS CONSTRUCTION OPERATIONS. SUCH IRONS SHALL BE RE-ESTABLISHED BY A LICENSED LAND SURVEYOR OR A LICENSED PROFESSIONAL ENGINEER IN ACCORDANCE WITH STATE LAWS.
3. CONTRACTOR SHALL NOTIFY THE UTILITY COMPANIES OF CONSTRUCTION SCHEDULING.
4. EXISTING UTILITIES AND THEIR LOCATIONS, AS SHOWN ON THE PLANS, REPRESENT THE BEST INFORMATION OBTAINABLE FOR DESIGN. LOCATION INFORMATION HAS BEEN OBTAINED FROM THE VARIOUS UTILITY COMPANIES AND IS EITHER FROM COMPANY RECORD DRAWINGS OR COMPANY PROVIDED FIELD LOCATIONS. THE PLAN LOCATIONS SHOWN ARE NOT GUARANTEED. ADDITIONAL EXISTING UTILITIES MAY ALSO BE ENCOUNTERED.

NOTE: NOTIFY THE FOLLOWING COMPANIES PRIOR TO ANY EXCAVATION.

BELL TELEPHONE COMPANY	268-2256
CABLEVISION	262-0661
GAS SERVICE COMPANY	262-7511
KANSAS GAS & ELECTRIC	261-8248
KANSAS ONE-CALL	1-800-344-7233

BENCH MARK


CITY SLD. DISC 39' N. AND 33' E. CL BOTH OLIVER STREET AND 29TH STREET NORTH. ELEV. 159.68

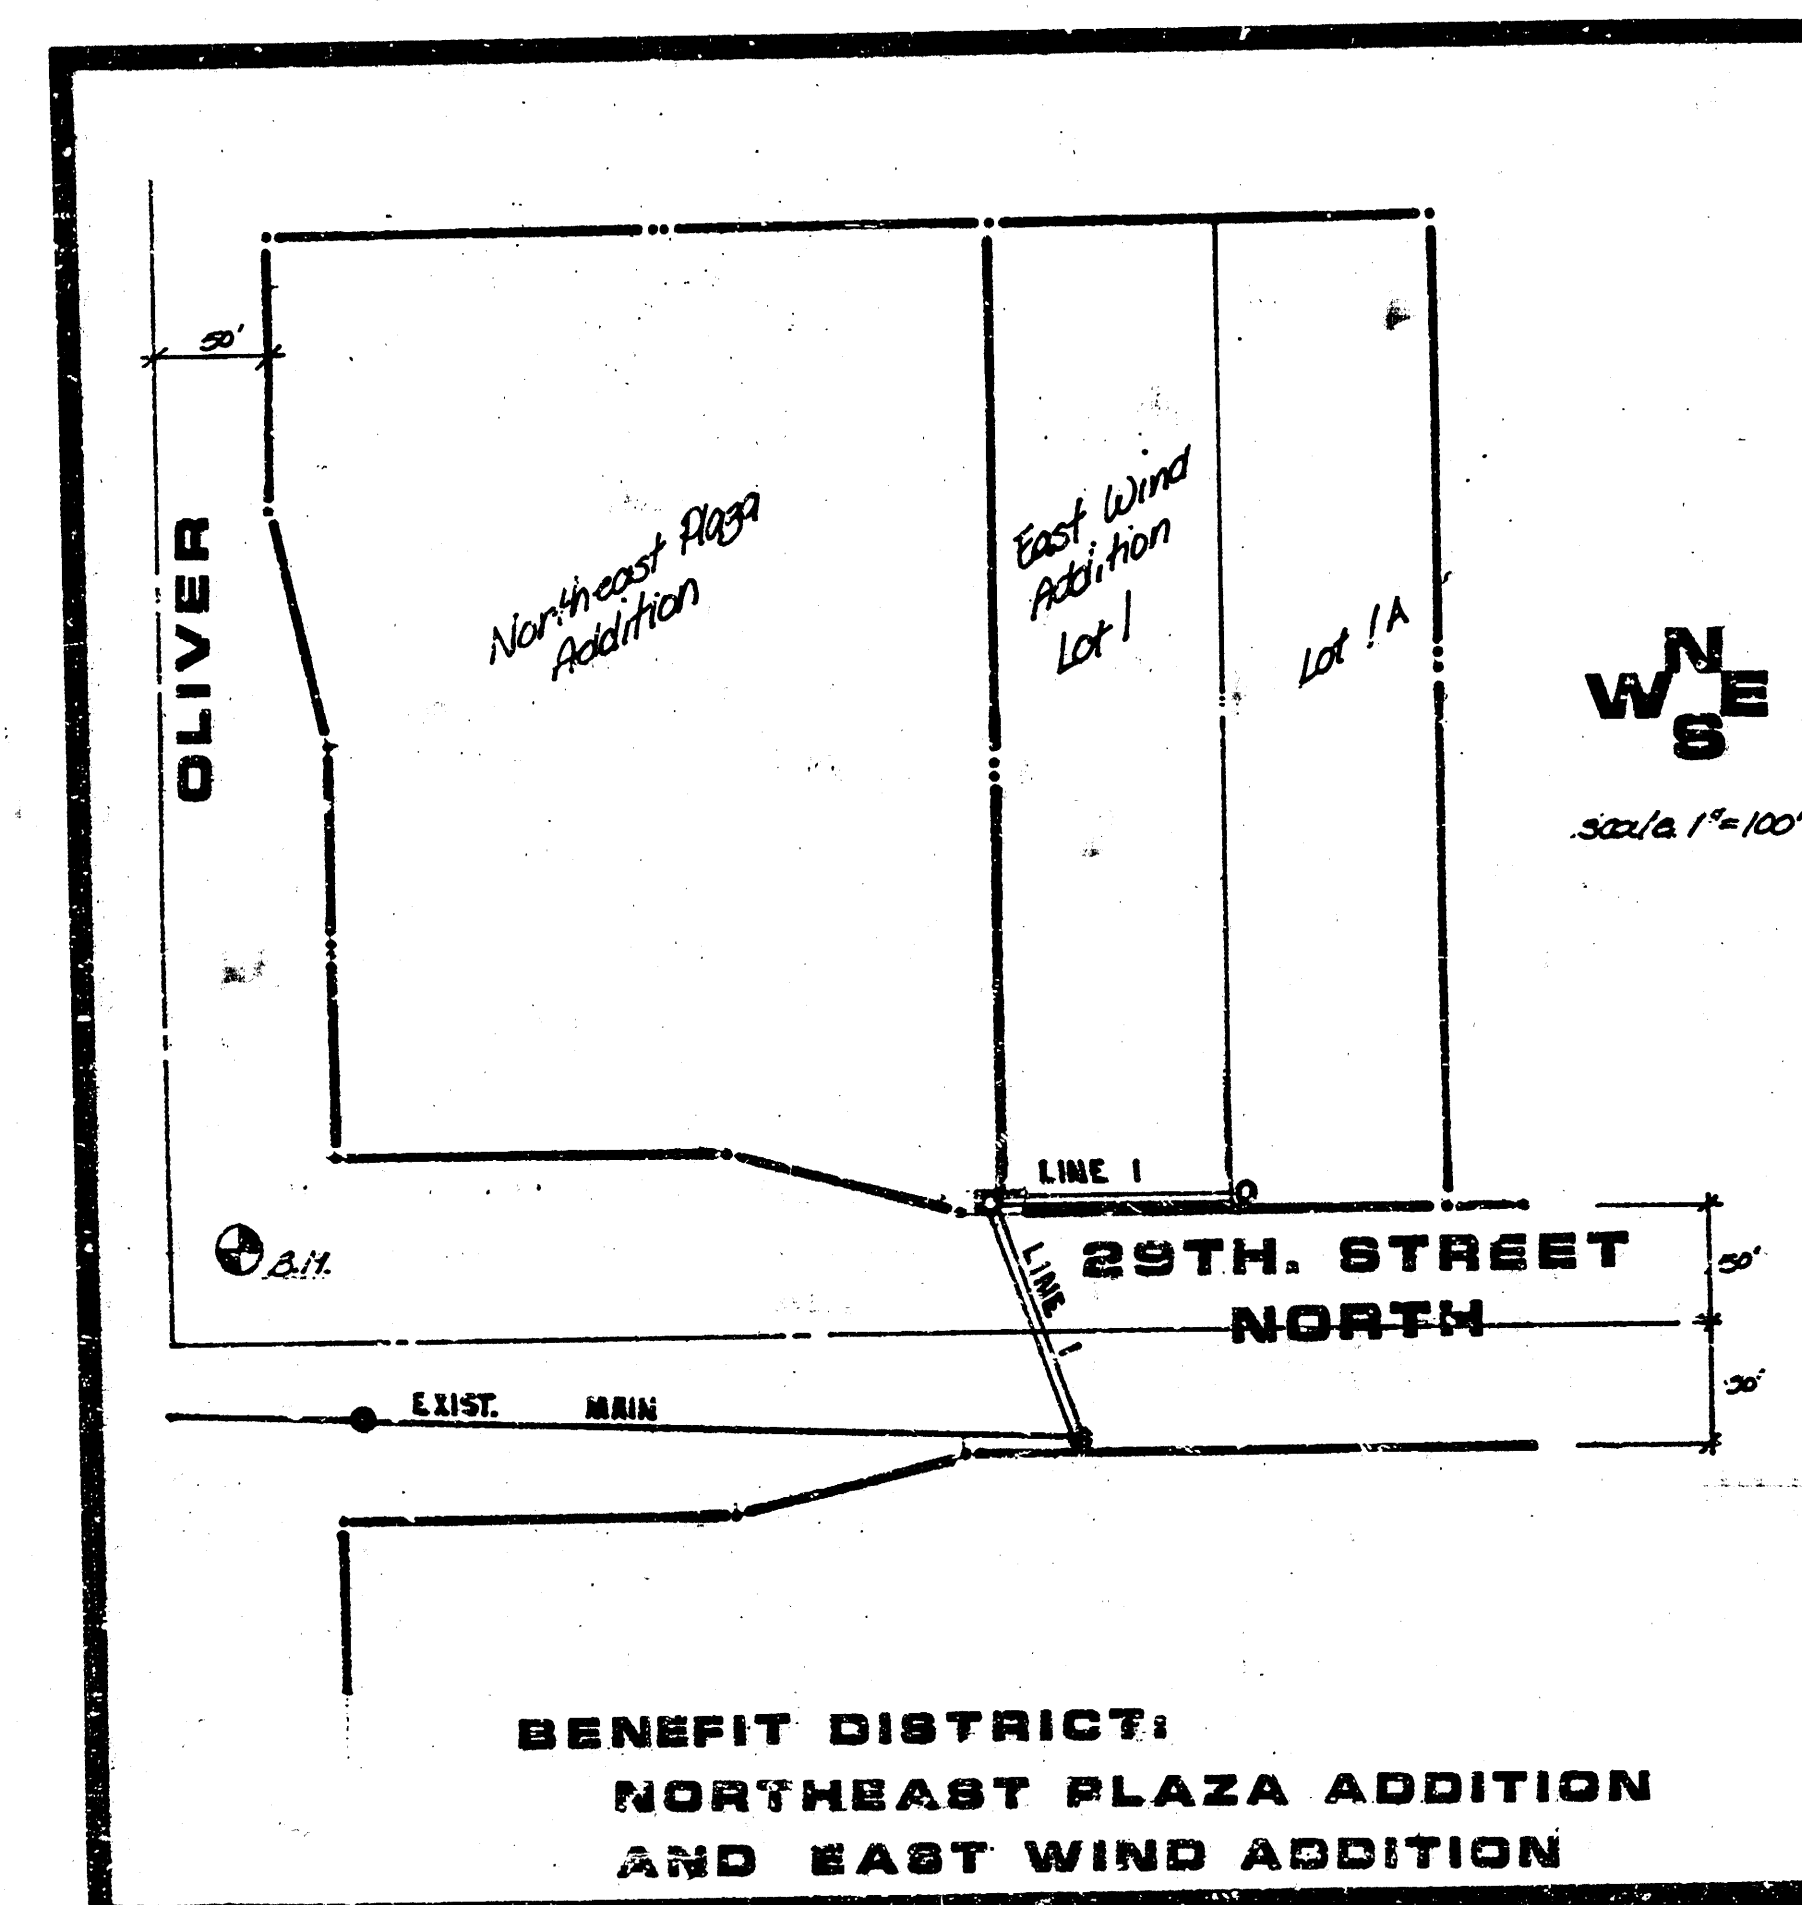

INDEX TO DRAWINGS



SHEET NO.
1
2

DESCRIPTION
TITLE & LOCATION
PLAN & PROFILE

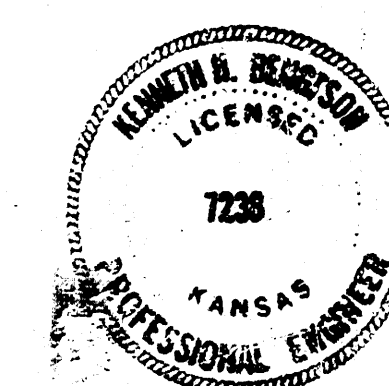

1/2

FILMED FROM THE BEST

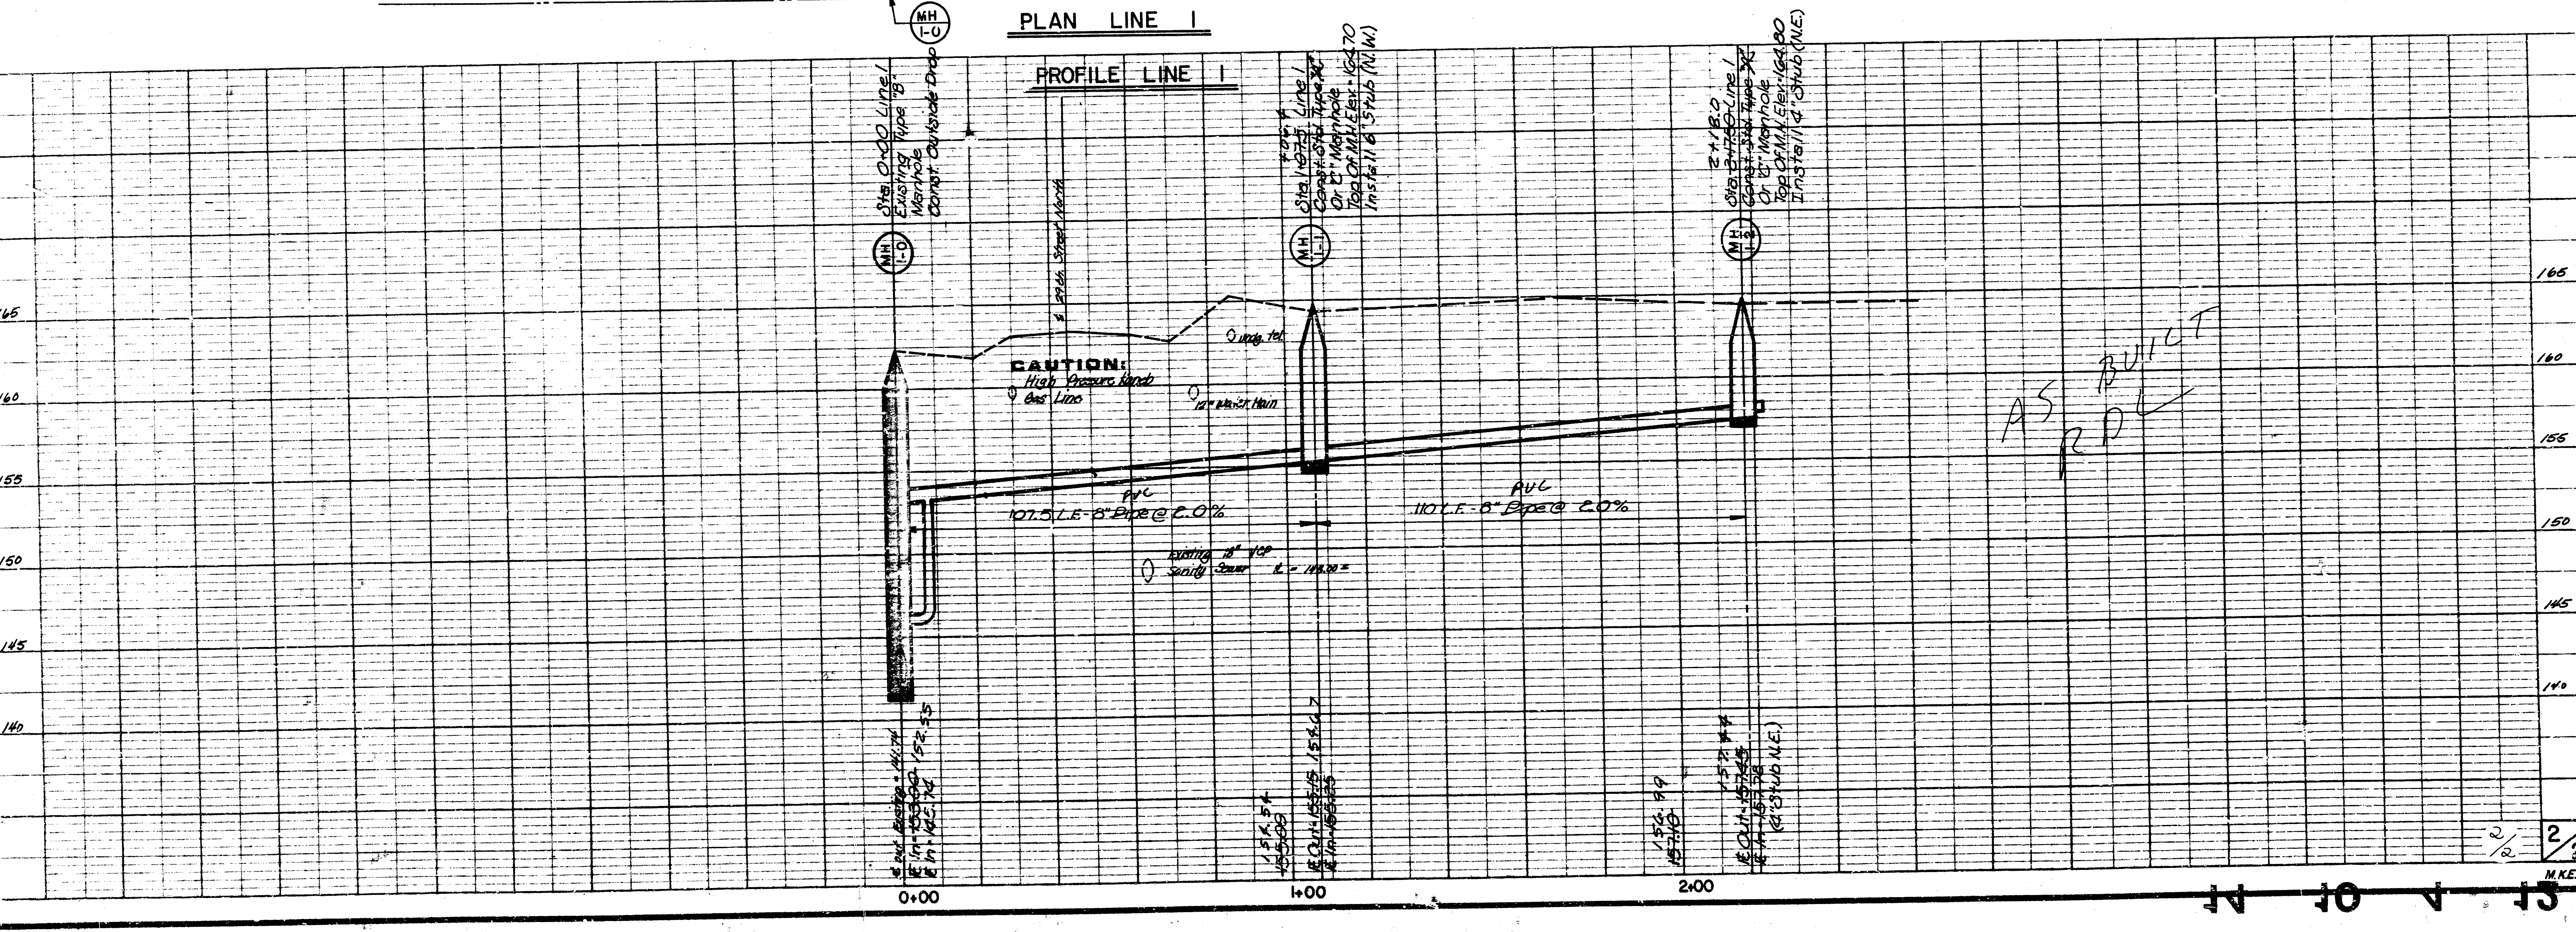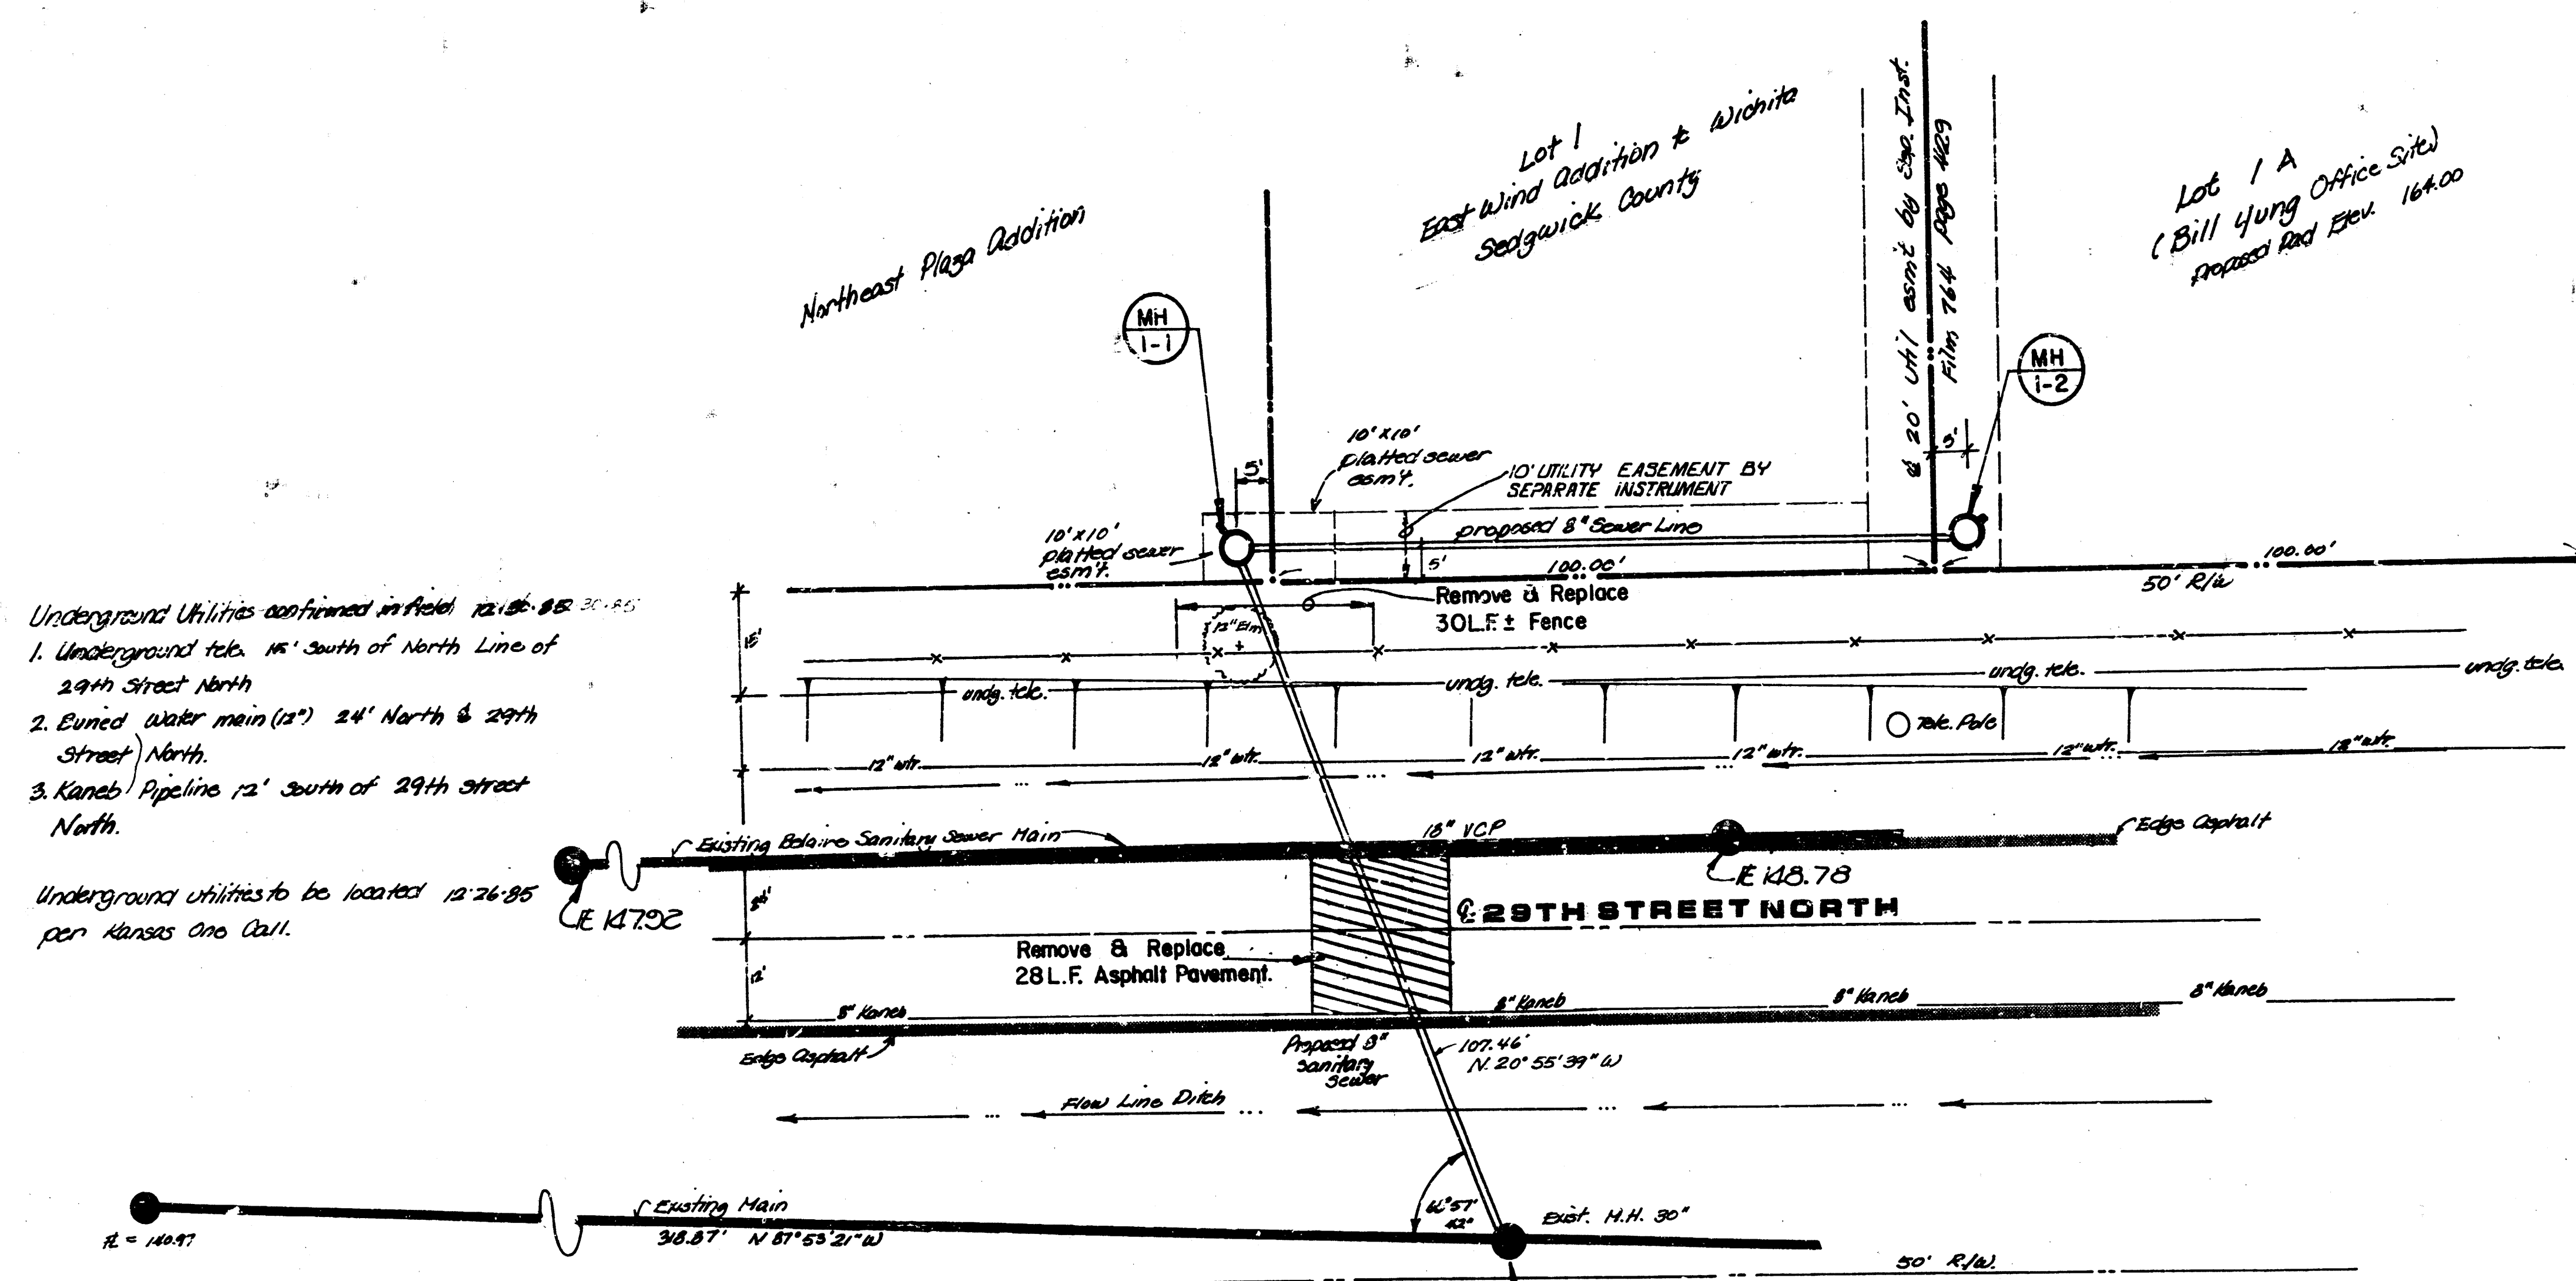

AS BUILT
R.D.C.