

LATERAL 52, SANITARY SEWER NO. 23

CITY OF WICHITA


M.E. LINDEBAK, CITY ENGINEER

PROJECT NO. 468-76-245-81313-000-000-001

DATE: OCTOBER 1983


TABLE OF CONTENTS

TITLE SHEET	-----	SHEET 1
LINE NO. 1	-----	SHEET 2
LINE NO. 2	-----	SHEET 3
LINE NO. 3	-----	SHEET 3
RISER DETAIL	-----	SHEET 4

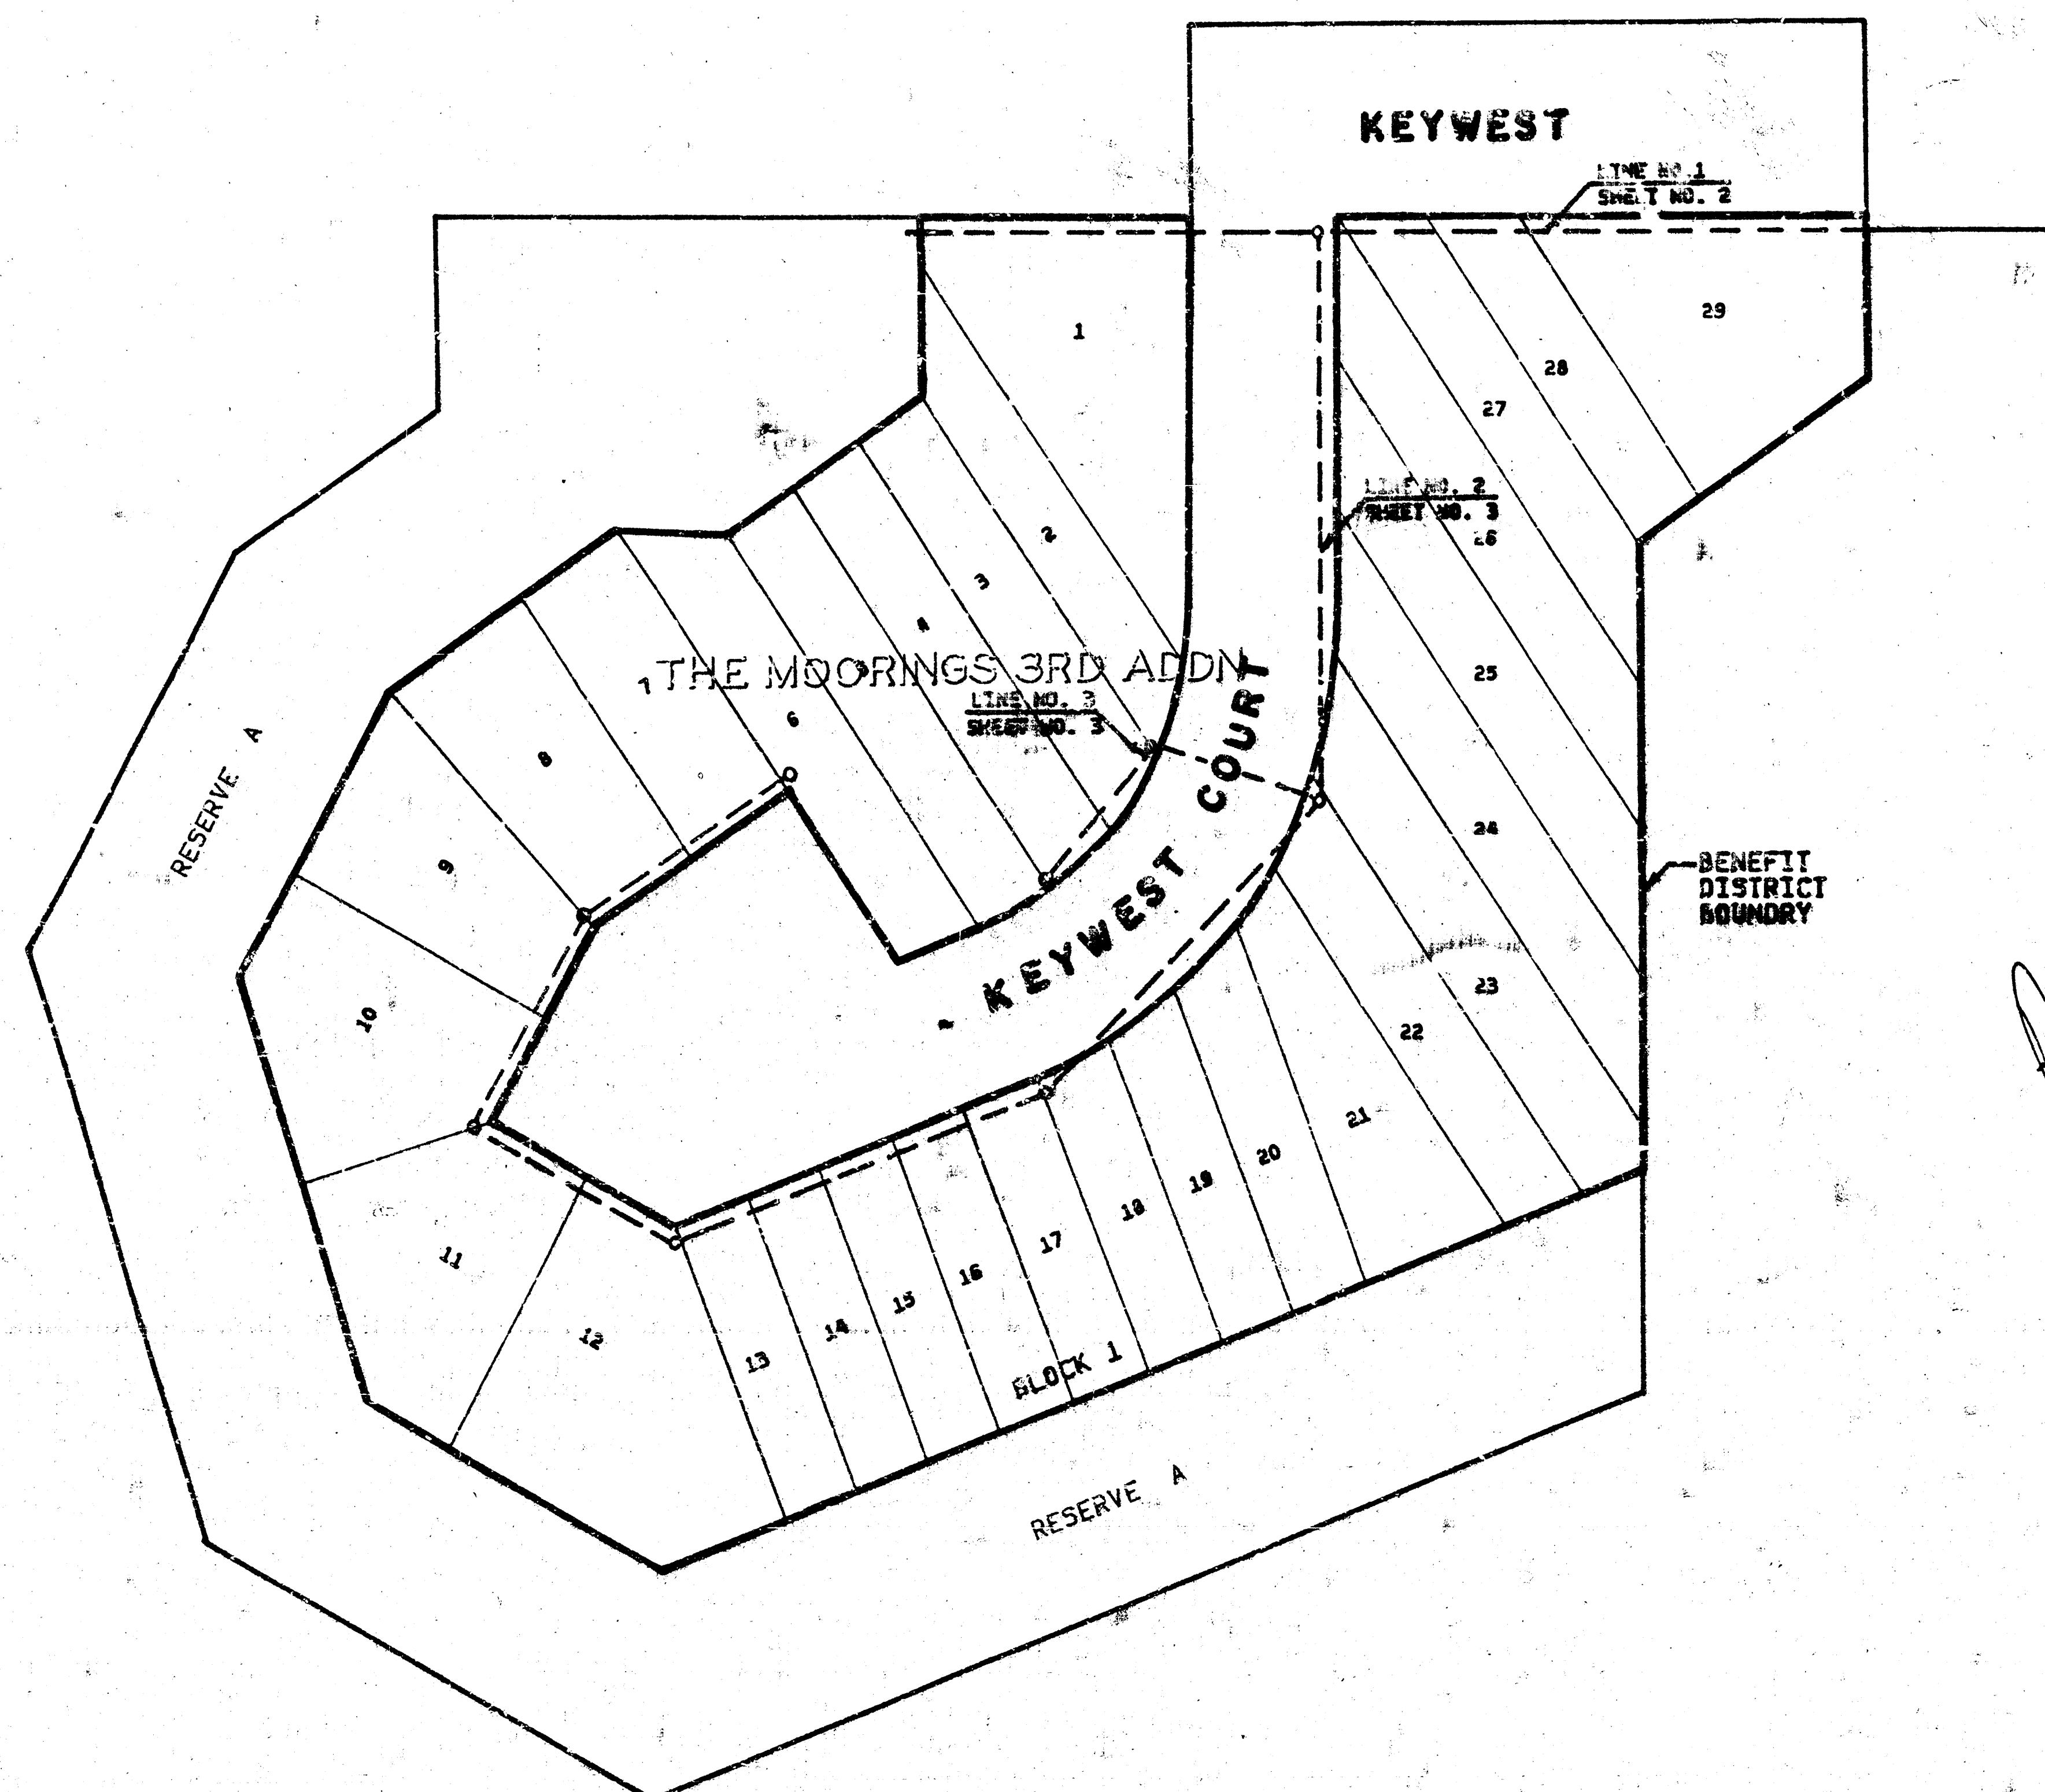

*As Built
9-1-84
JL*

THE CONTRACTOR SHALL BE RESPONSIBLE FOR PRESERVING PROPERTY IRMS. THE CONTRACTOR SHALL BE REQUIRED TO RE-ESTABLISH ANY PROPERTY IRMS WHICH ARE DAMAGED OR DESTROYED BY HIS CONSTRUCTION OPERATIONS. SUCH IRMS SHALL BE RE-ESTABLISHED BY A LICENSED LAND SURVEYOR OR A LICENSED PROFESSIONAL ENGINEER IN ACCORDANCE WITH STATE LAWS.

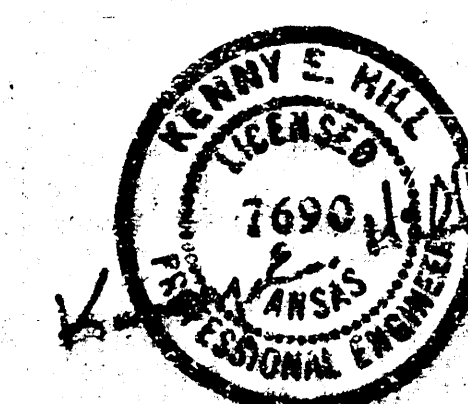


SHEET 1 OF 4

1/4

B.M. # 2 "++ CUT ON N. SIDE OF MANHOLE RING
LOCATED AT 138' EAST OF STA. 0+00
(LINE NO. 1) ELEV. 142.64
(PROJECT DATUM)

PLAN	SURVEYED	BY	DATE
NOTE BOOK	PLOTTED		
NO.	ALIGNMENT CHECKED		
	RT. O. WAY CHECKED		


PROFILE	SURVEYED.....	BY.....	DATE.....
	CLOSED..... CHECKED..... (3) M-3 NOTEC..... STRUCTURE NOTATIONS CHFKD.....		
NOTE BOOK			
NO.....			

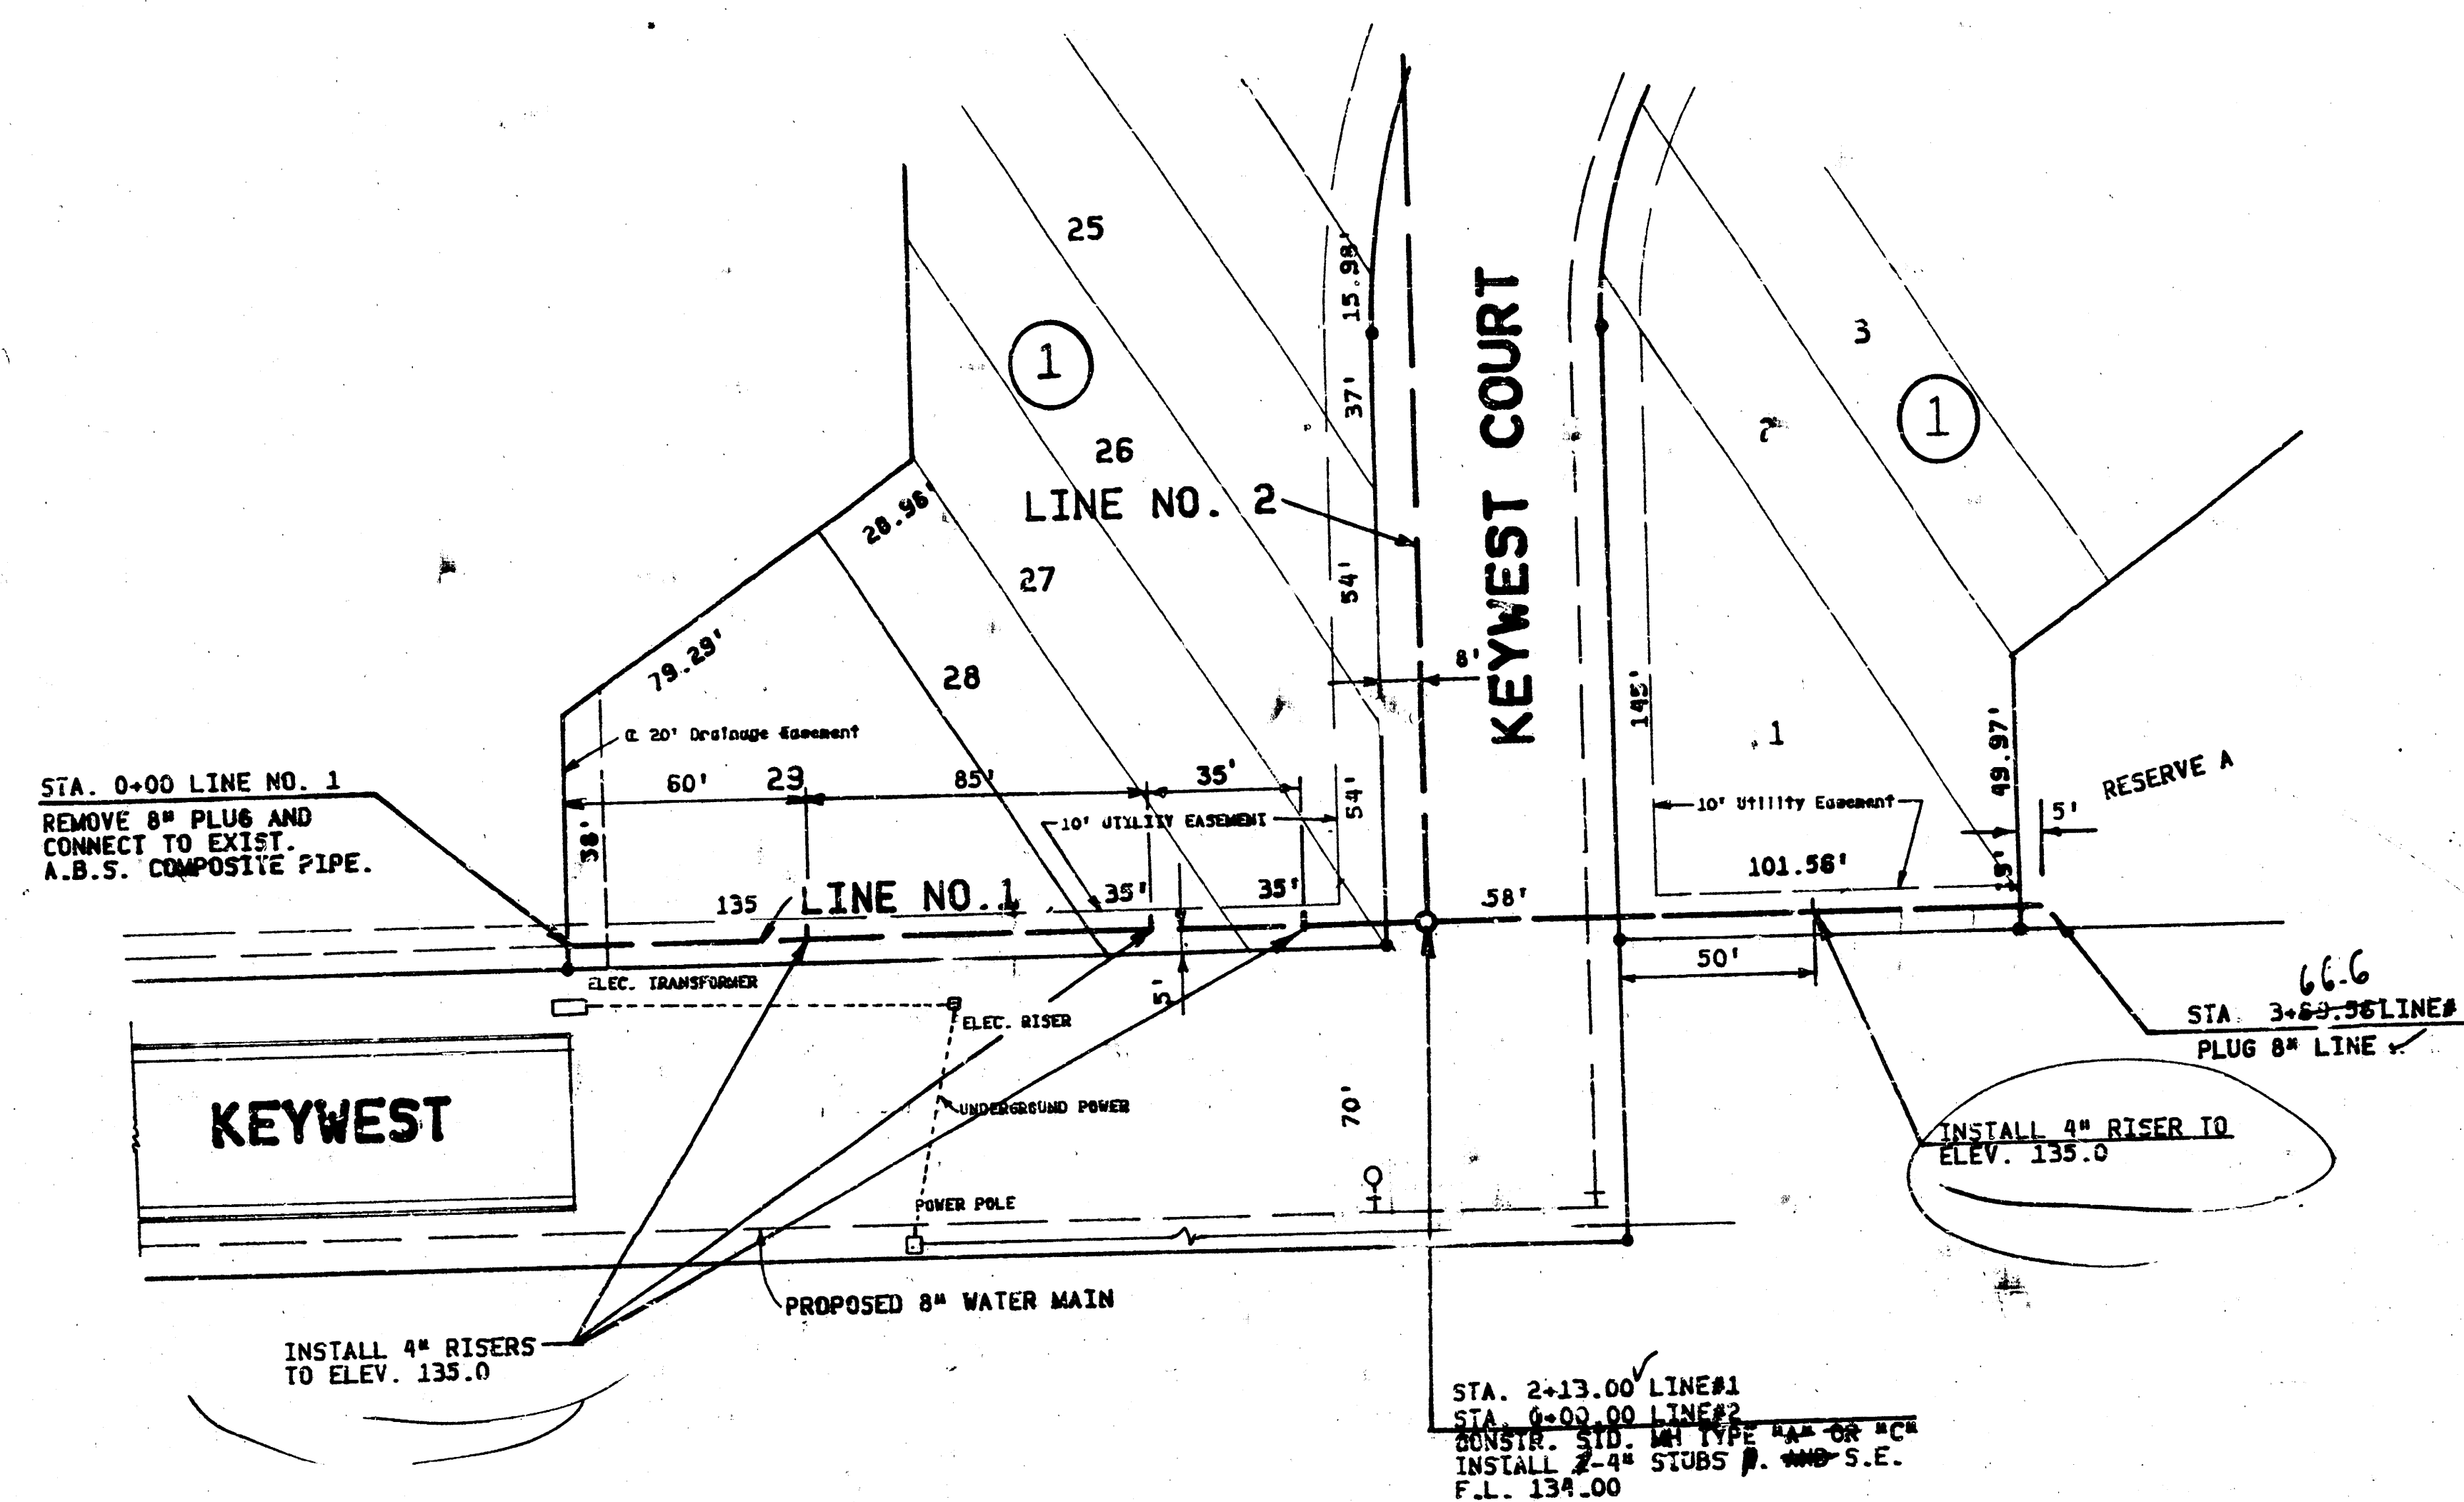

As Built
J.V. 84
3




SCALE:
HORIZ. 1"=40'
VERT. 1"=5'

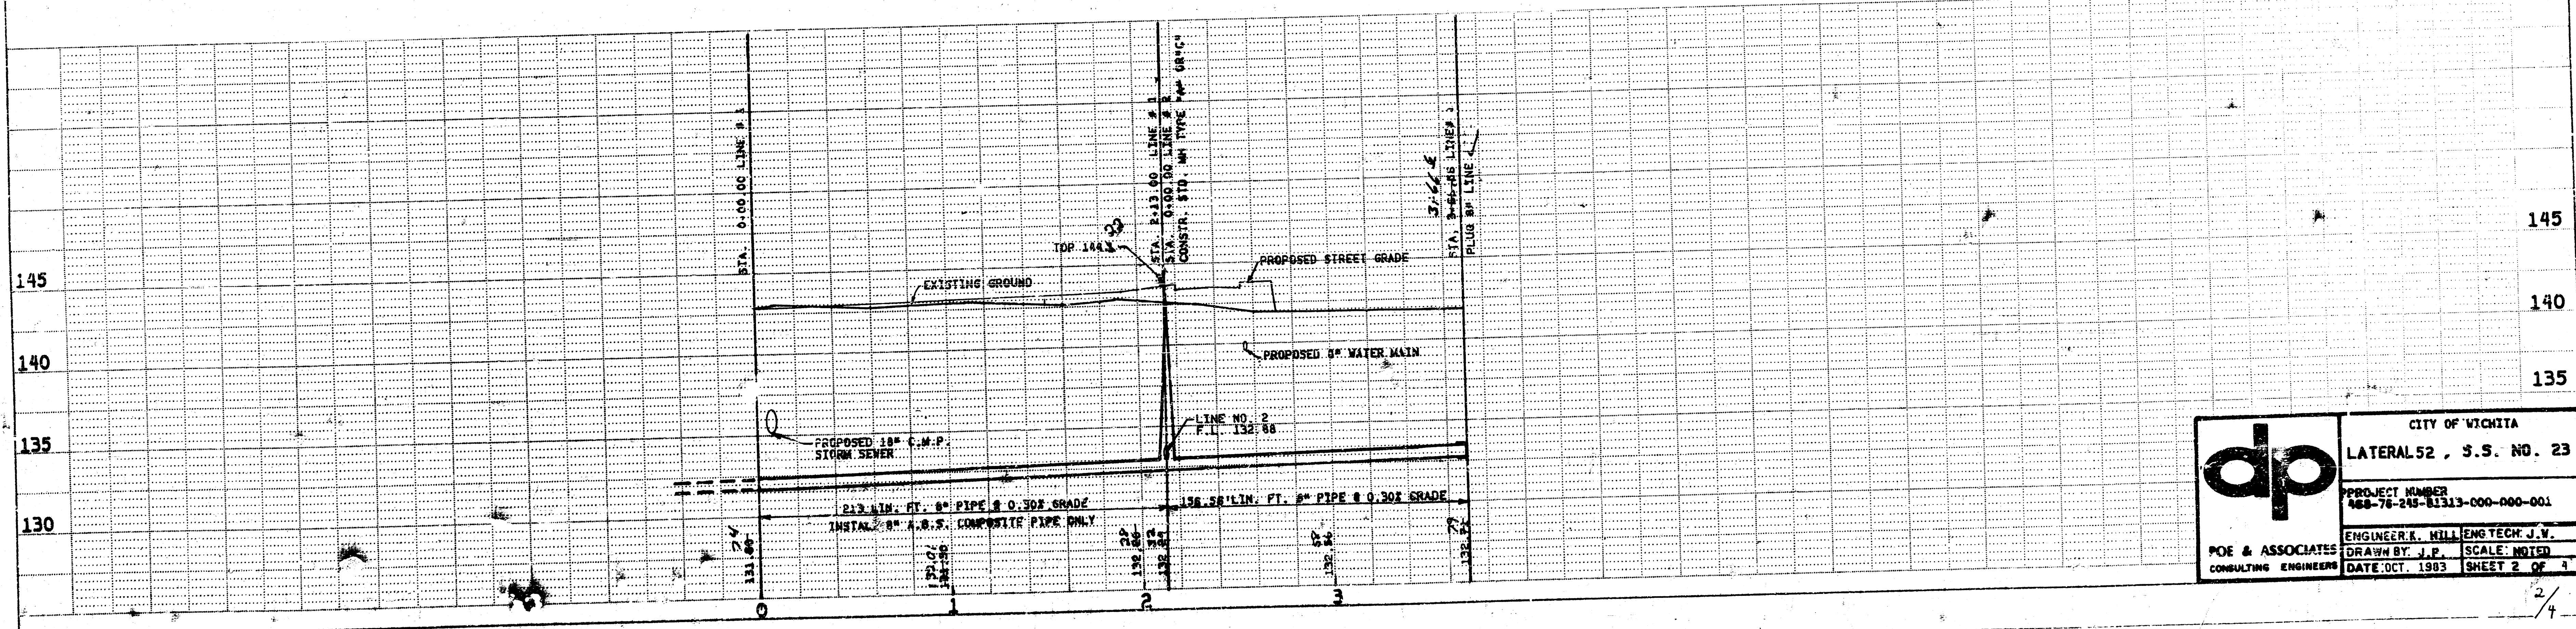


PLAN	DATE
DESIGNED	BY
CHECKED	BY
NOTED	BY
NOTE BOOK	NO.
NO.	

PROFILE	DATE
DESIGNED	BY
CHECKED	BY
NOTED	BY
NOTE BOOK	NO.
NO.	

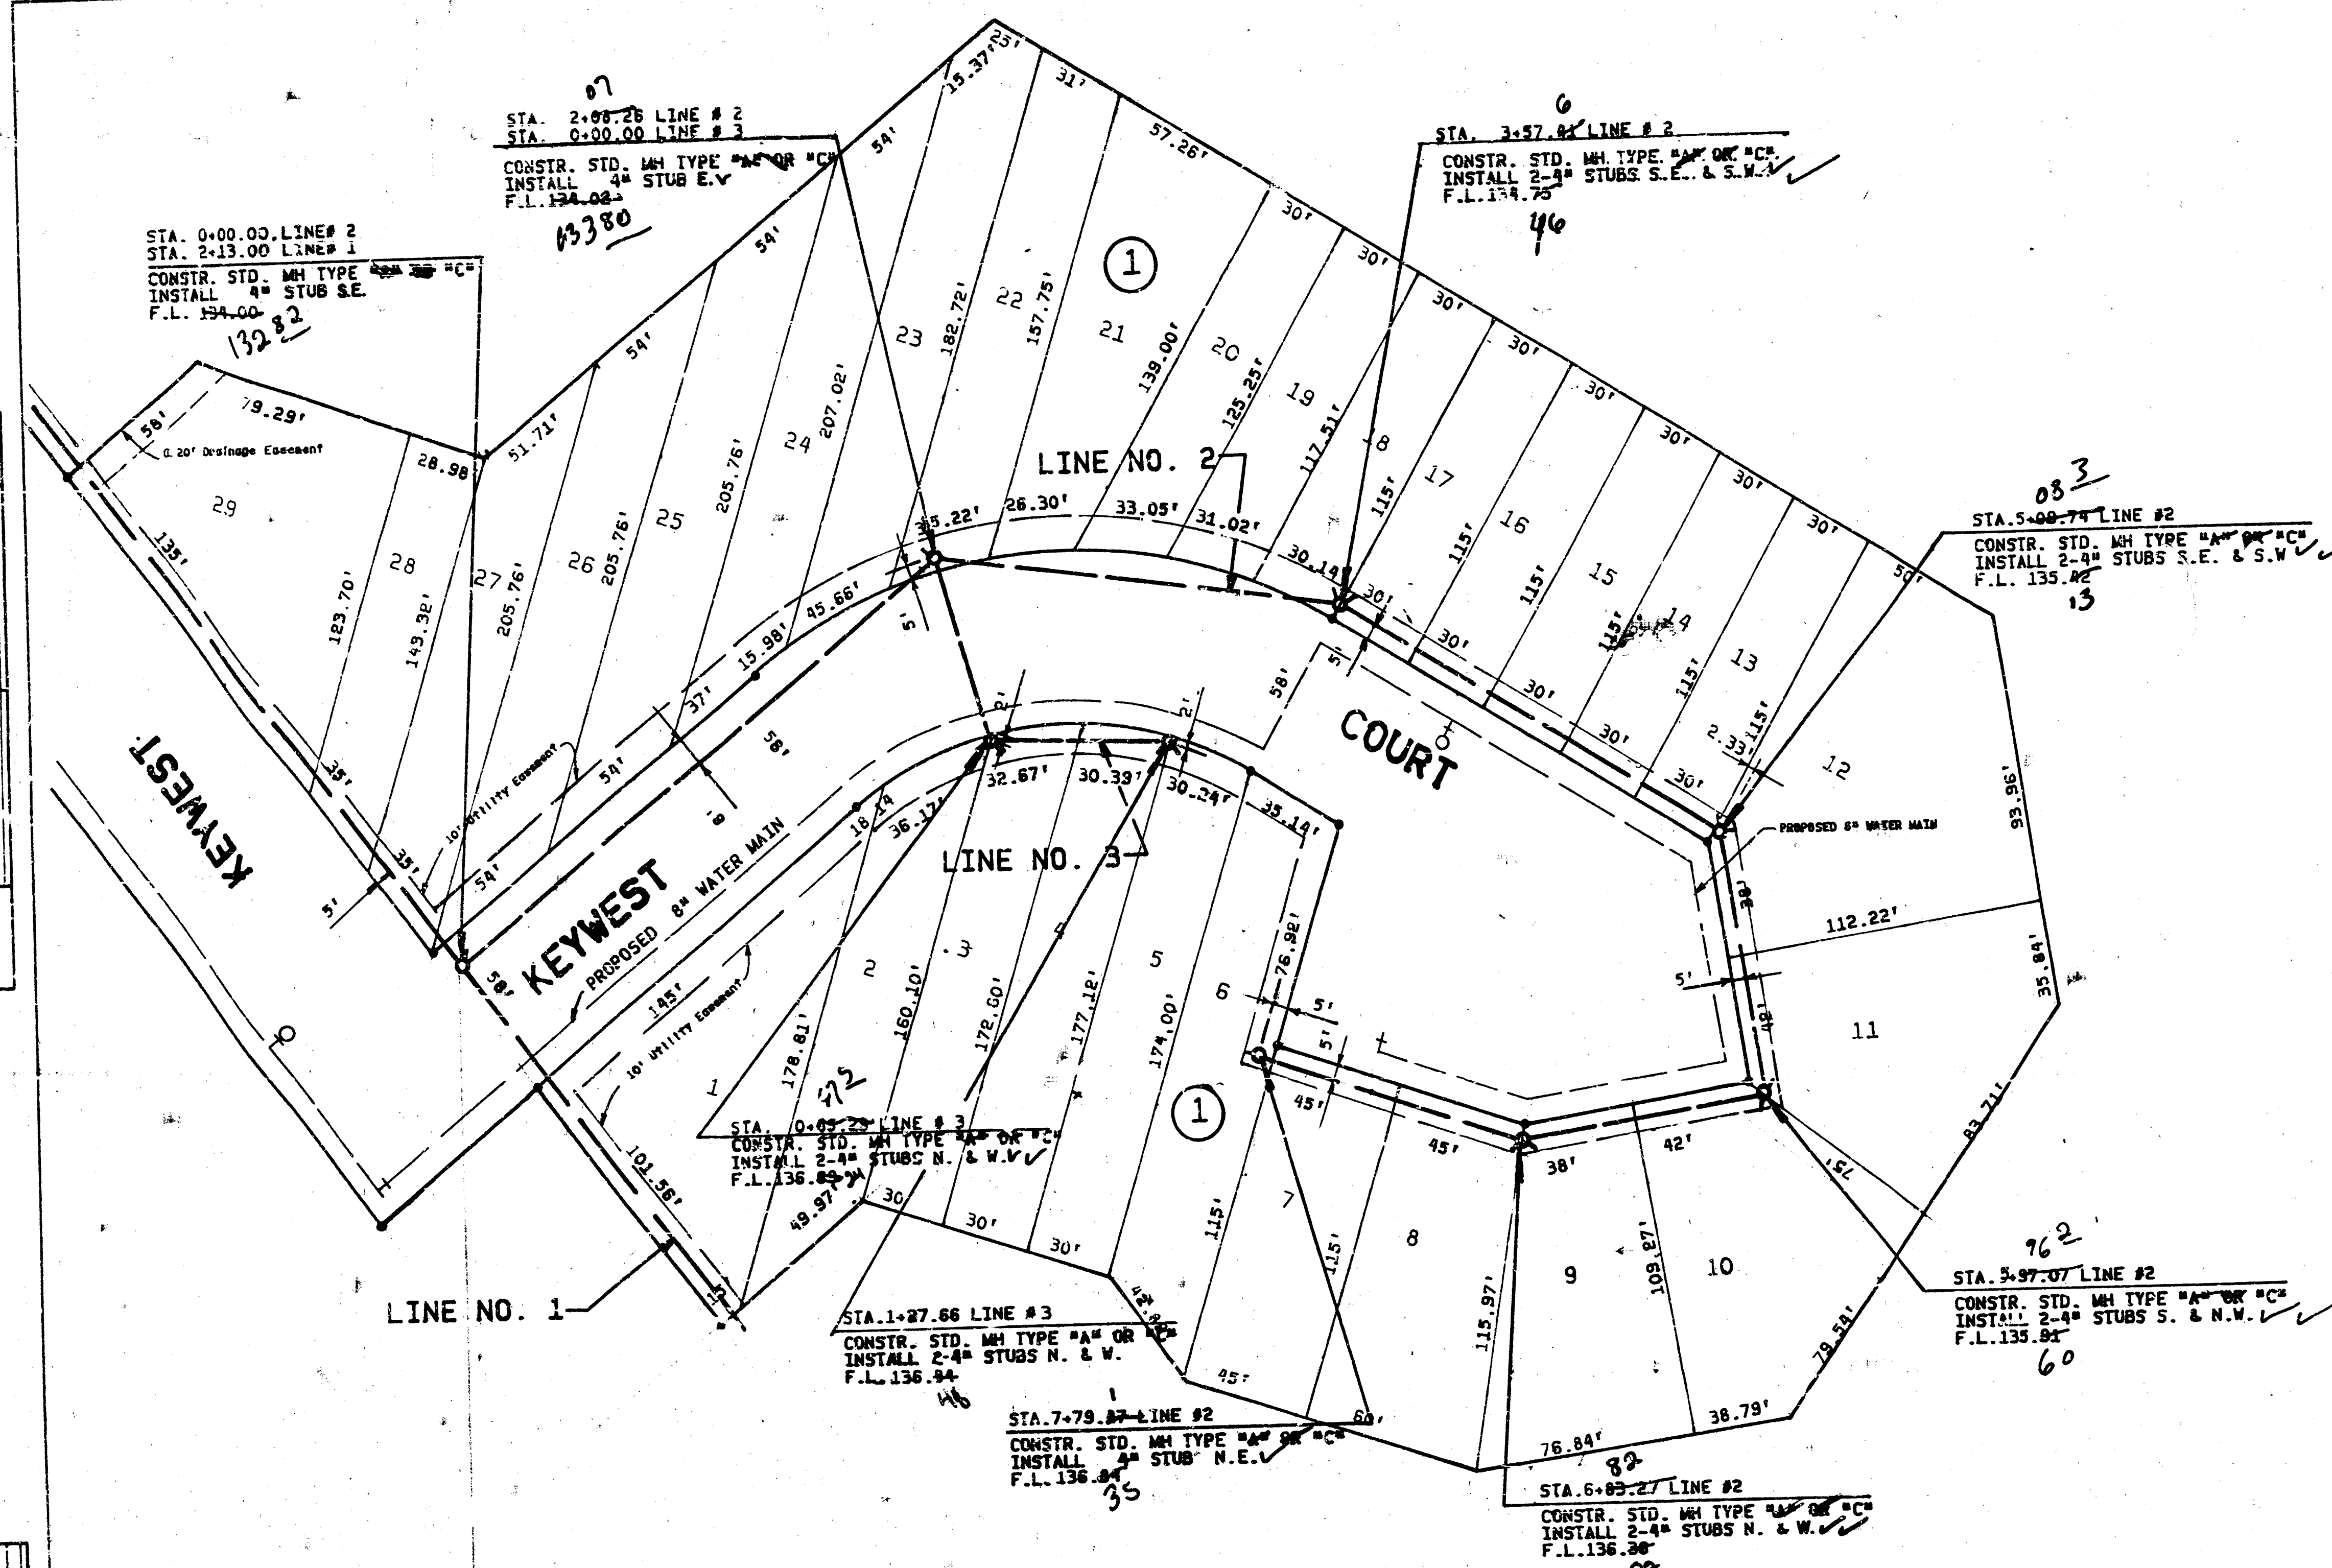

As Built
J.L.L.
3-89

SCALE:
HORIZ. 1"=40'
VERT. 1"=5'

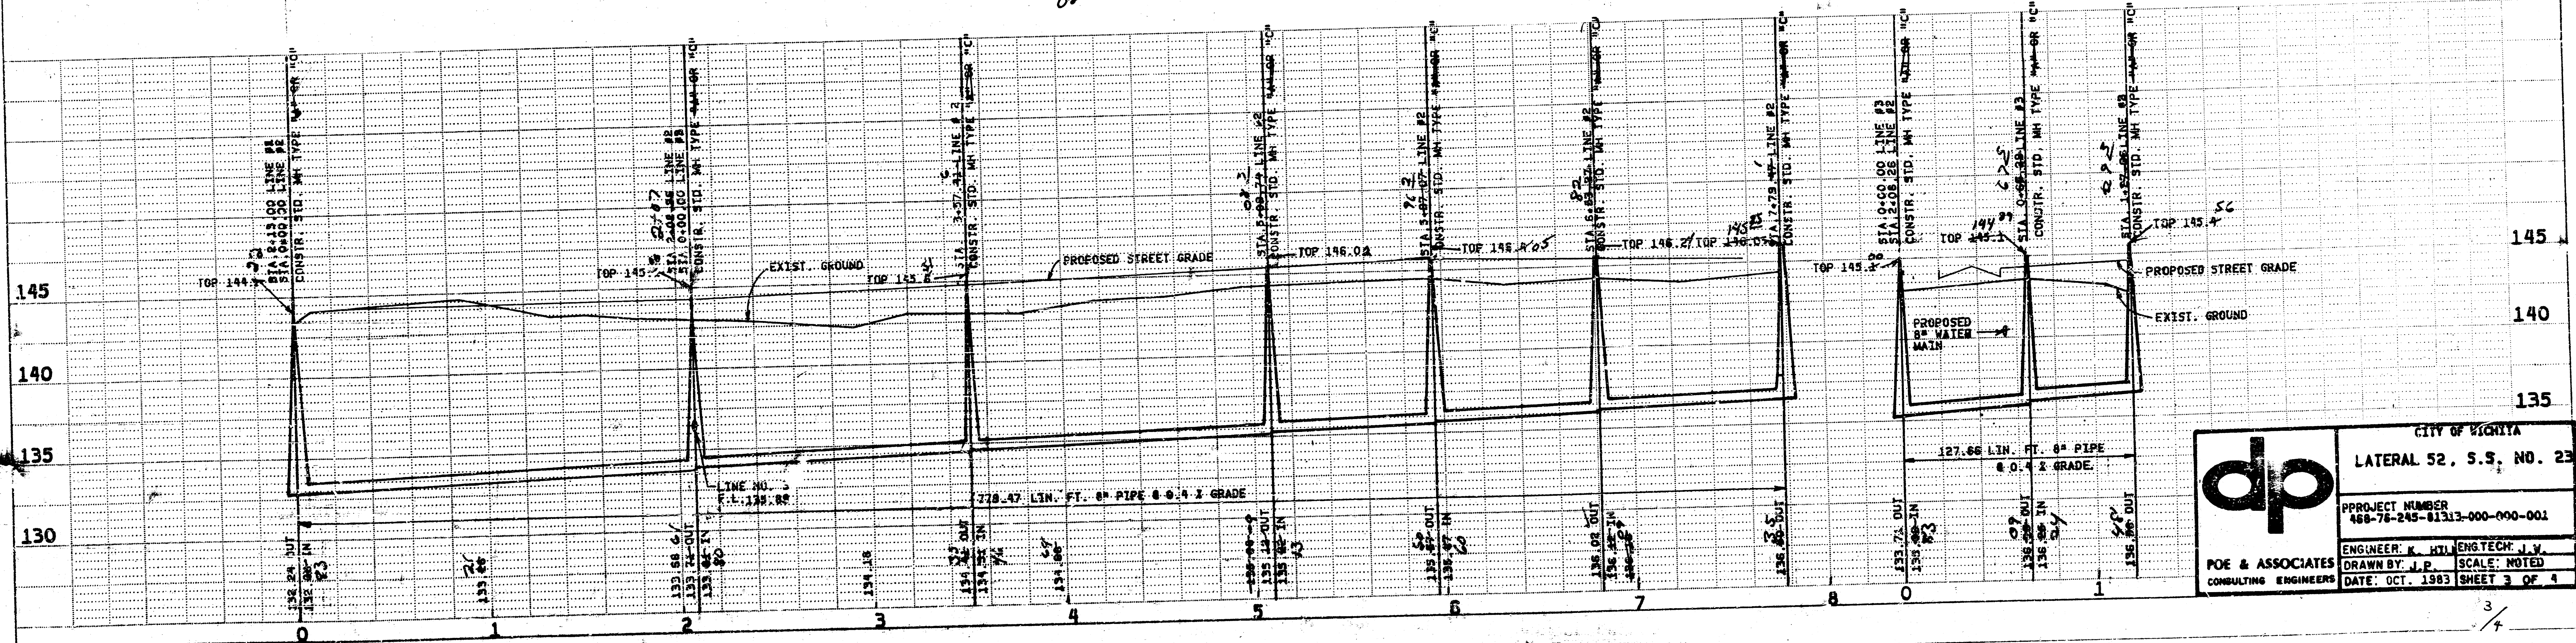

POE & ASSOCIATES
CONSULTING ENGINEERS

CITY OF WICHITA
LATERAL 52, S.S. NO. 23


PROJECT NUMBER
468-76-245-01313-000-001

ENGINEER: K. HIL
DRAWN BY: J.P.
DATE: OCT. 1983

SCALE: NOTED
SHEET 3 OF 4


VERTICAL RISER DETAIL ADOPTED AS STANDARD DESIGN BY

CITY OF WICHITA, KANSAS

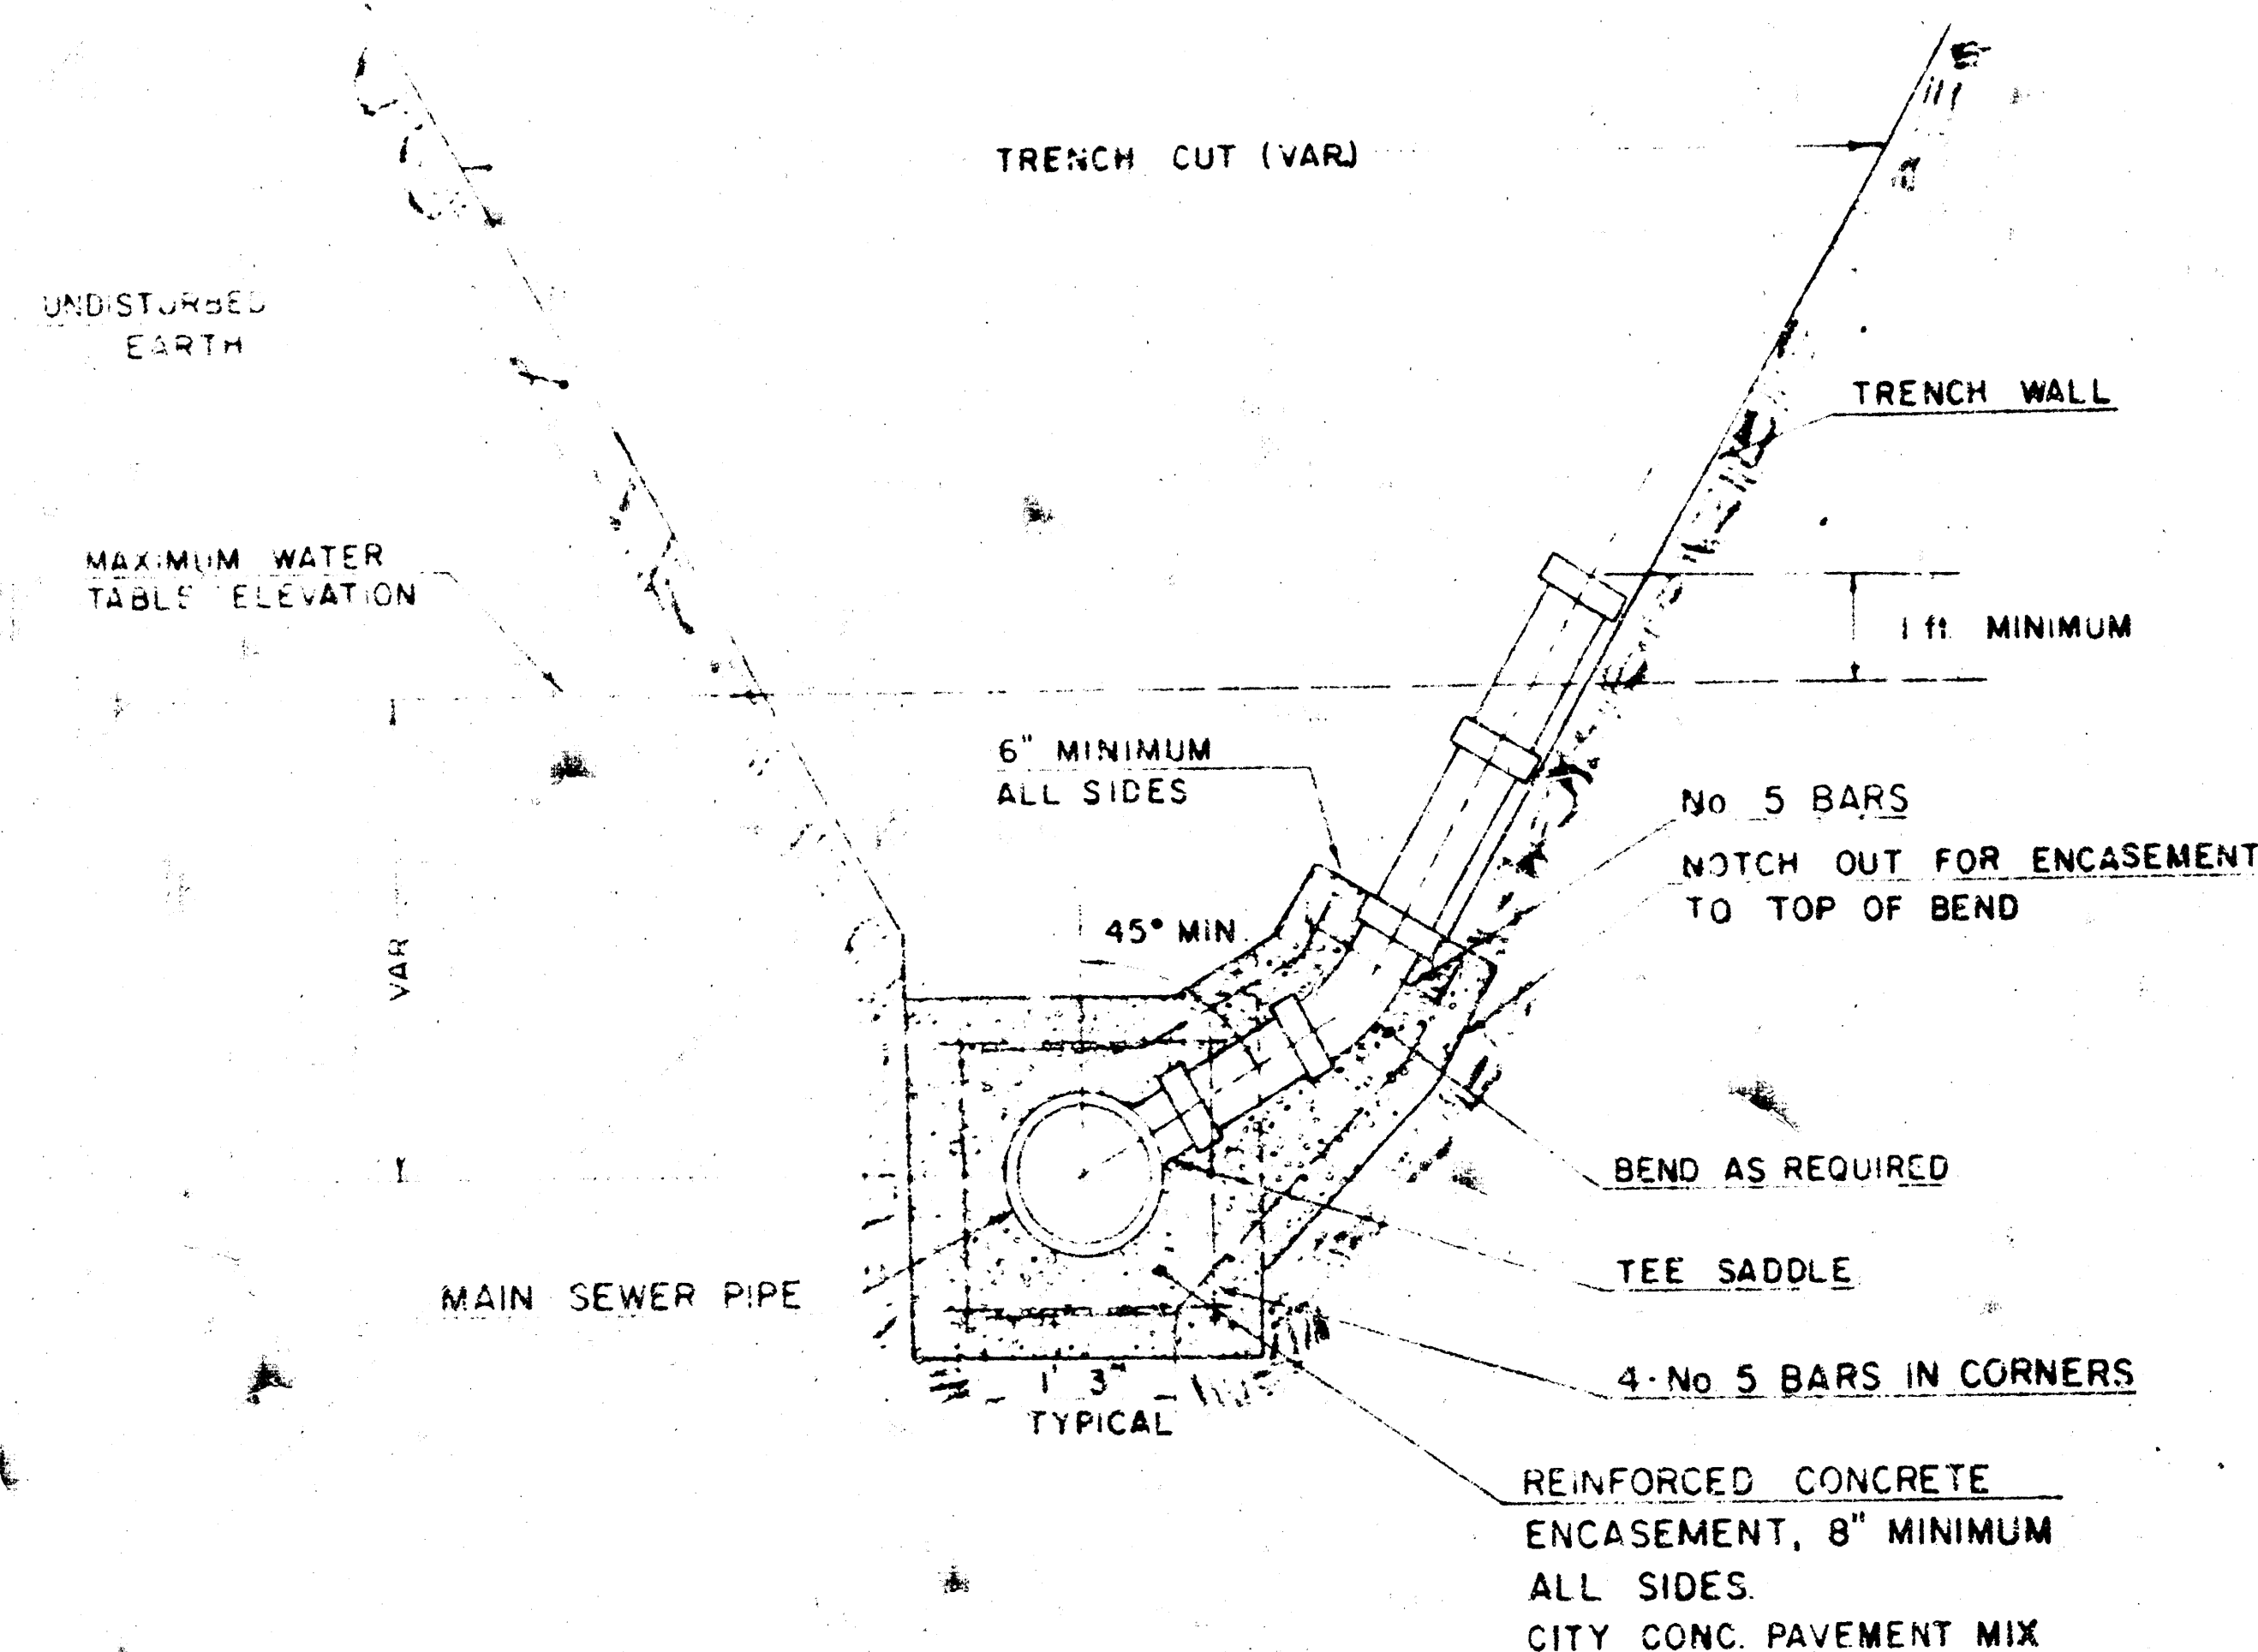


TYPICAL RISER FOR SLOPING TRENCH WALLS

NOTE:
TOP OF 4\"/>

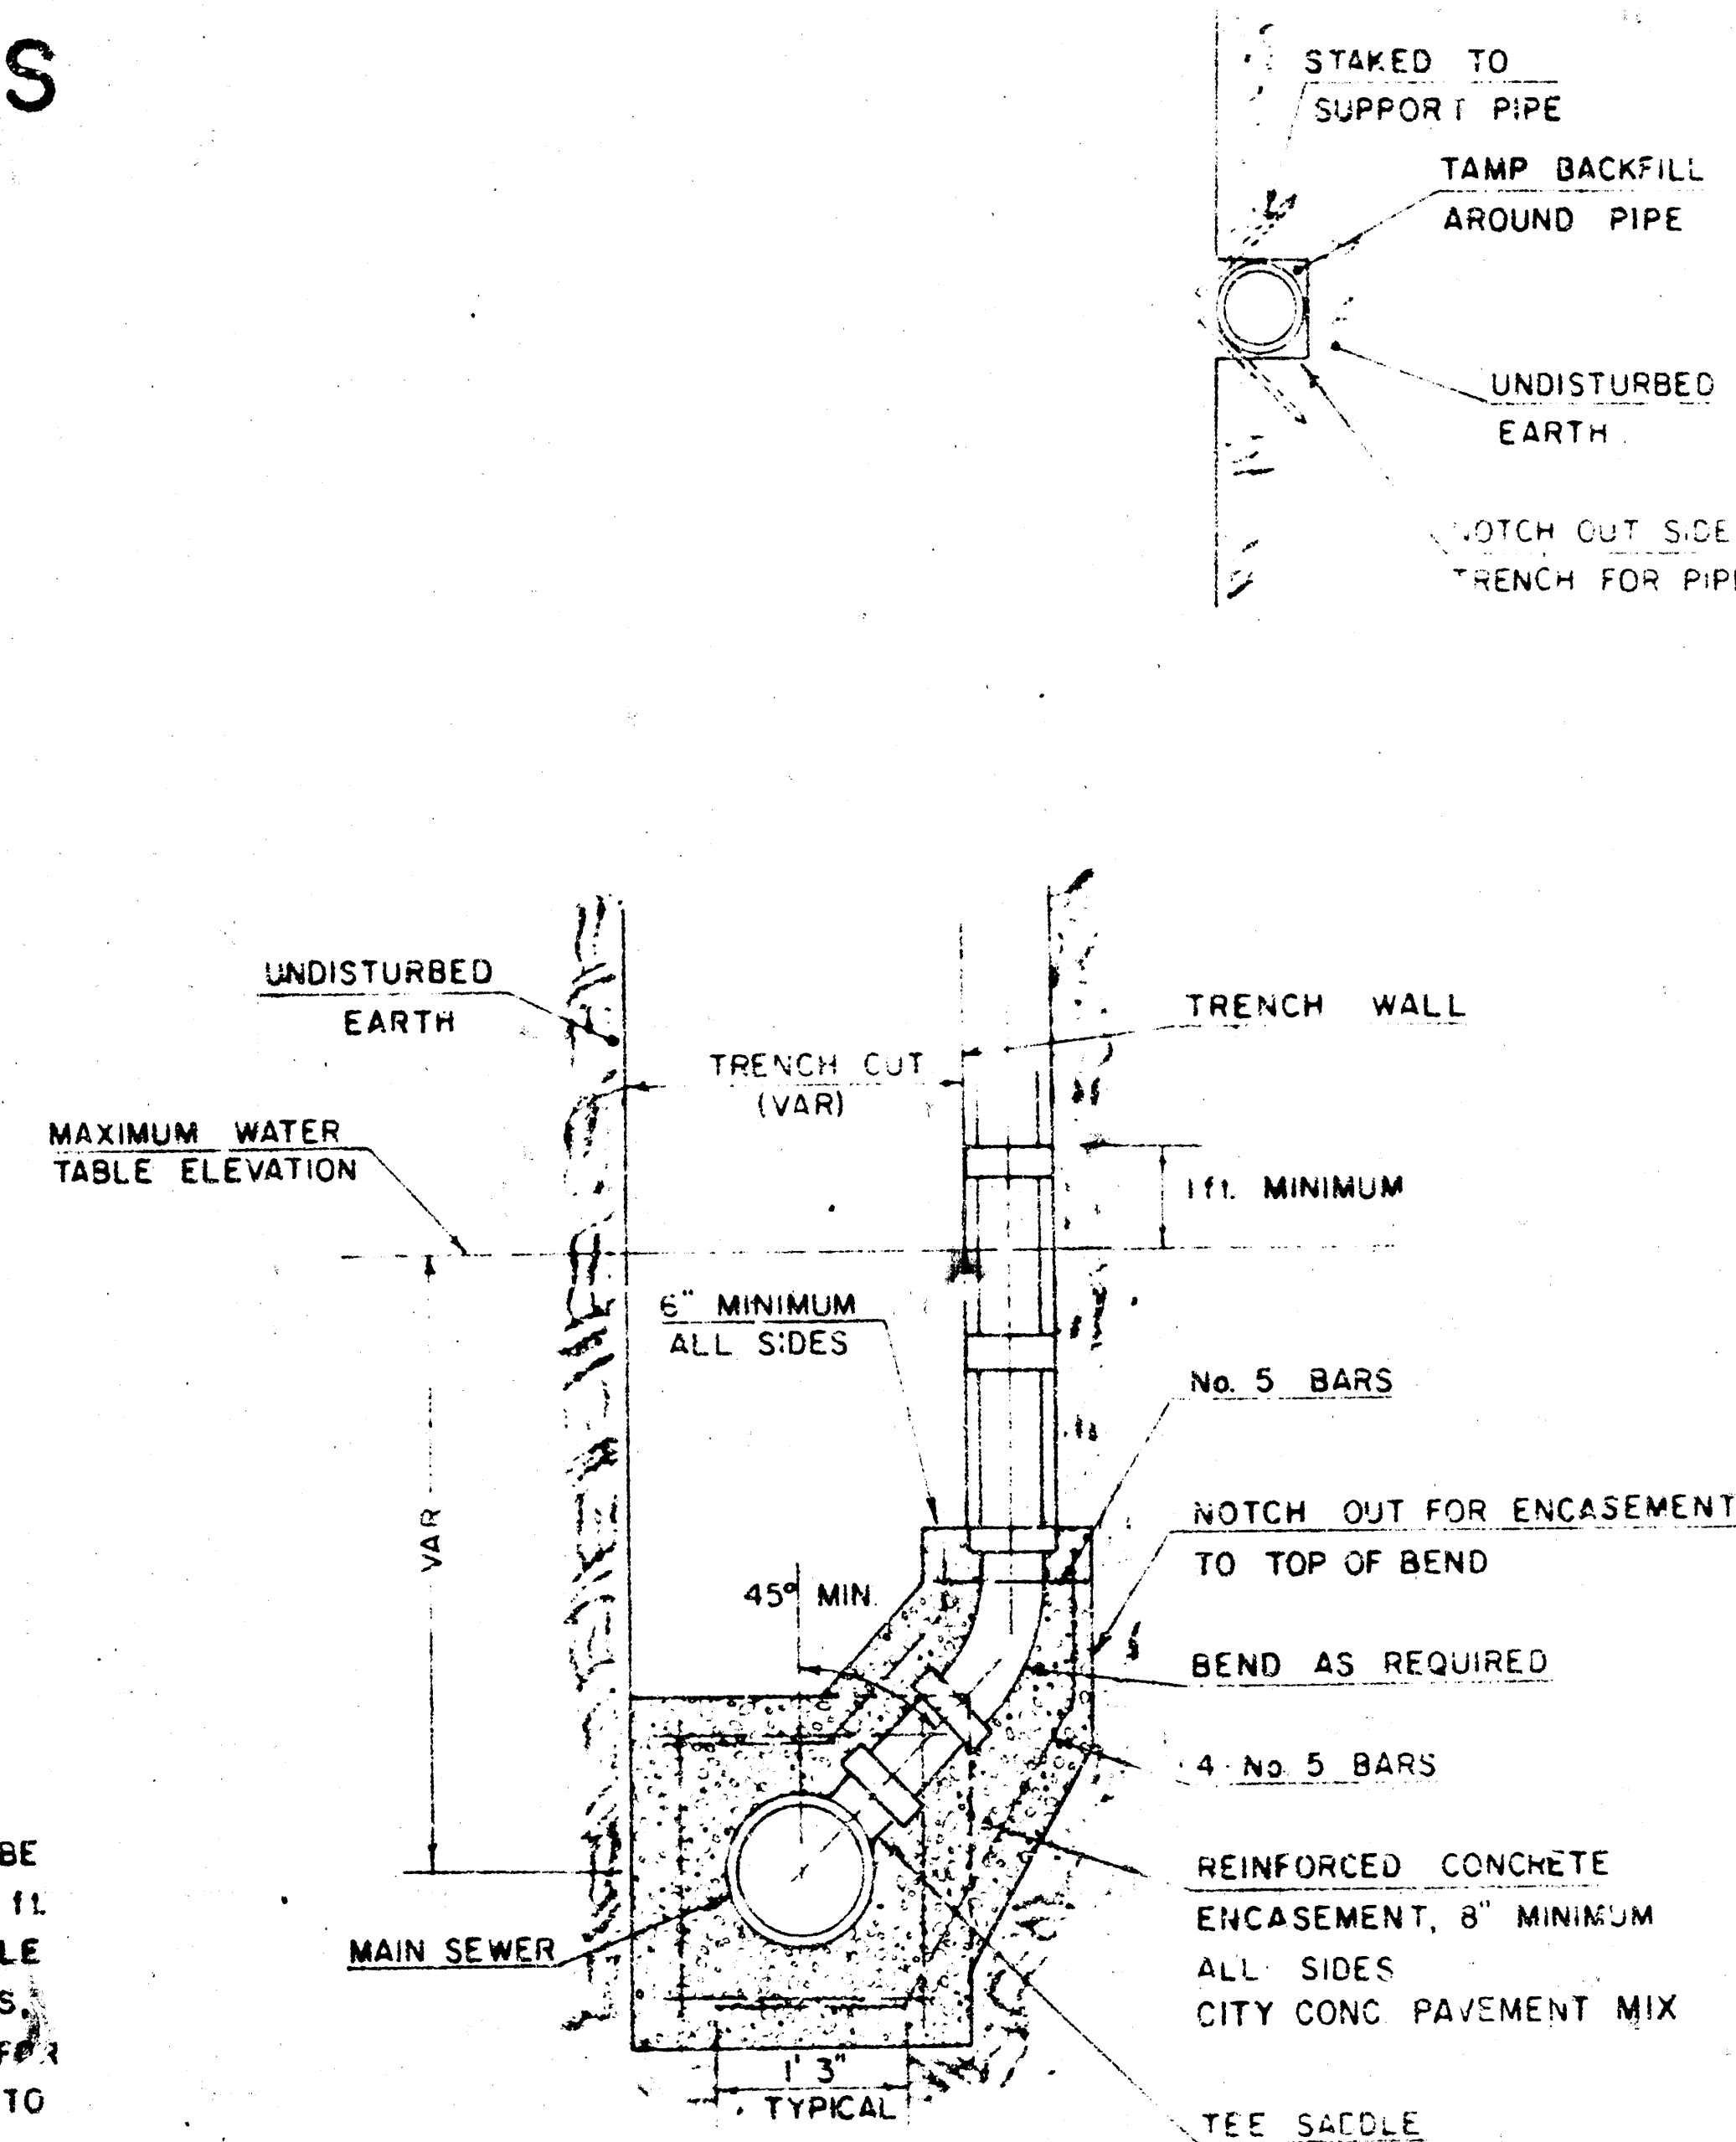

TYPICAL RISER FOR VERTICAL TRENCH WALLS

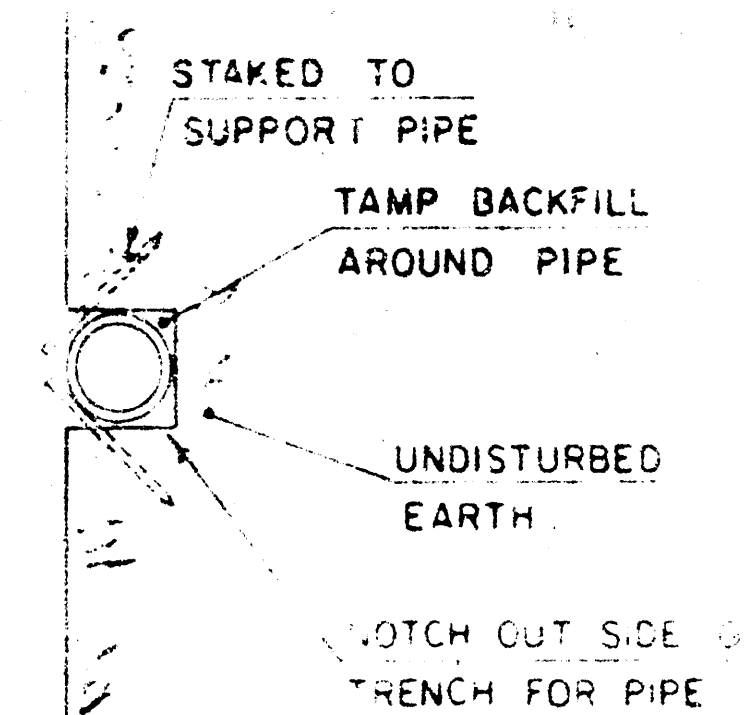

THIS DETAIL IS A STANDARD DESIGN FOR THE CITY OF WICHITA, KANSAS. IT IS INTENDED TO BE USED AS A GUIDE FOR THE INSTALLATION OF VERTICAL RISERS IN TRENCHES. THE DETAIL SHOWS A CROSS-SECTION OF A TRENCH WITH A VERTICAL RISER PIPE. THE RISER PIPE IS TO BE EXTENDED TO AN ELEVATION OF 1 FT. MINIMUM ABOVE THE WATER TABLE ELEVATION, WHEN WATER EXISTS, OR TO AN ELEVATION SUITABLE FOR PROVIDING SERVICE TO THE LOT TO BE SERVED AND THEN PLUGGED. THE RISER PIPE IS TO BE ENCASED IN A REINFORCED CONCRETE ENCASUREMENT, 8\"/>

THE DETAIL IS A STANDARD DESIGN FOR THE CITY OF WICHITA, KANSAS. IT IS INTENDED TO BE USED AS A GUIDE FOR THE INSTALLATION OF VERTICAL RISERS IN TRENCHES. THE DETAIL SHOWS A CROSS-SECTION OF A TRENCH WITH A VERTICAL RISER PIPE. THE RISER PIPE IS TO BE EXTENDED TO AN ELEVATION OF 1 FT. MINIMUM ABOVE THE WATER TABLE ELEVATION, WHEN WATER EXISTS, OR TO AN ELEVATION SUITABLE FOR PROVIDING SERVICE TO THE LOT TO BE SERVED AND THEN PLUGGED. THE RISER PIPE IS TO BE ENCASED IN A REINFORCED CONCRETE ENCASUREMENT, 8\"/>

	LATERAL 52 S.S. NO. 23 CITY OF WICHITA, KANSAS
	PROJECT NUMBER 468-78-245-11313-000-000-001
	ENGINEER: F. HILL CHECKED BY: []
	DRAWN BY: [] DATE: OCT. 1983
	SCALE: N/A SHEET 1 OF 1