

NOTE TO CONTRACTOR
INSPECTION AND TESTING FOR THIS PROJECT IS TO BE PROVIDED BY A LICENSED CONSULTING ENGINEERING FIRM UNDER CONTRACT WITH THE OWNER/DEVELOPER. SAID INSPECTION TO BE IN ACCORDANCE WITH THE CITY OF WICHITA STANDARD CONSTRUCTION ENGINEERING PRACTICES AND CERTIFIED BY A LICENSED PROFESSIONAL ENGINEER. NO WORK SHALL BE PERFORMED IN DEDICATED EASEMENTS OR THE PUBLIC RIGHT-OF-WAY BY THE CONTRACTOR WITHOUT SUCH INSPECTION NOR SHALL ANY WORK BE COMMENCED IN DEDICATED EASEMENTS OR PUBLIC RIGHT-OF-WAY WITHOUT WRITTEN AUTHORIZATION BY THE CITY ENGINEER.


NOTE: This project is to be constructed within K-96 Bypass Right-of-Way. The City of Wichita has awarded project to Sherwood Construction in the area, and Sherwood Construction has begun construction activities. ALL WORK WITHIN K-96 BYPASS RIGHT-OF-WAY SHALL BE SCHEDULED WITH SHERWOOD CONSTRUCTION.

APPROVED AS NOTED
By CITY ENGINEER OF WICHITA

PRIVATE PROJECT, PART OF
LATERAL 70, SAN. SEWER 23
STA. 13+35 TO STA. 16+50
PROJ. NO. 249 PPS


Sanitary Sewers VRH 5/8/90
Storm Sewers _____
Driveway Approaches _____
Water Mains _____
Paving _____

Scale: 1" = 40' Horiz.
1" = 5' Vert.

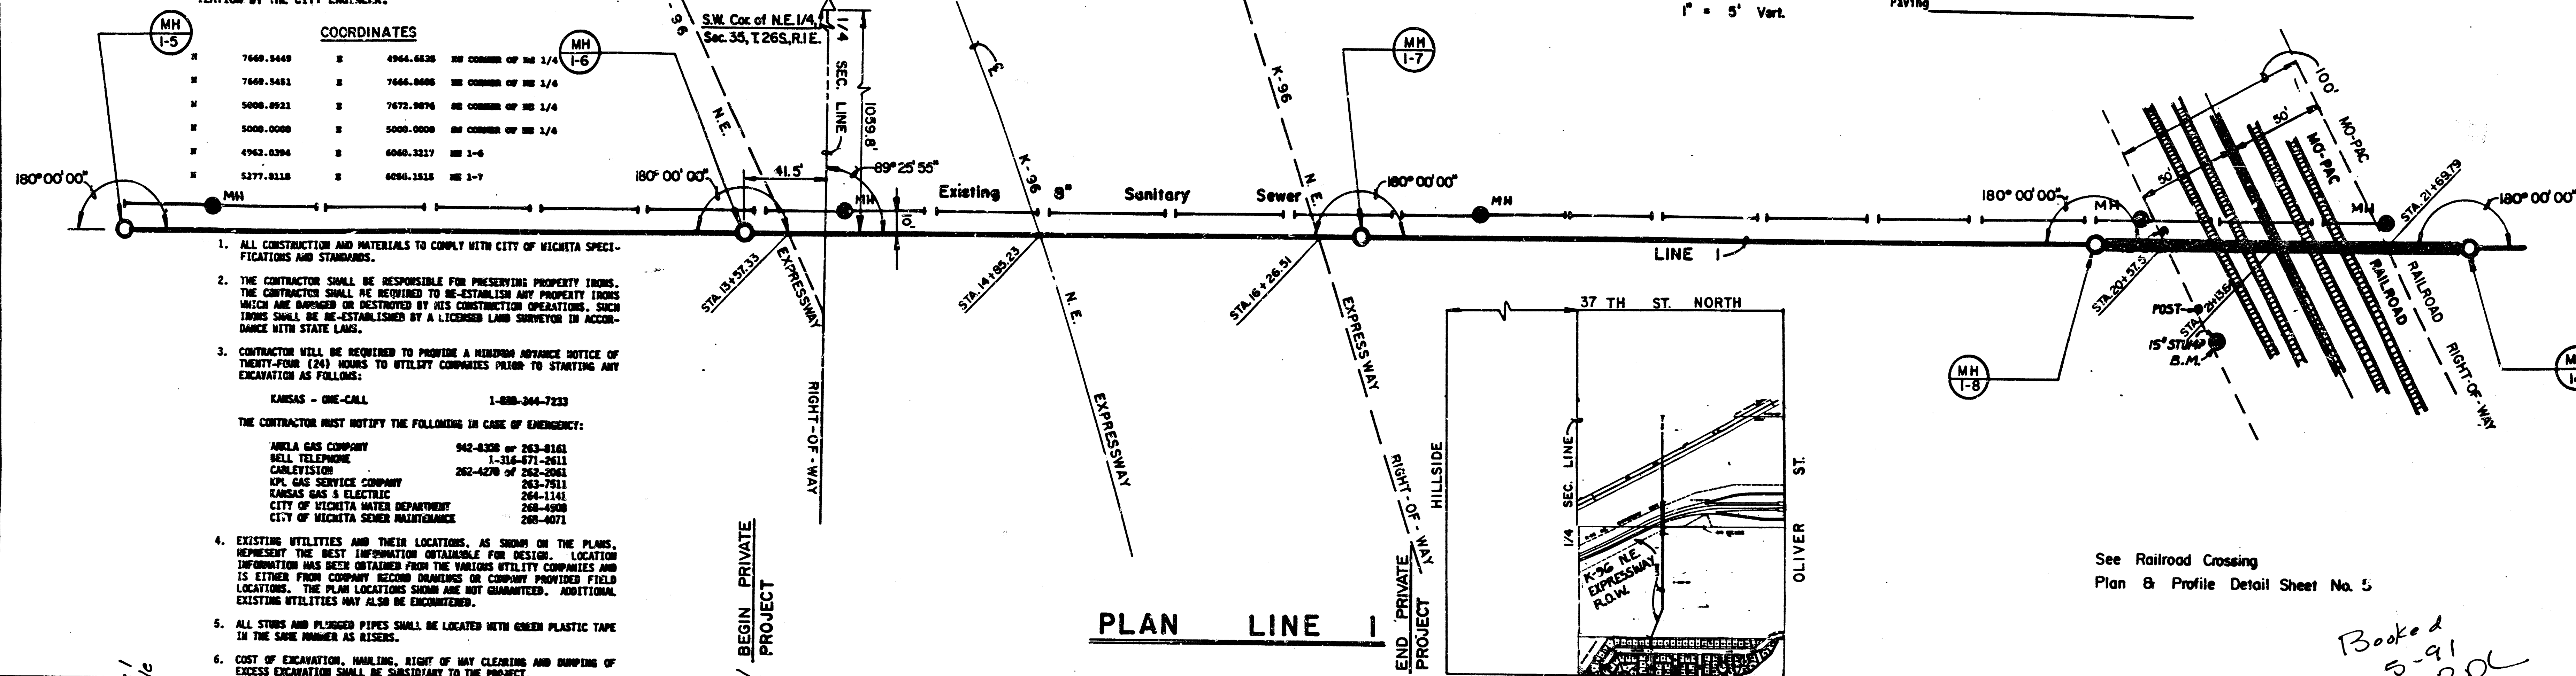

PLAN LINE I

PROFILE LINE I

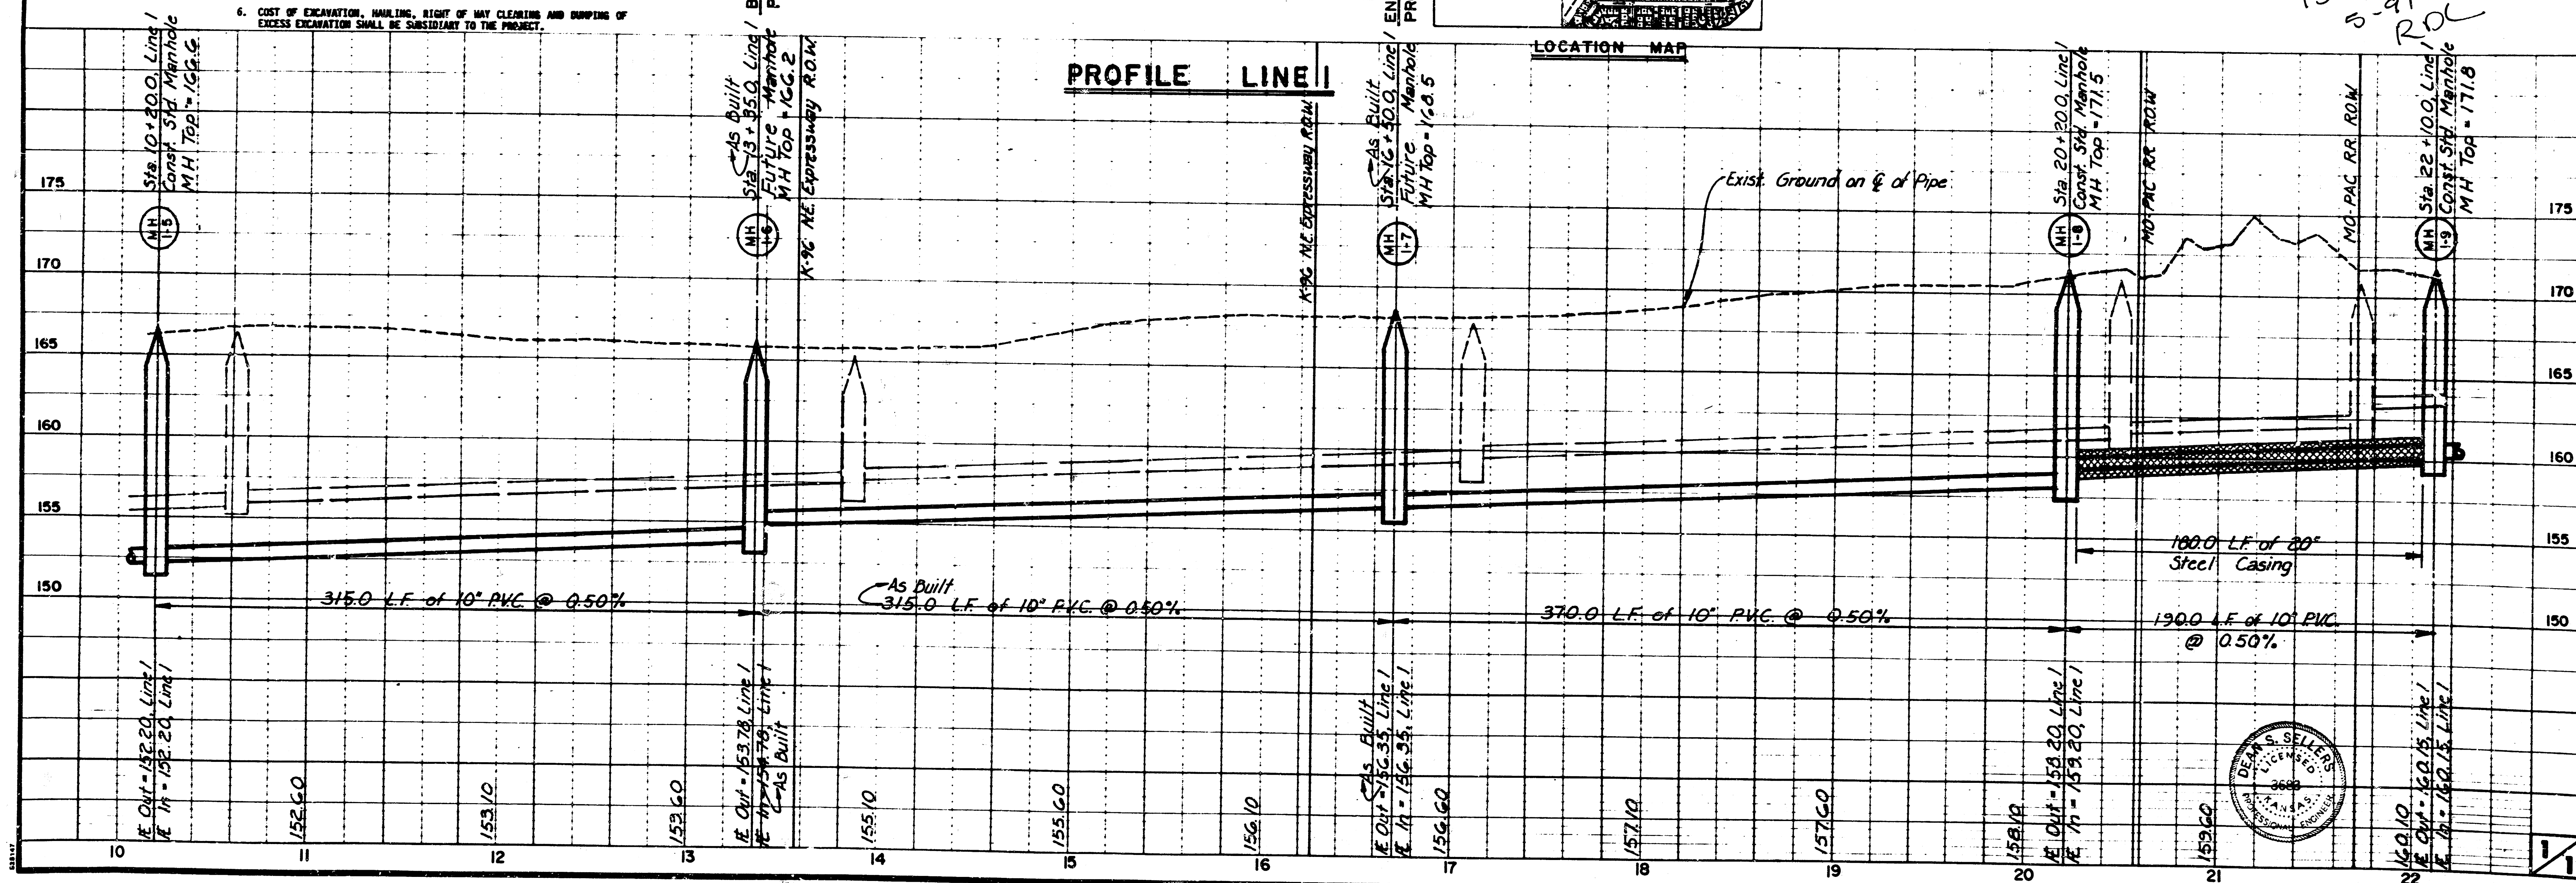

A5 BUILT - AUG. 1990 - KSM

FILMED FROM THE BEST
AVAILABLE COPY