



BN 161.54 NE Cor. Conc. porch House # 4305 E. 27th St. No.
BN 140.23 Ctr. Brick Arc way on conc. wk House # 2900 N. Terrace Dr.

NOTE: THIS PROJECT IS TO BE COORDINATED WITH THE
ADJUSTMENT OF CONTINENTAL PIPELINE.

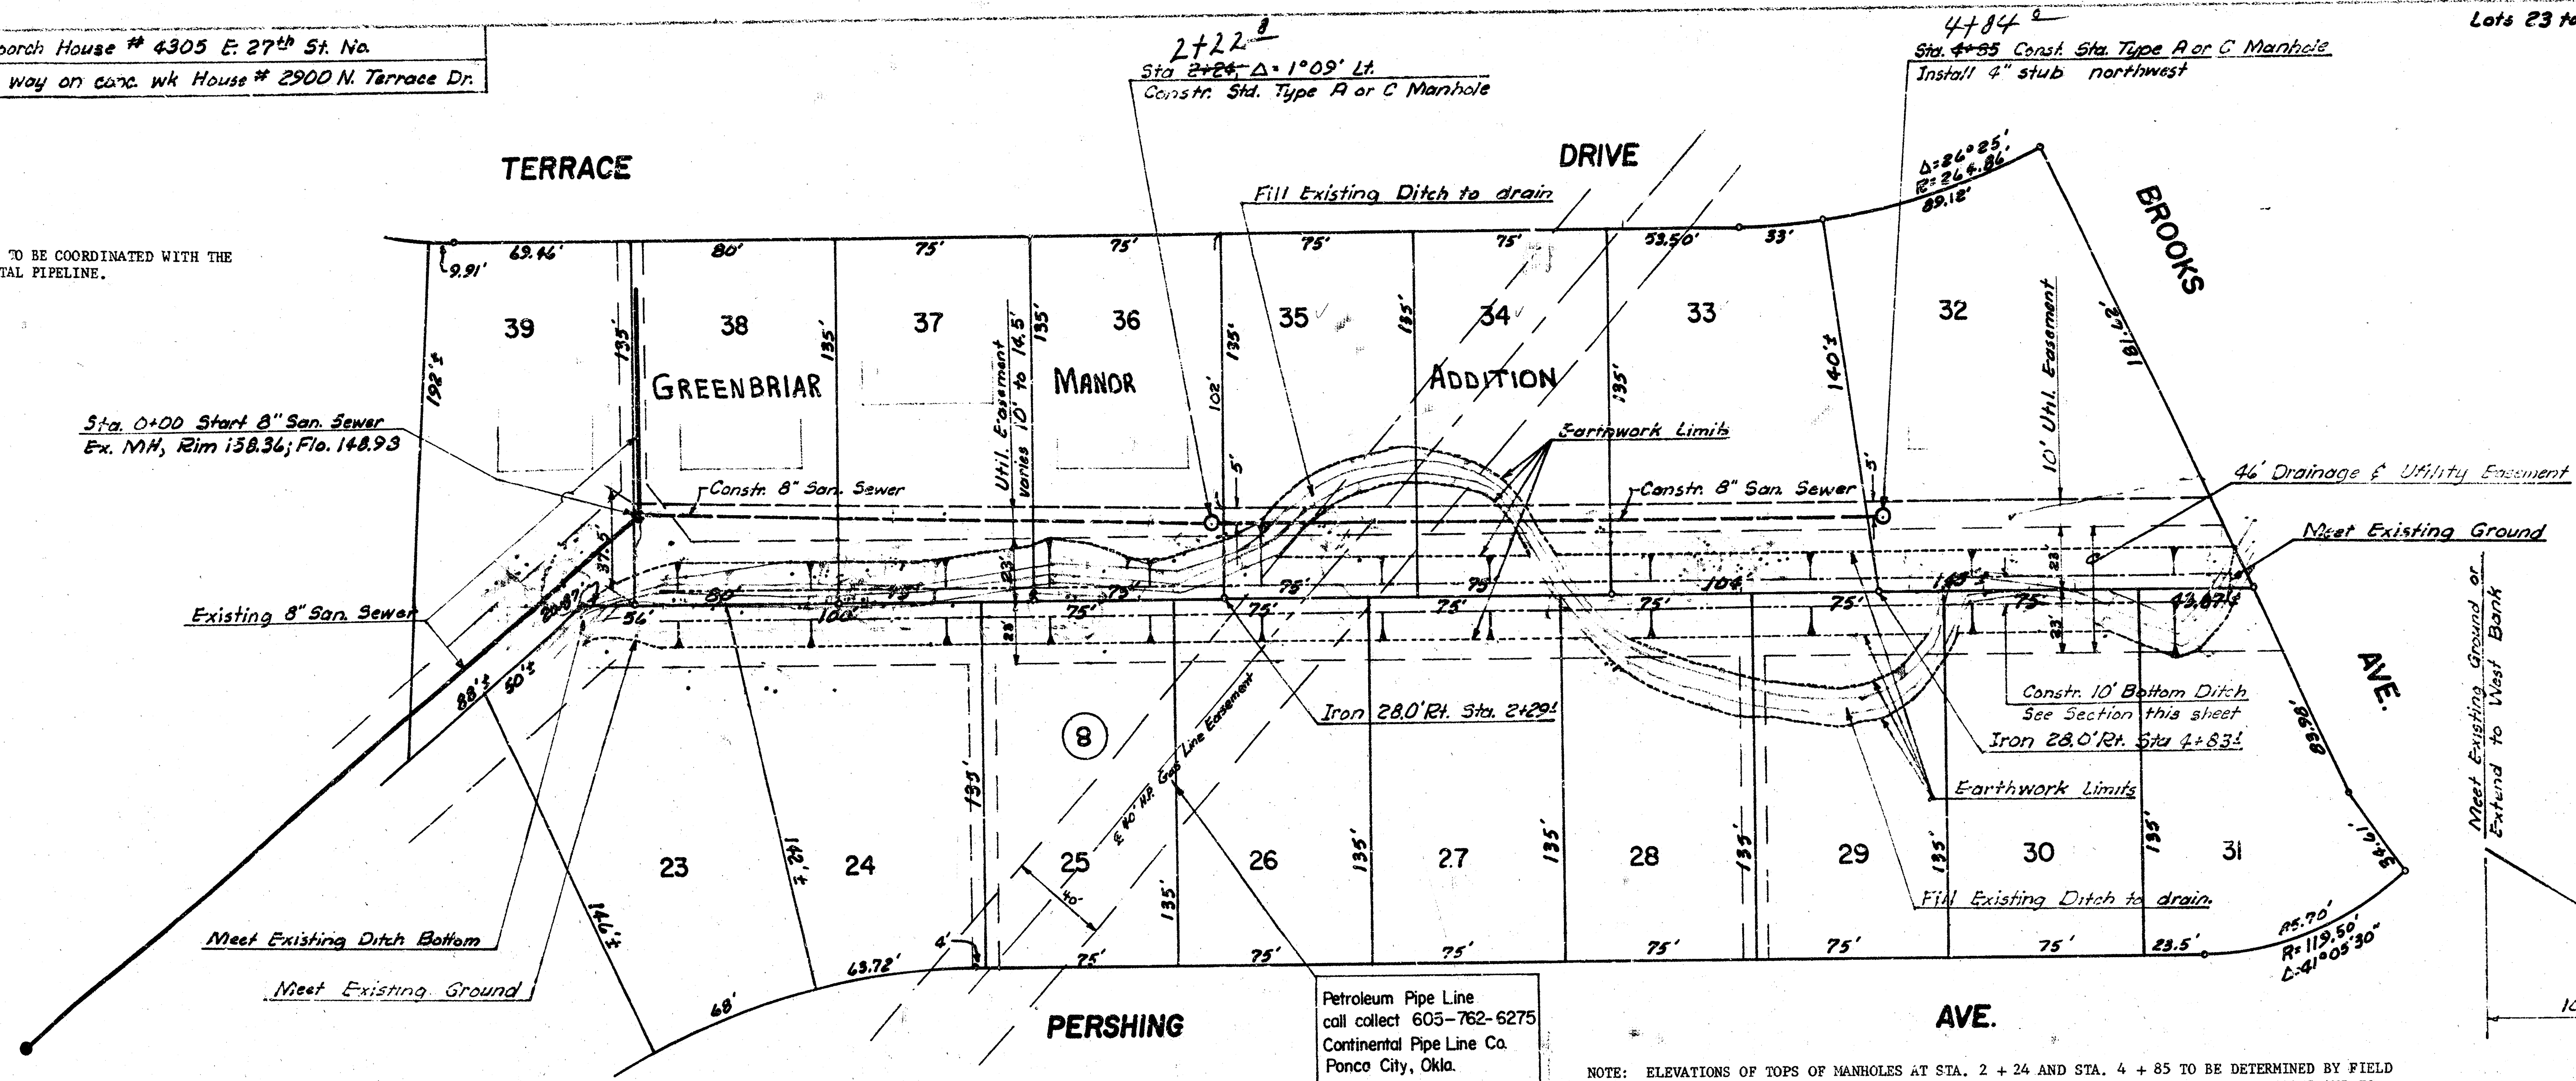


Lots 23 to 31 & Lot 32 are not in Benefit District.

Plan Scale 1" = 40'
Profile Scale 1" = 40' Horiz.
1" = 5' Vert.

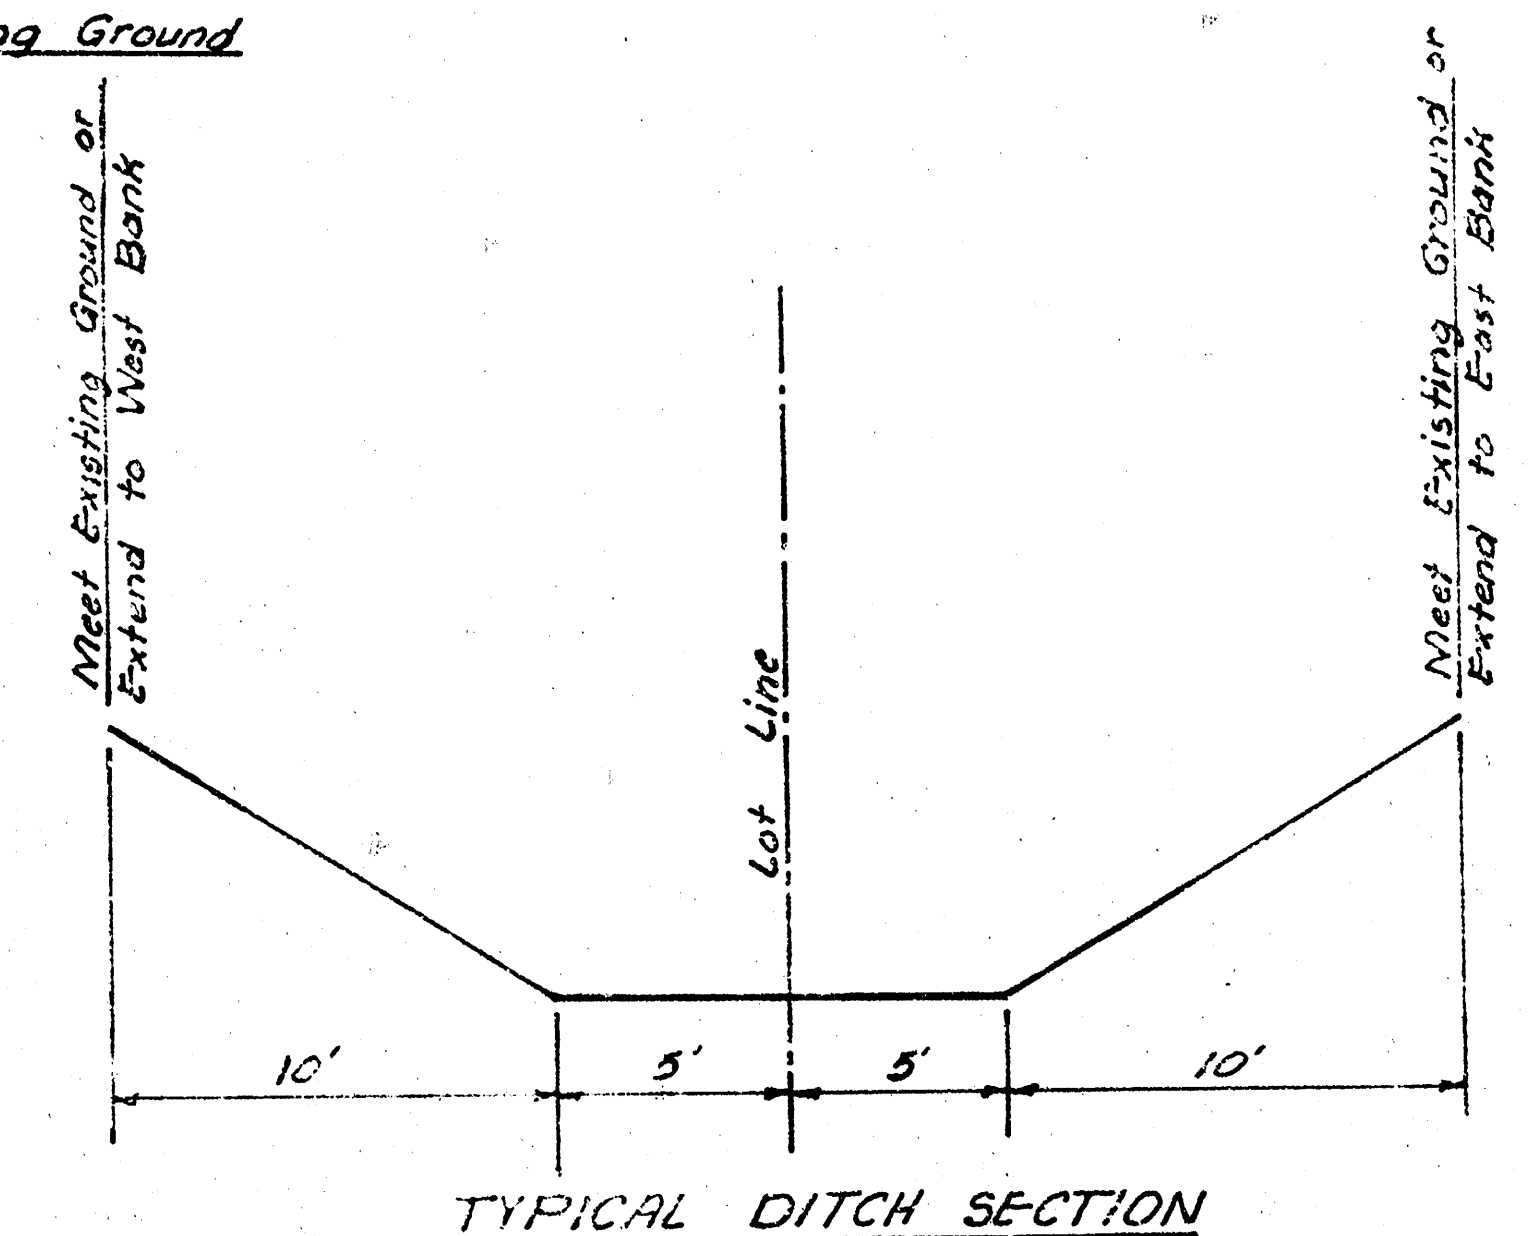

NOTE: ELEVATIONS OF TOPS OF MANHOLES AT STA. 2 + 24 AND STA. 4 + 85 TO BE DETERMINED BY FIELD ENGINEER. CONTRACTOR WILL BE REQUIRED TO EXCAVATE A CHANNEL AS SHOWN BY PLANS AND TO FILL THE EXISTING CHANNEL OUTSIDE THE LIMITS OF THE PROPOSED NEW CHANNEL AS SHOWN BY PLANS. EXCAVATION OF CHANNEL SHALL BE PAID FOR AT PRICE BID PER CUBIC YARD OF EXCAVATION. FILL WILL NOT BE PAID FOR DIRECTLY AND THIS COST SHALL BE INCLUDED IN THE UNIT PRICE BID FOR THE EXCAVATION OF THE CHANNEL.

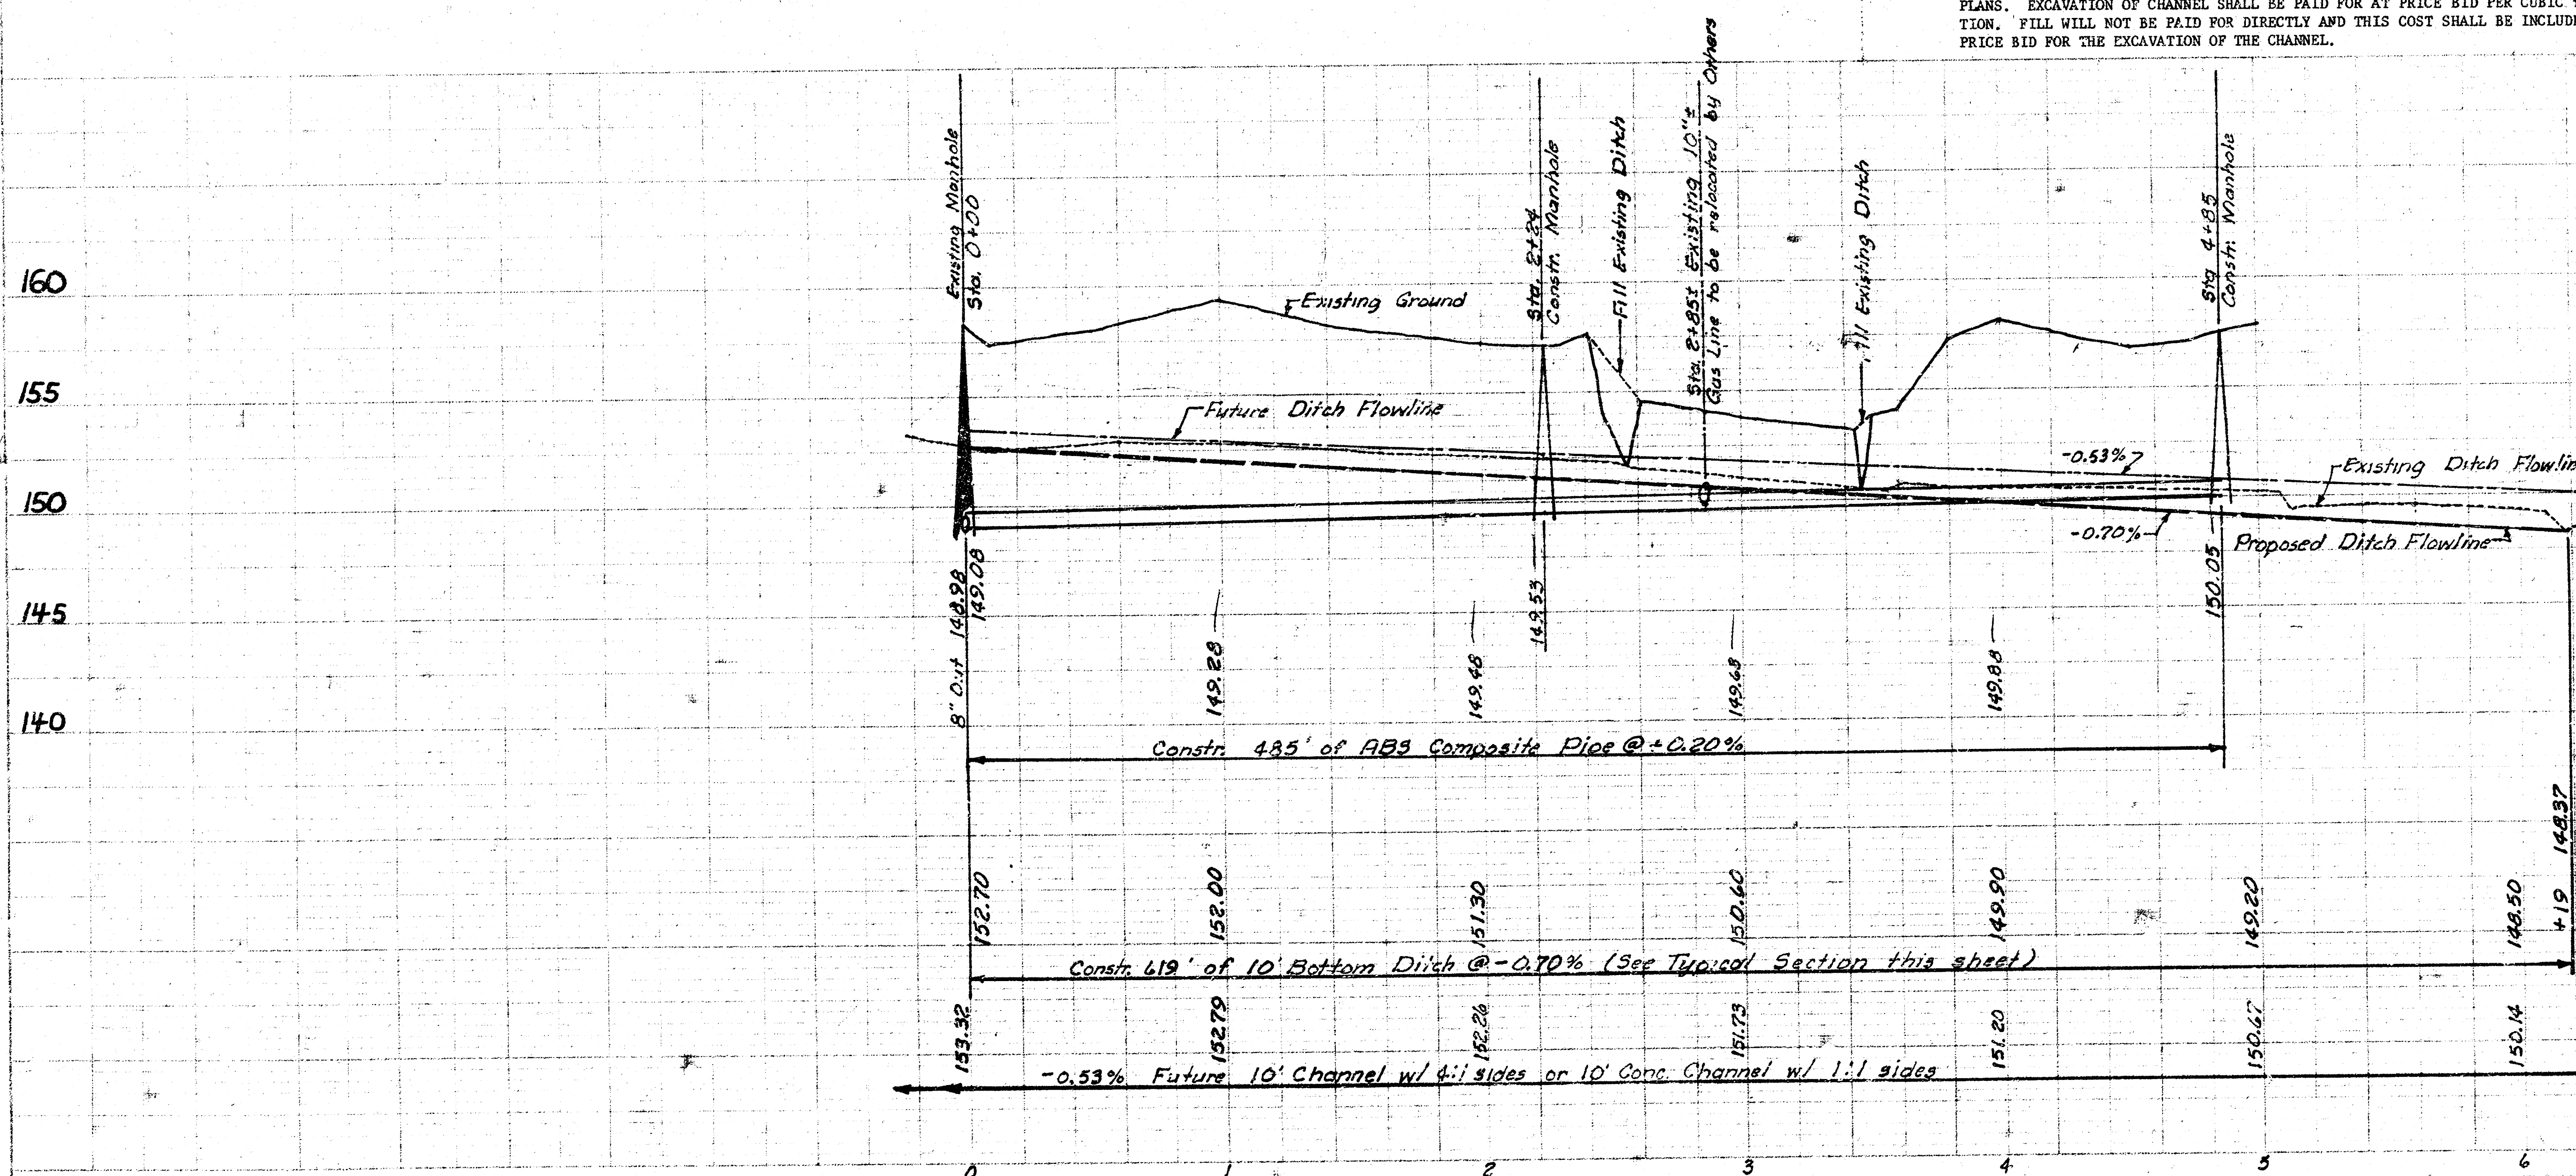

As Built 10-5-76
LAT. 8 MAIN I SANITARY SEWER 23
CITY OF WICHITA, KANSAS
R. W. LINN — CITY ENGINEER
DATE: _____
Project Number DBKL576009

