

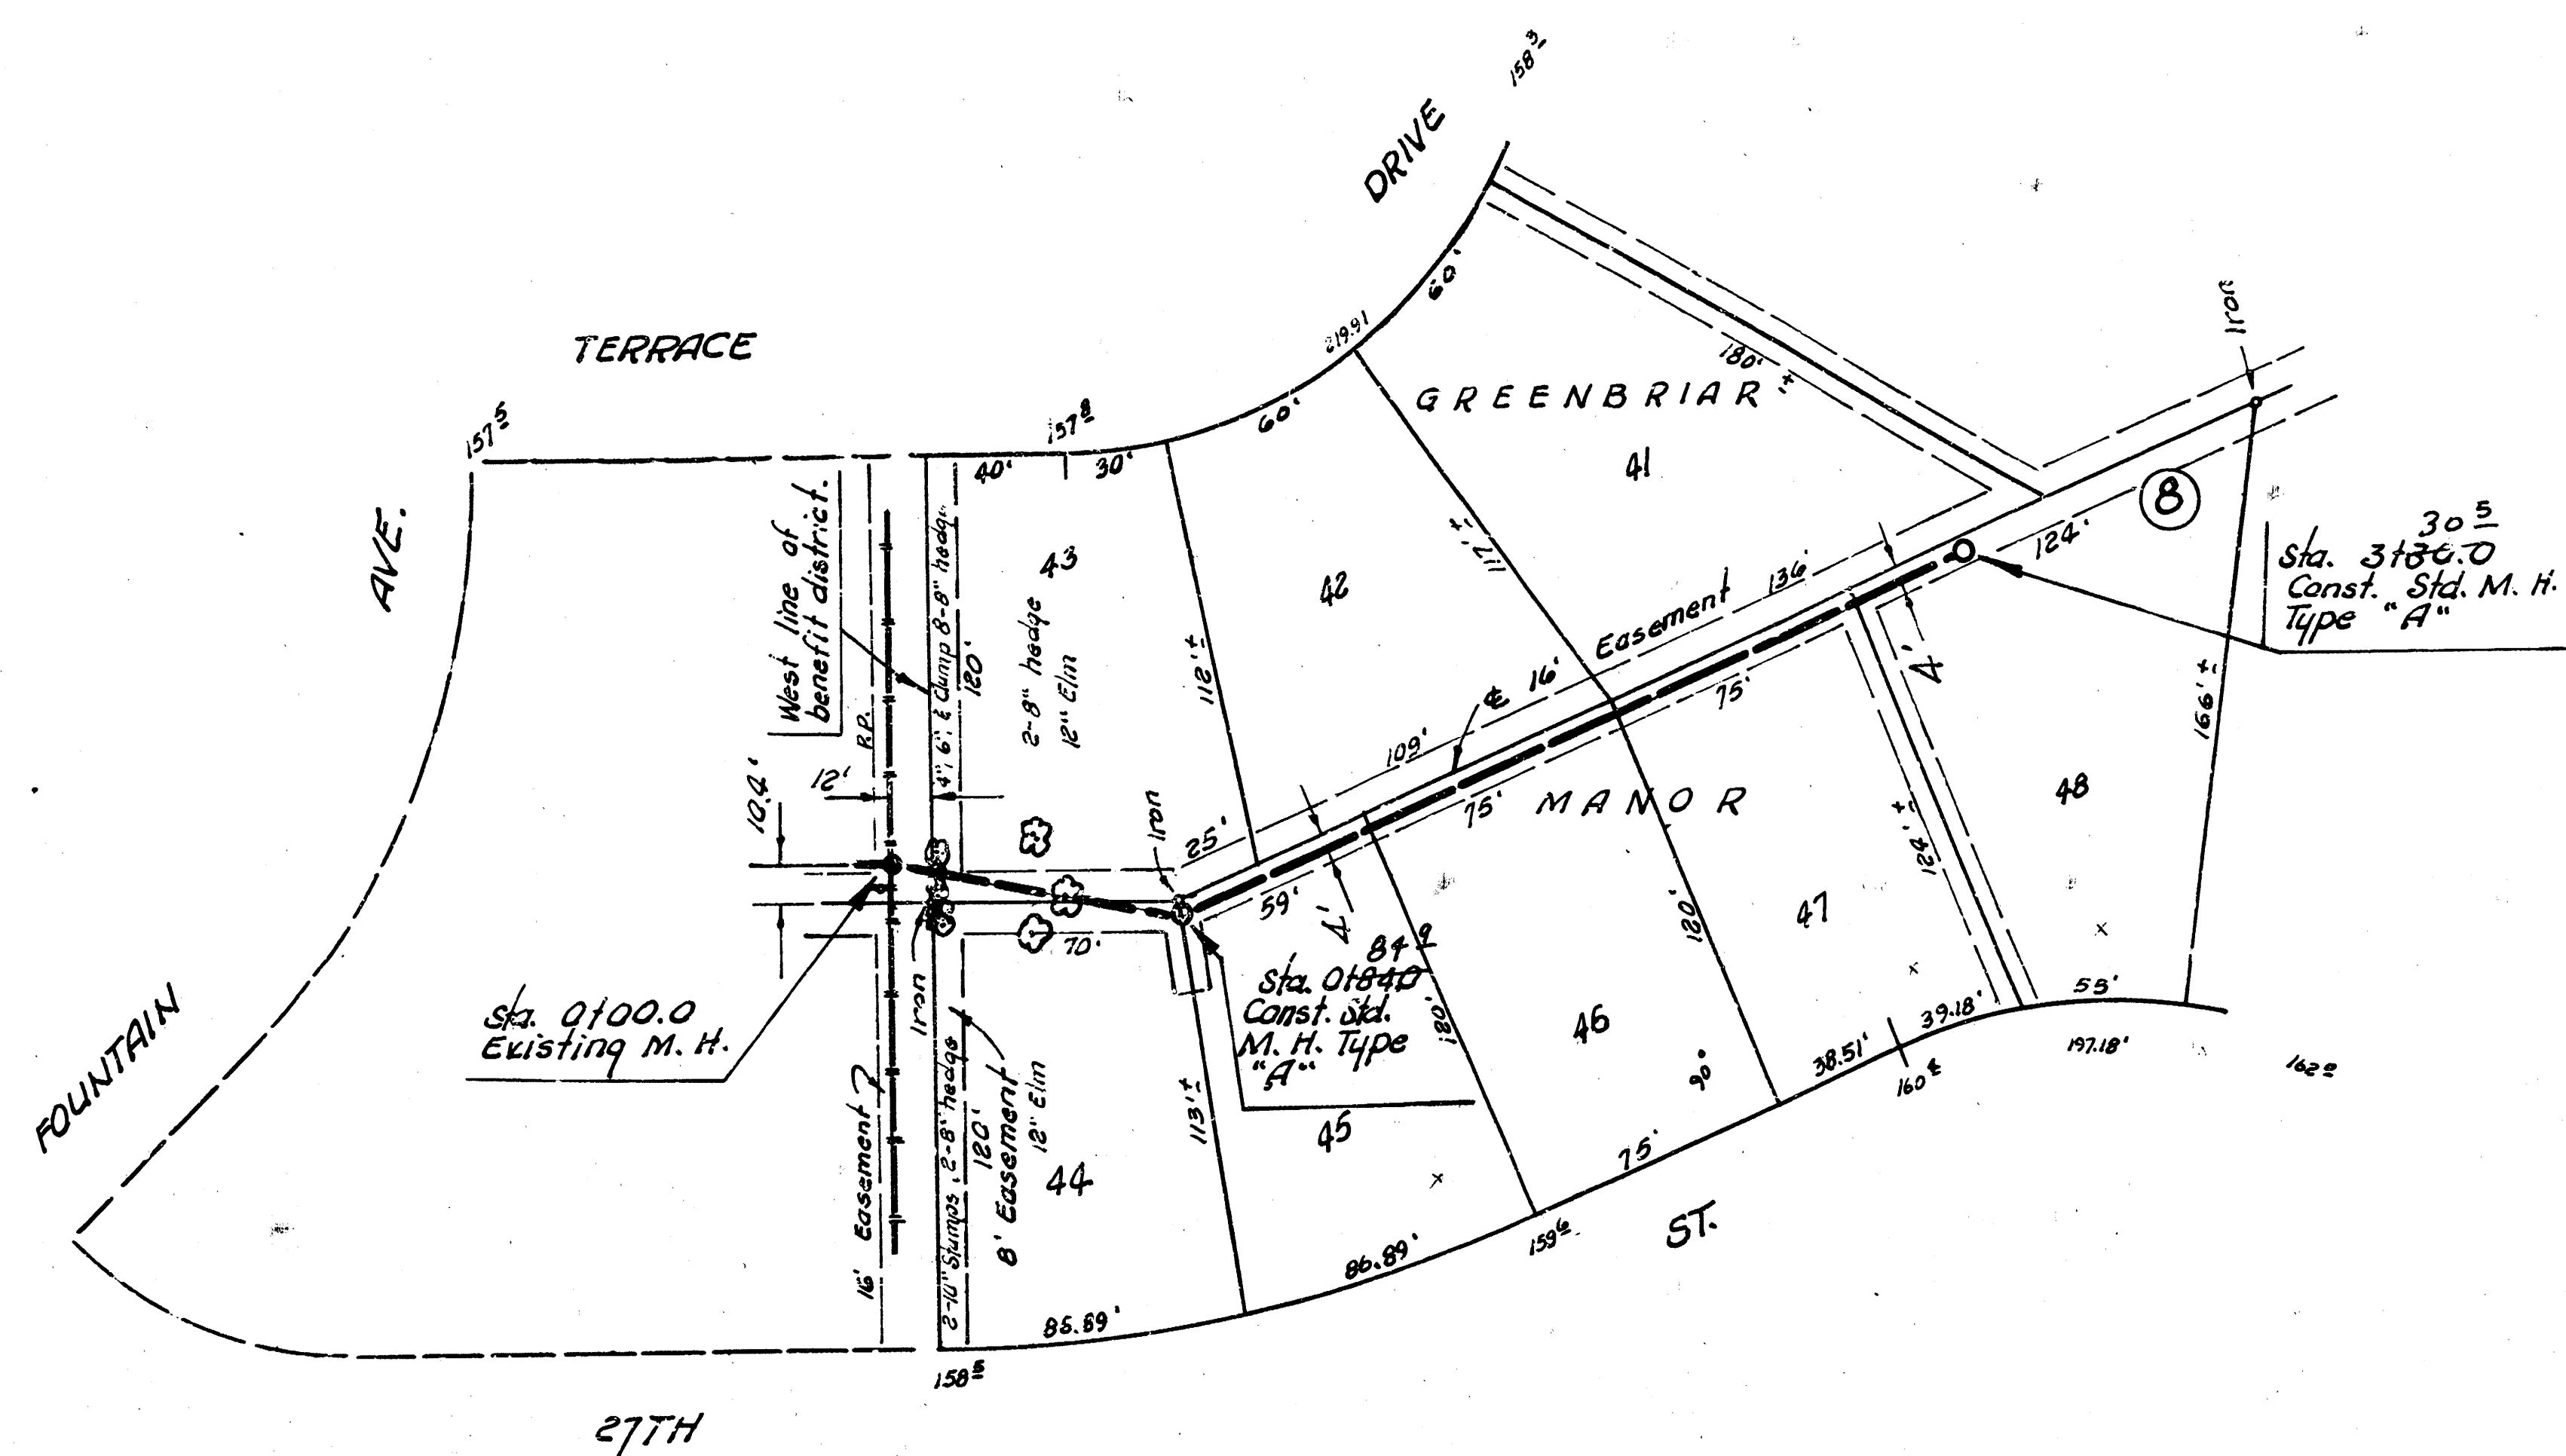


B.M. 146.93 "M" in Mueller F. H. S.E. cor.
Pershing & Greenbriar Lane.
B.M. 158.18 "R" in Ritchie bras const. E-end
Rad. N.E. cor. 27th & Fountain.
T.P. 157.21 C. Rim M.H. Sta. 0+00.
B.M. 159.68 C. of W. B.M. Disc. 39' N. and
33' E. of & Oliver & 29th St. N.

NOTE: The bid price of Lump Sum
Clearing of Right-of-way to
include all costs of removing
trees, hedge, stumps and any
other items in the way of the
construction of the sewer.

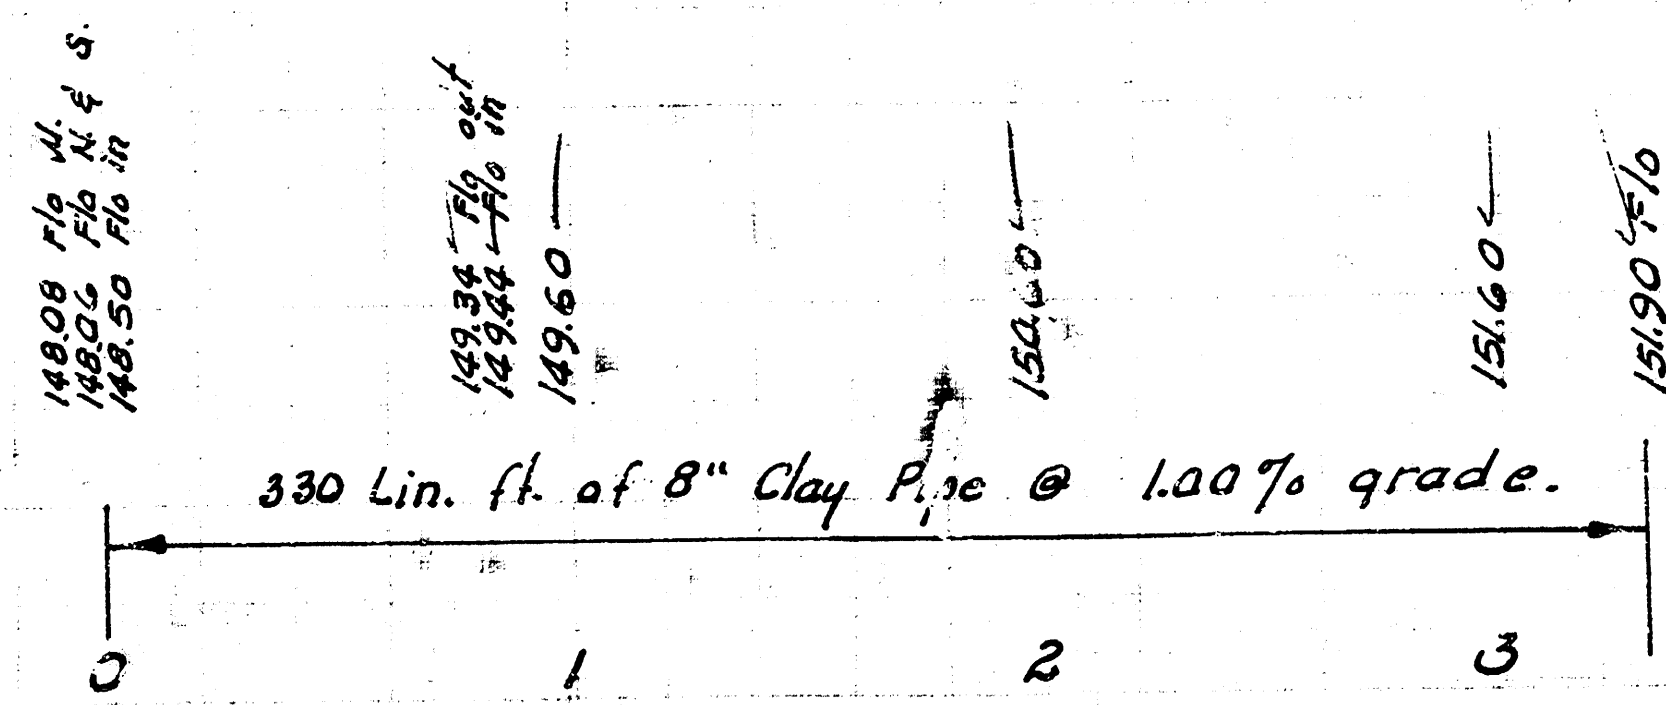

Plan scale 1" = 40'
Profile scale 1" = 40' Horiz.
1" = 5' Vert.

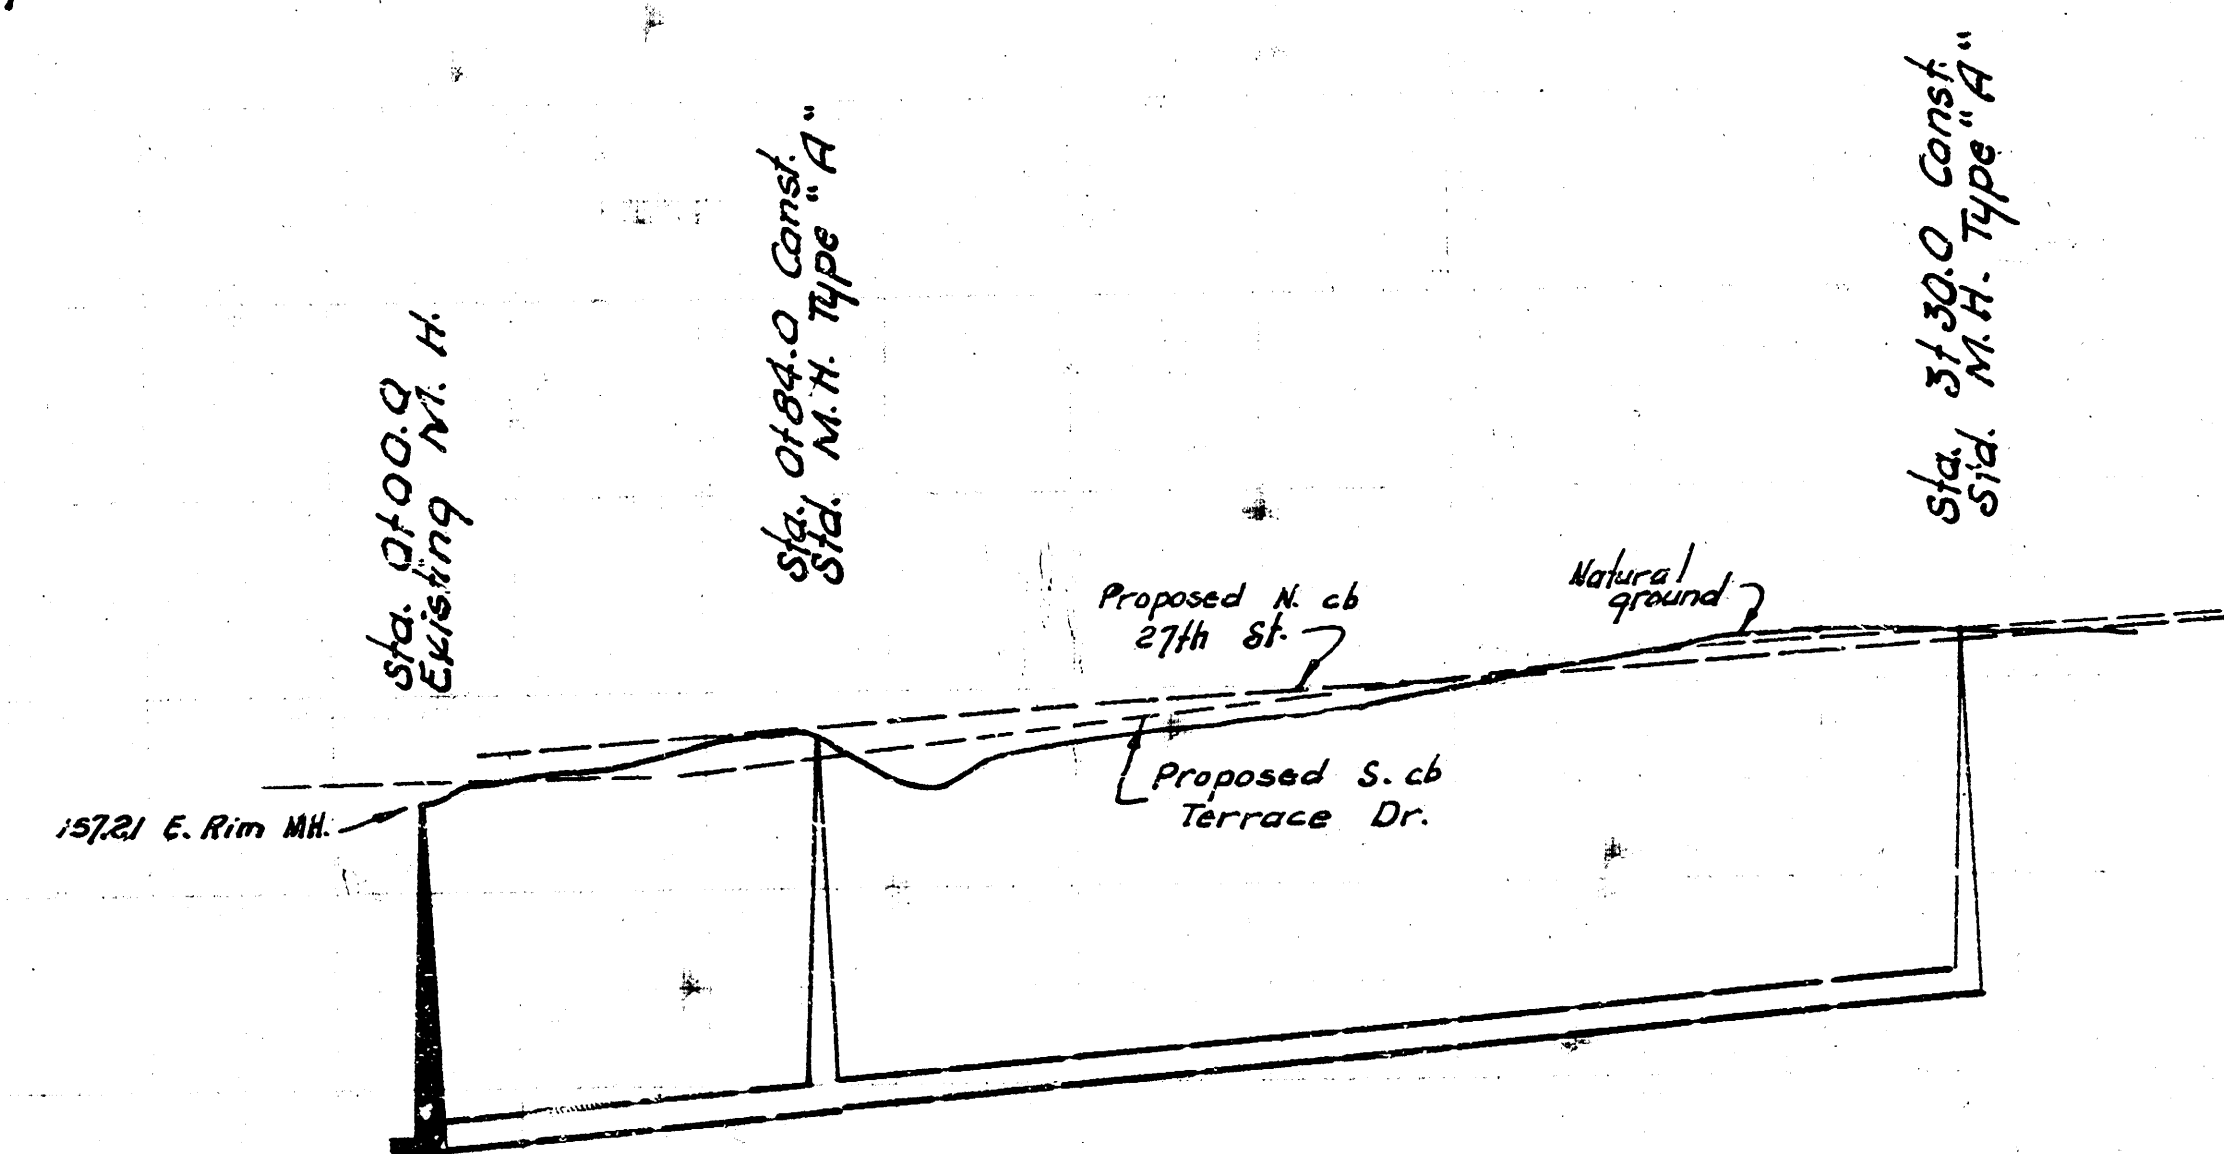

As Built Final Map 1H 84
LAT. 7, MAIN 1, S. S. NO. 23
CITY OF WICHITA, KANSAS
R. W. LINN — CITY ENGINEER
APRIL 1974 PROJECT NO. DBK1574005

FILMED FROM THE BEST
AVAILABLE COPY