



Sheet 1 of 1
Checked by

B. M. 133.46 "M" in Mueller on Fire
Hyd. 33rd and Market.


NOTE TO CONTRACTOR:
The removal of grape arbor
is to be incidental to the
project.
Repair or replacement of septic
tank laterals shall be included
in bid price of pipe.
Replace all fences.

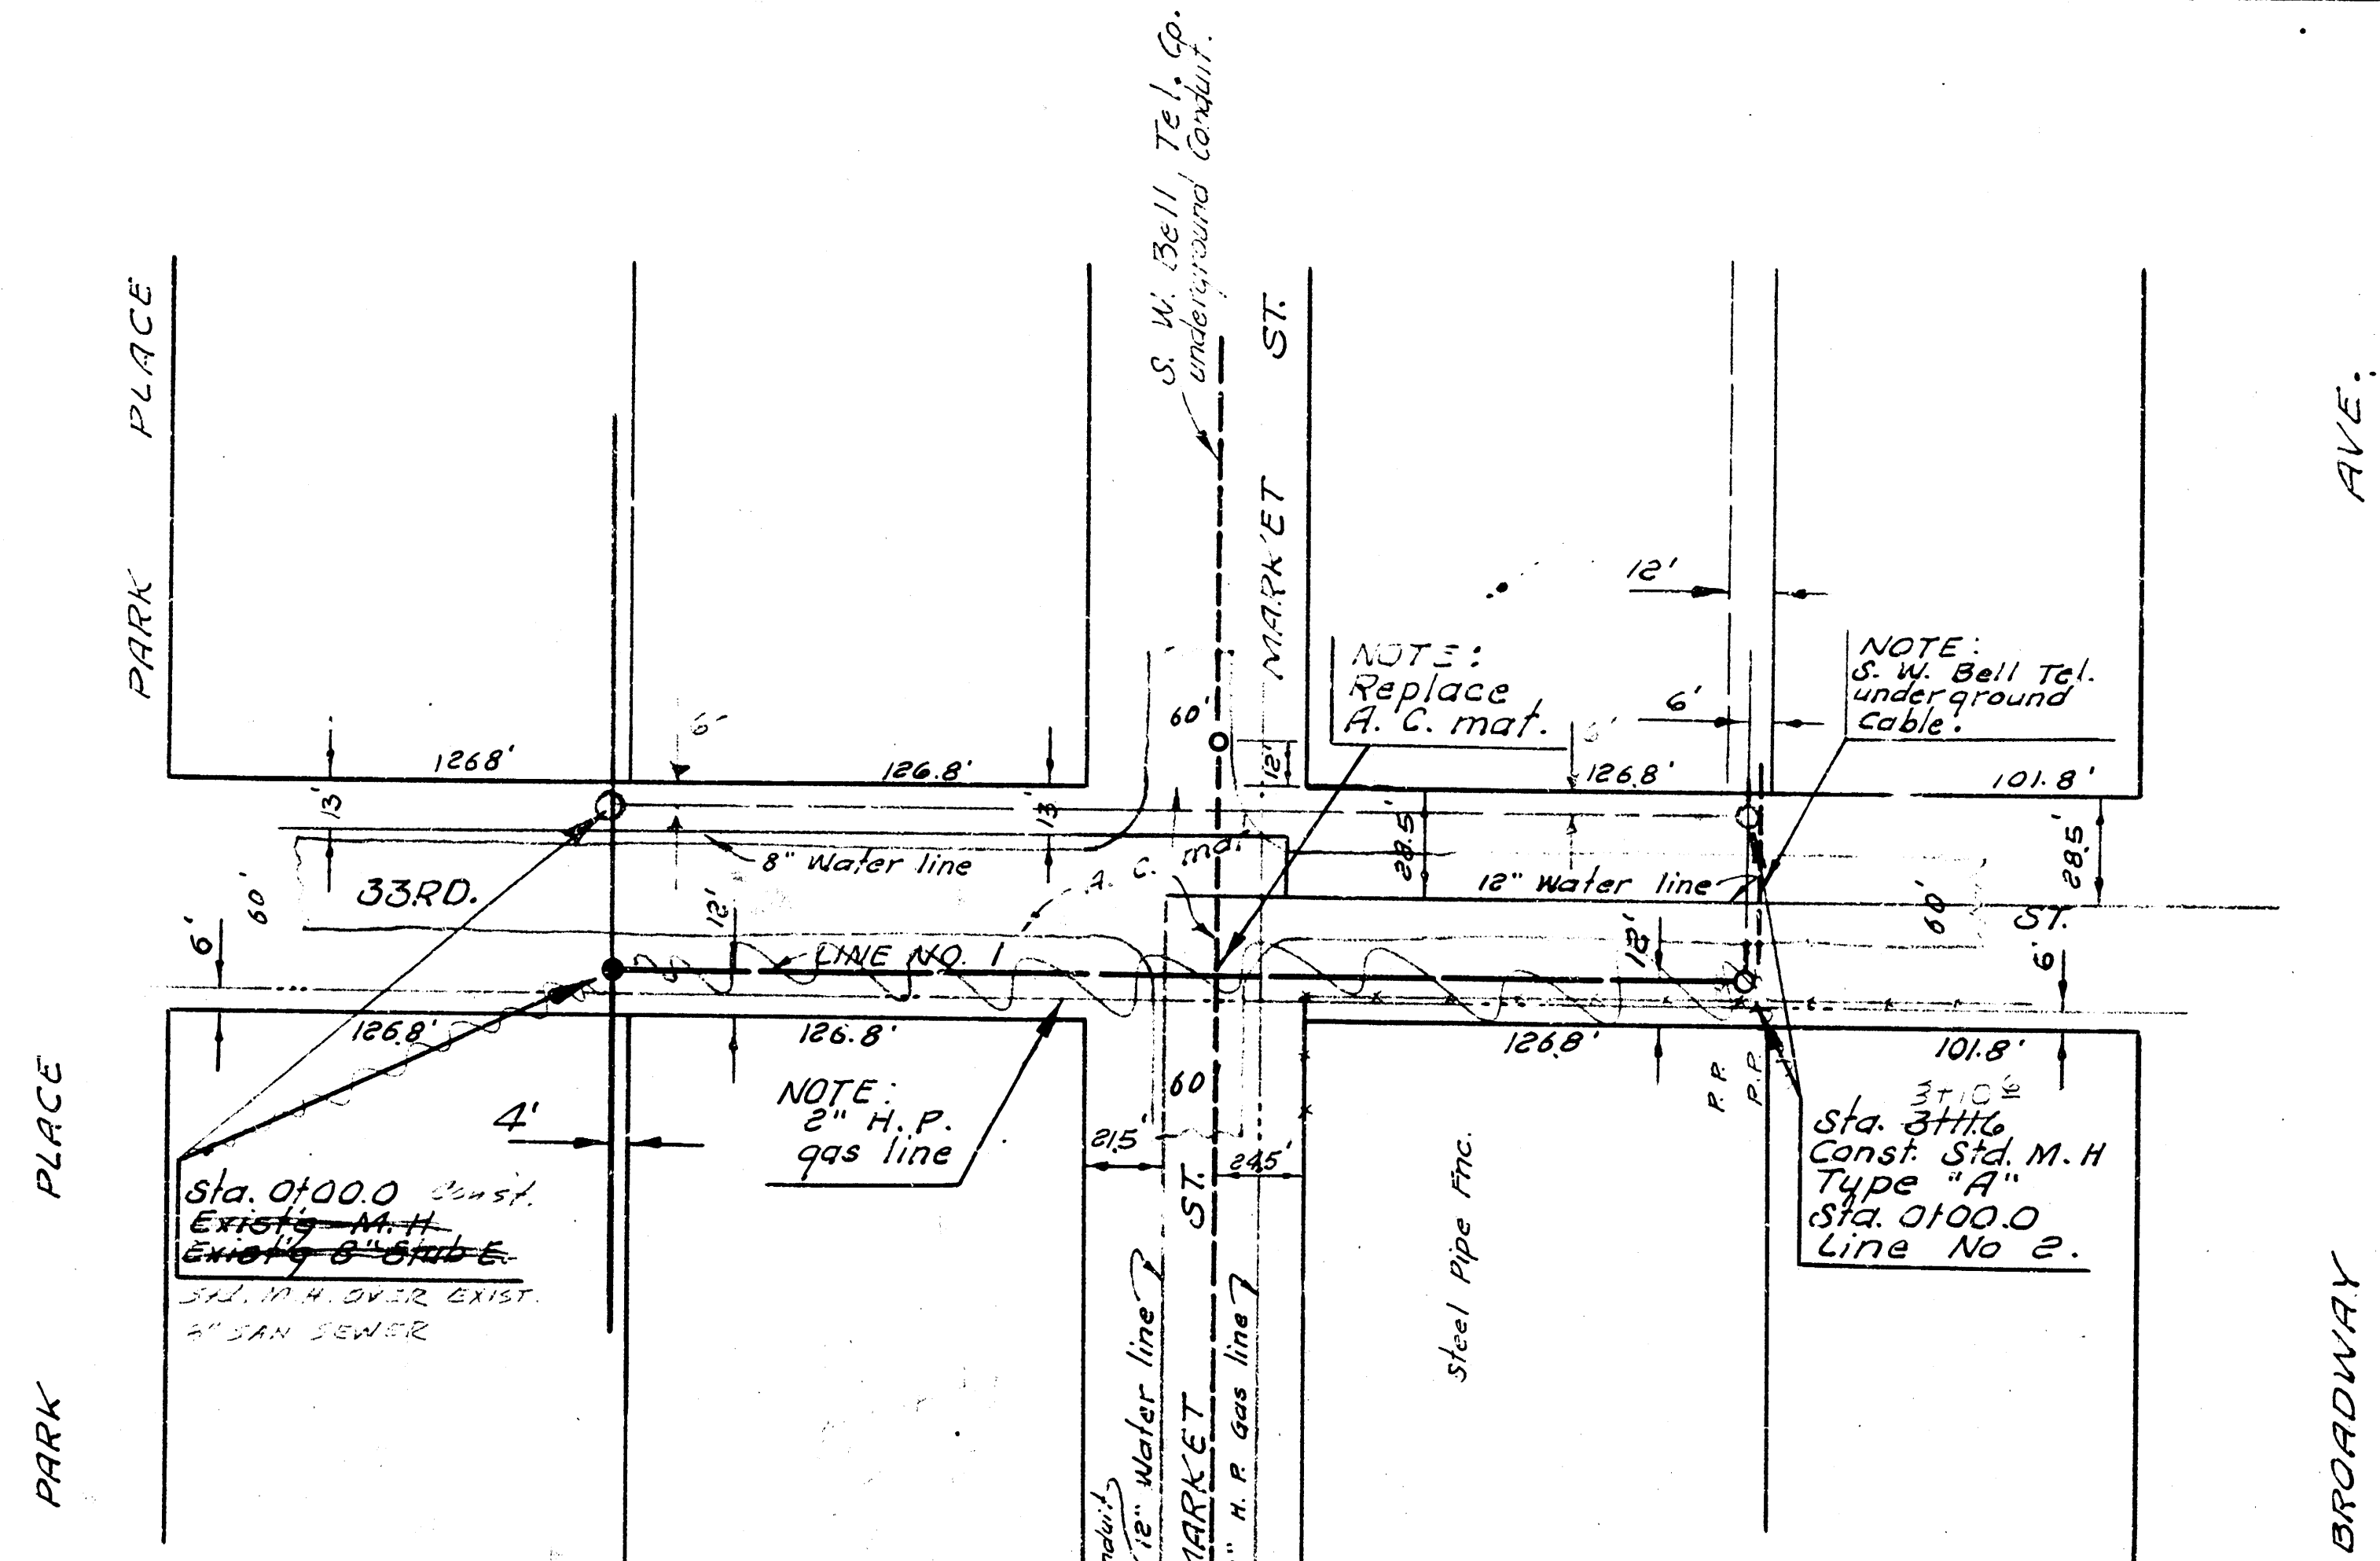

Plan Scale 1" = 40'
Profile Scale 1" = 4' Vert.

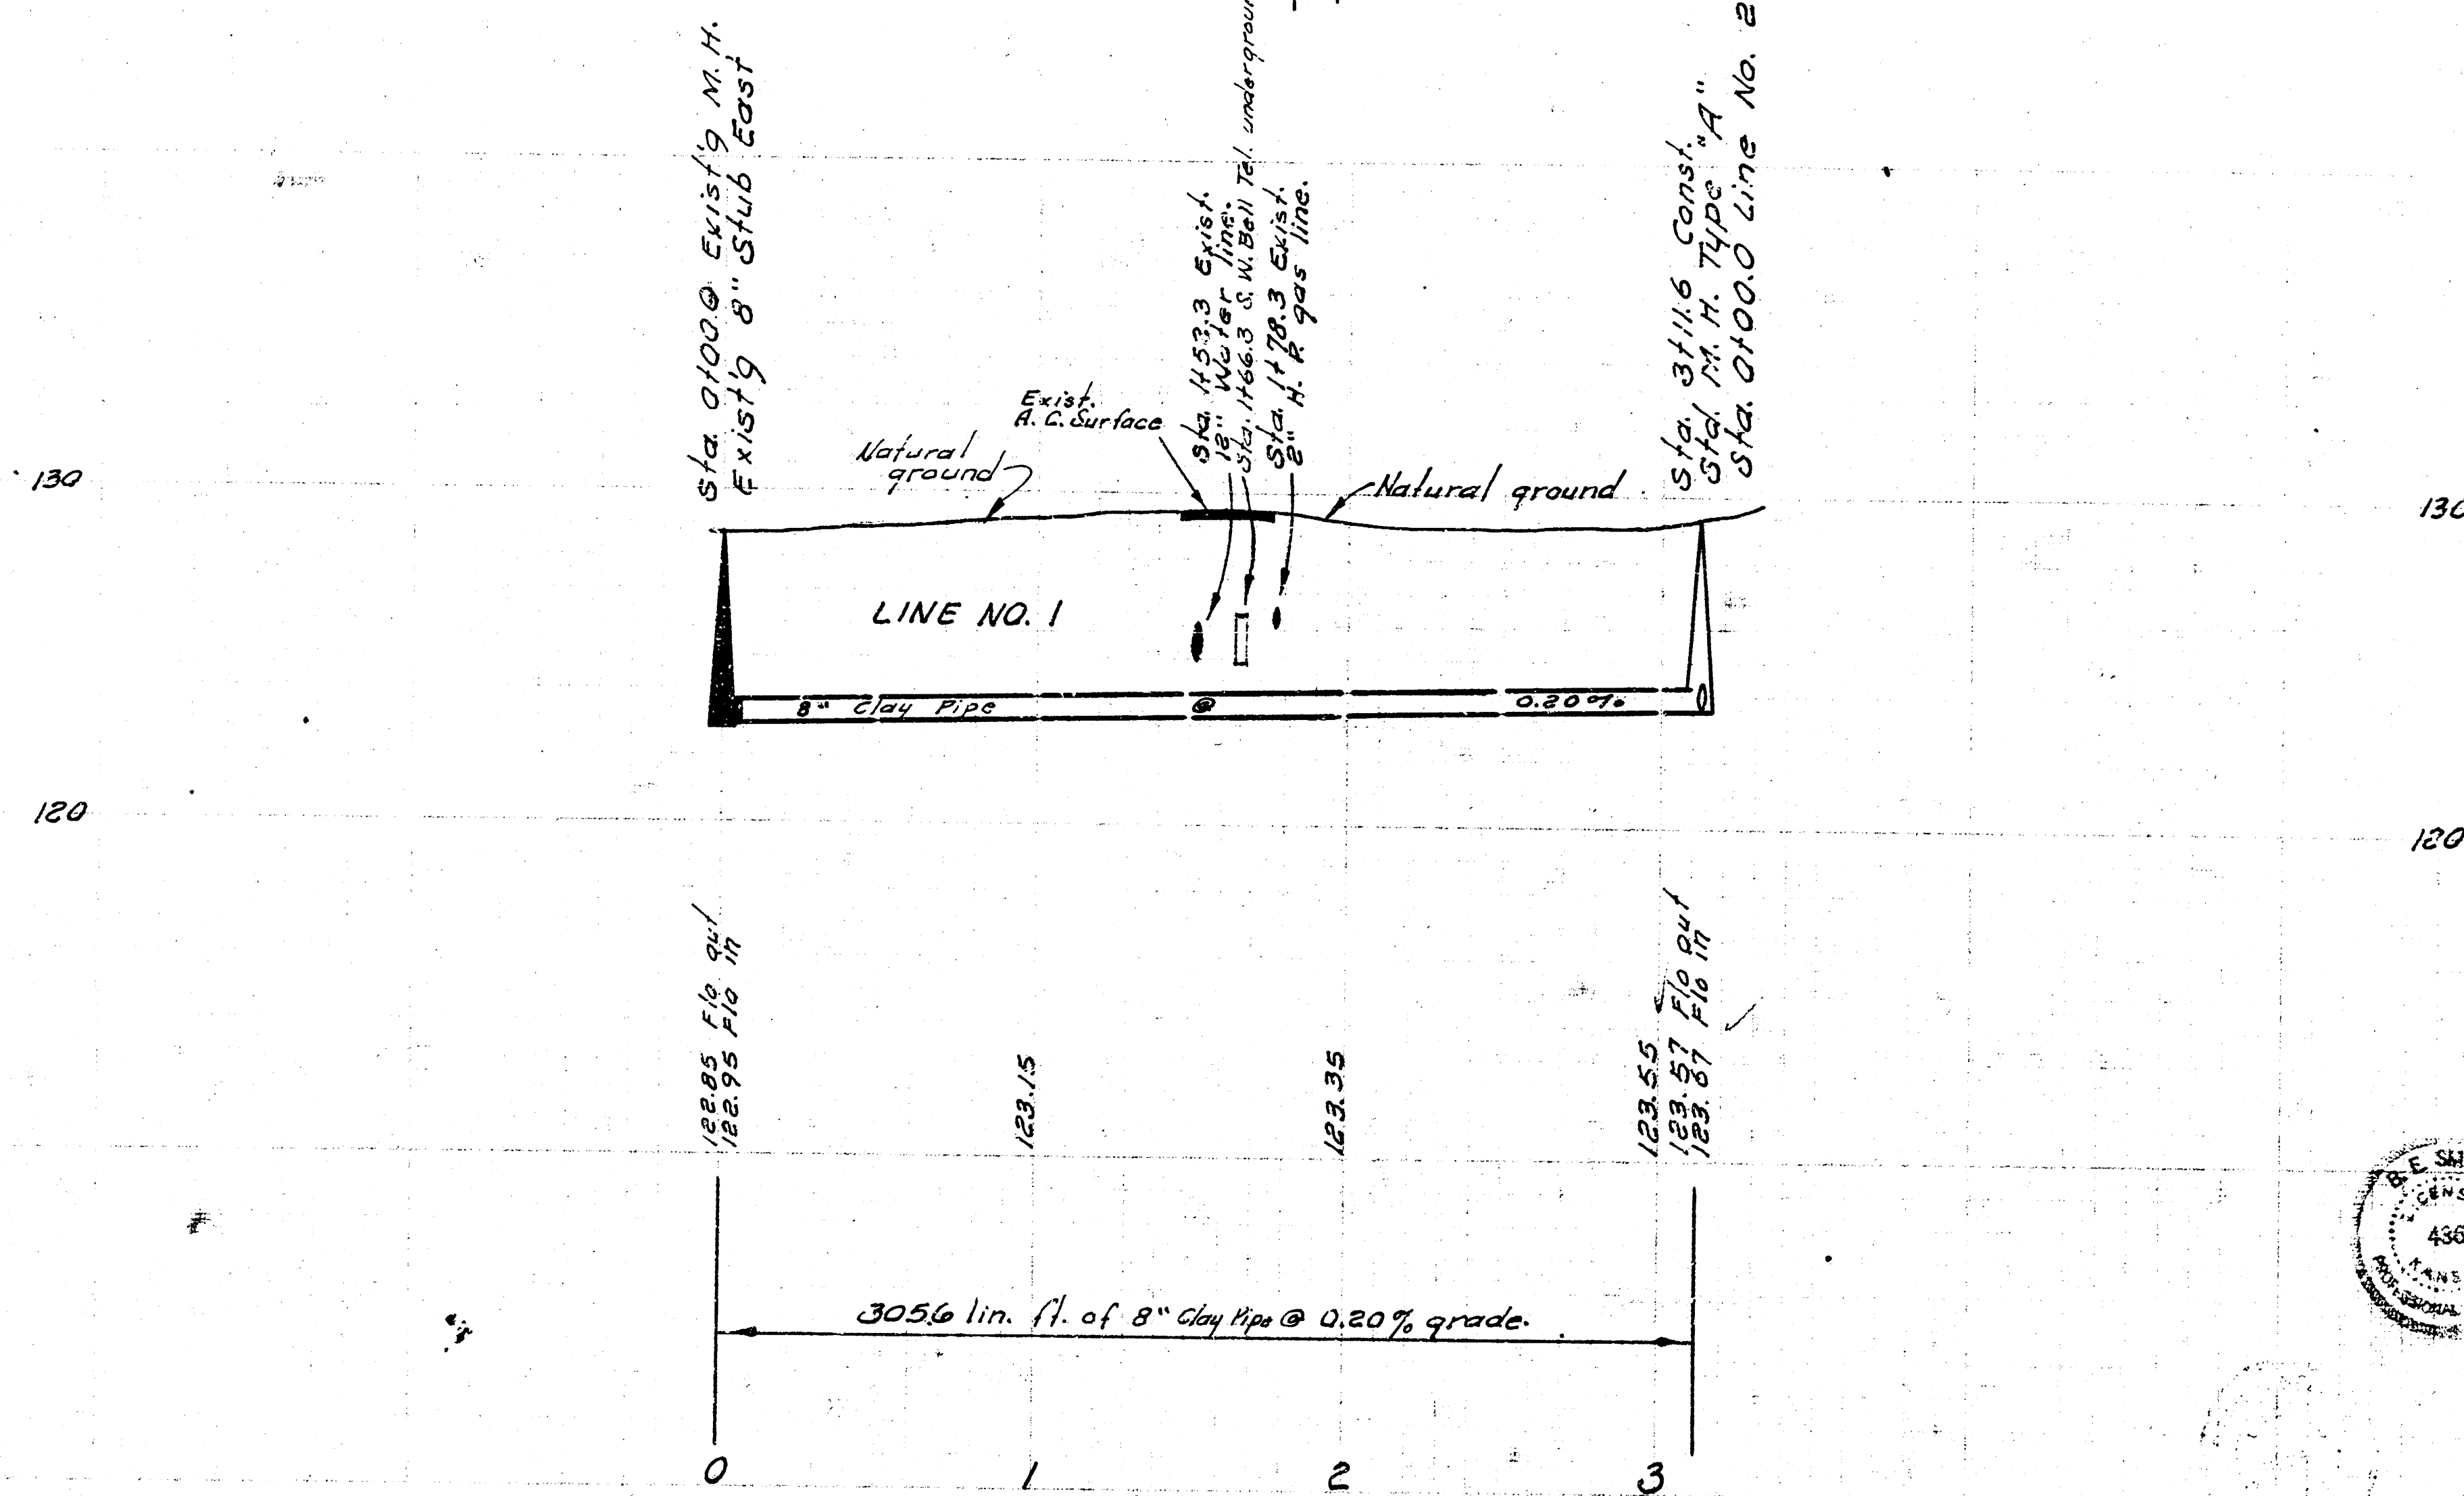

As Built 1970
LAT. 12, SUBMAIN 4, S. S. NO. 23
CITY OF WICHITA, KANSAS
B. E. SMITH CITY ENGINEER
FEB. 1970 PROJECT NO. C23-64

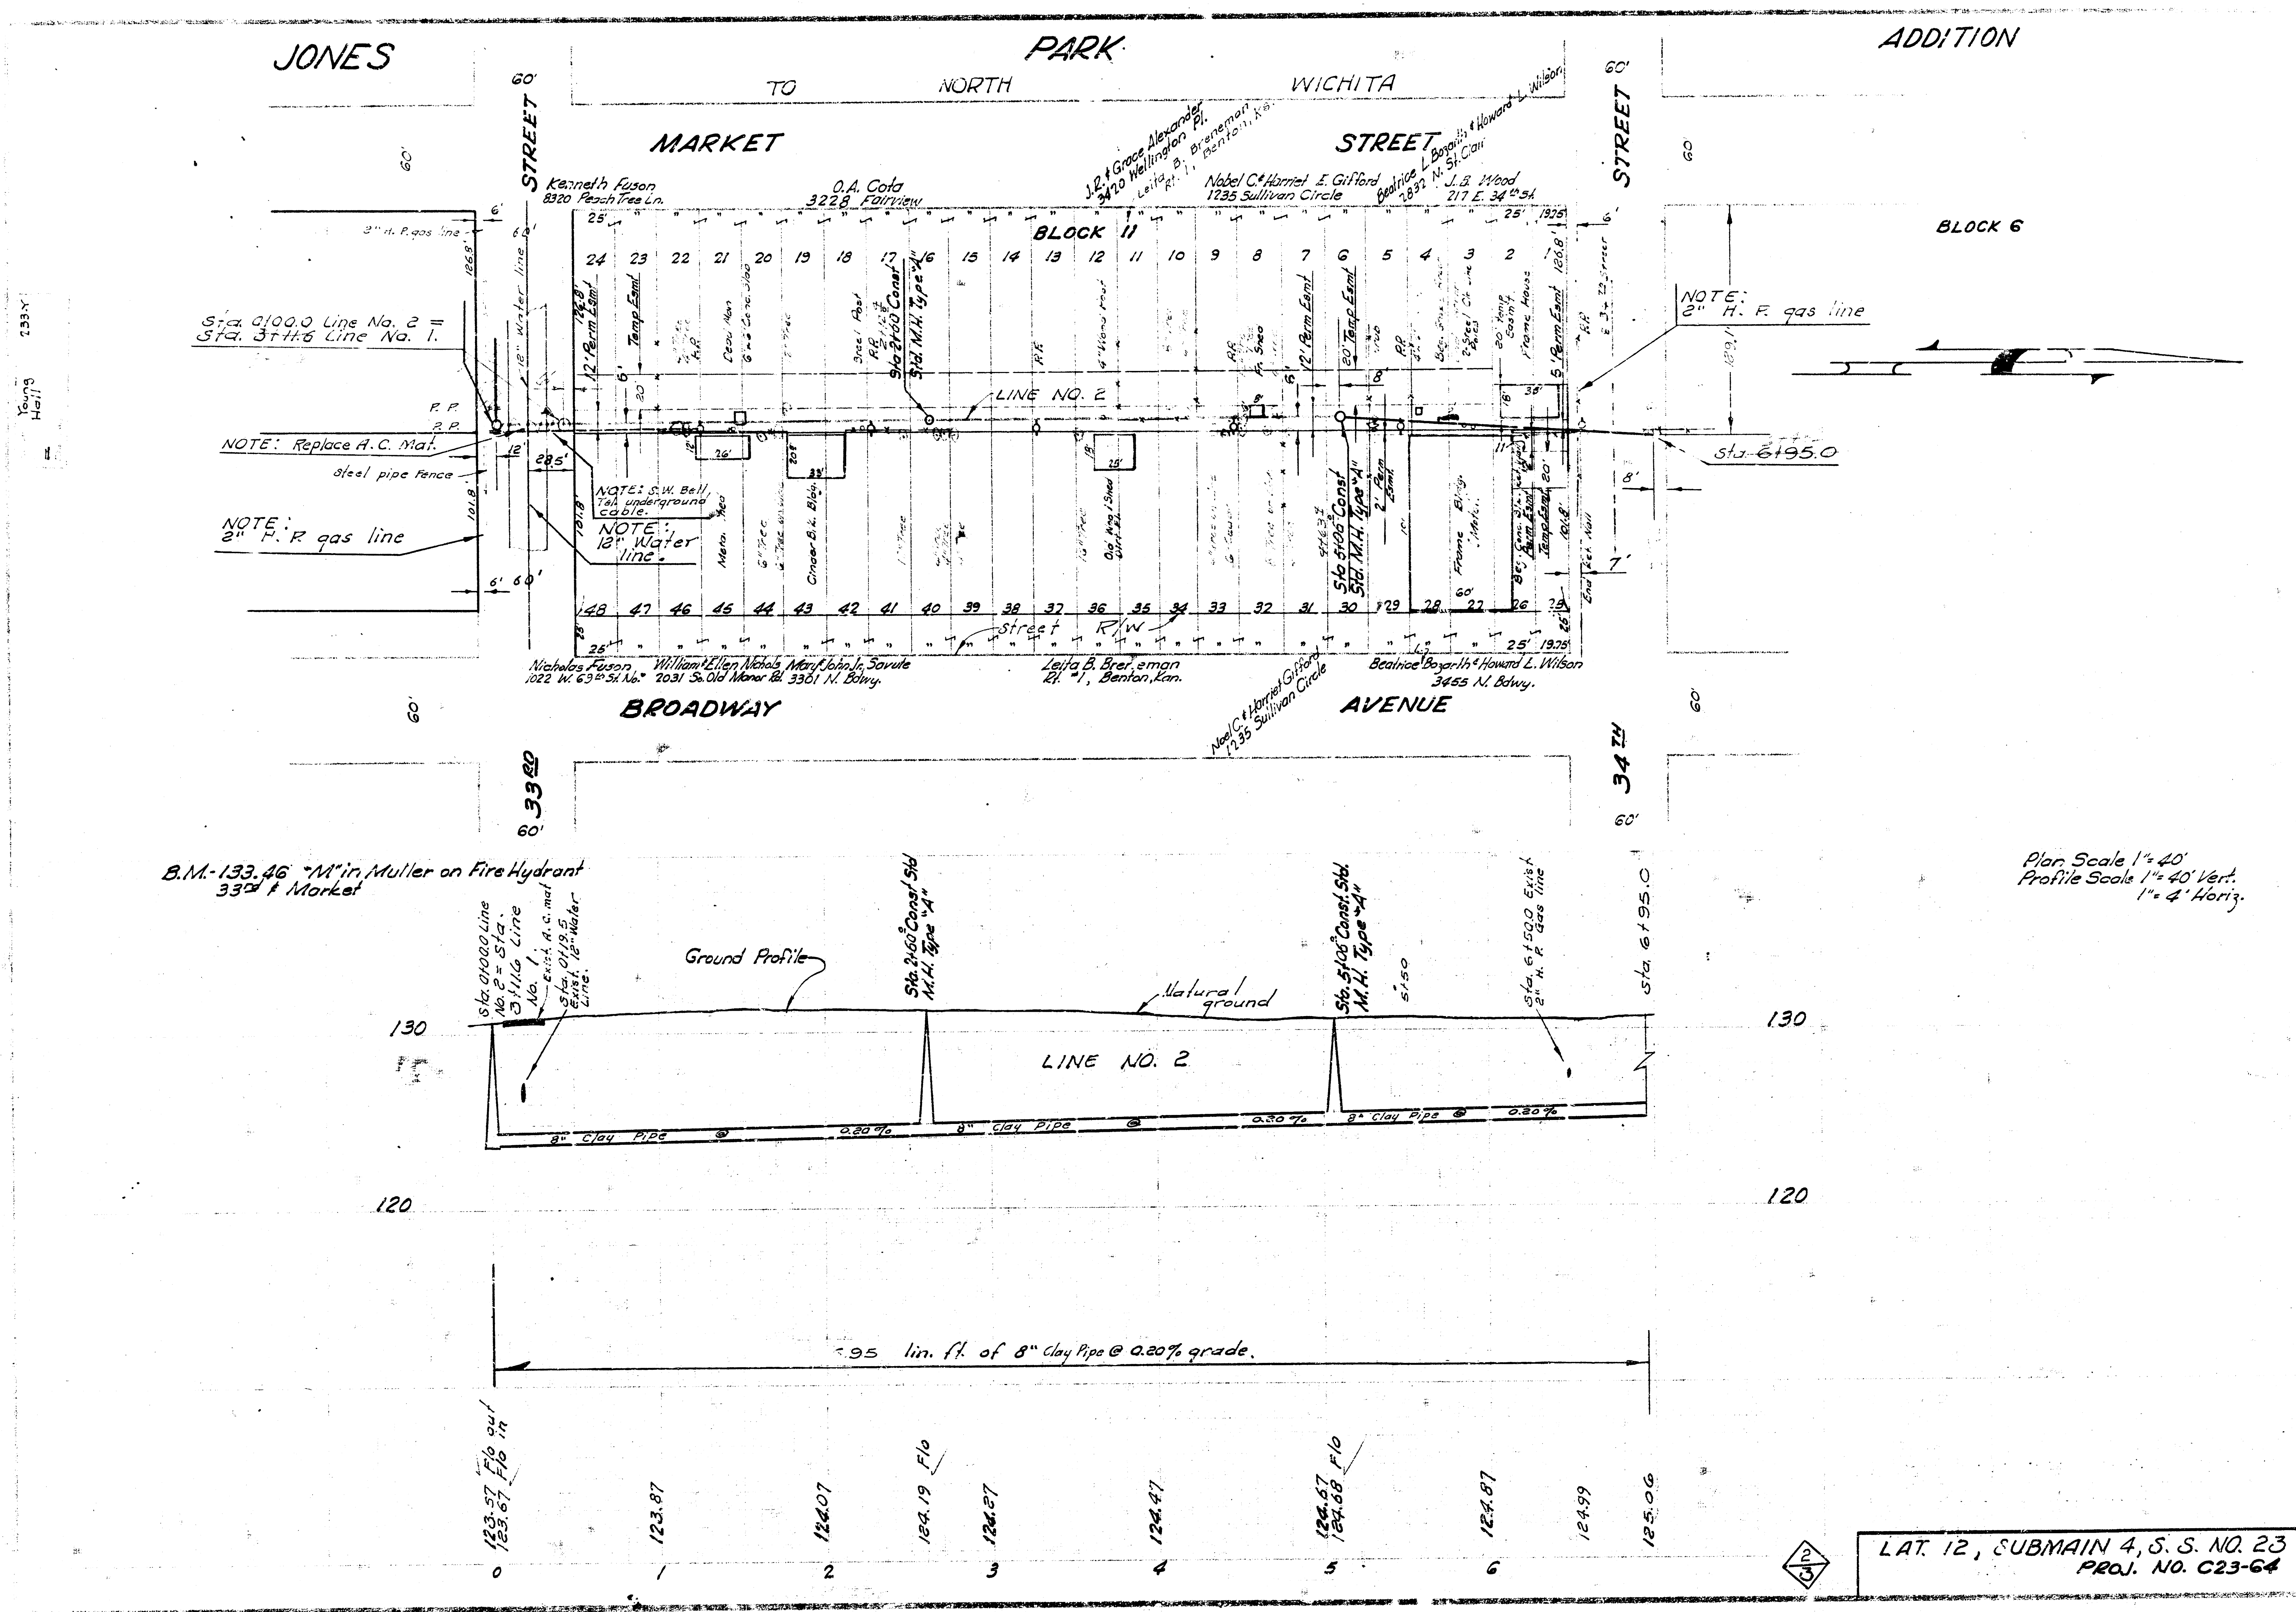

Plan Scale 1"=40'
Profile Scale 1"=40' Vert.
1"=4' Horiz.

LAT. 12, SUBMAIN 4, S.S. NO. 23
PROJ. NO. C23-64

