


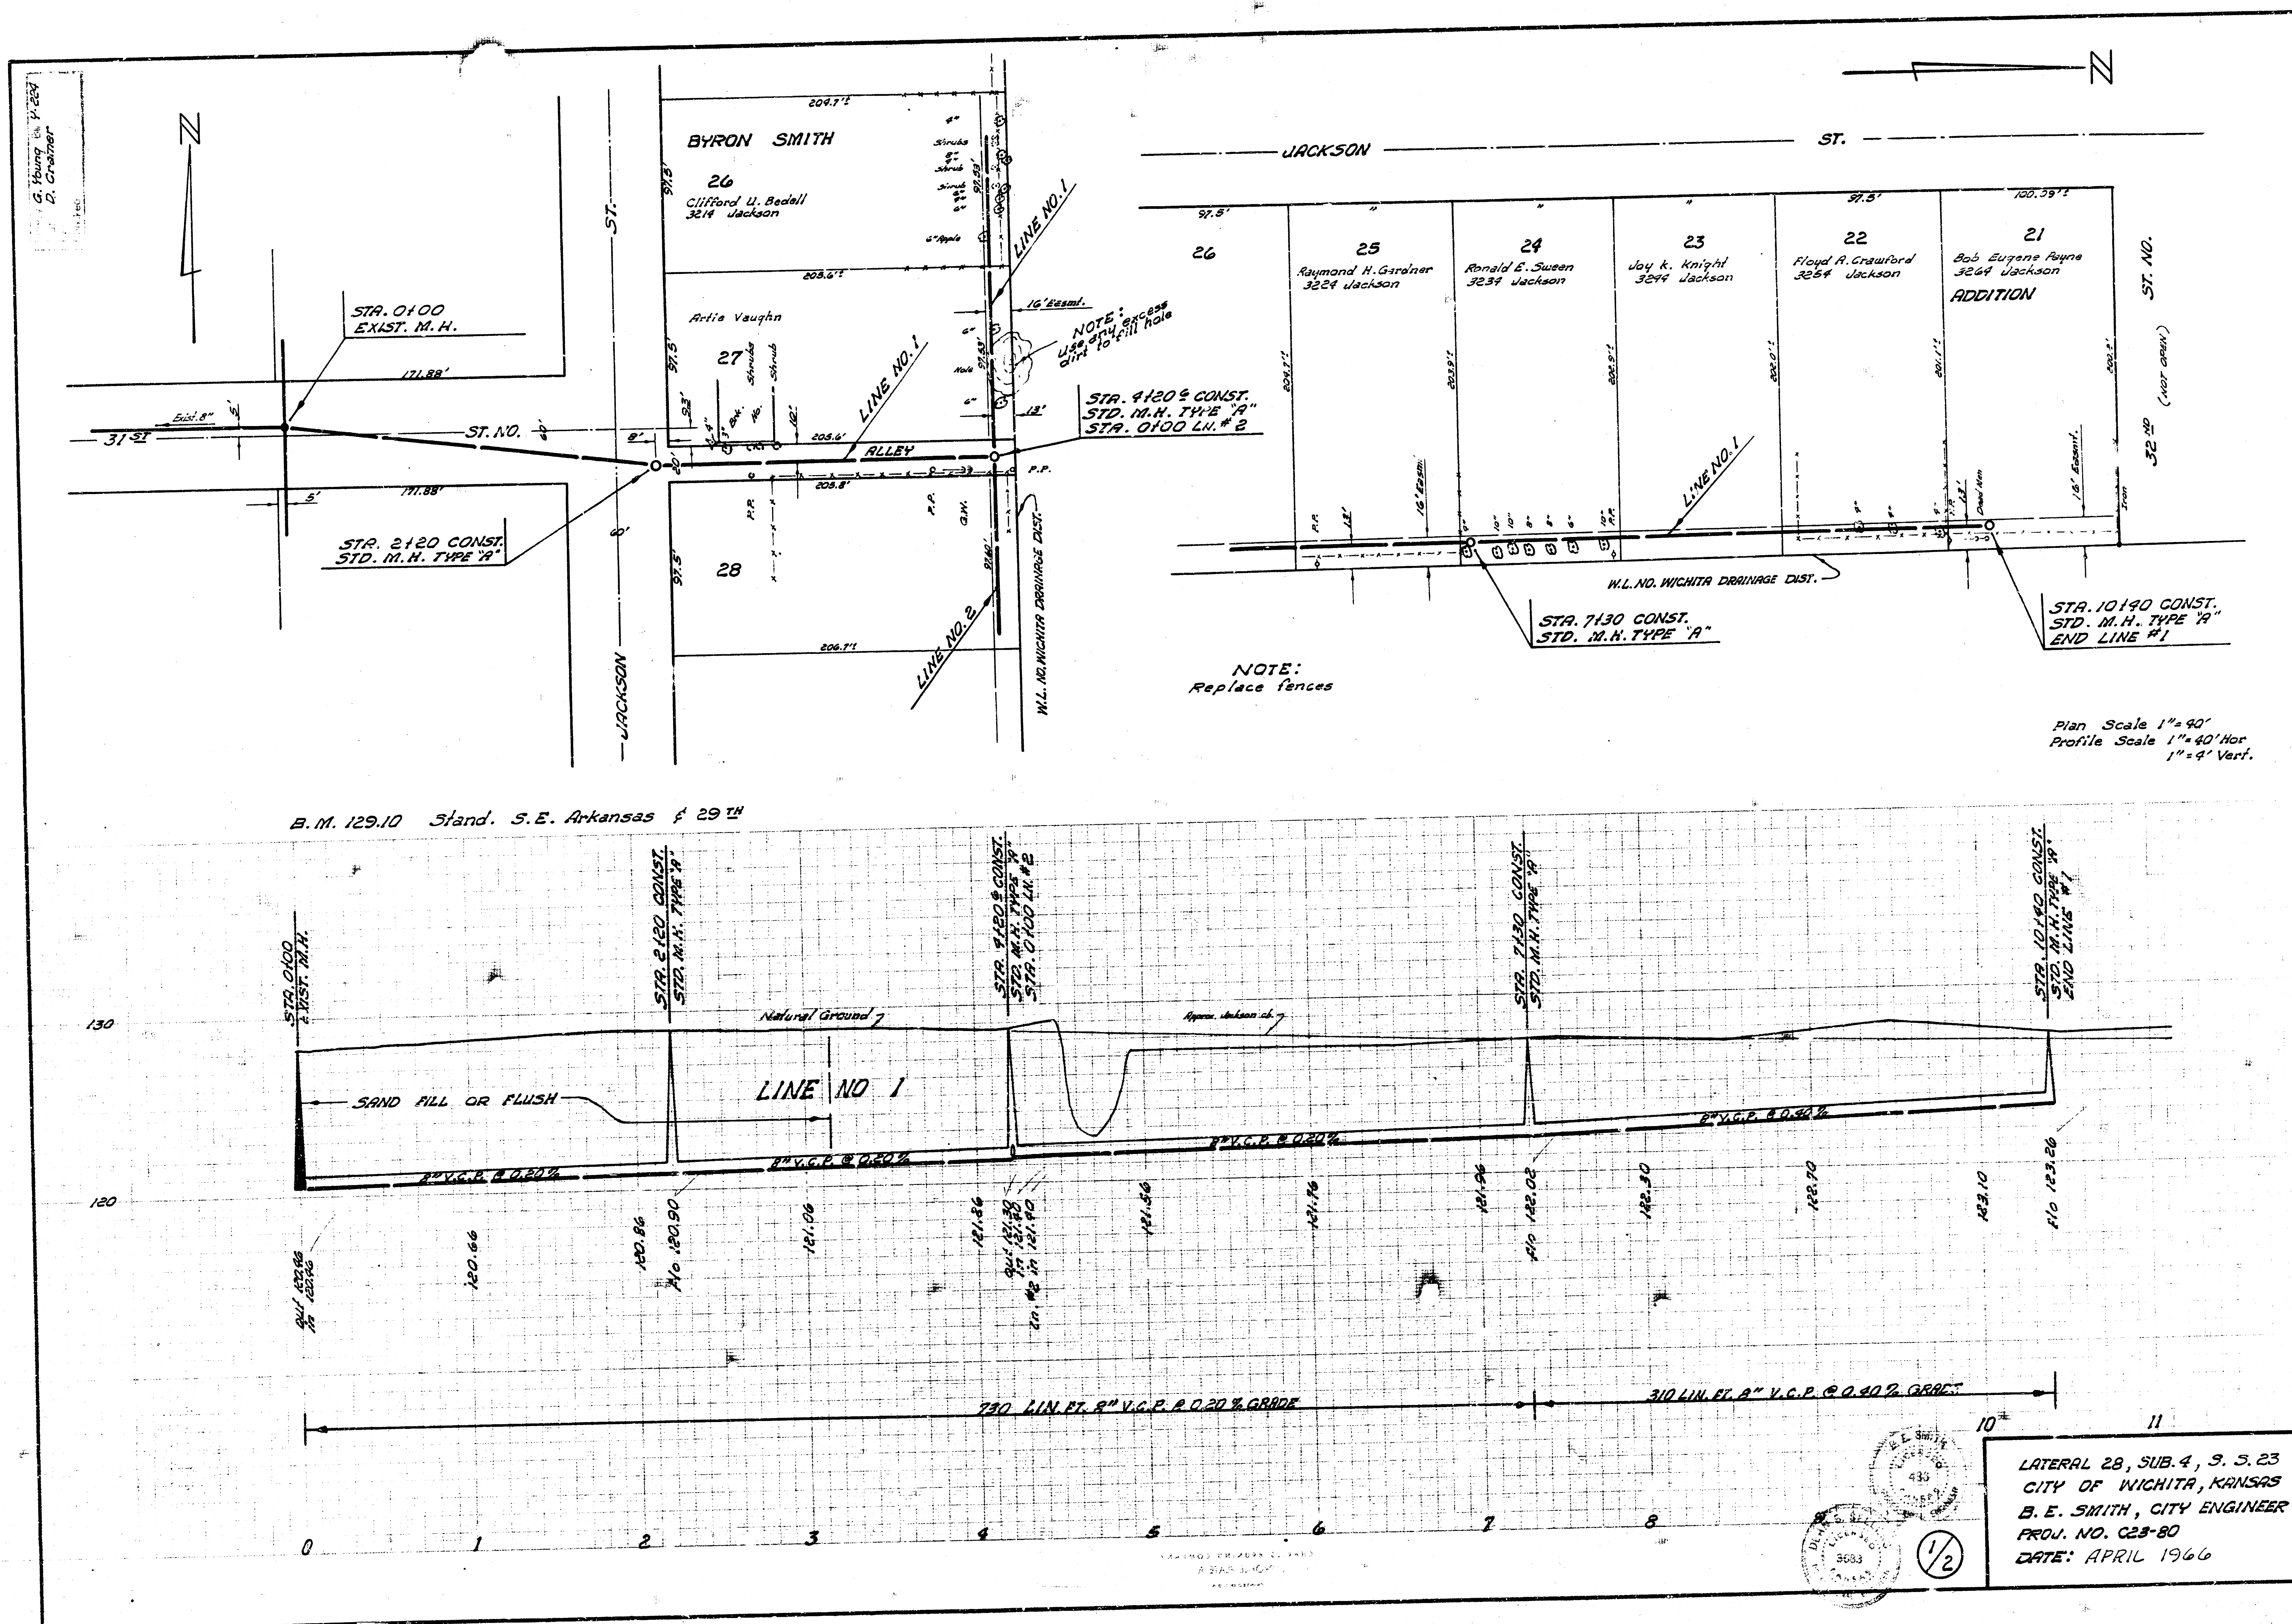



STA. 0+00 LN. #2  
STA. 9+20 LN. #1

W.L. NO. WICHITA DRAINAGE DIST.

STA. 2+90 CONST.  
STD. M. H. TYPE "A"

FIELD ENGINEER  
Alter alignment  
to miss fish pond

STA. 5+40 CONST.  
STD. M. H. TYPE "A"  
END LINE #2

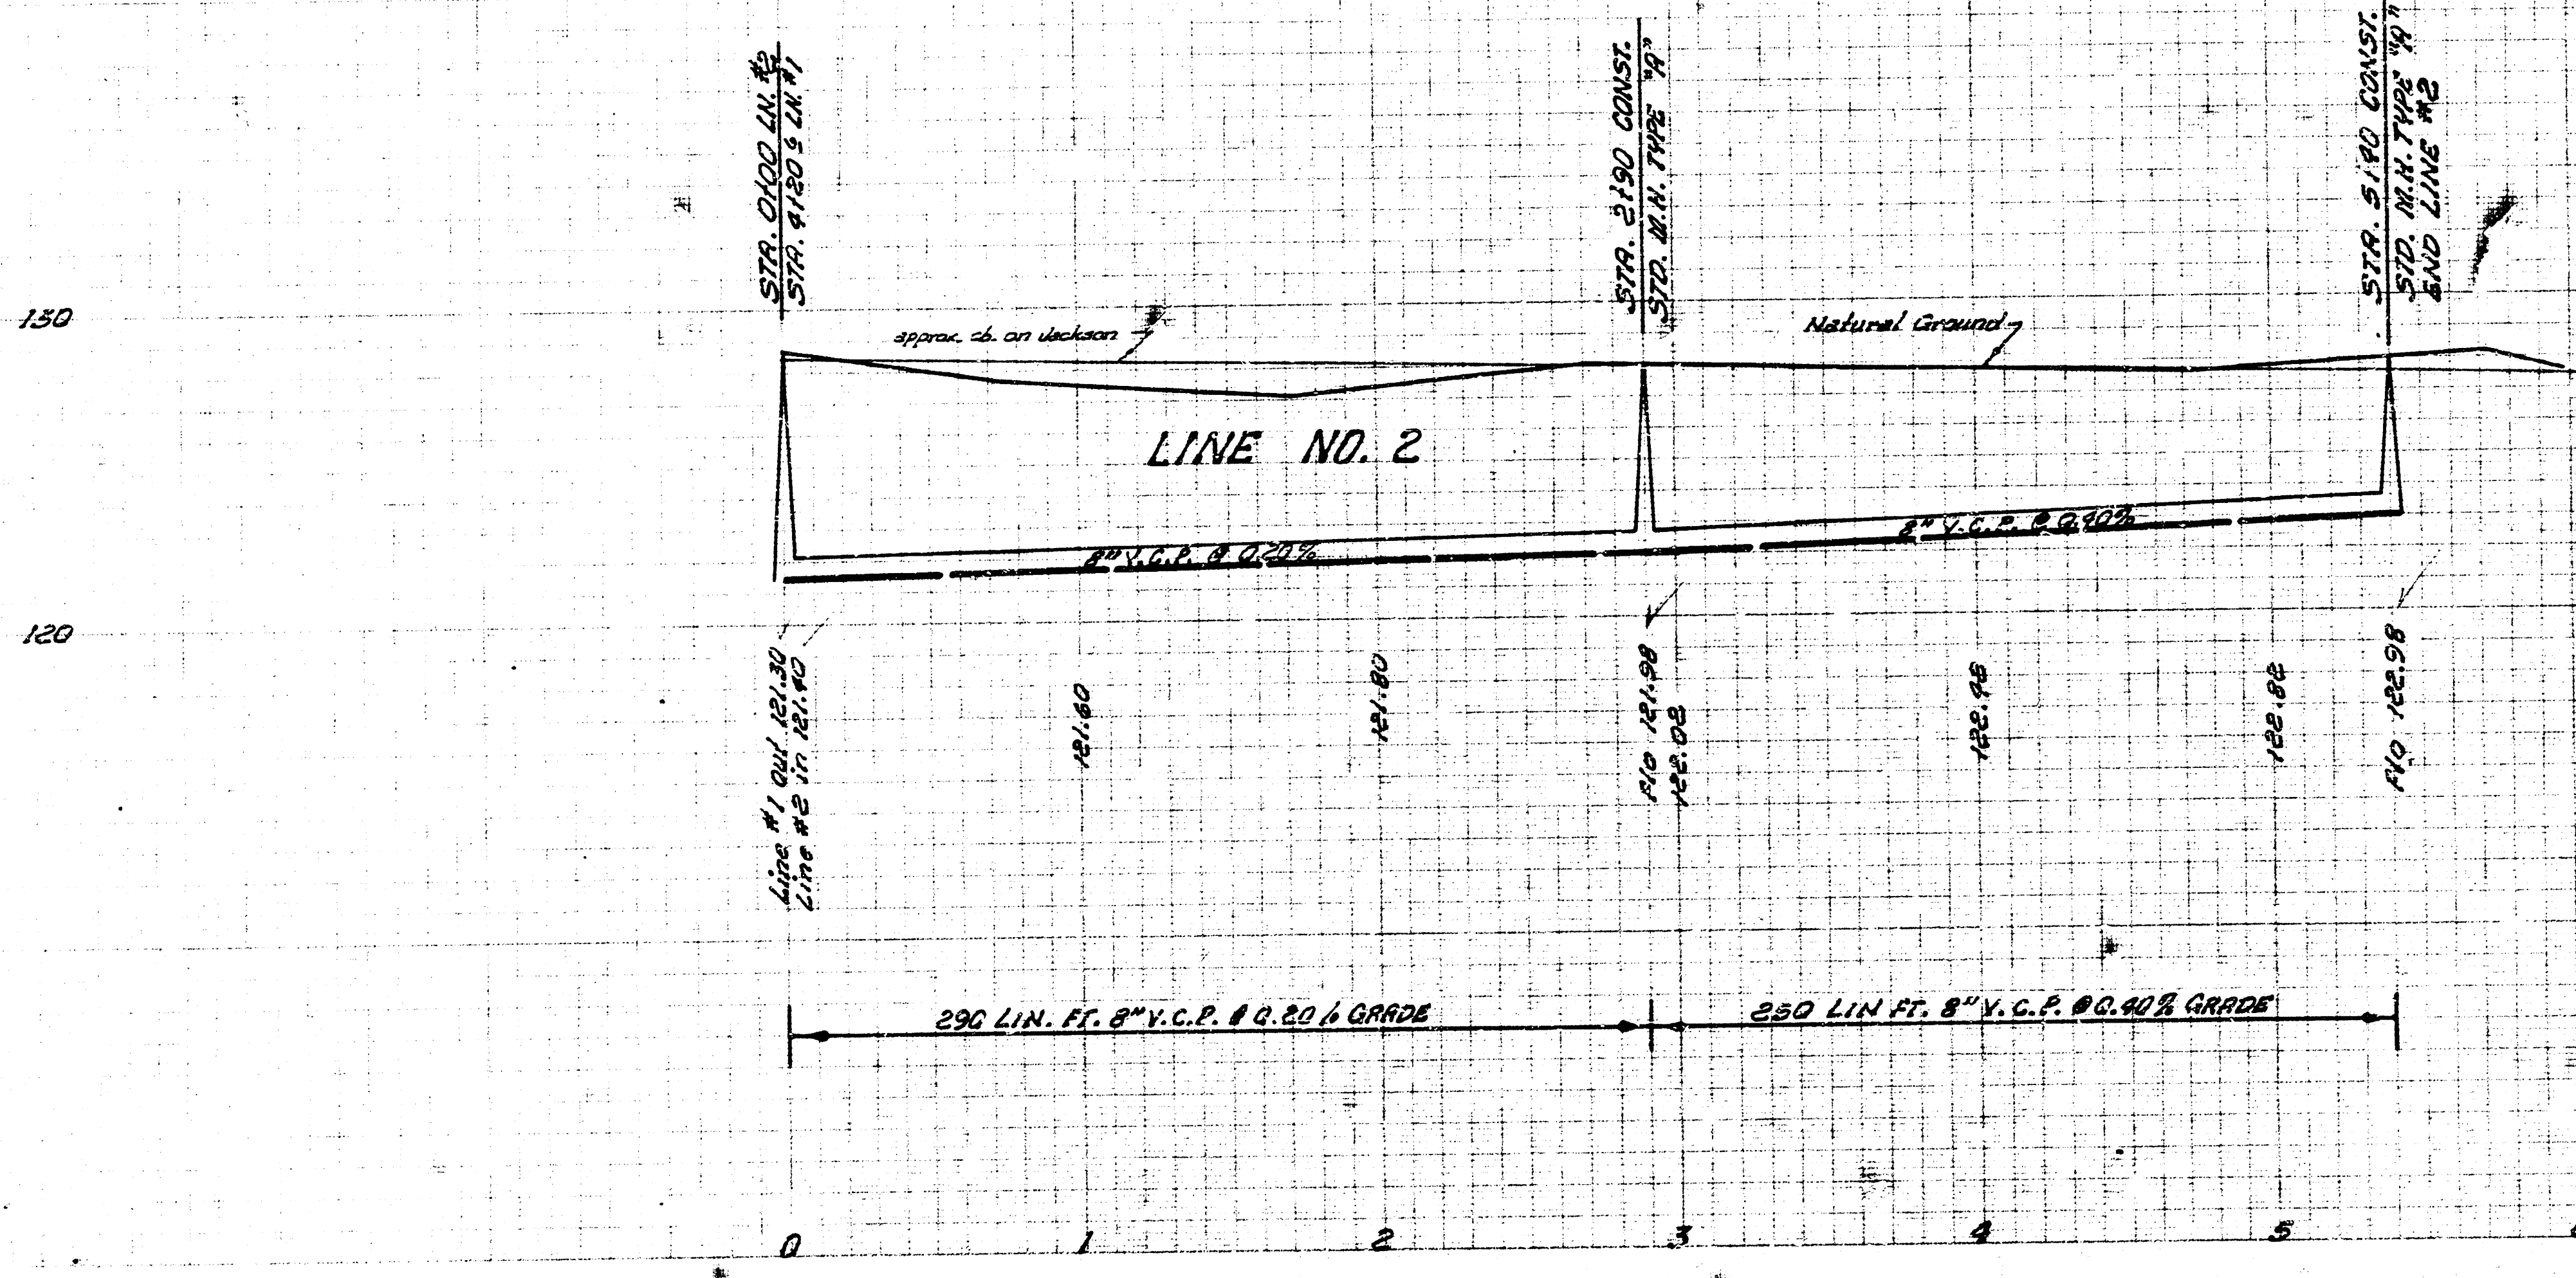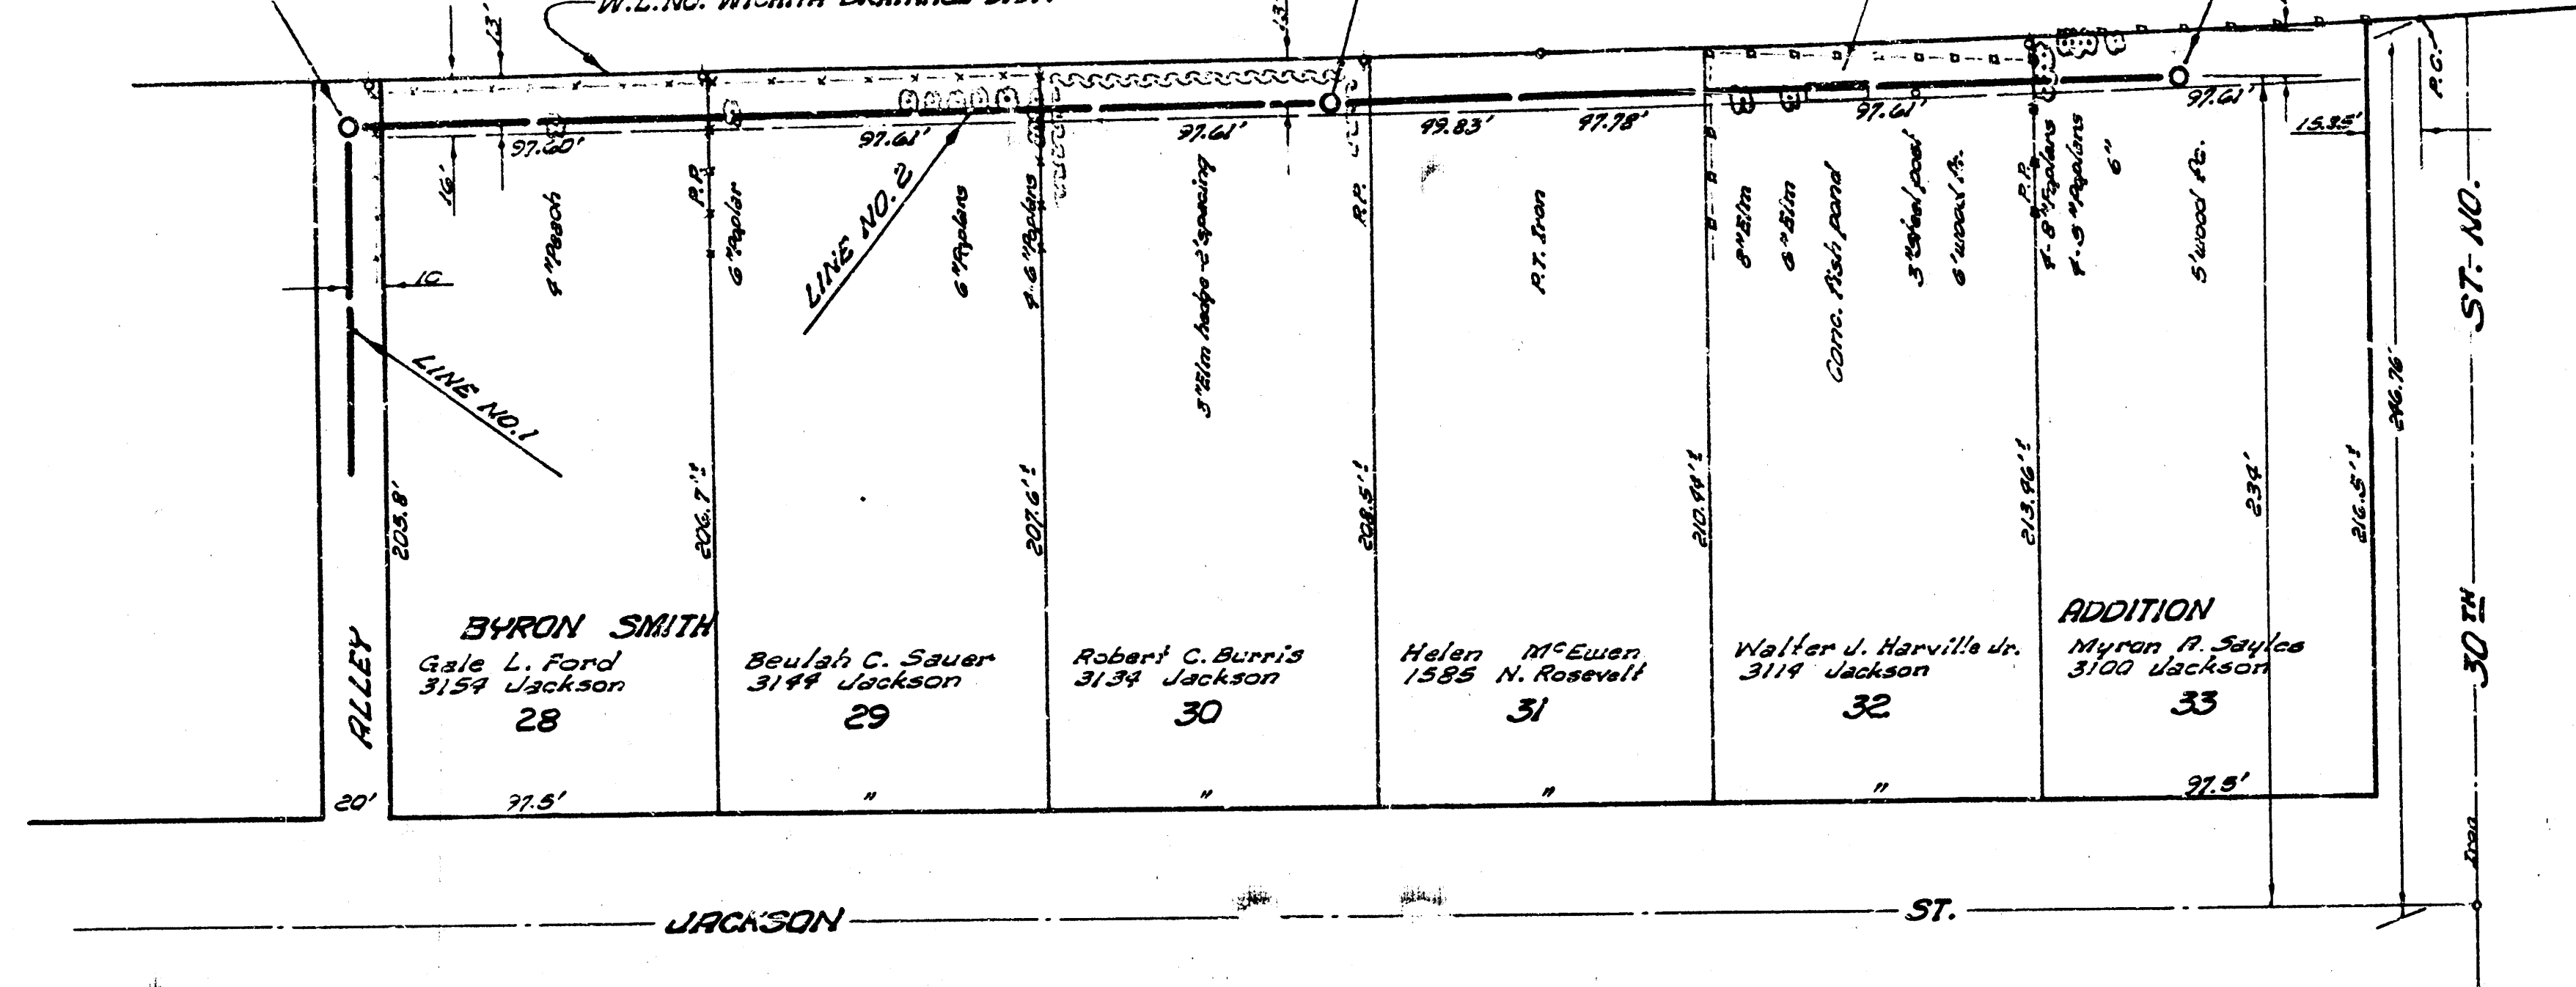

2/2

LAT. 28, SUB. 4, S.S. NO. 23  
PROJ. NO. C23-80

3 15 1 1