




Survey Station 24+00.00

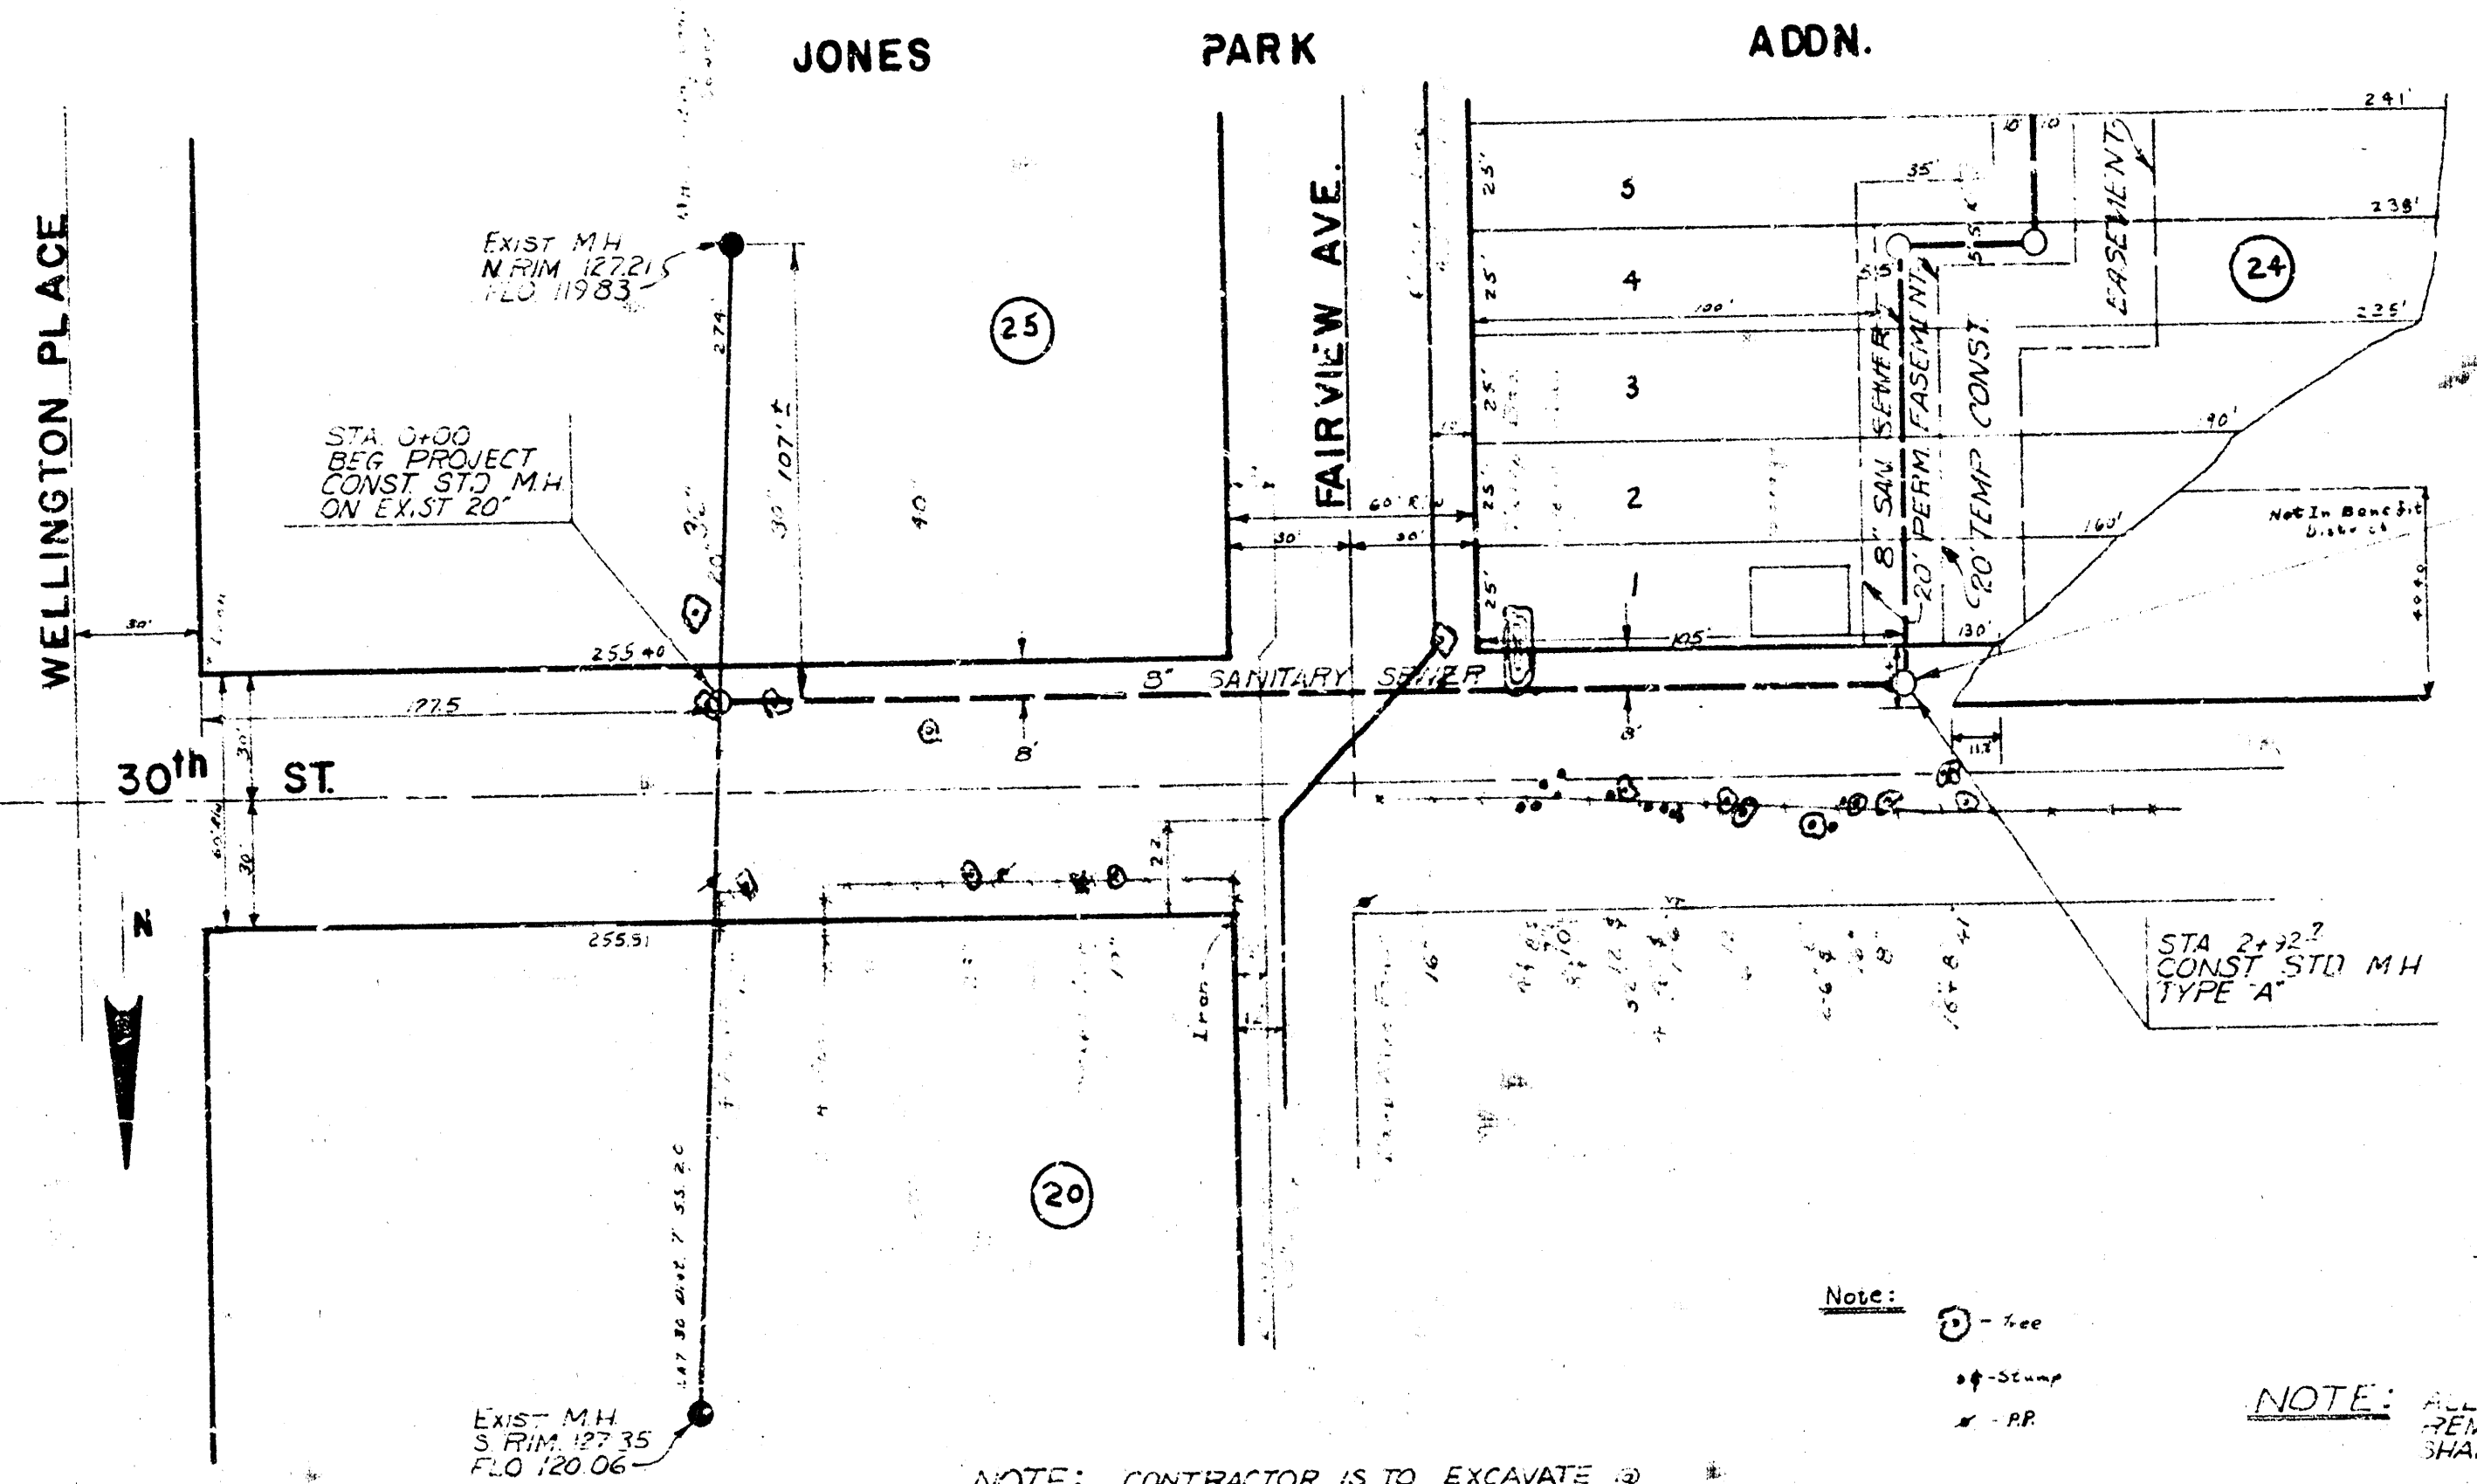

PLAN SCALE 1"=40'
PROFILE SCALE 1"=40' HORIZ.
1"=50' VERT.

NOTE: CONTRACTOR IS TO EXCAVATE TO 24+00.00 PRIOR TO CONSTRUCTION. FIELD ENGINEER CAN VERIFY FLO ELEVATION OF 20" SAN. SEWER.

NOTE: ALL FENCES & CLOTHESLINE POLES REMOVED DURING CONSTRUCTION SHALL BE REPLACED BY CONTRACTOR.

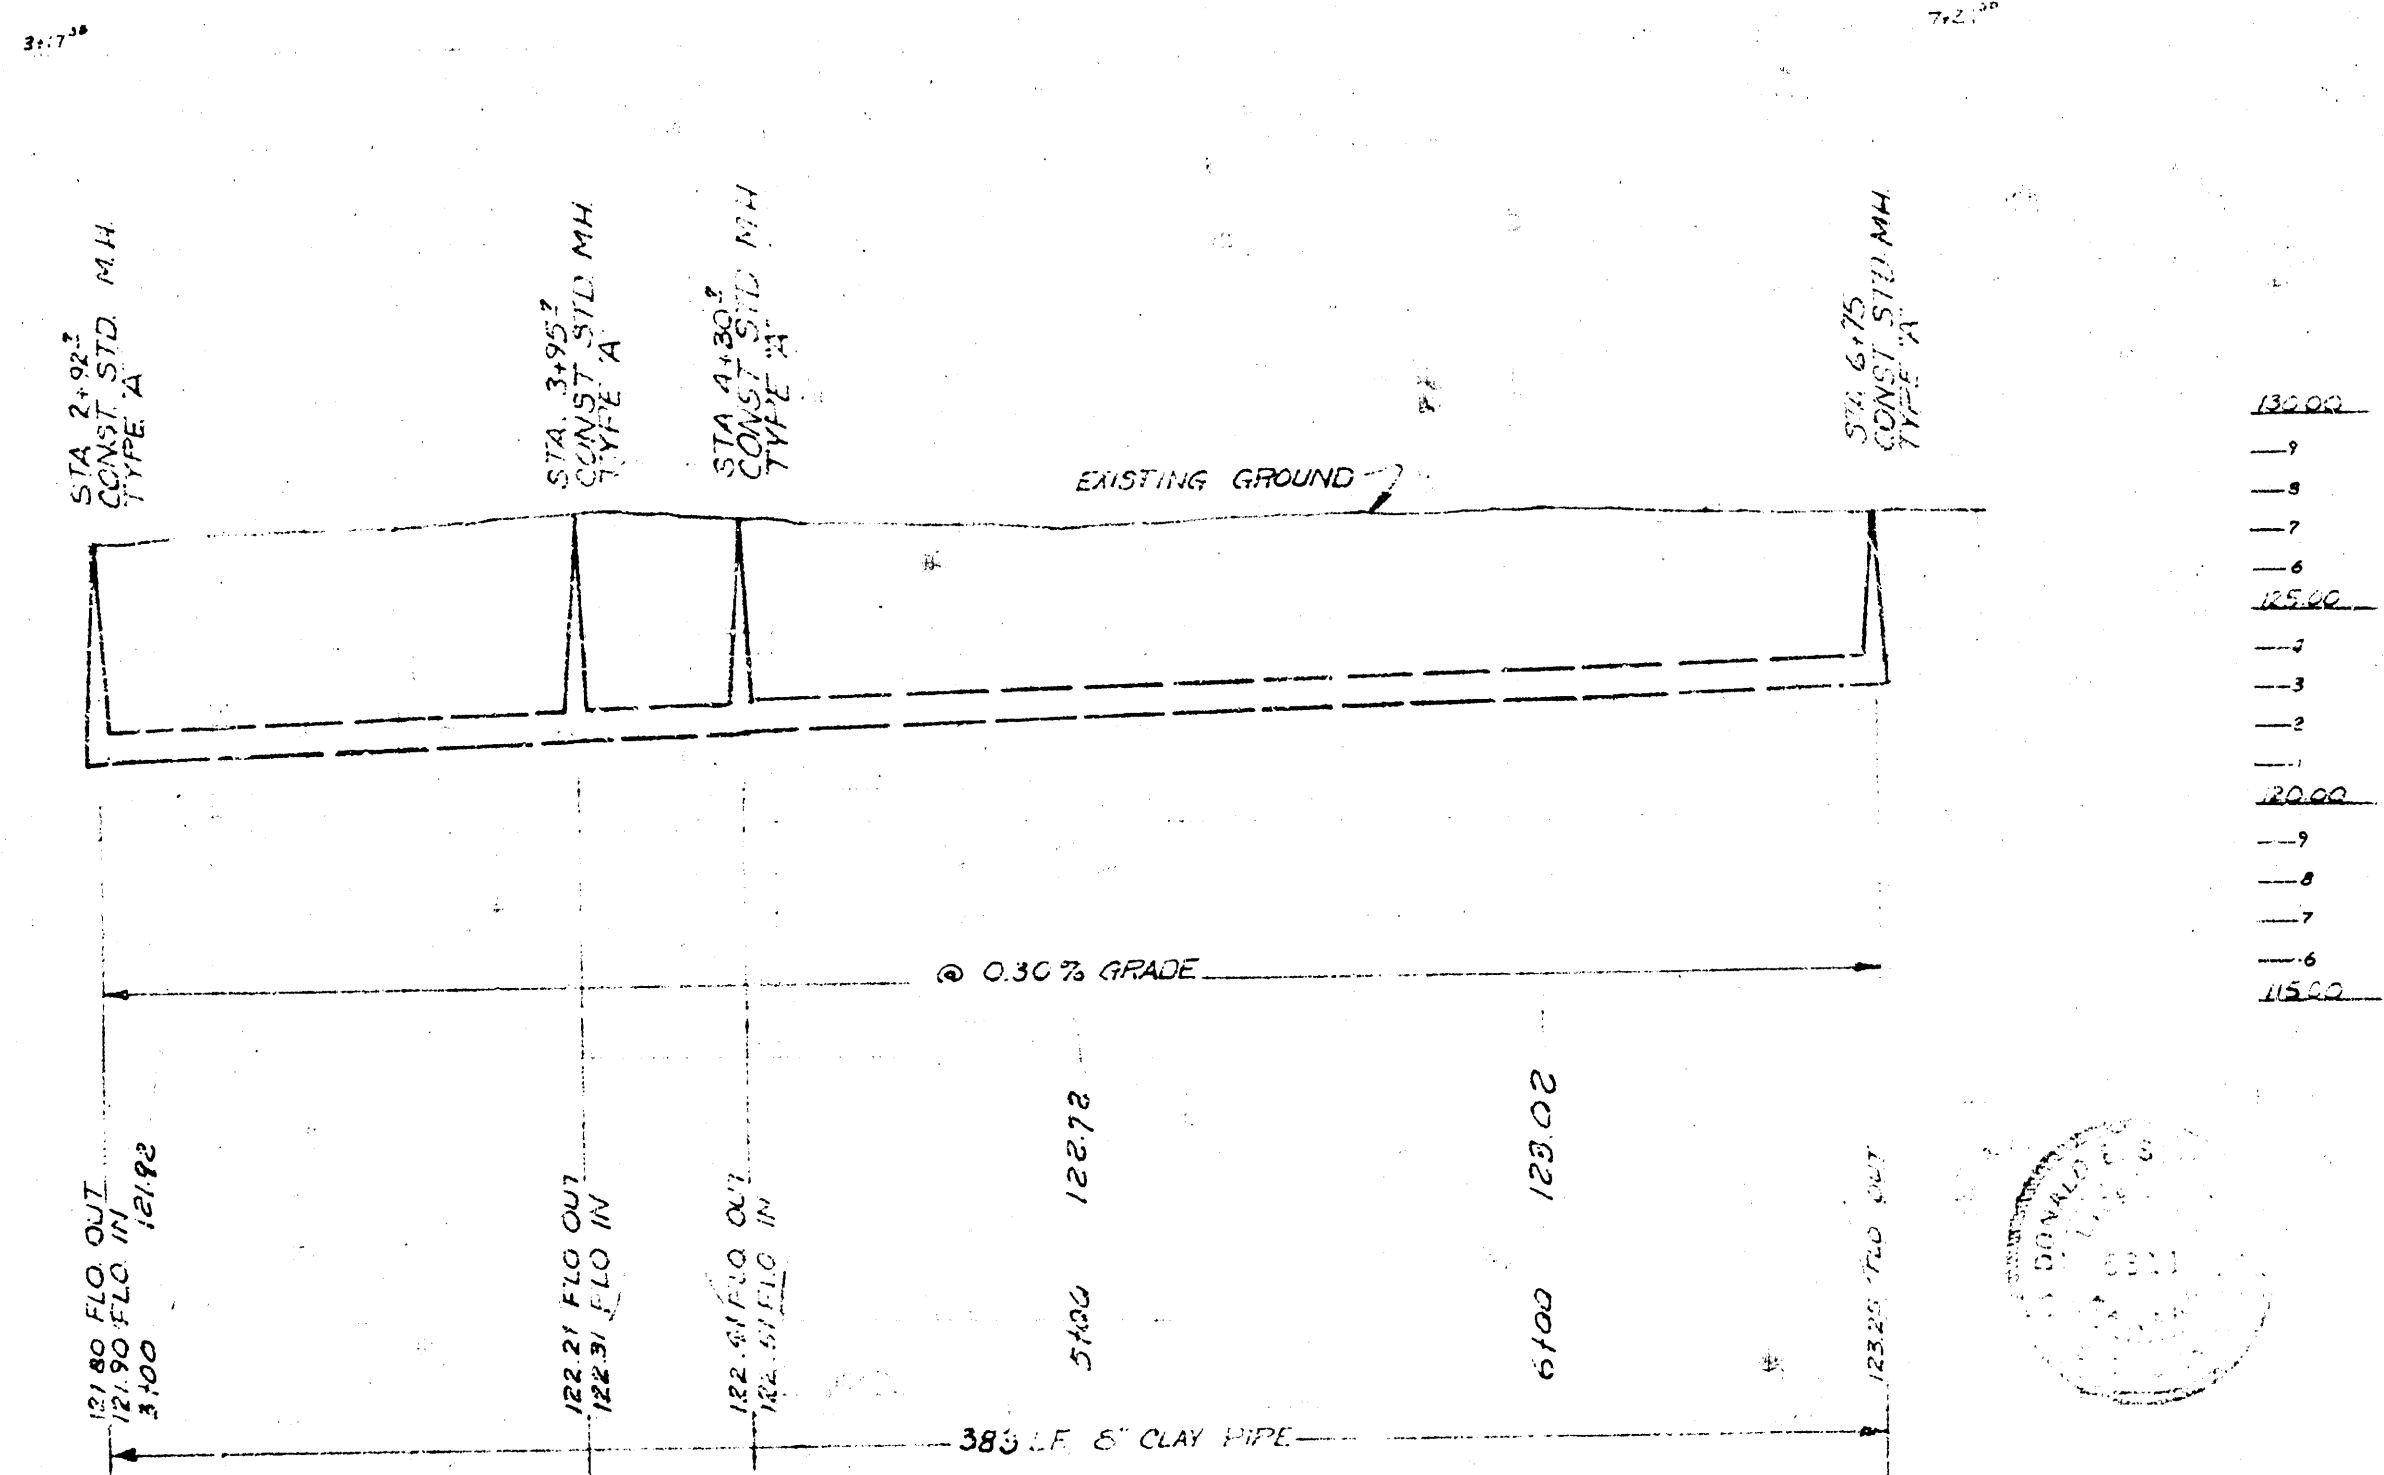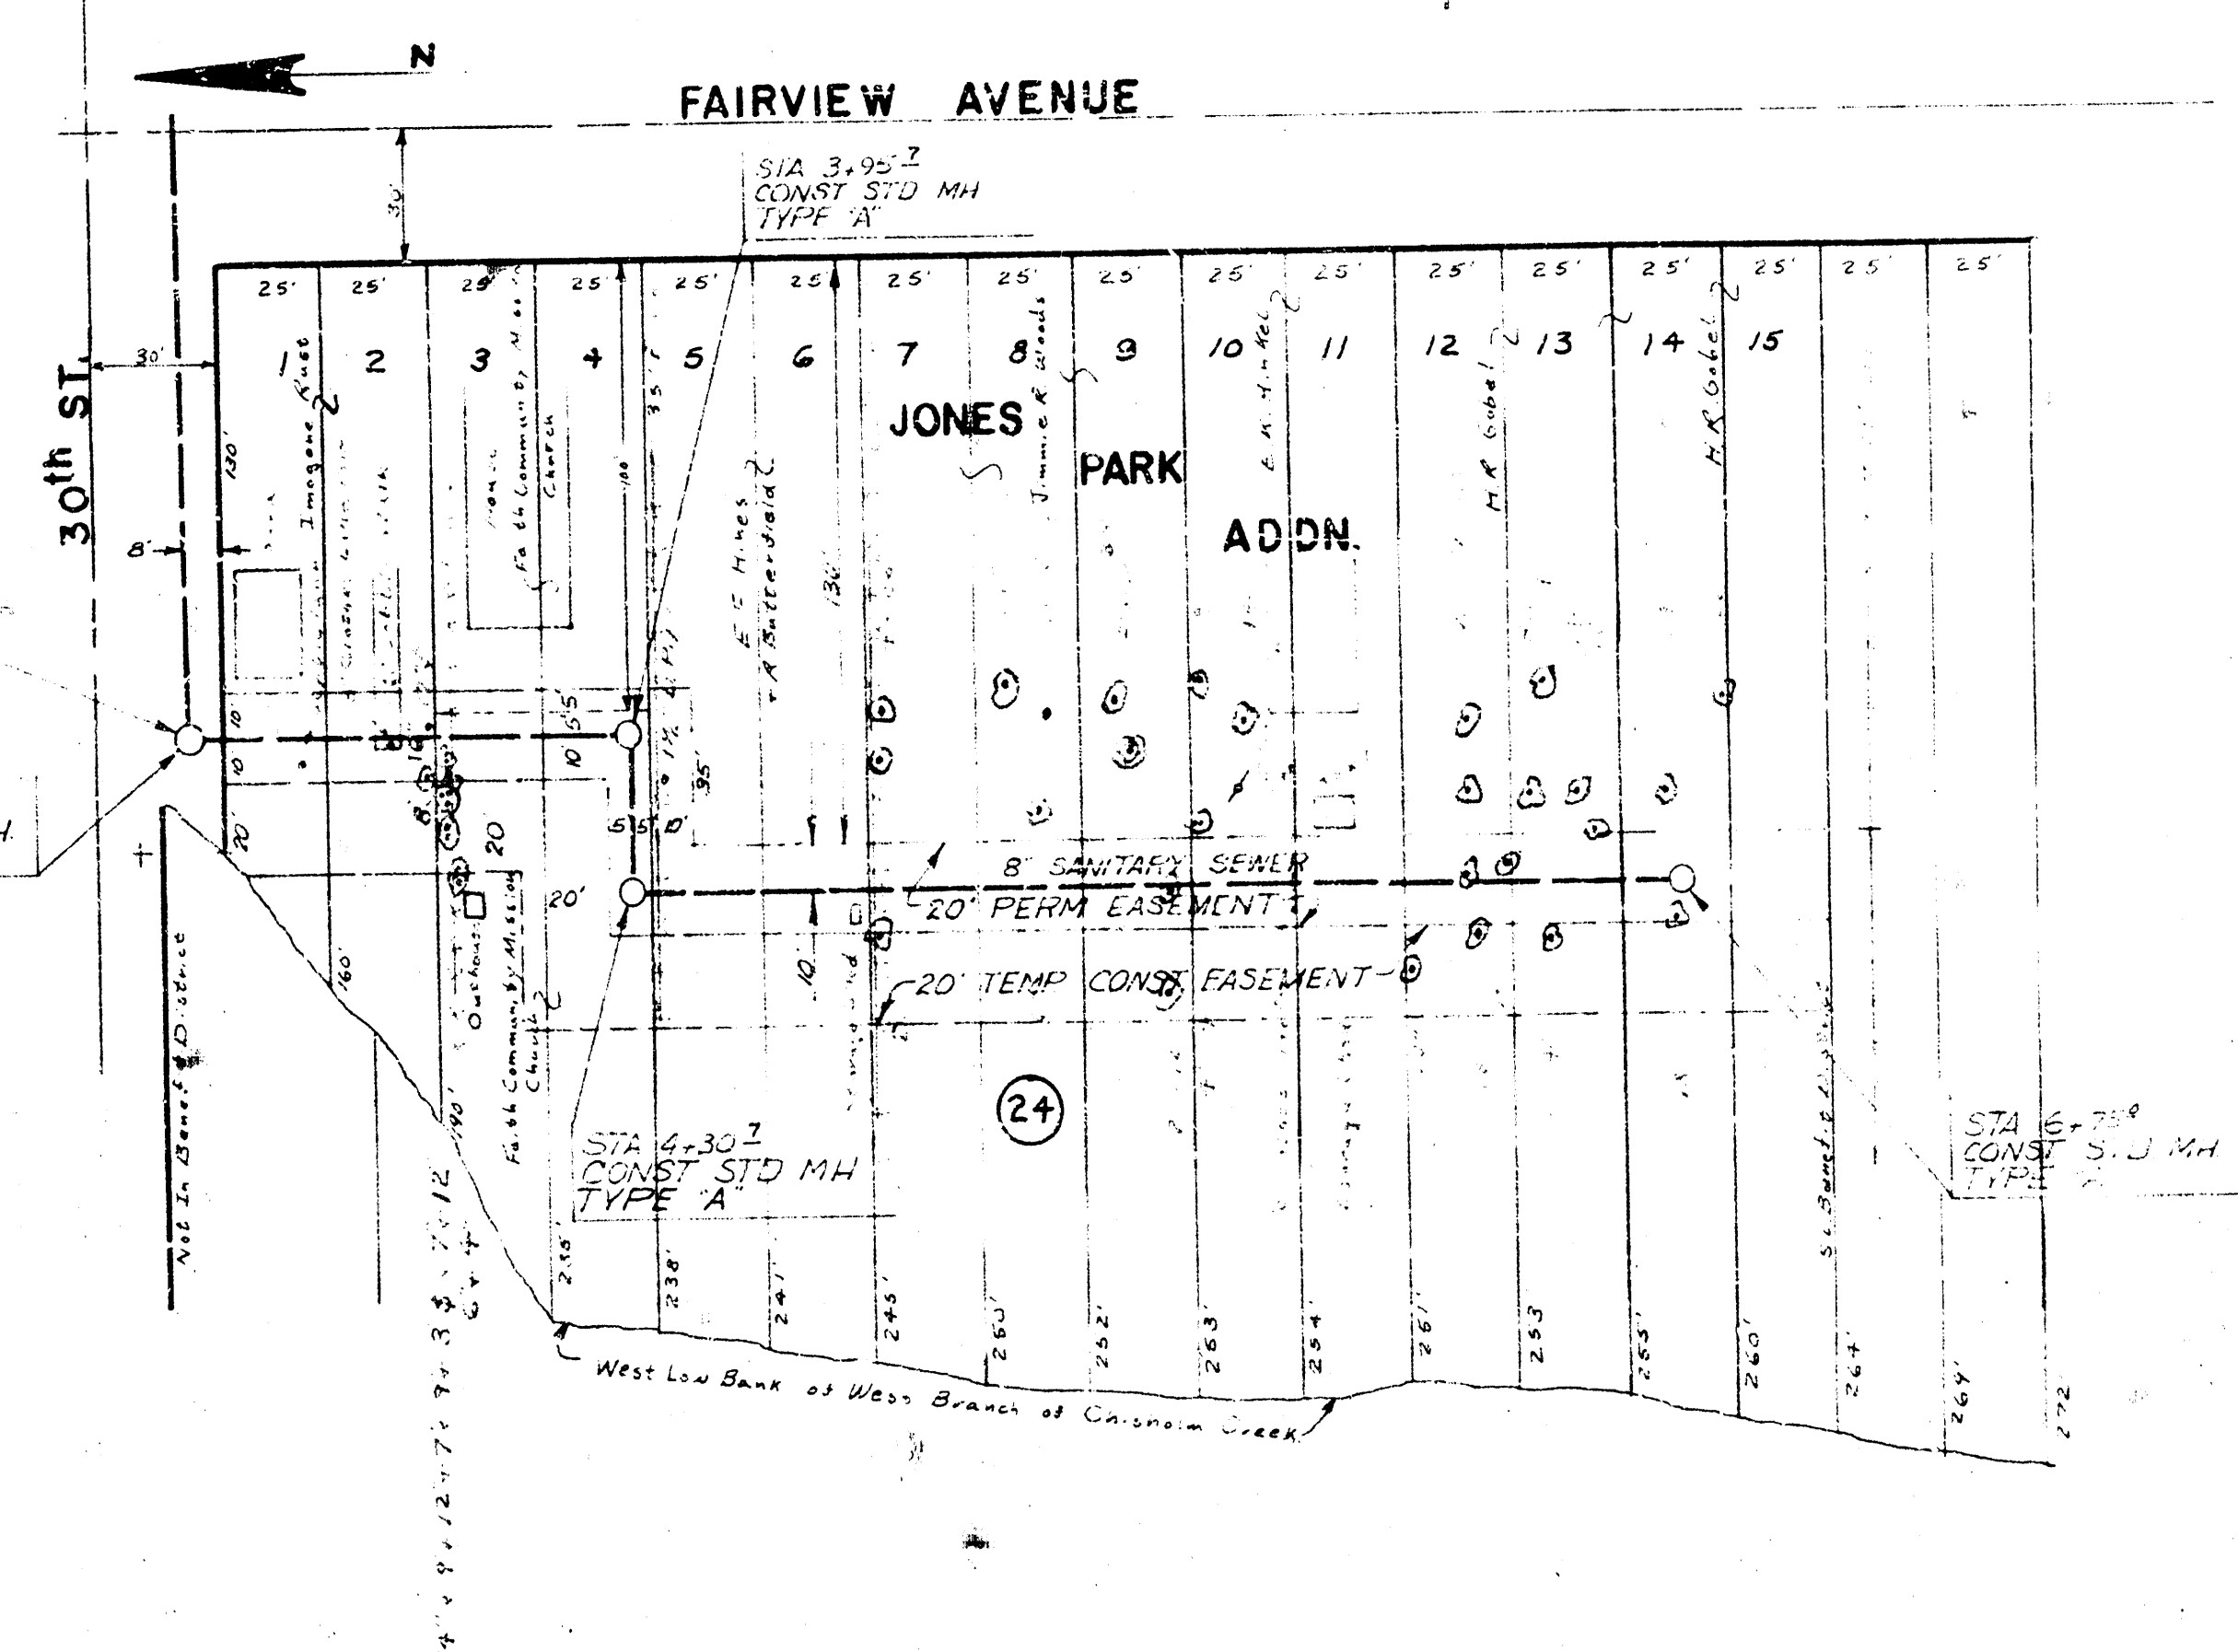

LAT 80, MAIN 4, S.S. 23
CITY OF WICHITA, KANSAS
R.W. LINN, CITY ENGINEER
PROJ. NO. DBKL 573004
DATE:

AS BUILT FINAL MEASUREMENTS

14 3 1 0