


CONSTRUCTION PLANS FOR
LATERAL 119, MAIN 4
OF THE

SANITARY SEWER 23

THE CITY OF WICHITA,
SEDGWICK COUNTY, KANSAS
MICHAEL E. LINDEBAK, P.E. CITY ENGINEER

As Built
JLL
12-85

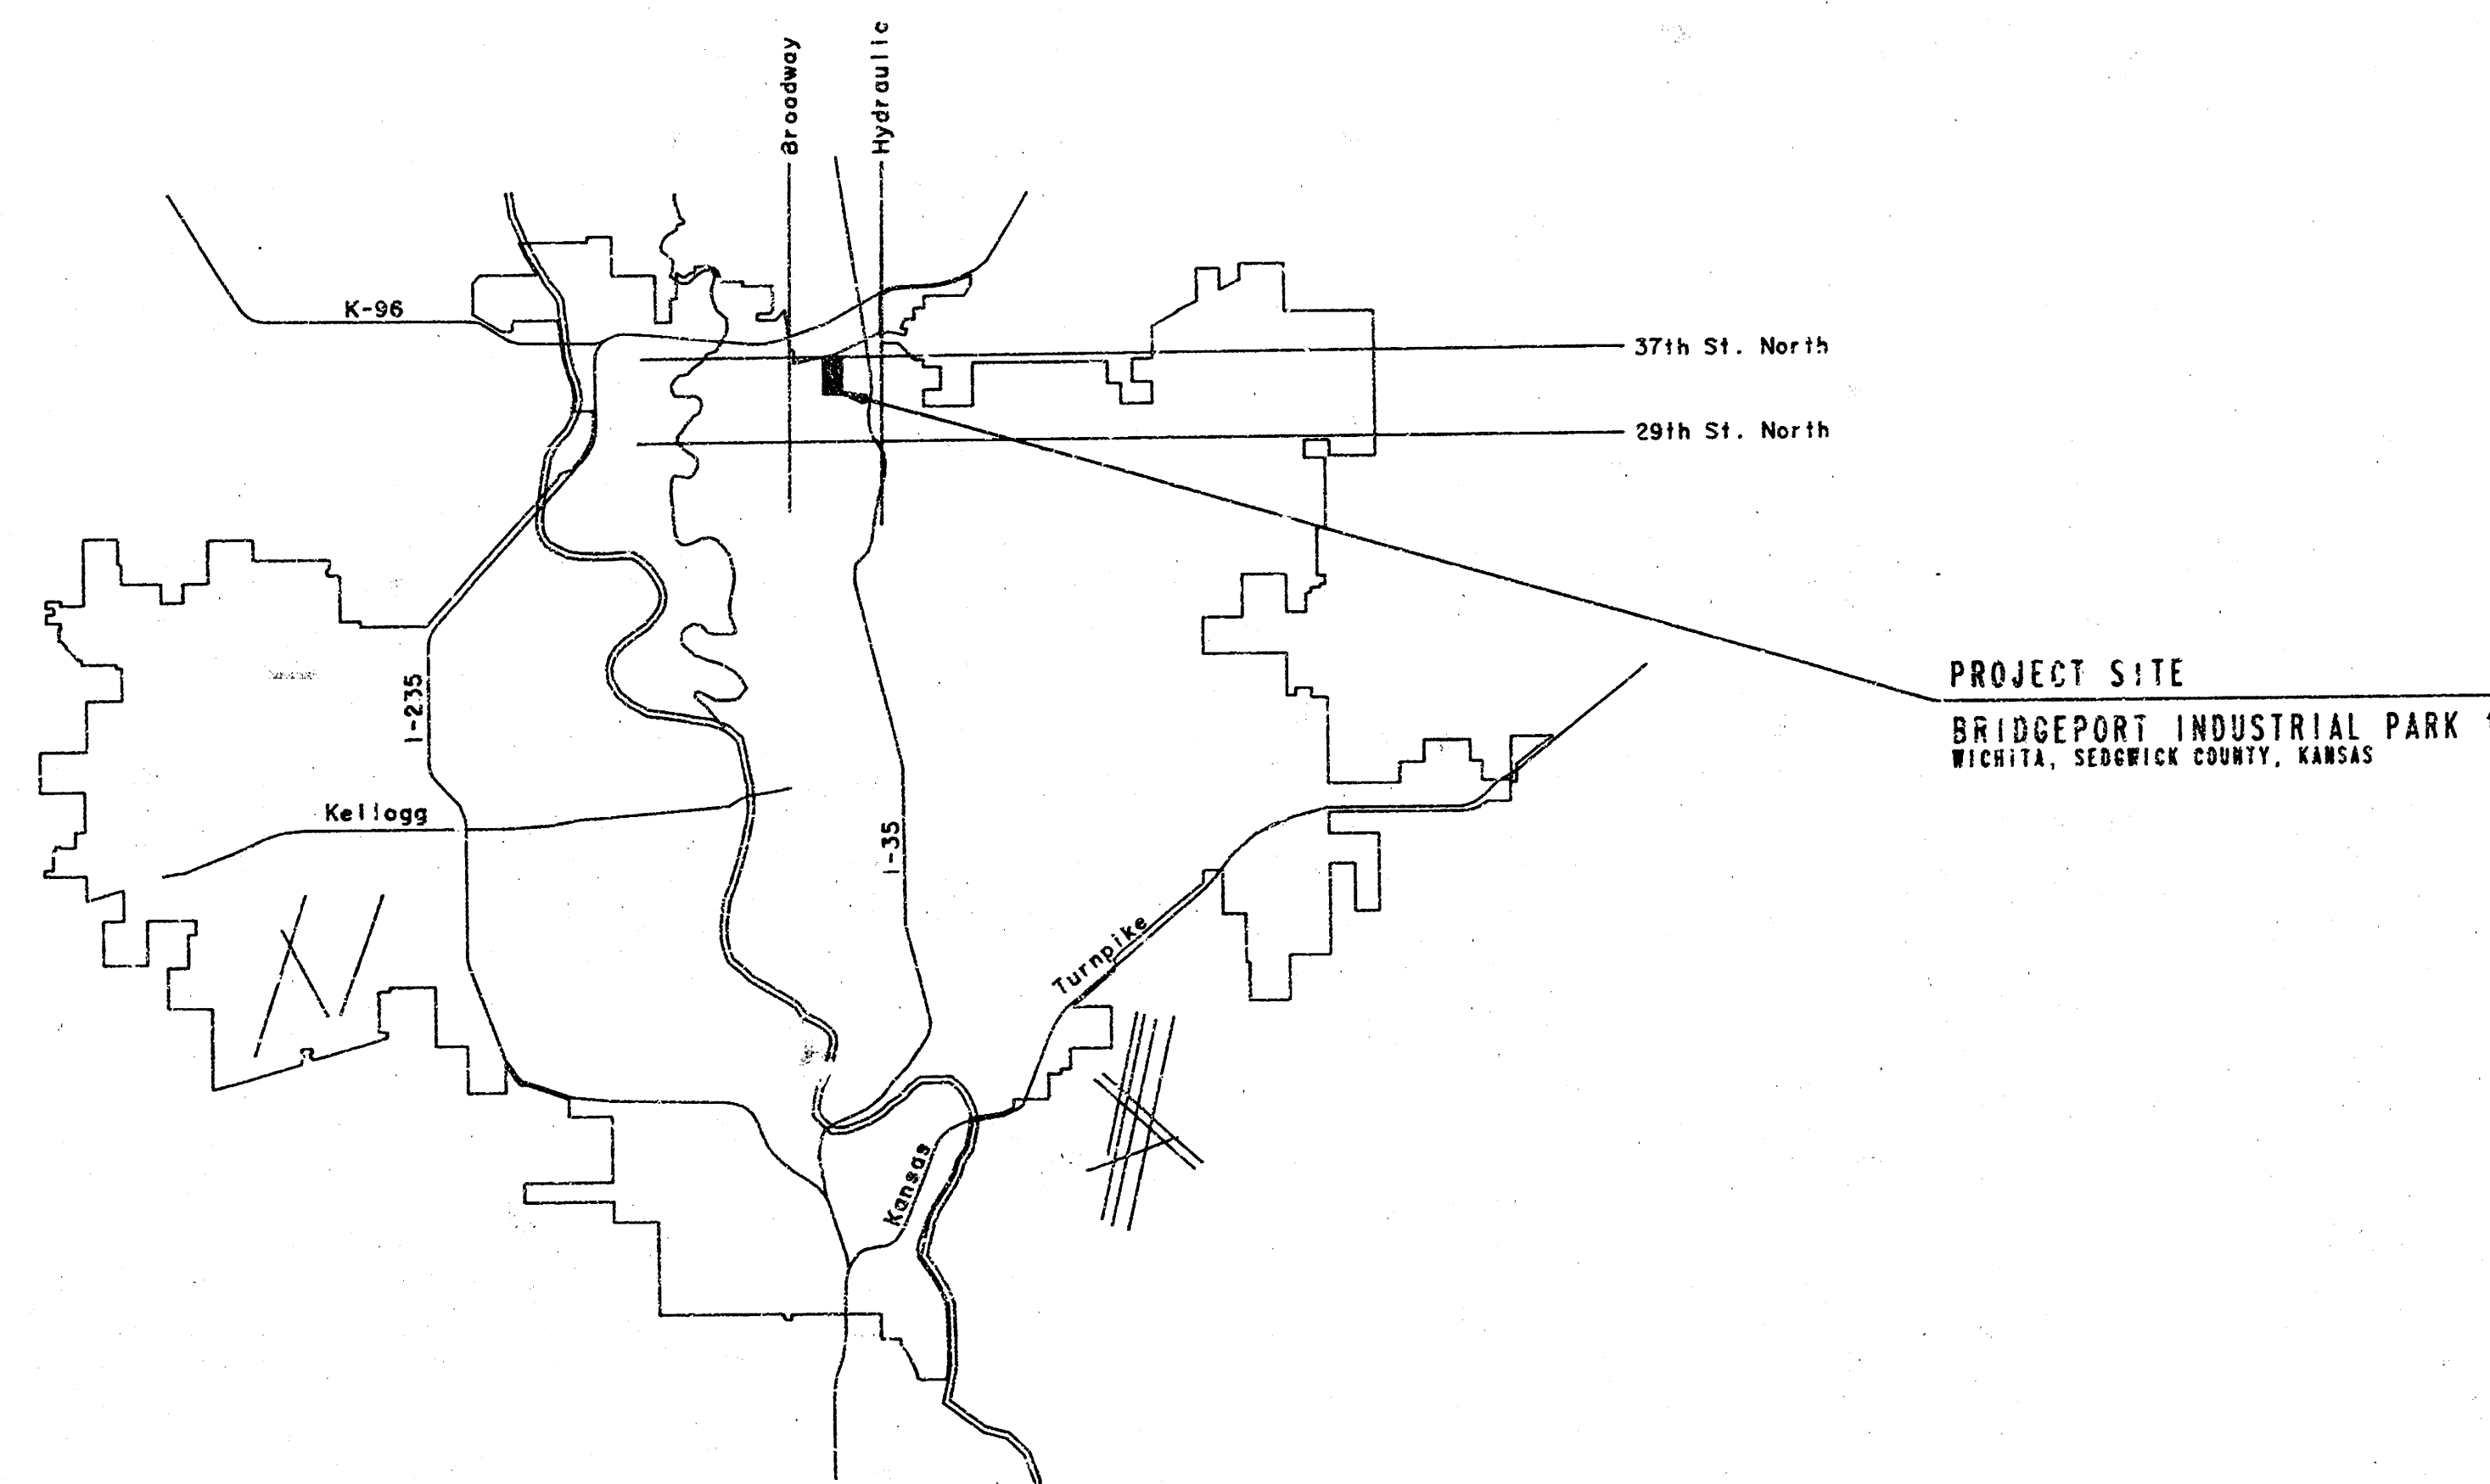



LOCATION MAP

CITY OF WICHITA PROJECT NO. 468-76-245-81404-000-000-001

APRIL, 1985

PLANS PREPARED BY
PROFESSIONAL ENGINEERING CONSULTANTS, P.A.
ENGINEERS
WICHITA, KANSAS



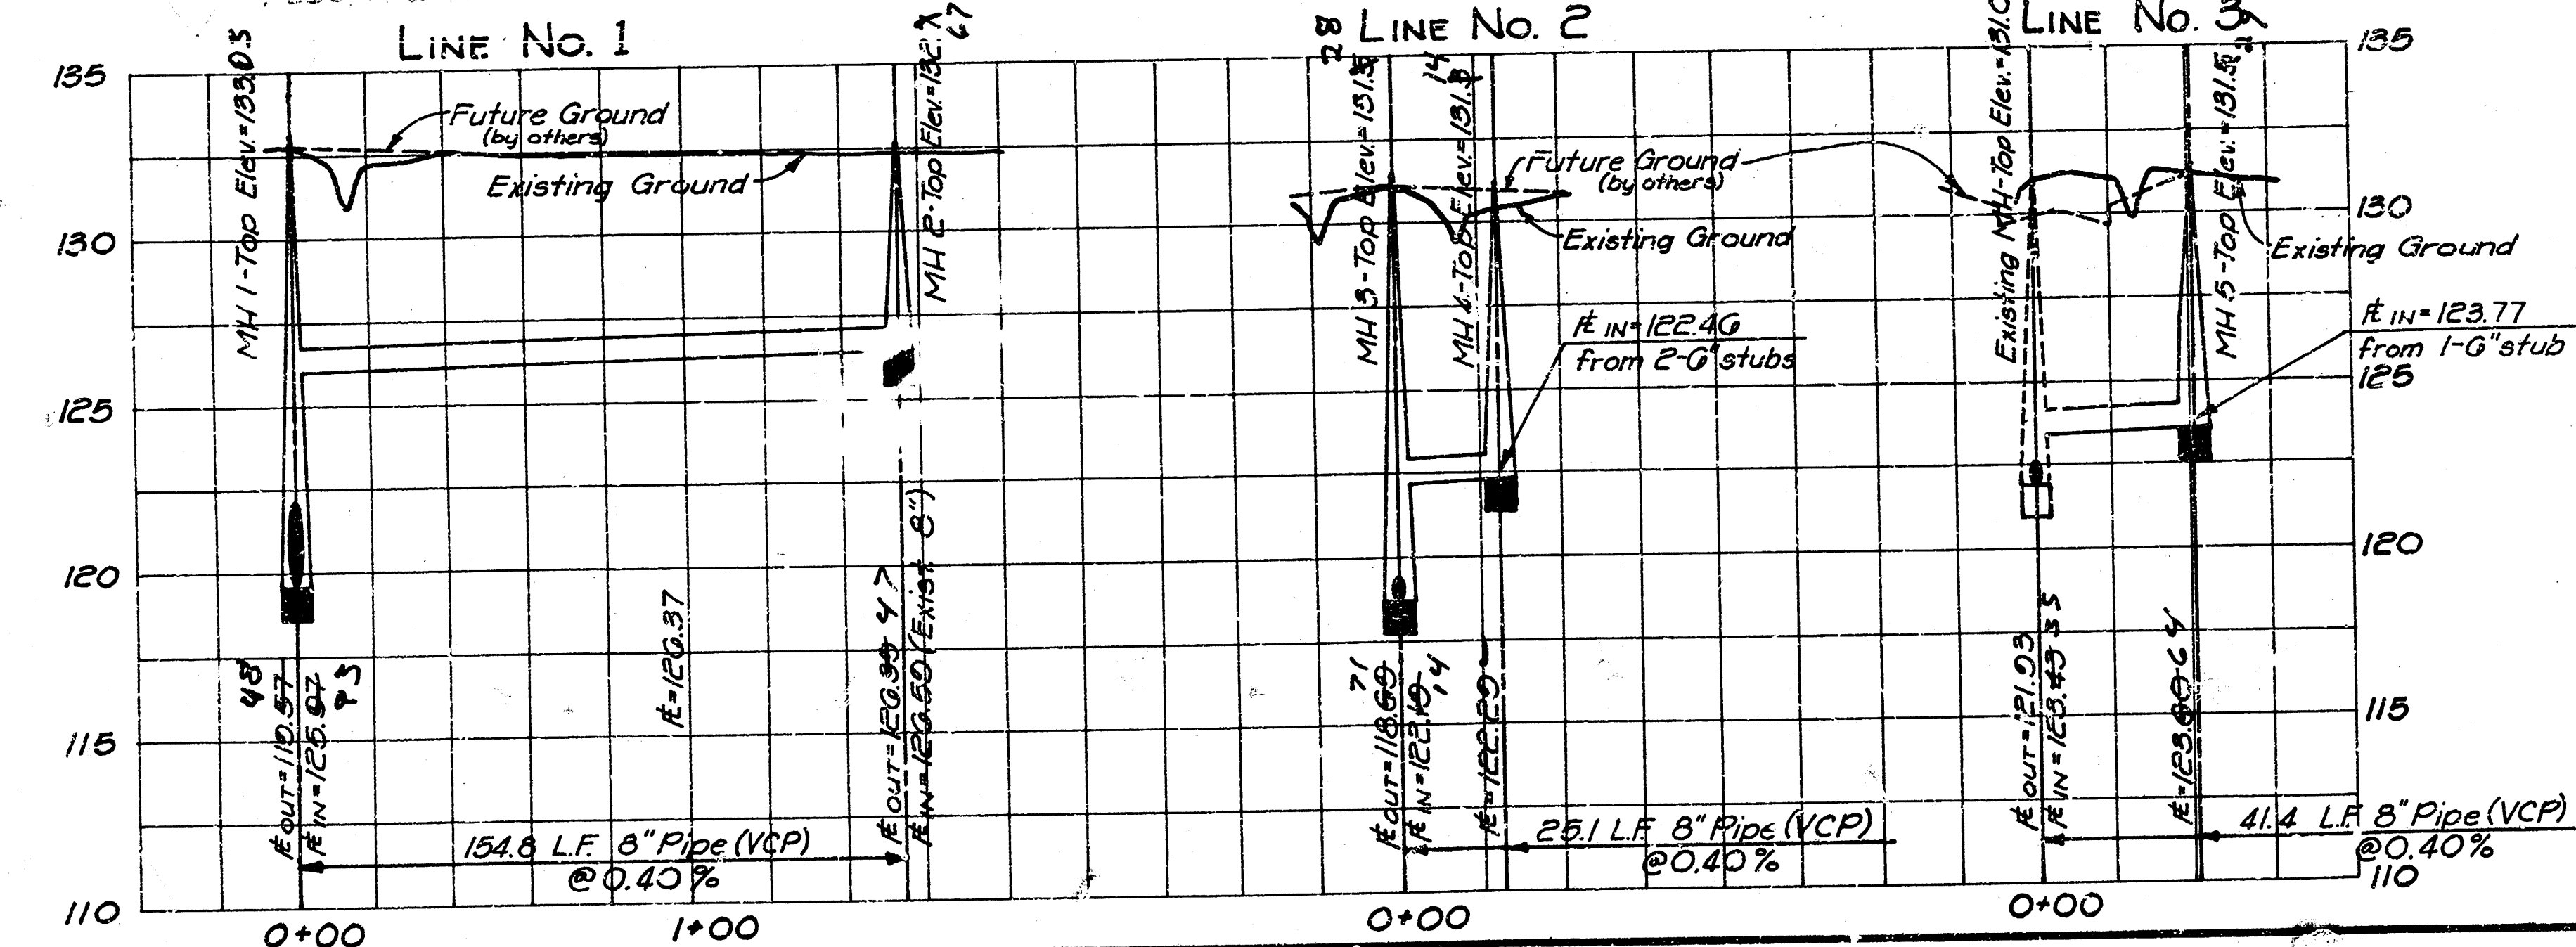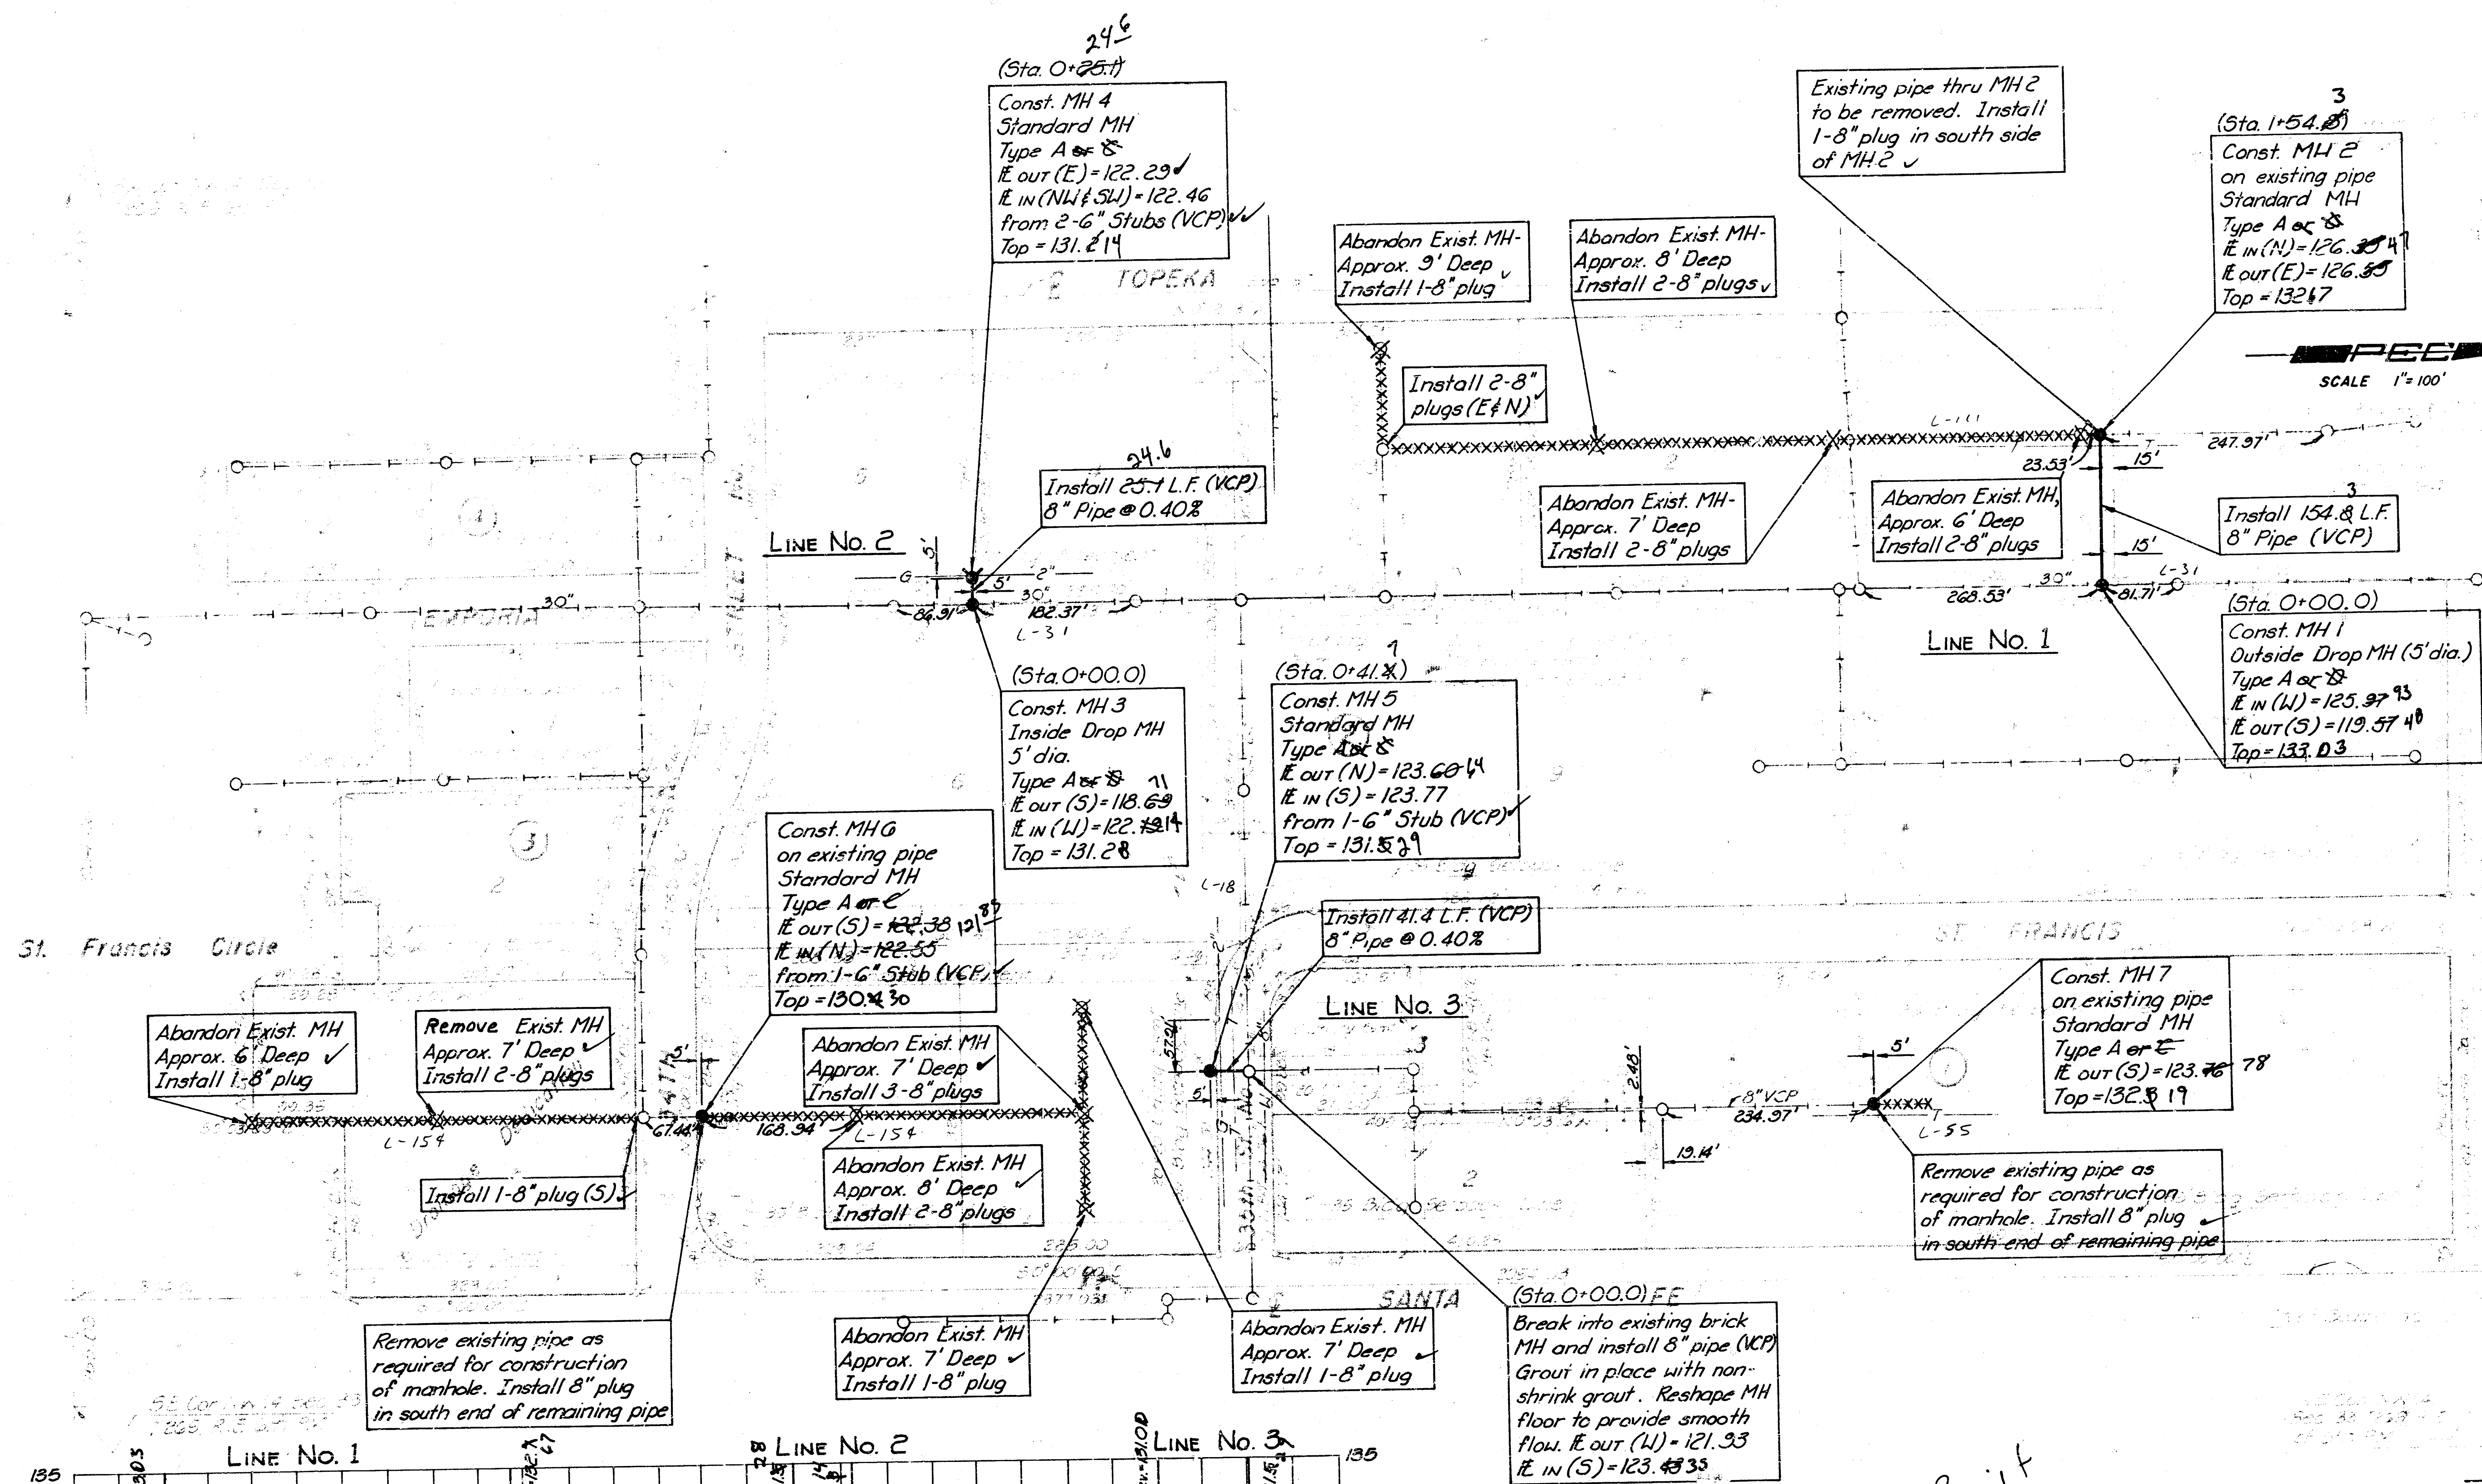

As Built
JLL
12-85

LEGEND

***** Indicates Pipe and Manhole to be abandoned in place

--- Existing Sanitary Sewer and Manhole

--- Proposed Sanitary Sewer and Manhole

	Revision No. _____ Date _____	
	CITY OF WICHITA, KANSAS LATERAL 119, MAIN 4 OF SANITARY SEWER 23 MICHAEL E. LINDEBAK, P.E. CITY ENGINEER CITY OF WICHITA PROJECT NO. 468-76-245-81404-000-001 PROFESSIONAL ENGINEERING CONSULTANTS, P.A. ENC. WEARS WICHITA, KANSAS	
	Designed by BDR, RFJ Drawn by DDM	Job No. 34-83700 Date April 1985
	Sht. 2 of 2	