



Scale 1"=20'

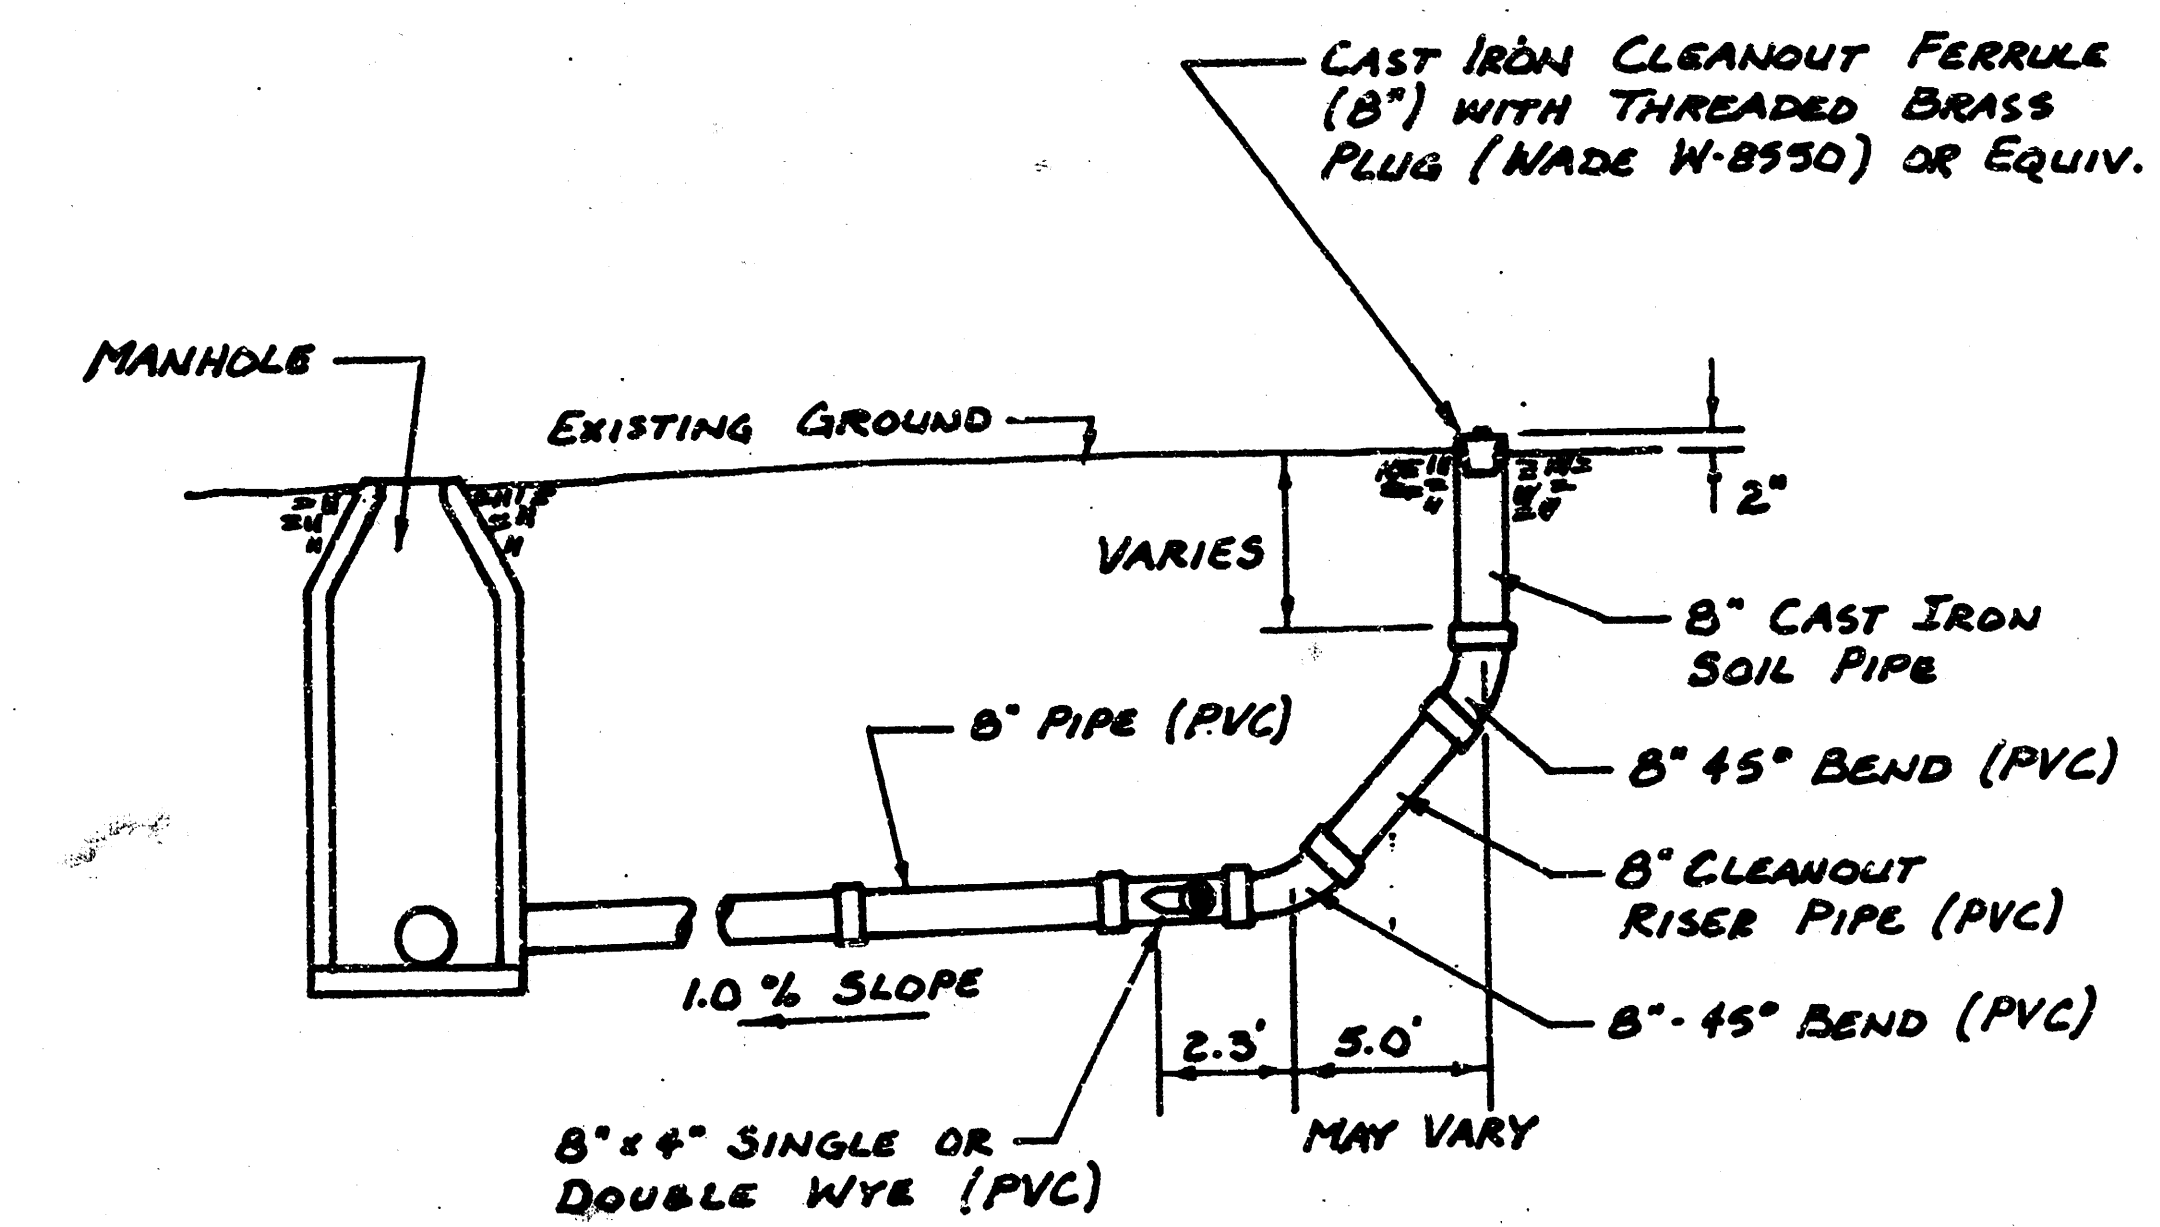

B.M. 124.81 City Std. Disc 32' S & 22' E of 1/4 Sec.
corner at 33rd St. No. & Arkansas
B.M. 132.51 "0" Top E. curb Arkansas at S.L. 32nd
St. No.
B.M. 133.24 NE. Cor. Conc. Porch of House at
SW Cor. 31st St. No. & Mascot.

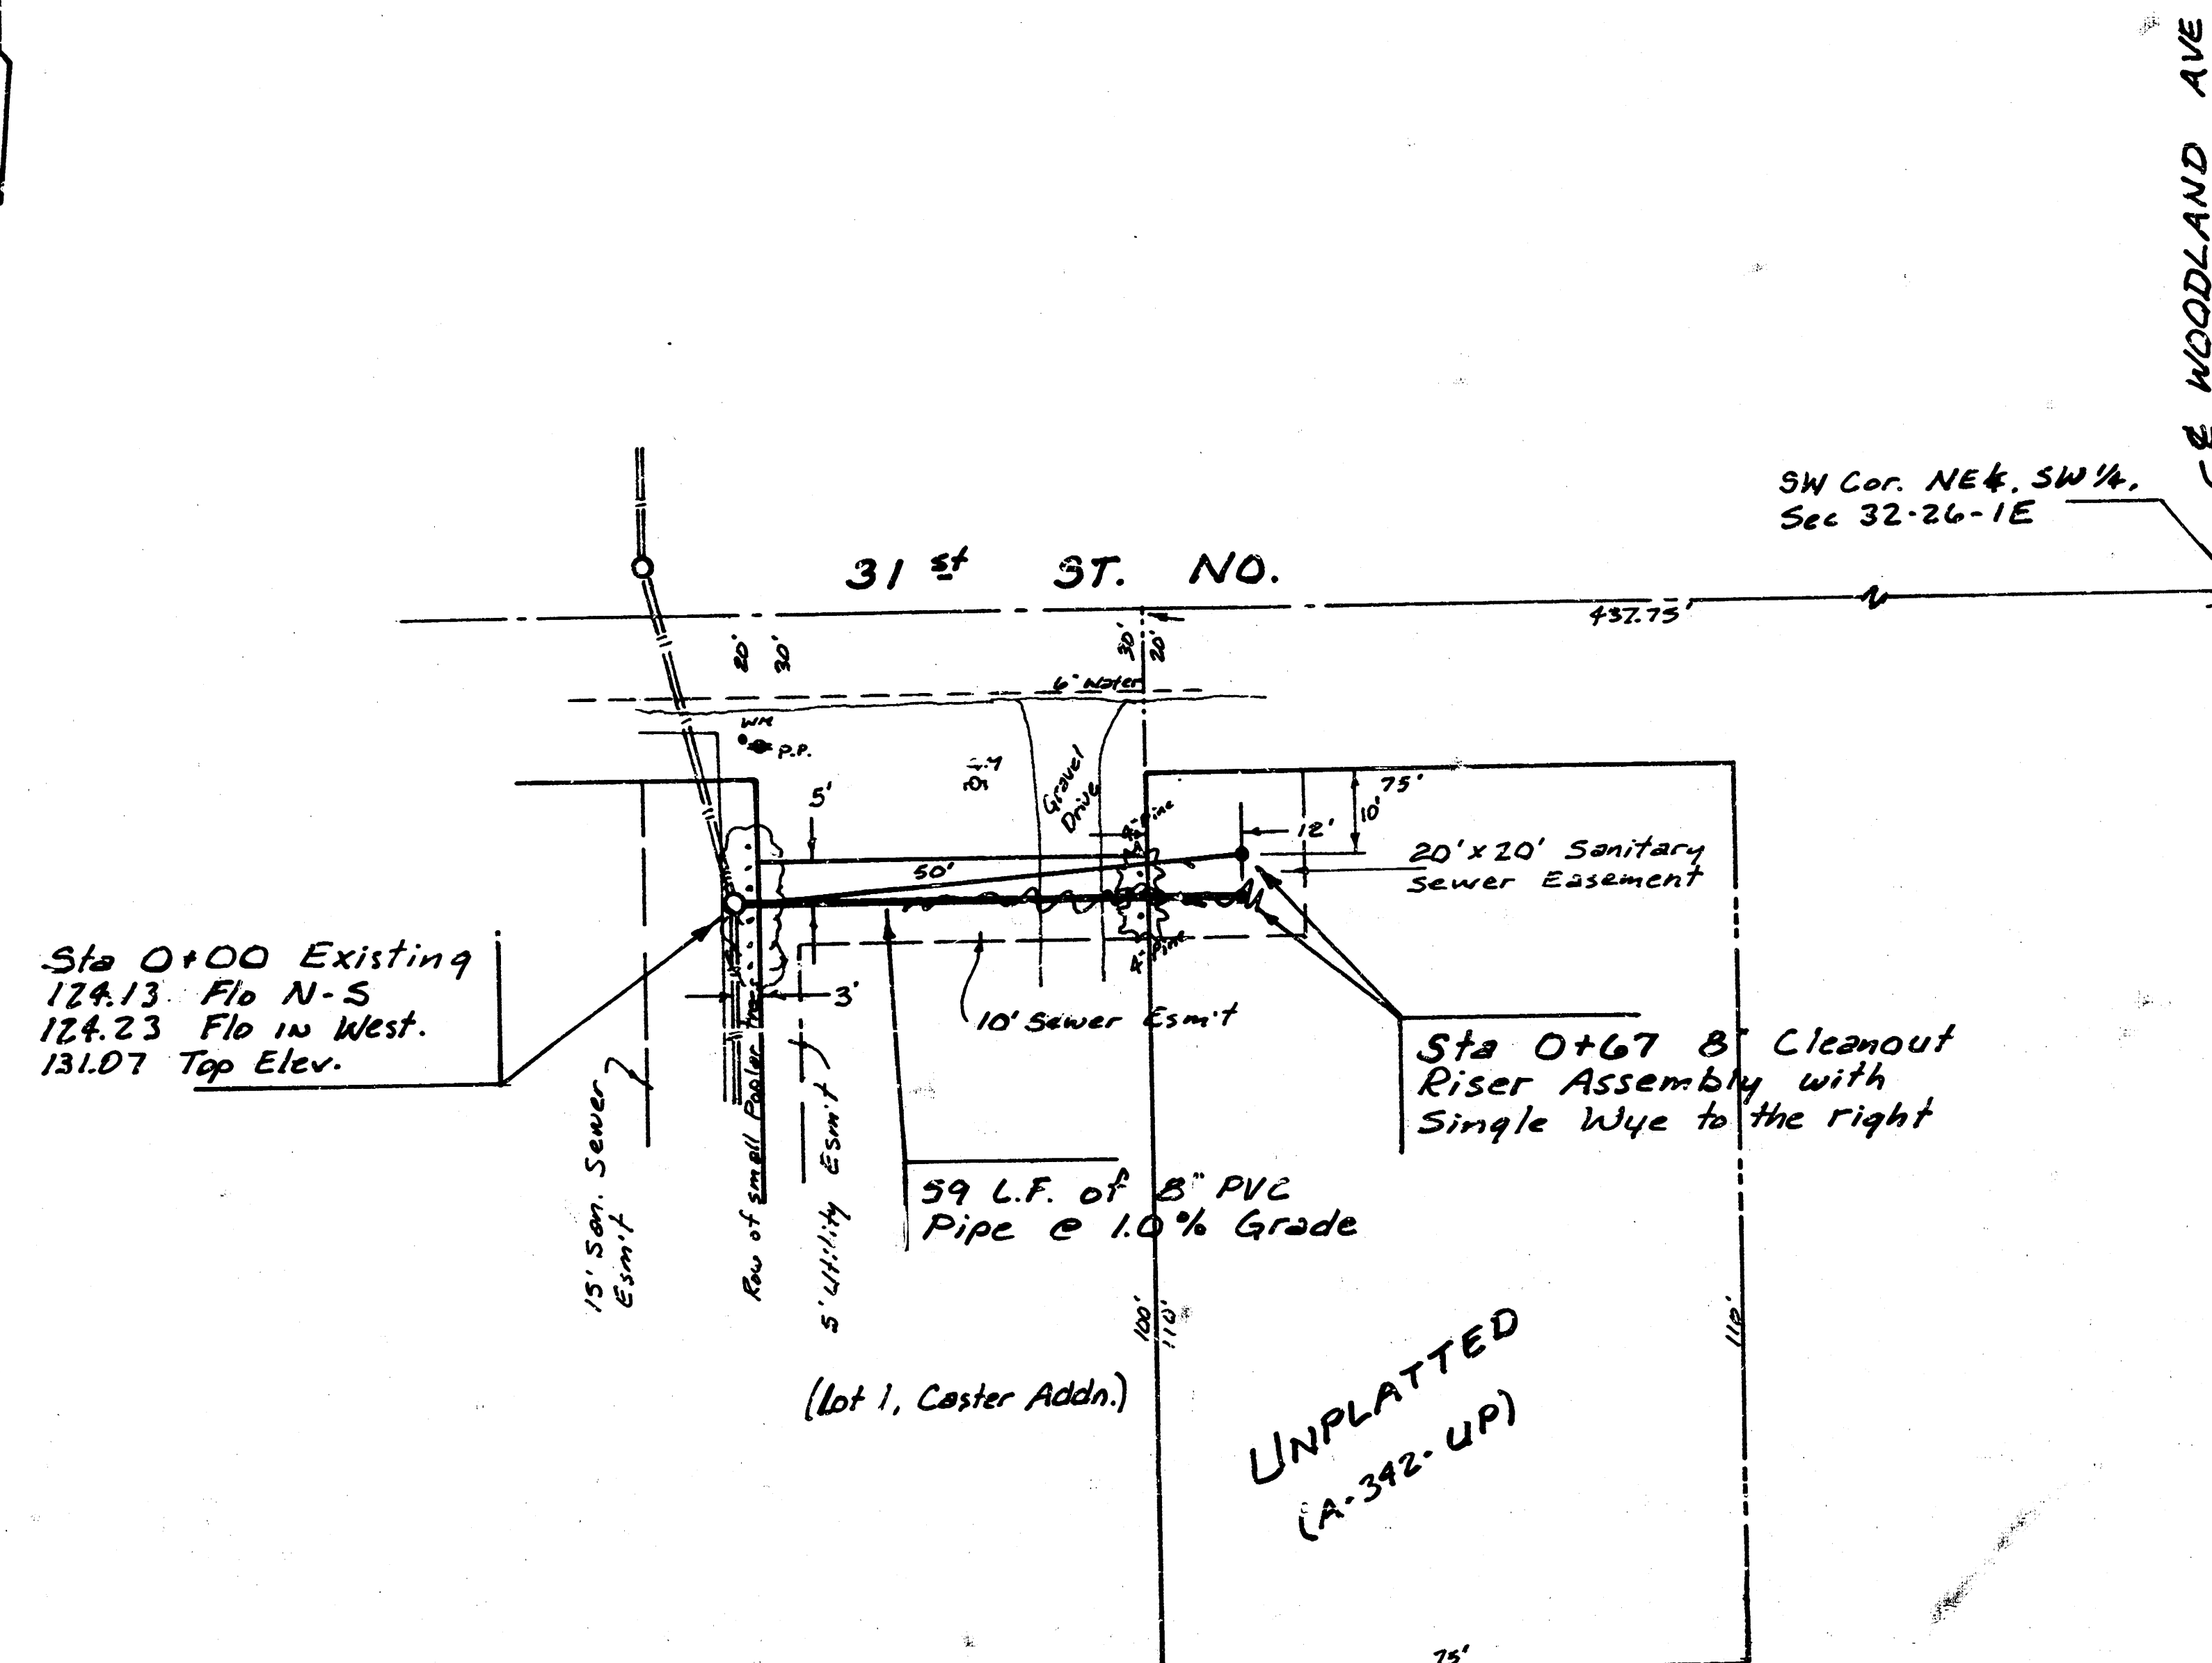

8" CLEANOUT RISER ASSEMBLY DETAIL

LATERAL 120, MAIN 4, SANITARY SEWER NO. 23

PROJECT NO. 468-82056

INDEX NO. 740464

CITY OF WICHITA, KANSAS

M. E. LINDEBAK - CITY ENGINEER



As BUILT
Booked
RAL
8-40

PROJECT DESCRIPTION
PROJECT NUMBER

FILMED FROM THE BEST
AVAILABLE COPY