

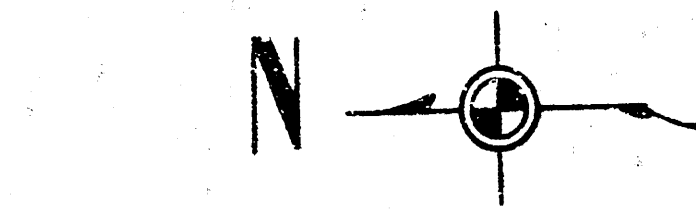


B. M. 204.69 "a" Top N. end W. clyt Headwall ent.
 clyt. N. 3. 21st. 200' E. of Edgemoor.

Survey by G.Y. Book No. 237-Y
 Plan by G.W.
 Checked by

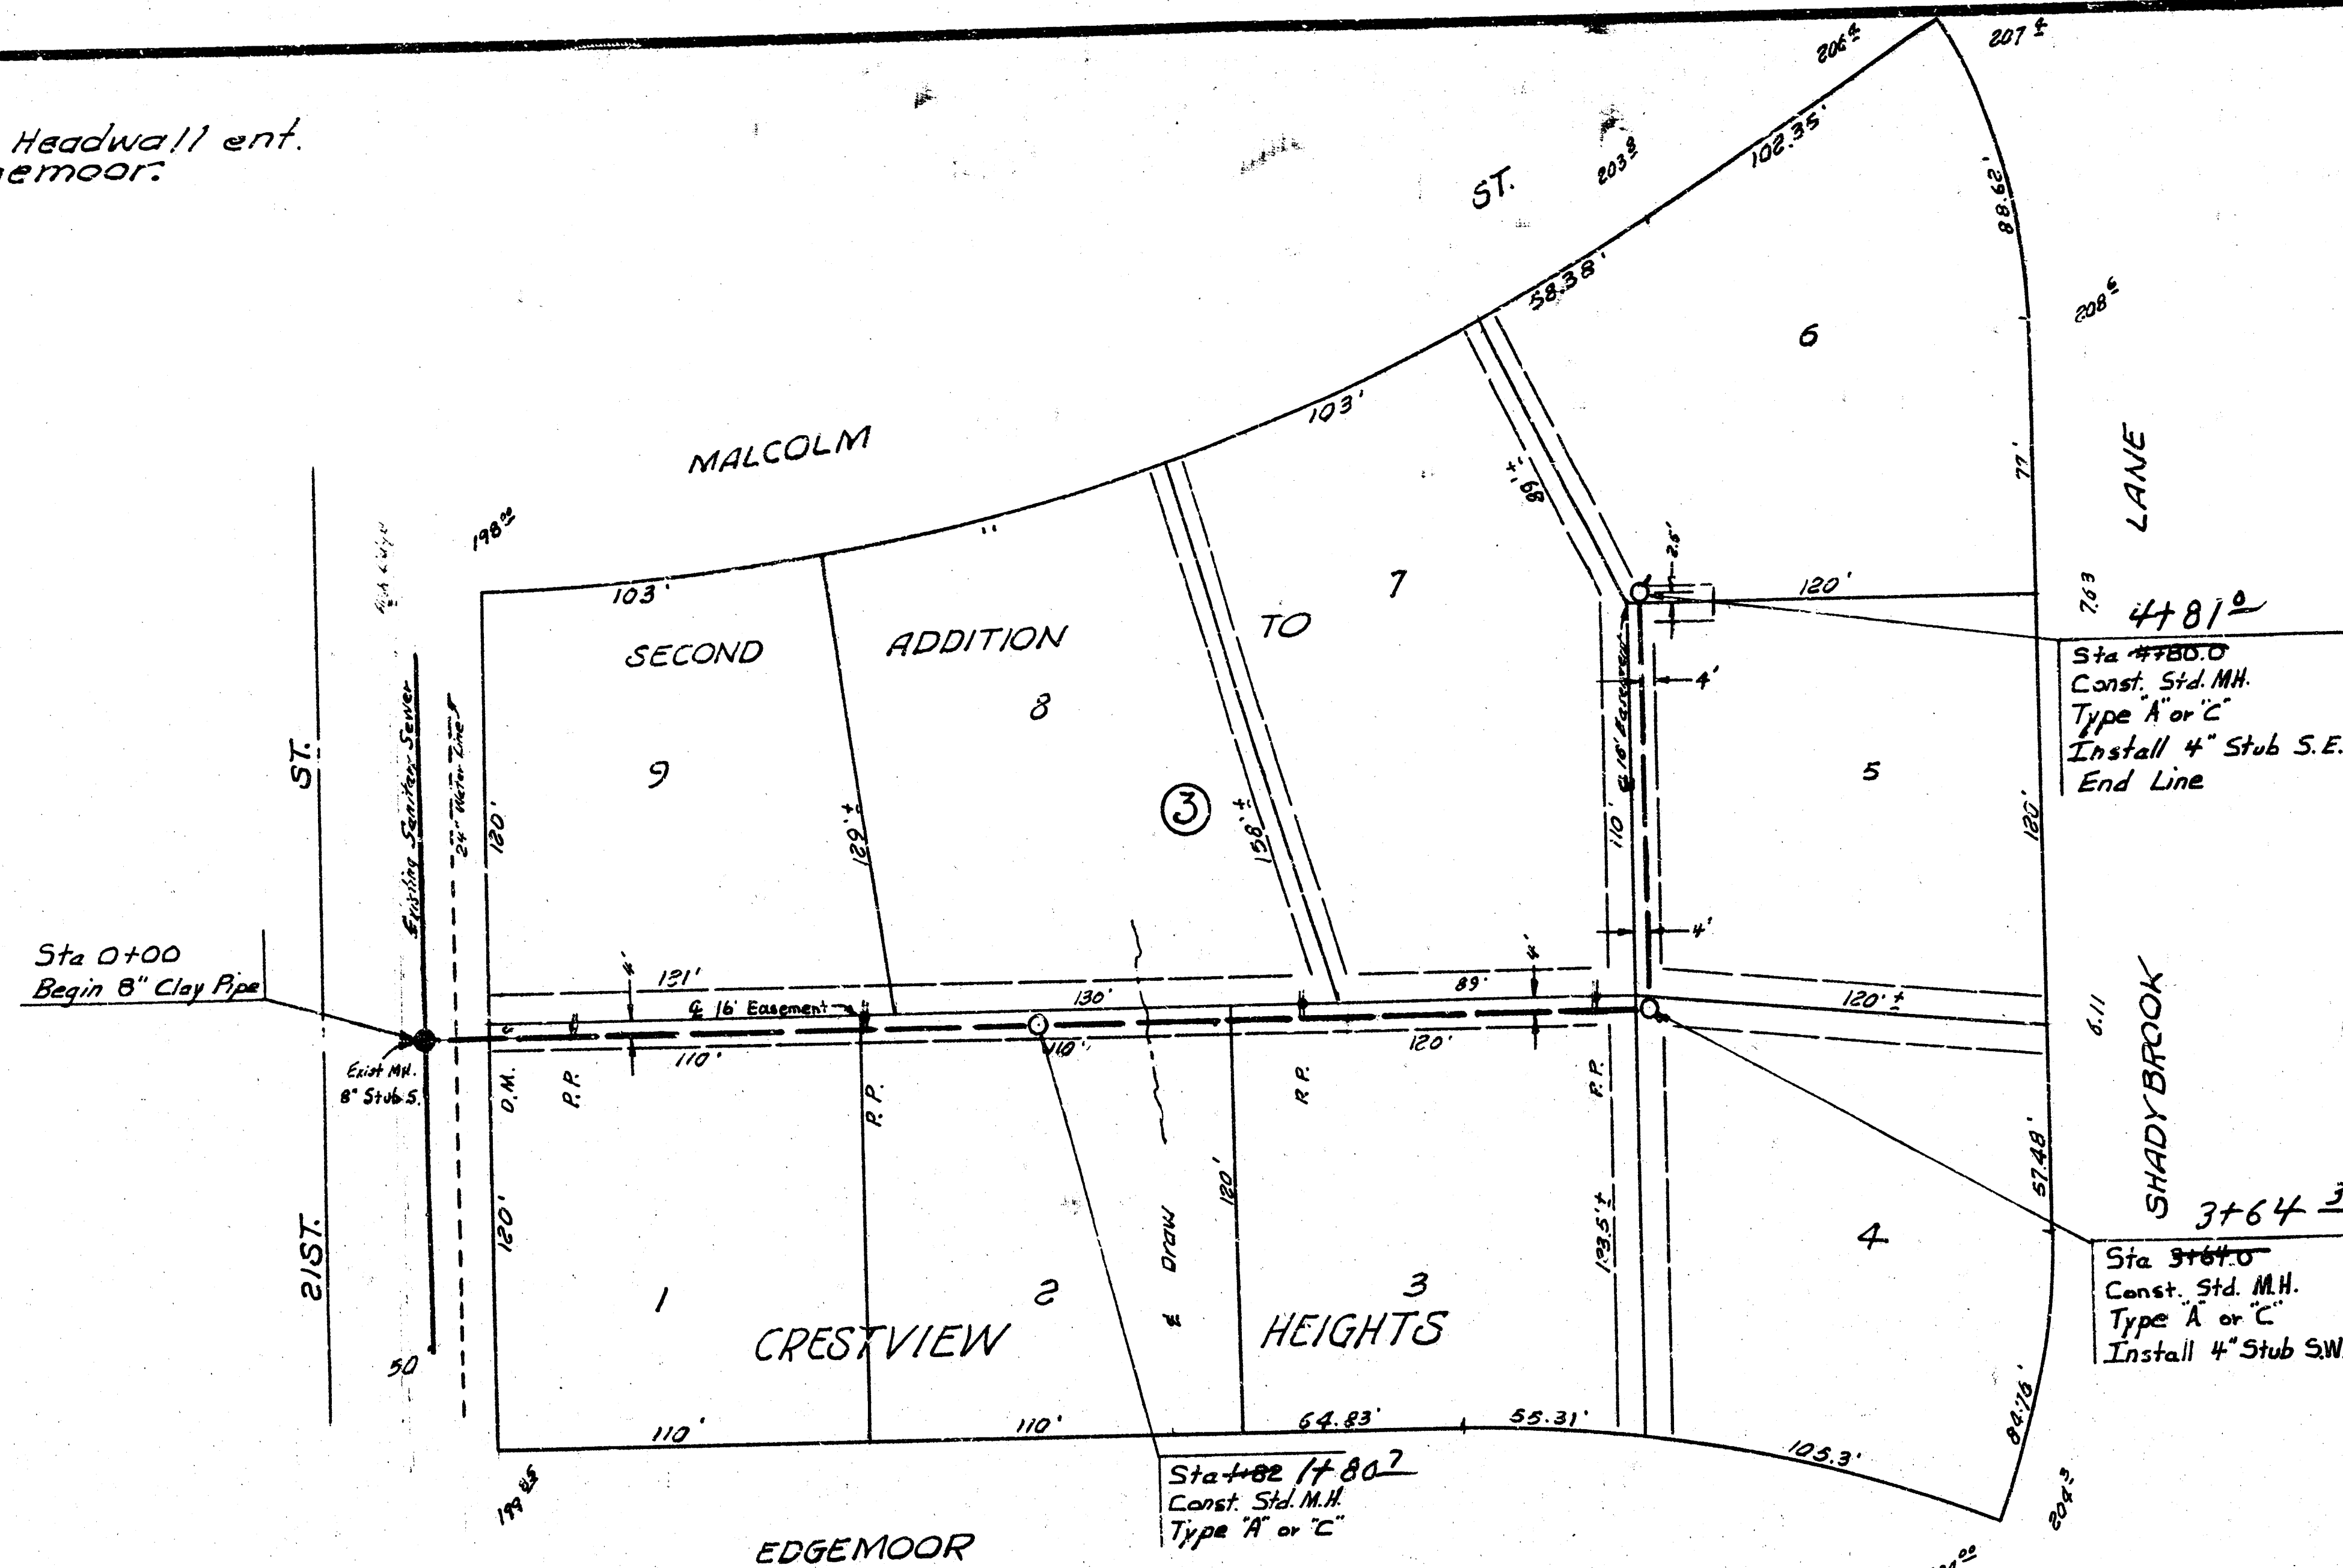

Plan Scale 1" = 40'
 Profile Scale 1" = 40' Vert.

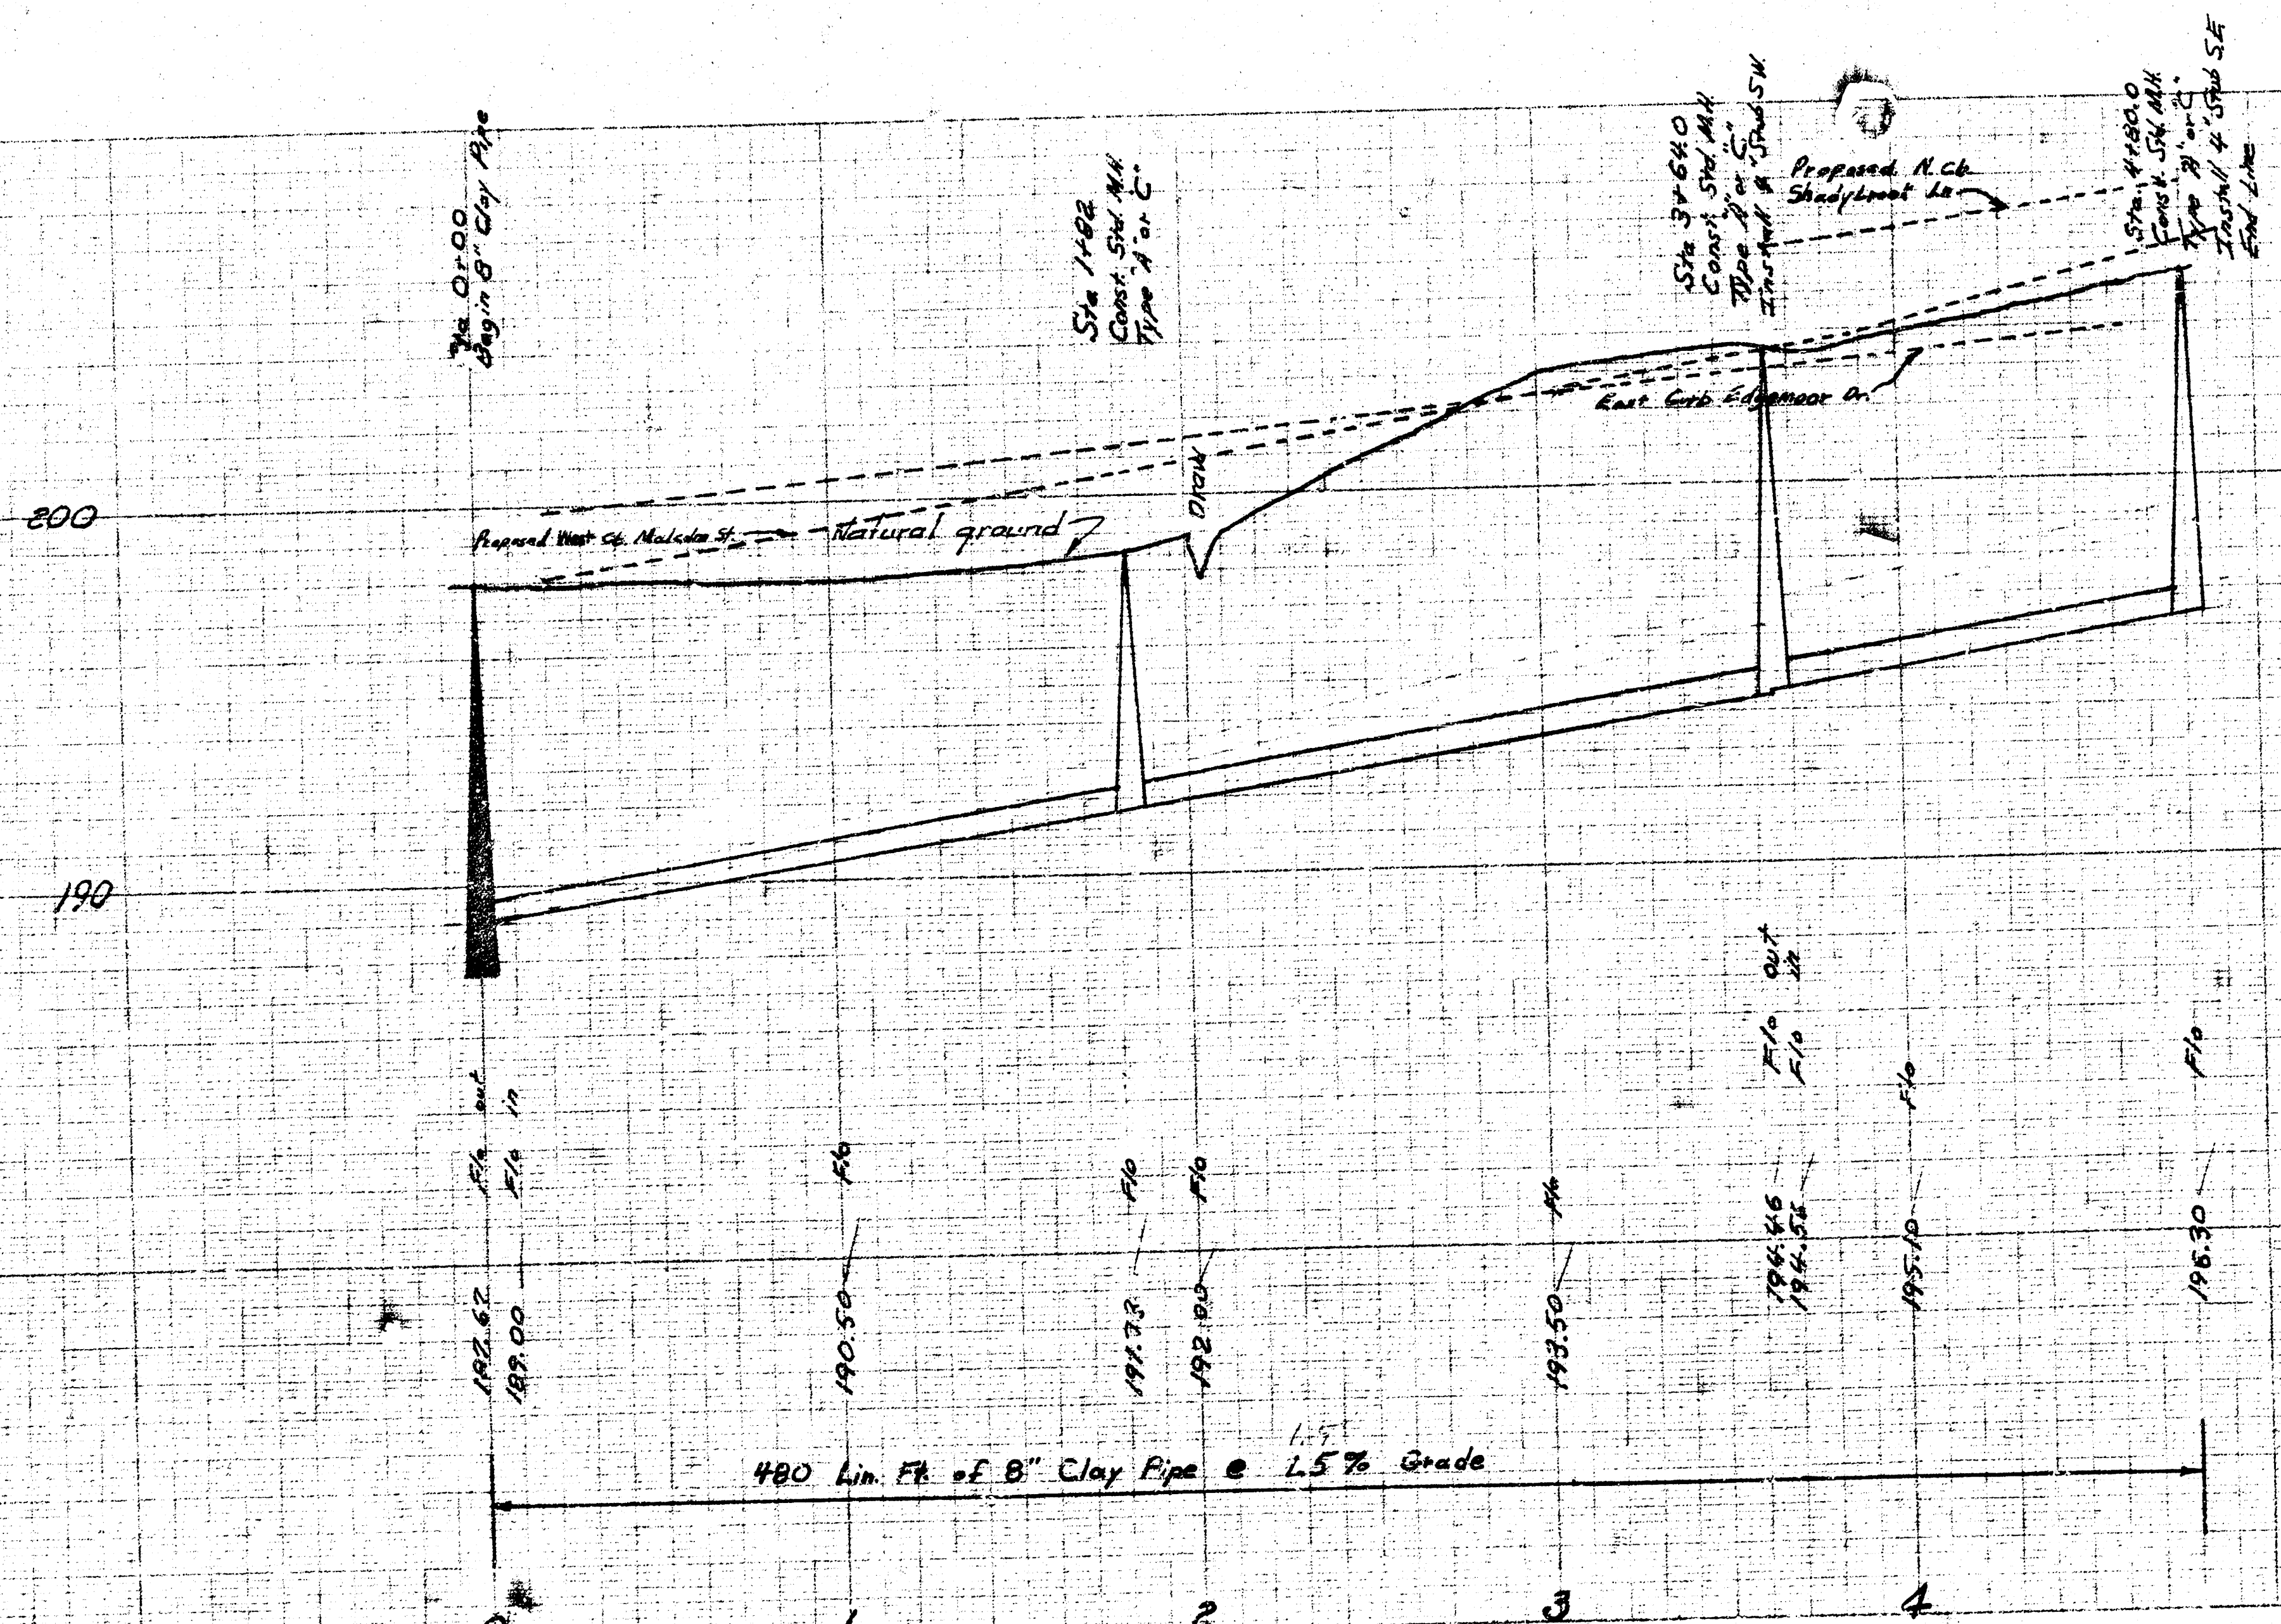

As Built 3-11-76
 LAT. II, SUBMAIN 5, S. S. NO. 23
 CITY OF WICHITA, KANSAS
 R. W. LINN CITY ENGINEER
 PROJECT DBKL566040

