


B. M. 204.69 Top N. end W. c/vt. Headwall
Ent. c/vt. N. S. 21st 200' E. of Edgemoor.

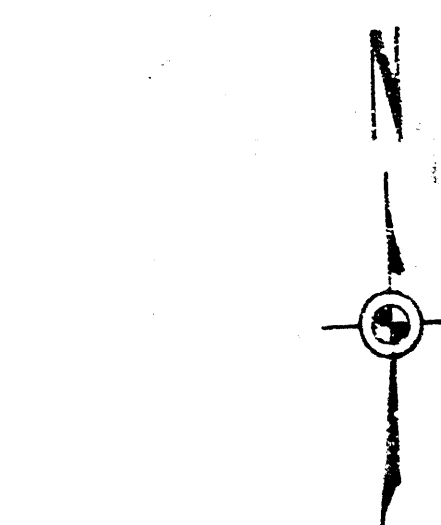

Plan Scale 1" = 40'
Profile Scale 1" = 10' vert.

Survey by G.Y. Book 237-Y
Plan by J.R.W.
Checked by

LARKSPUR

LANE

SHADYBROOK

LANE

ST

Sta. 0+00.0
Exist. M. H.
Exist. 8" stub East

NOTE:
Use extreme caution in
excavating stub at Sta.
0+00.0 as end of pipe
may be farther east of
manhole than indicated
by plan.

50+04 Begin
16' Util. Easement

2+335
Sta. 5150.0
Const. Std. M. H.
Type "A" or "C"

5+478
Sta. 5150.0
Const. Std. M. H.
Type "A" or "C"
Install 8" stub NW & SE.

CRESTVIEW

HEIGHTS

MALCOLM

20TH

214²
Rivers Street

ST.

Sta. 0+00.0 Exist. M. H.
Exist. 8" stub East

Sta. 5150.0 Const. Std. M. H.
Type "A" or "C"

Sta. 5150.0 Const. Std. M. H.
Type "A" or "C"
Install 4" stub NW & SE.

Existing N. cb.
20th St.

Natural ground

Proposed W. cb.
Malcolm St.

18' to Water table
6-27-75
util.

N. Rim M. H.
202.11

Lot 13
Basement Floor
Lot 1
Basement Floor

Proposed So. cb.
Shadybrook Ln.

199.01 Elev. of
199.11 Elev. in
8" stub East

545 Lin. ft. of 8" Clay Pipe @ 0.40 % grade

As Built 10-14-75

LAT. 12, SUBMAIN 5, S. S. NO. 23

CITY OF WICHITA, KANSAS

R. W. LINN — CITY ENGINEER

DATE: PROJECT NO. DBKL566041

