
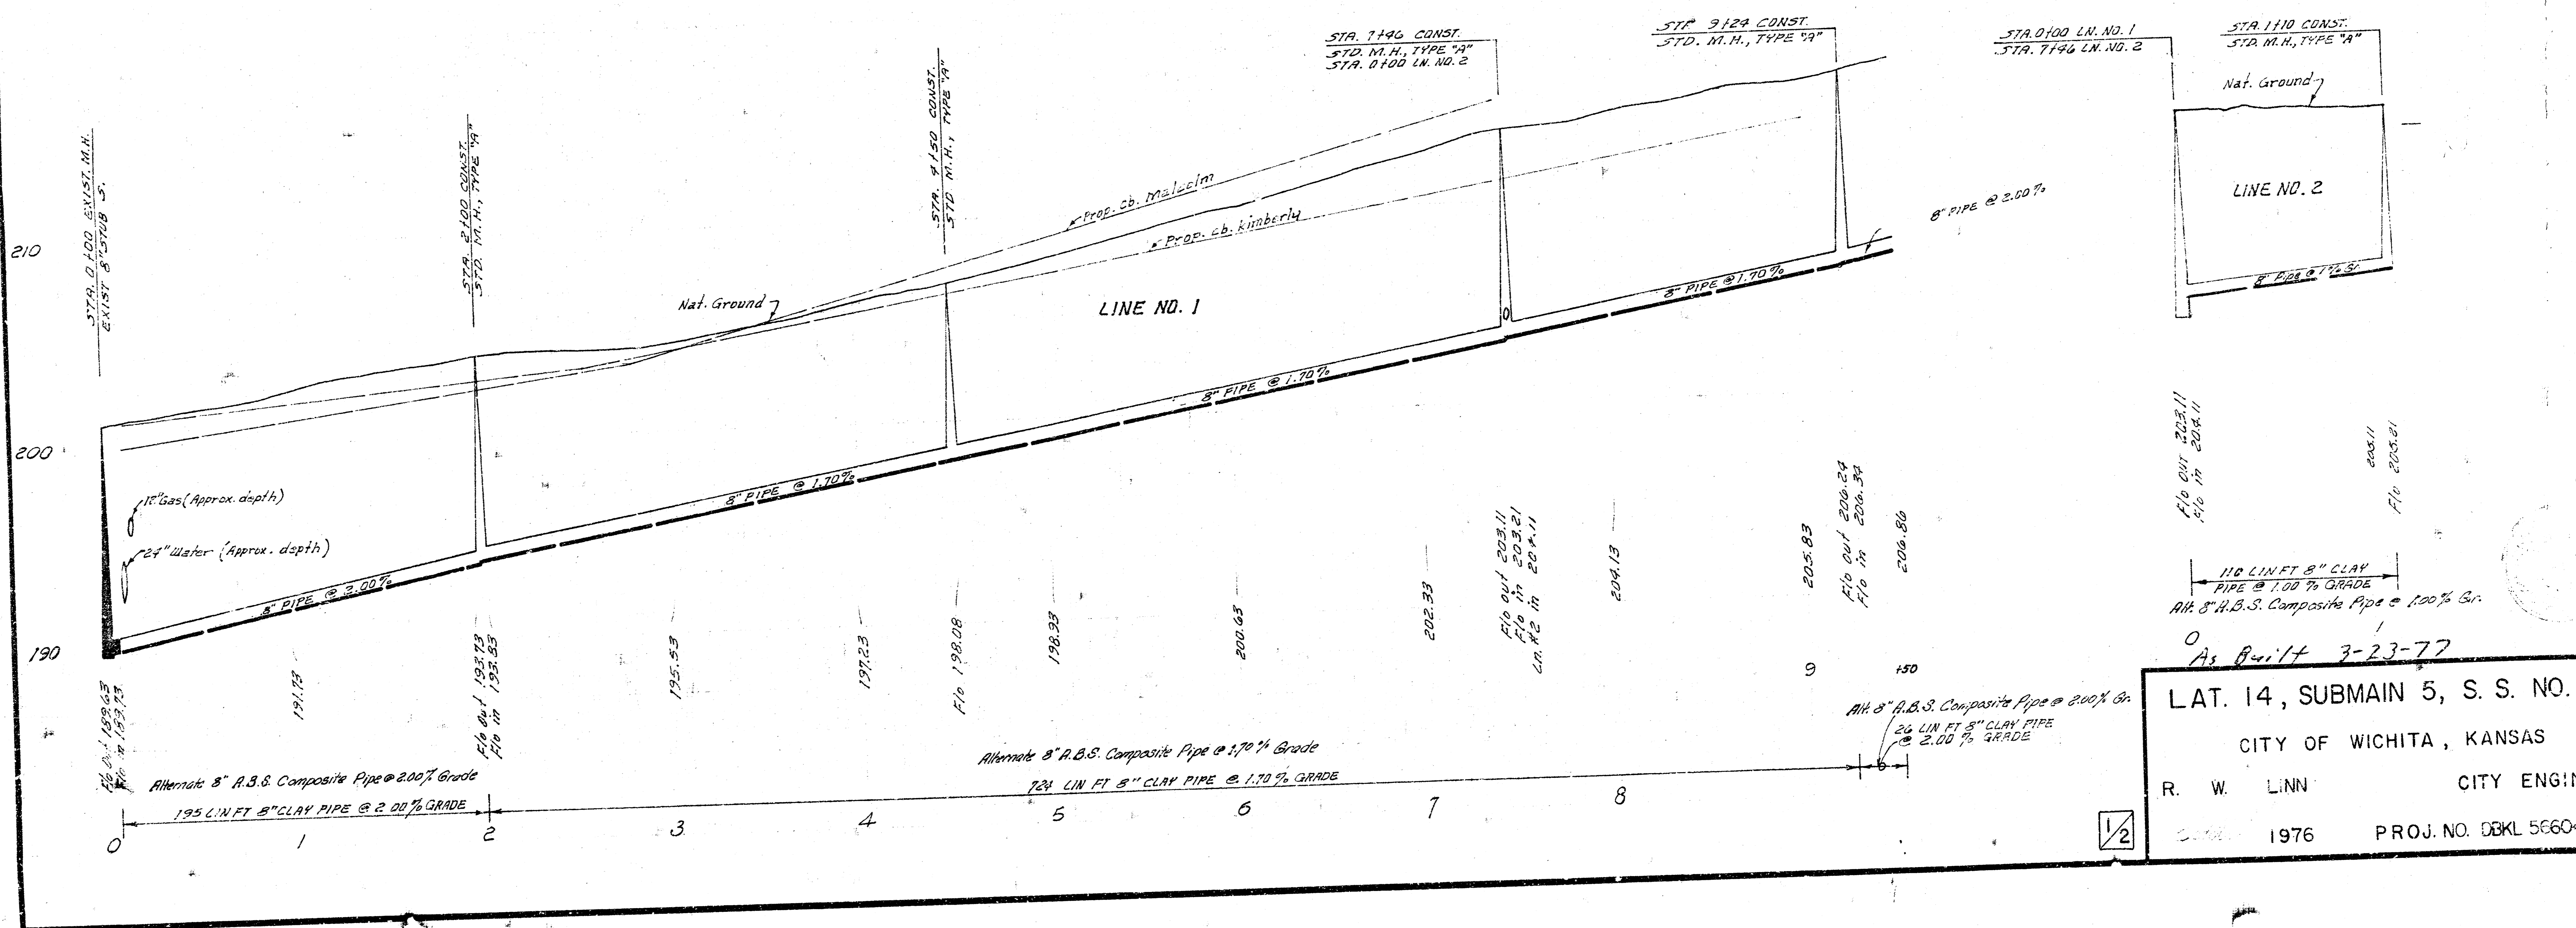


B.M. 204.69 "A" top N. end W. clyt. Headwall  
Ent. clyt. N.S. 21st. 200' E. of Edgemoor.


T.B.M. 216.72 60" nail W.S. P.P.S.E. cor  
lot 5 Block 12 Crestview Hqts. 1st.

Survey by G. X. D.L.C.  
 Book 241-Y 237-Y  
 Checked by R. W. Linn

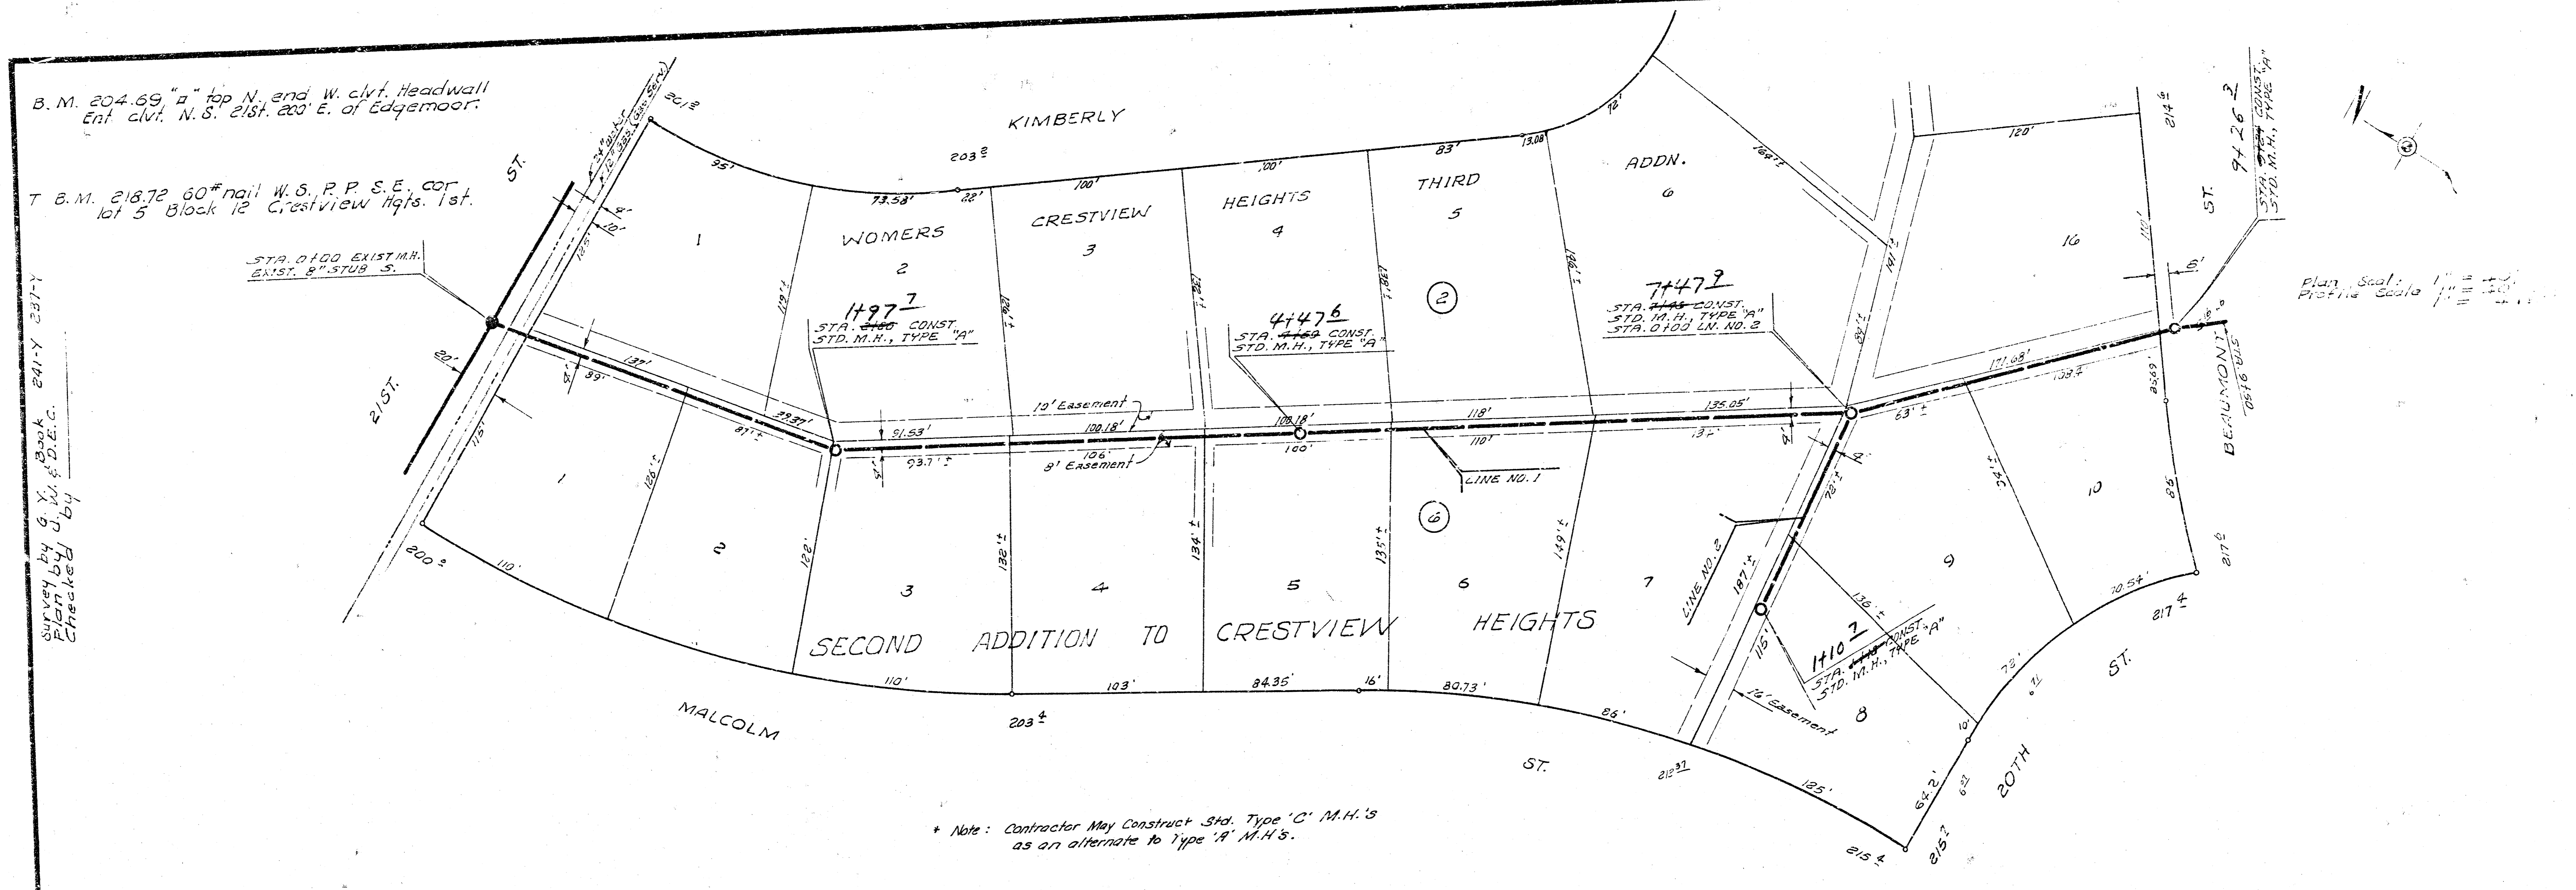


LAT. 14, SUBMAIN 5, S. S. NO. 23  
 CITY OF WICHITA, KANSAS  
 R. W. LINN CITY ENGINEER  
 1976 PROJ. NO. DBKL 566043

Bk. 237-Y

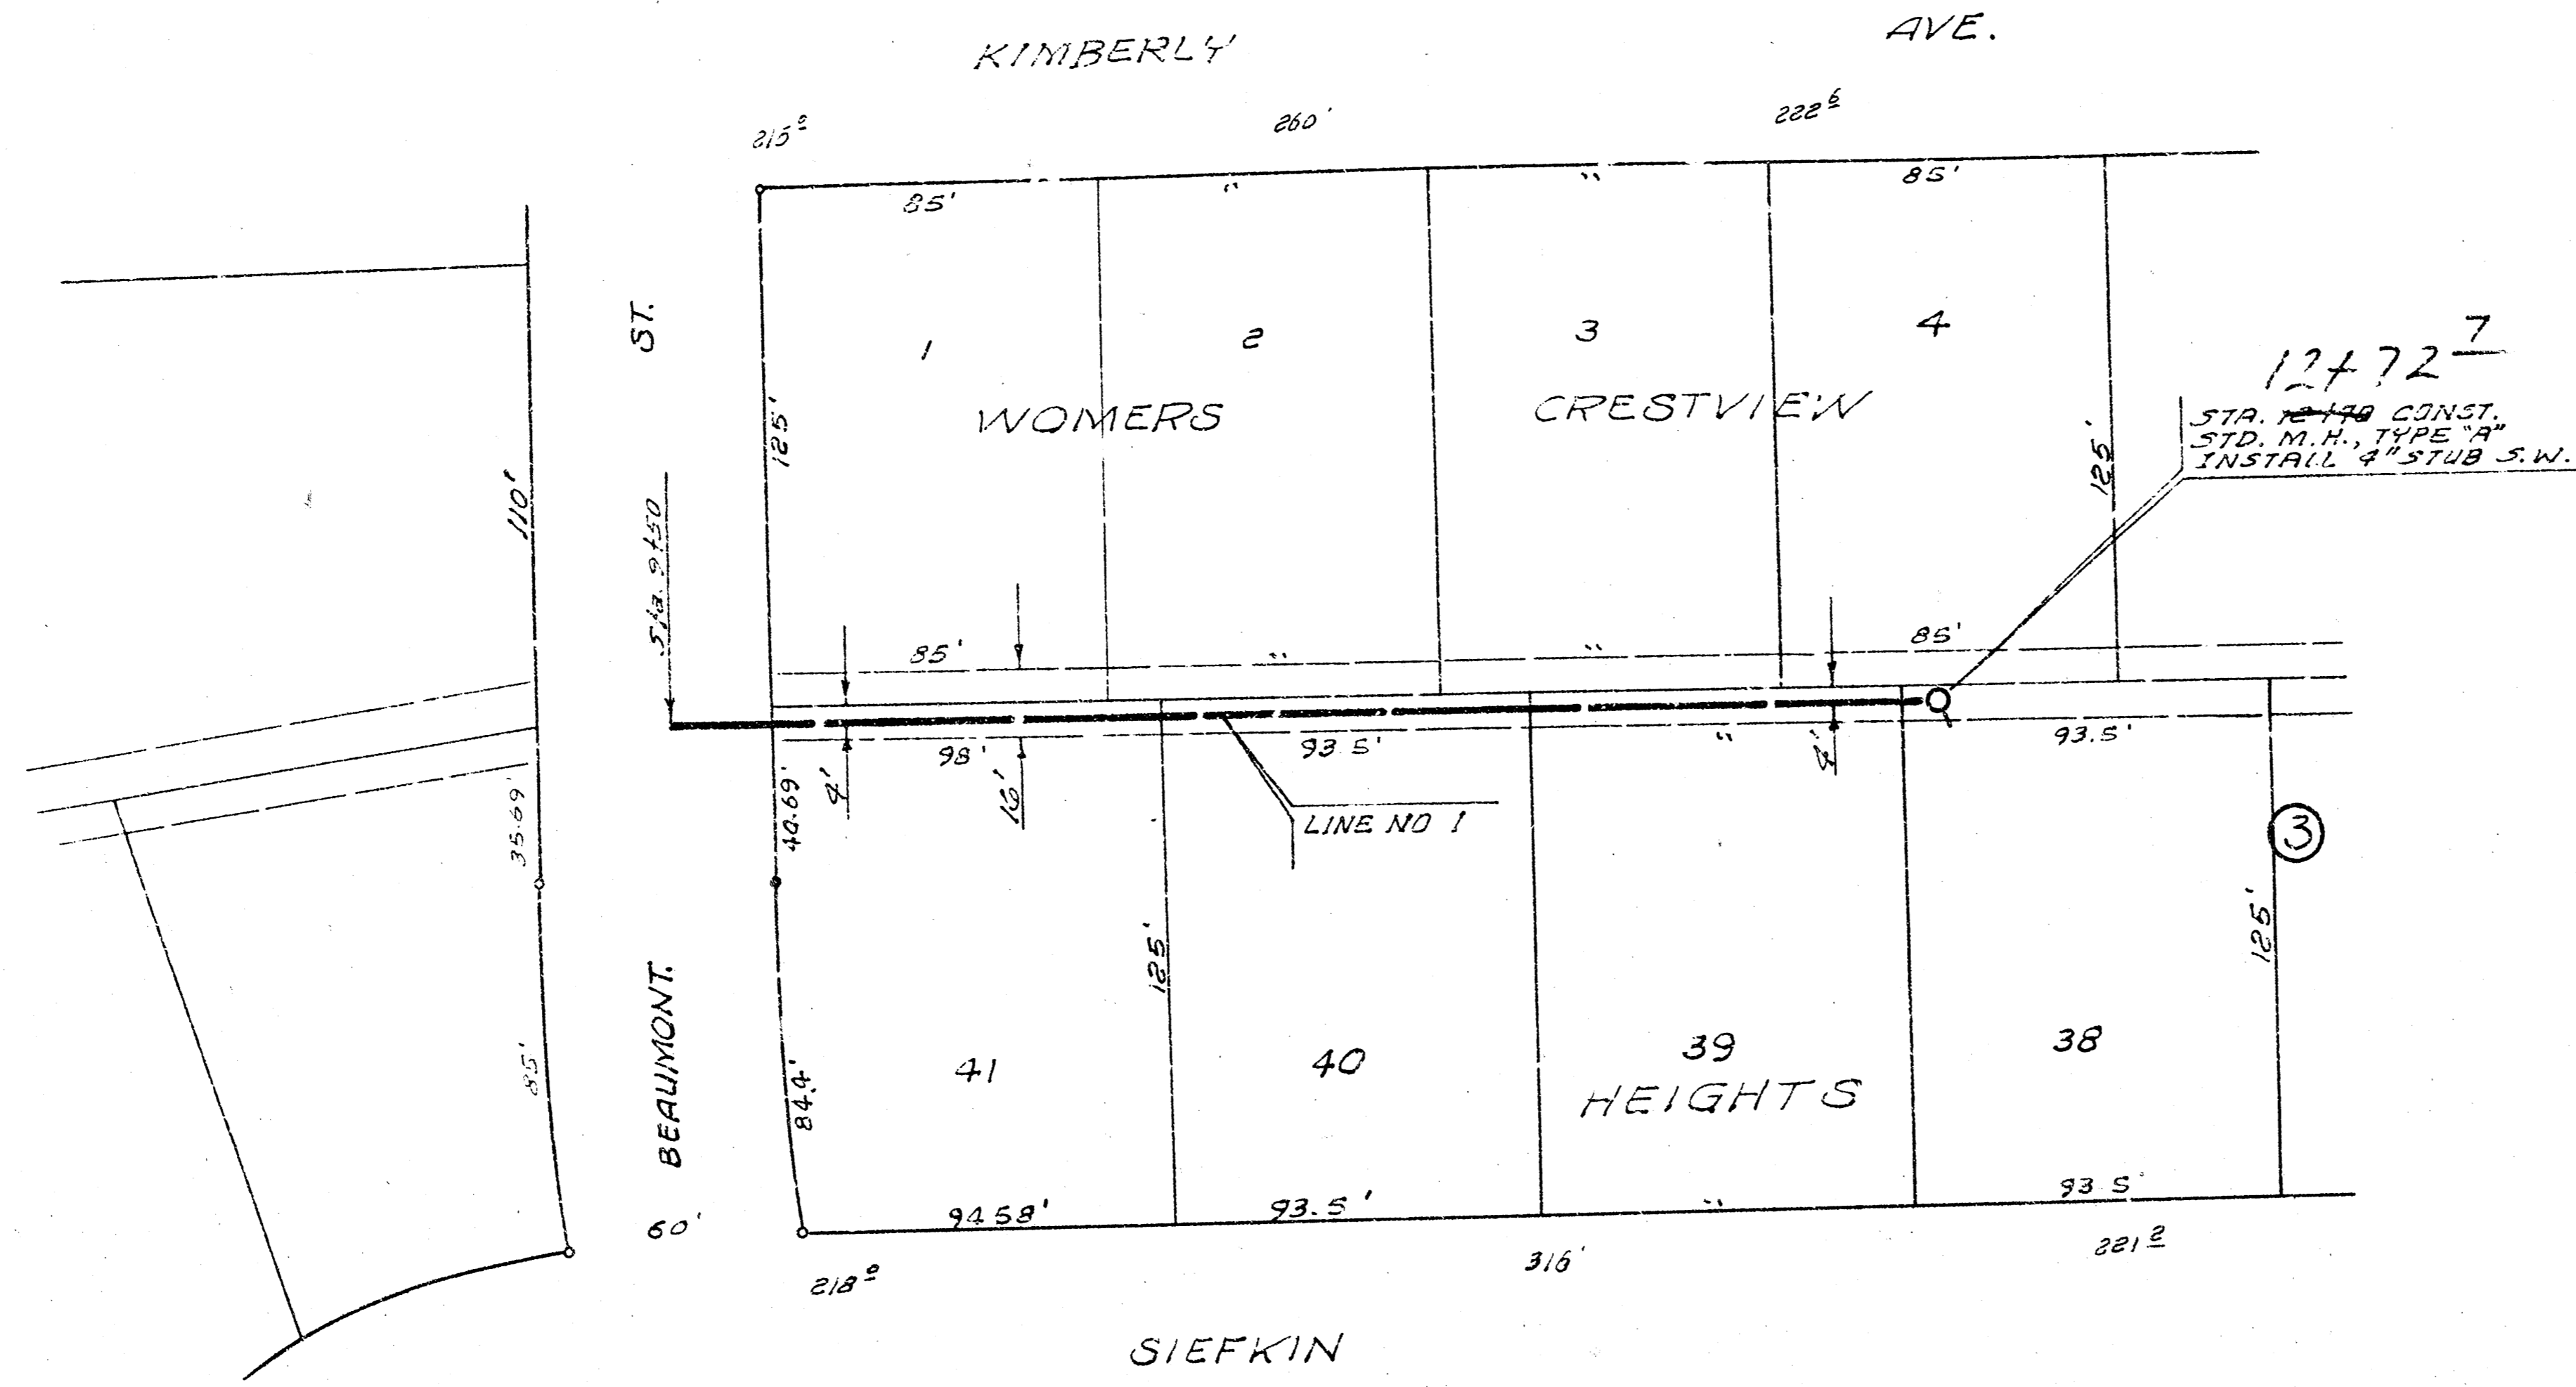

B.M. 21994 "T" top N. cb 1911  
10' E W. of Beaumont.

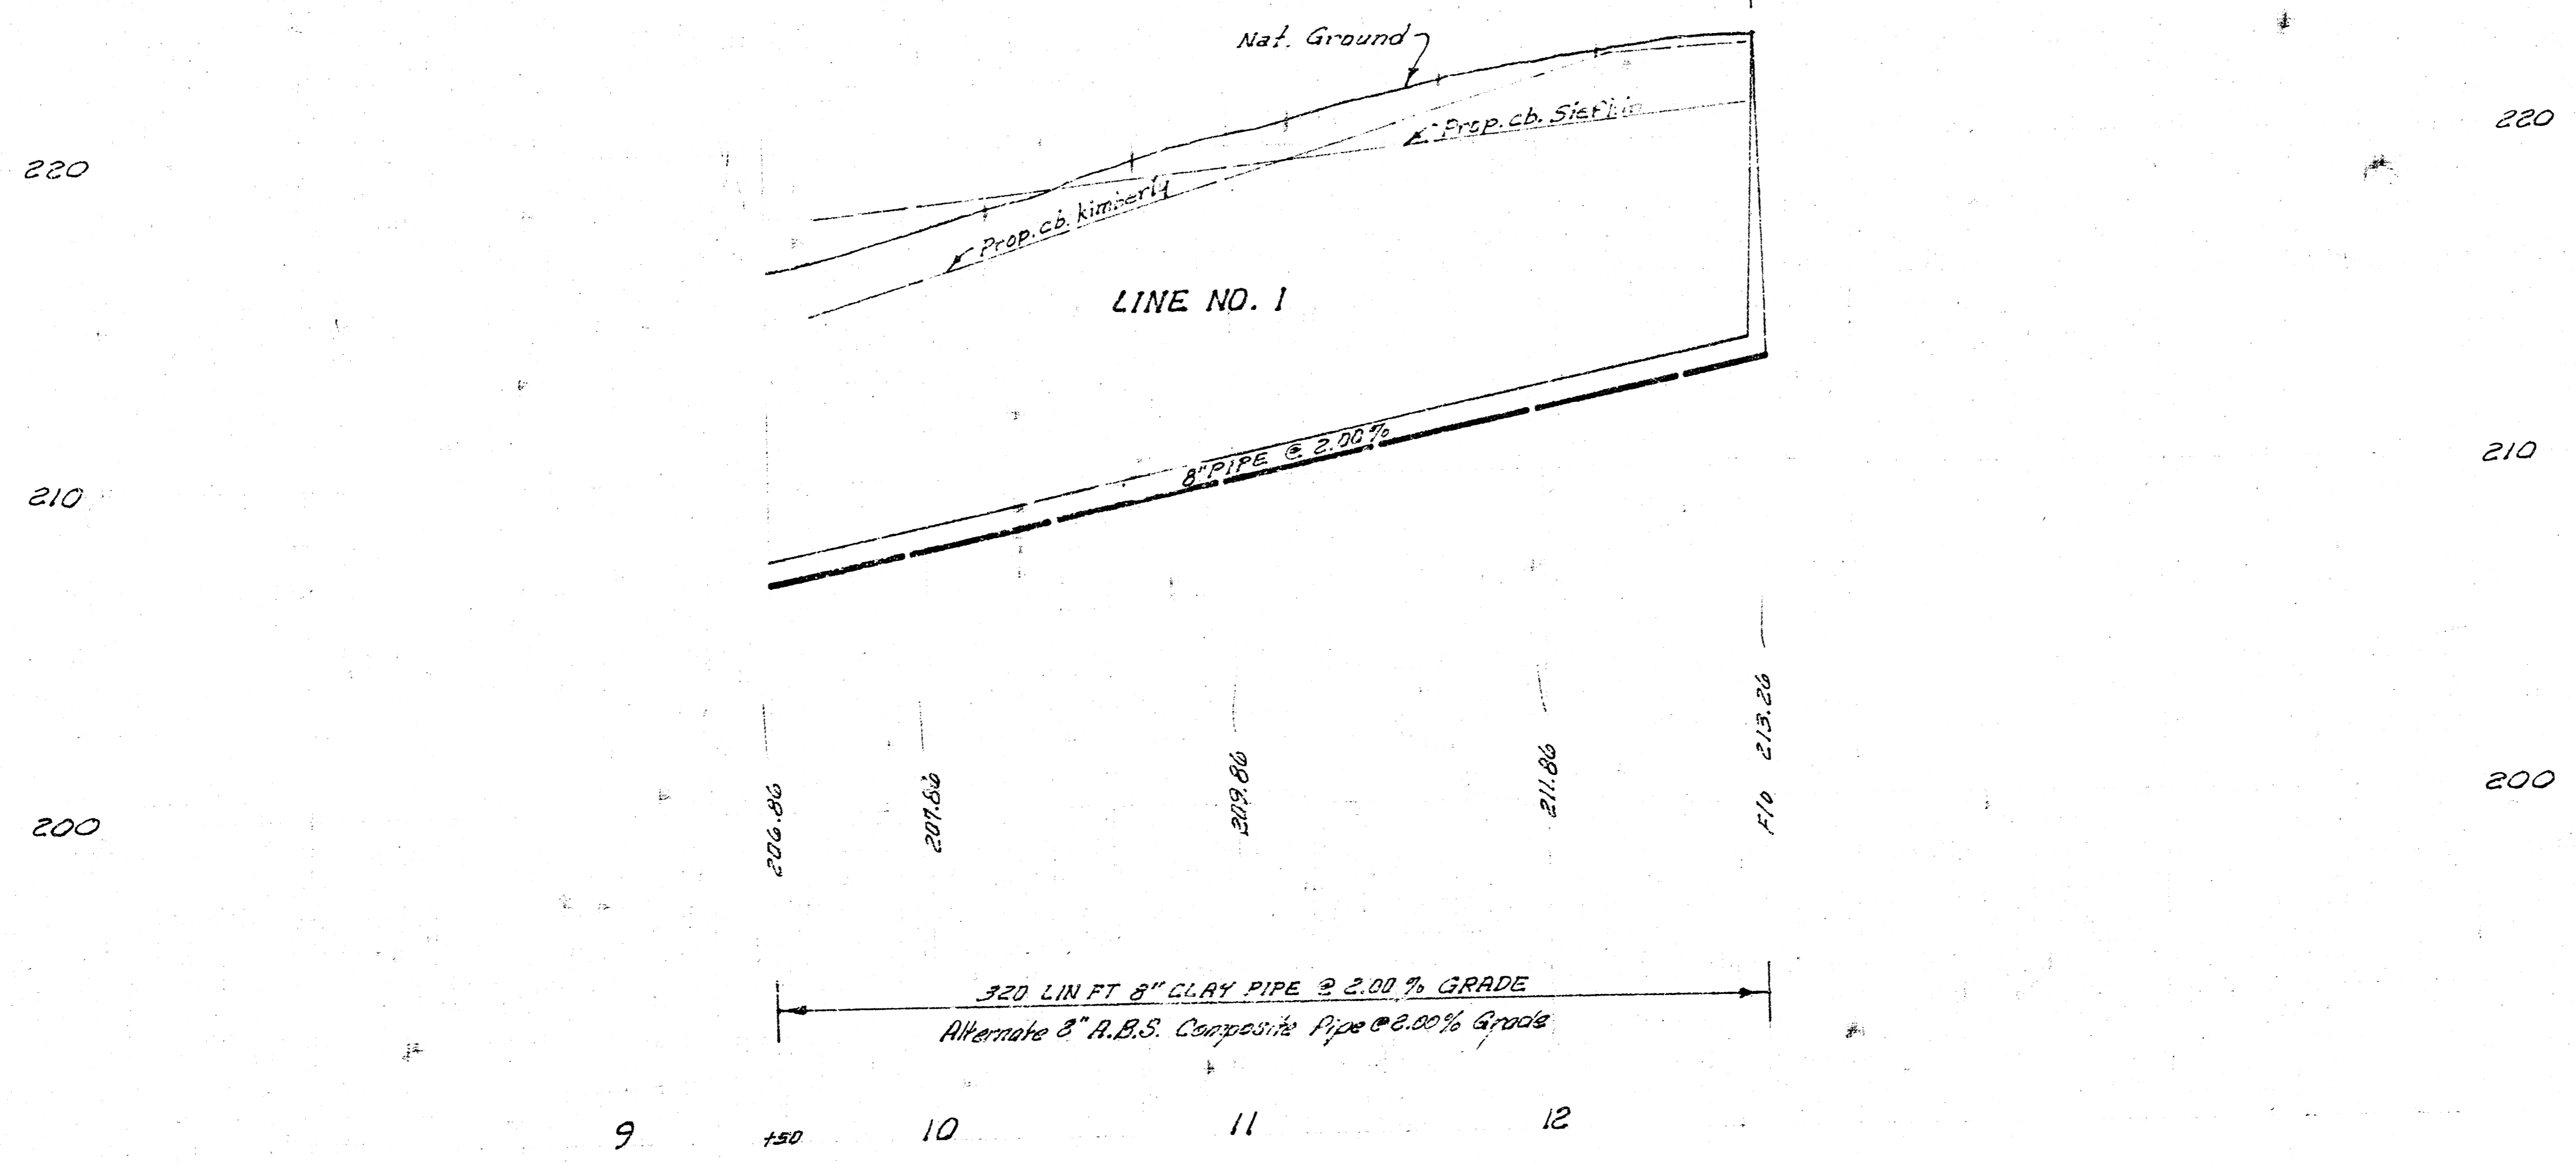

2/2

L AT. 14, SUBMAIN 5, S. S. NO. 23  
PROJECT NO. DBXL566003