
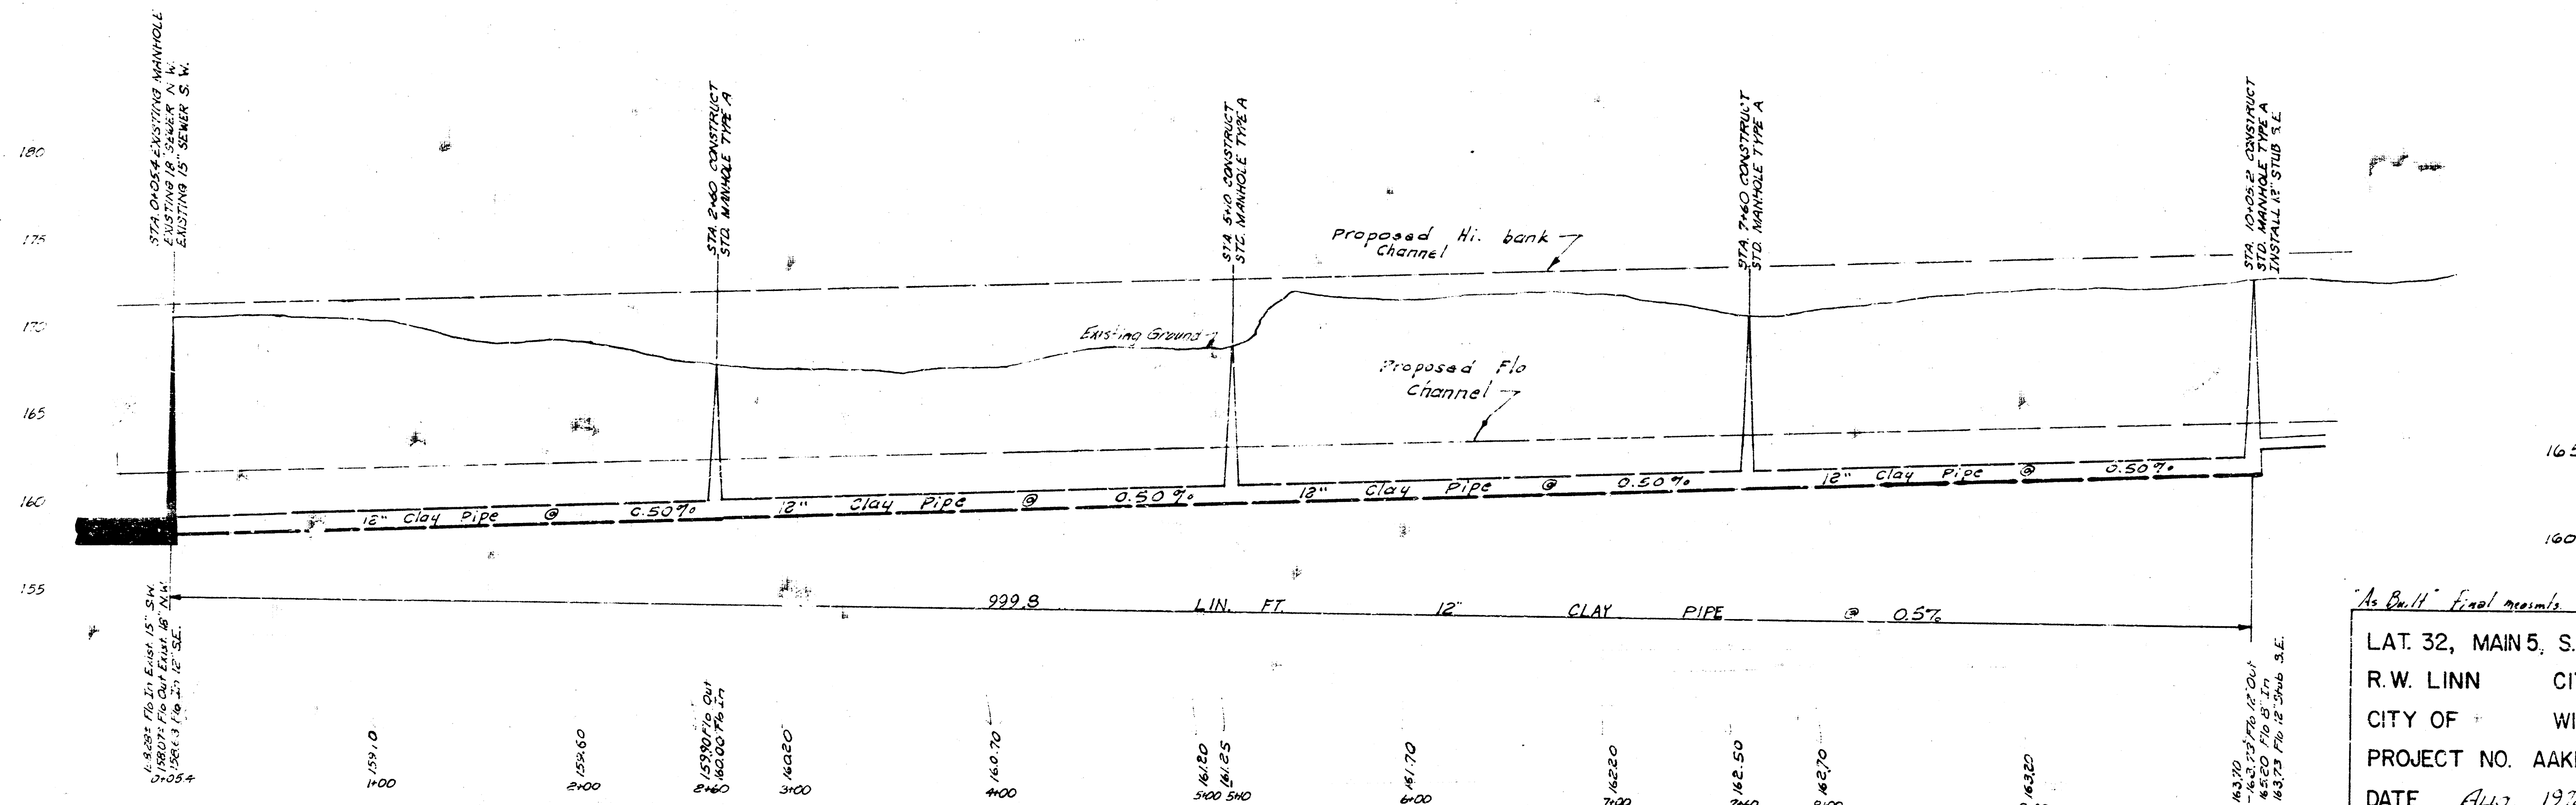


P. 200-65 City St. @ N.E. cor. Woodlawn & 21st

P. 200-65 City St. @ N.E. cor. Woodlawn & 21st
B.M. 188.477 City St. 12' north of 21st on Woodlawn
B.M. 175.61 R.R. pipe E. face orange hedge, Sta. 9+77.55.
B.M. 170.75 S. 8th existing M.H., Sta. 0+00.

NOTE: FIELD ENGINEER TO ESTABLISH SEWER ALIGNMENT USING
GIVEN DIMENSIONS AND ANGLES FROM THE S.E. CORNER
OF THE N.E. QUARTER OF SEC. 1, T27S, R1E OF 6th P.M.



NOTE TO CONTRACTOR
This project will be constructed under
the supervision of the CITY ENGINEER
and conforming to the SPECIFICATIONS
of the CITY OF WICHITA. The CON-
TRACTOR will reimburse the City of
Wichita for all cost of Engineering, Plans,
and Inspection.

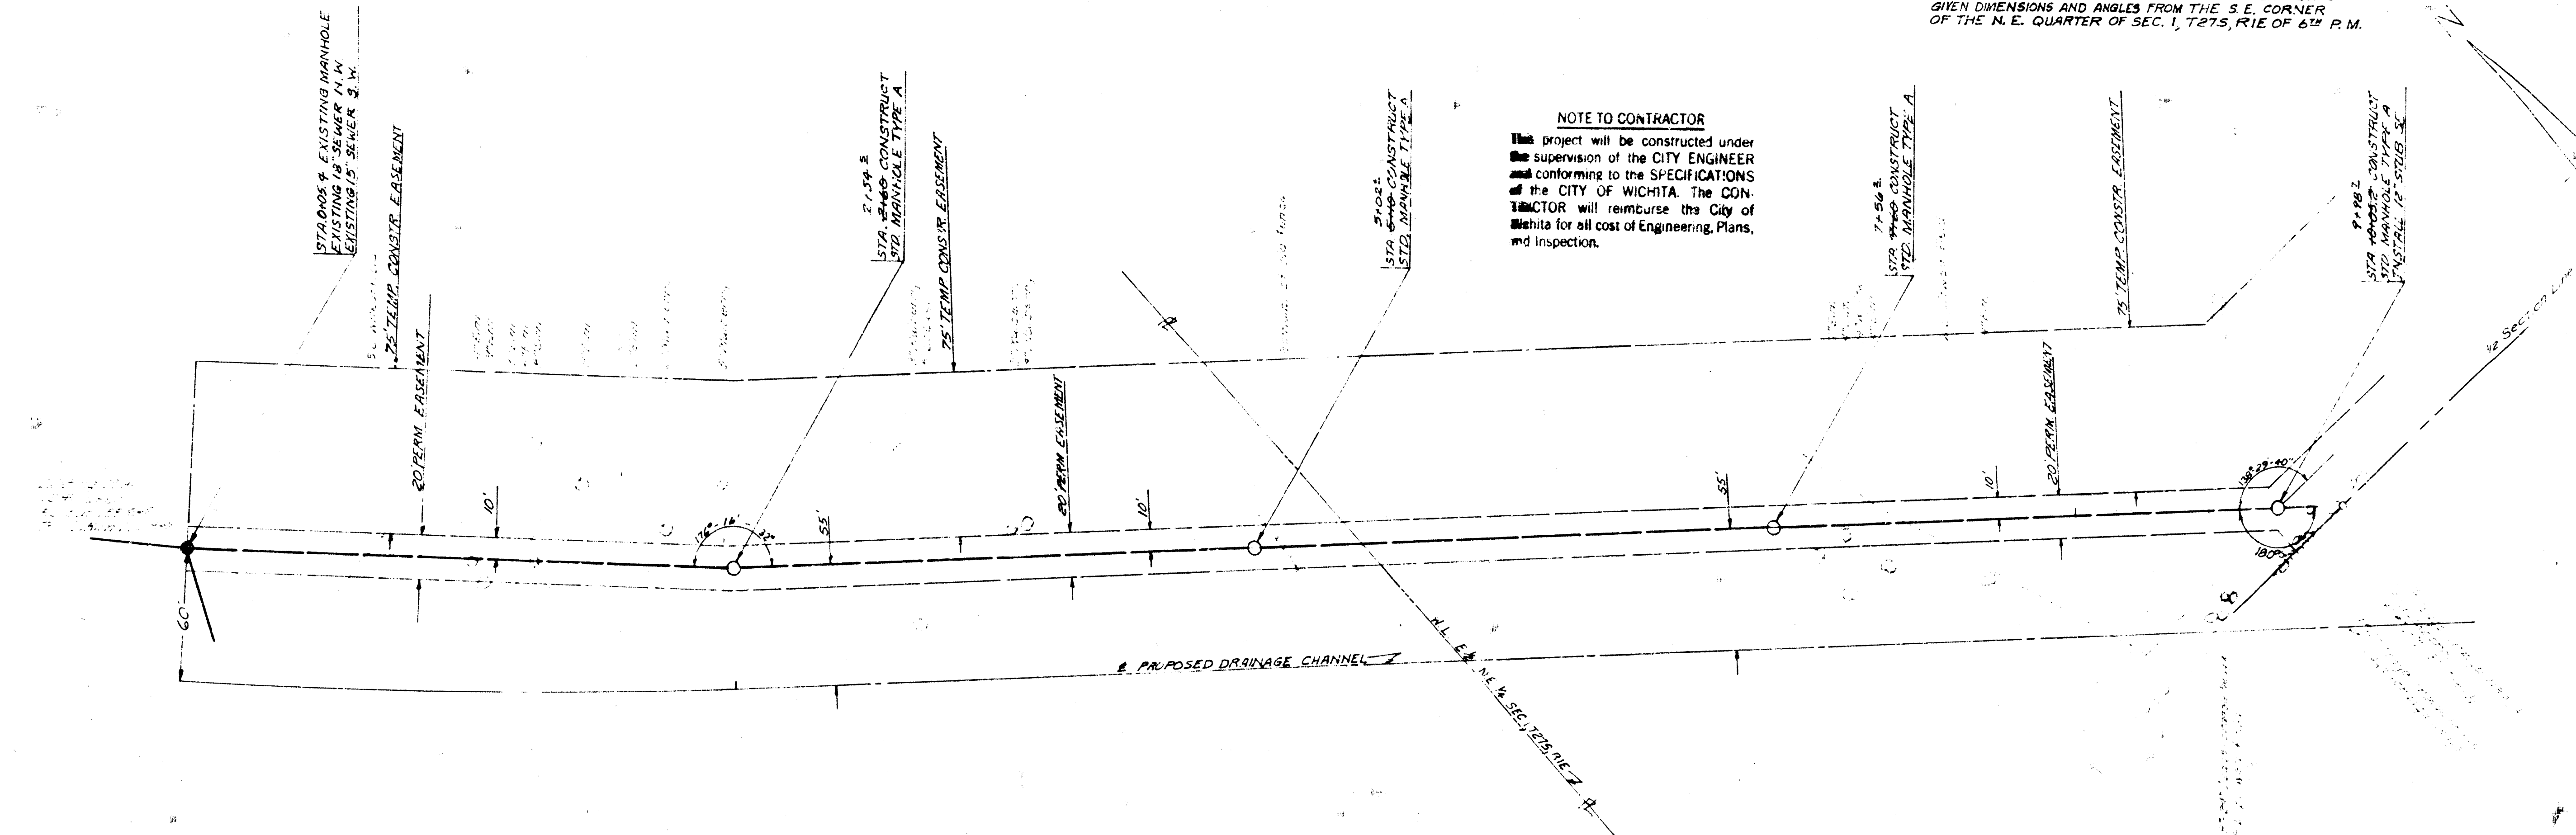

As Built Elevation 14-80
LAT. 32, MAIN 5, S.S. NO. 23
R.W. LINN CITY ENGINEER
CITY OF WICHITA, KS.
PROJECT NO. AAKB 502027
DATE Aug. 1972
Revised 10-20-72
1-31-73

PLAN - 180°

B. M. 200.65 CITY STD. @ N.E. COR. WOODLAWN & 21ST ST.
B. M. 189.48 CITY STD. @ WOODLAWN & 24TH ST. NO. 26 S. & 71 E. OF 1/4 SEC. COR.

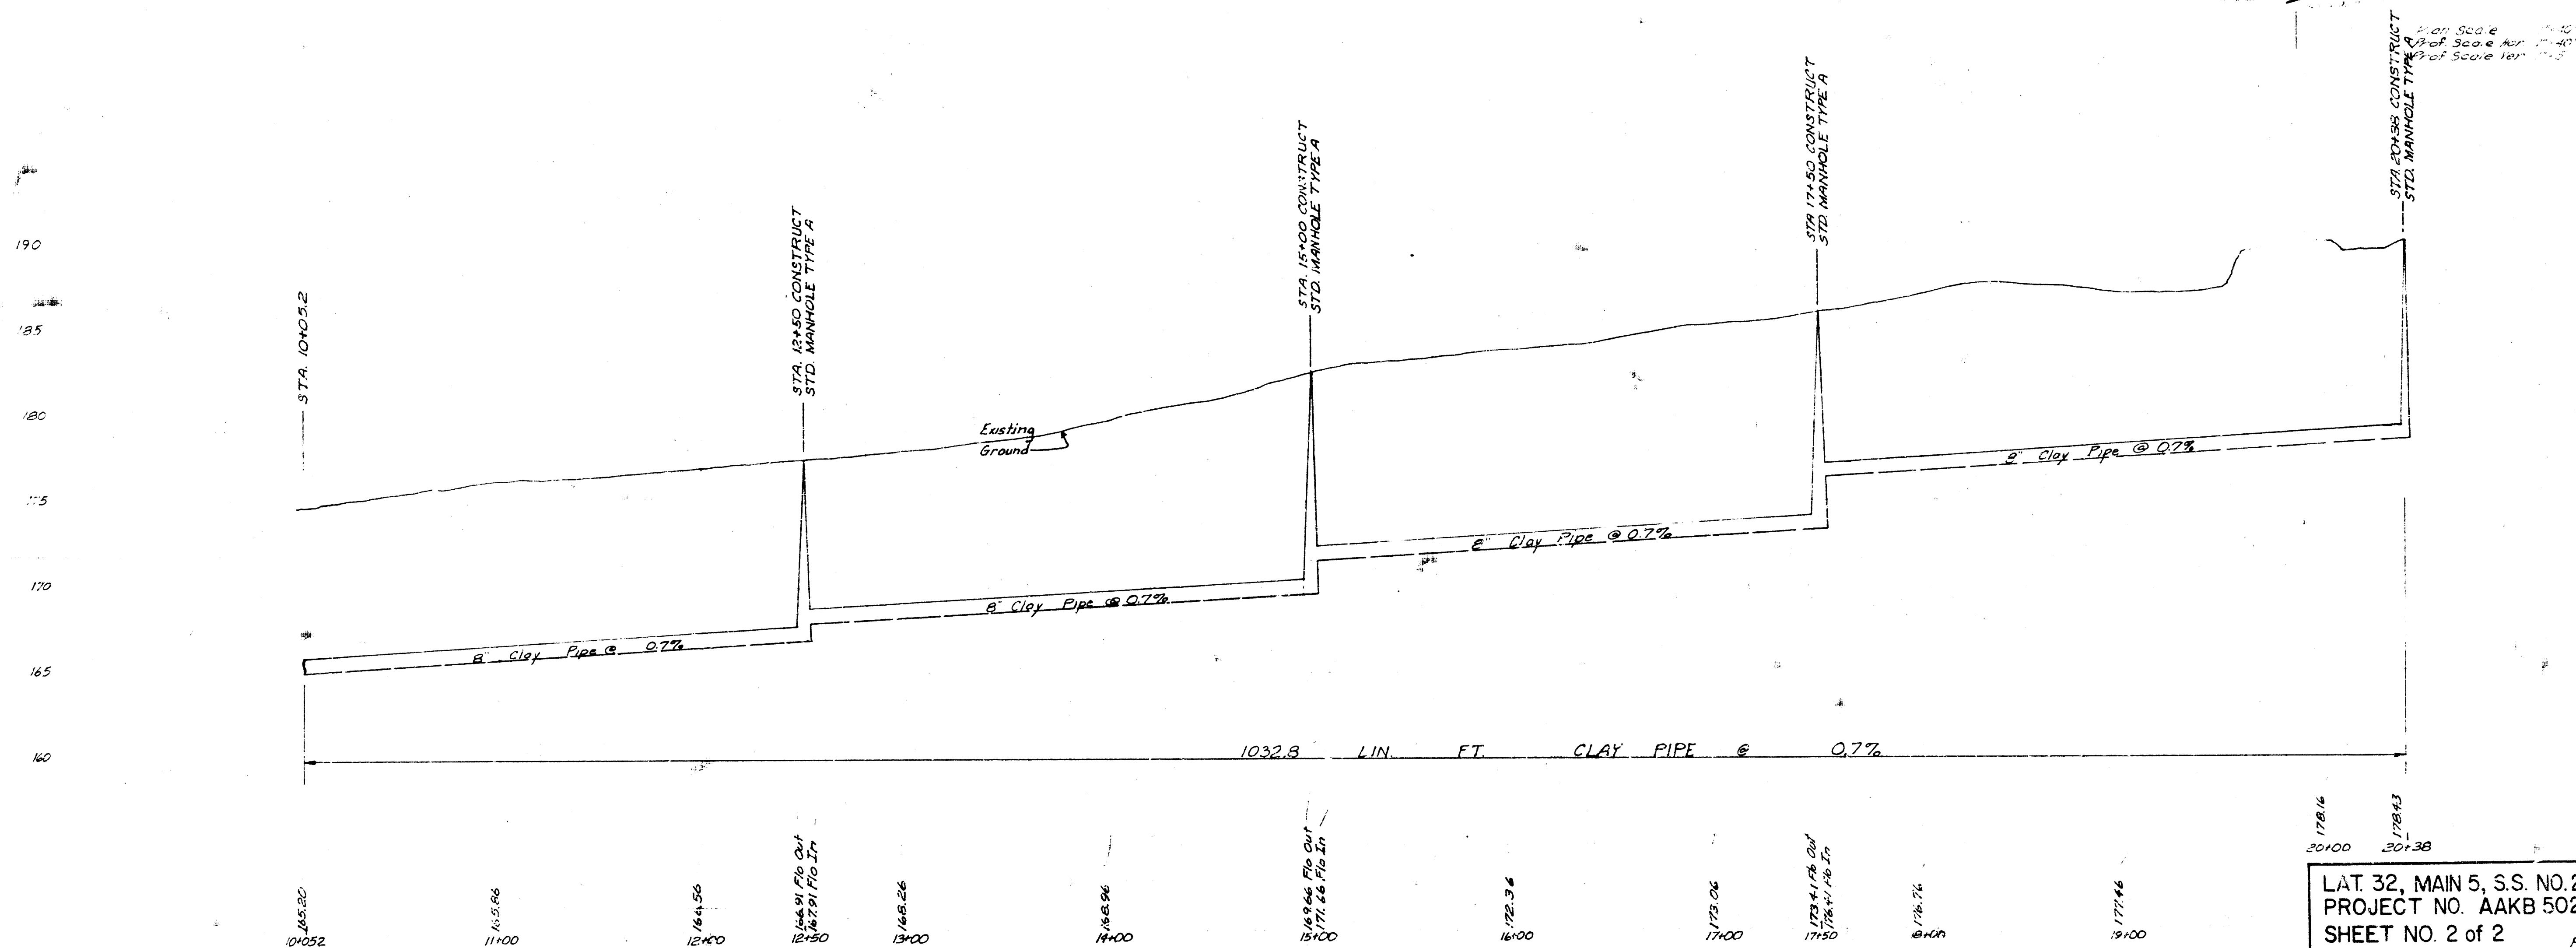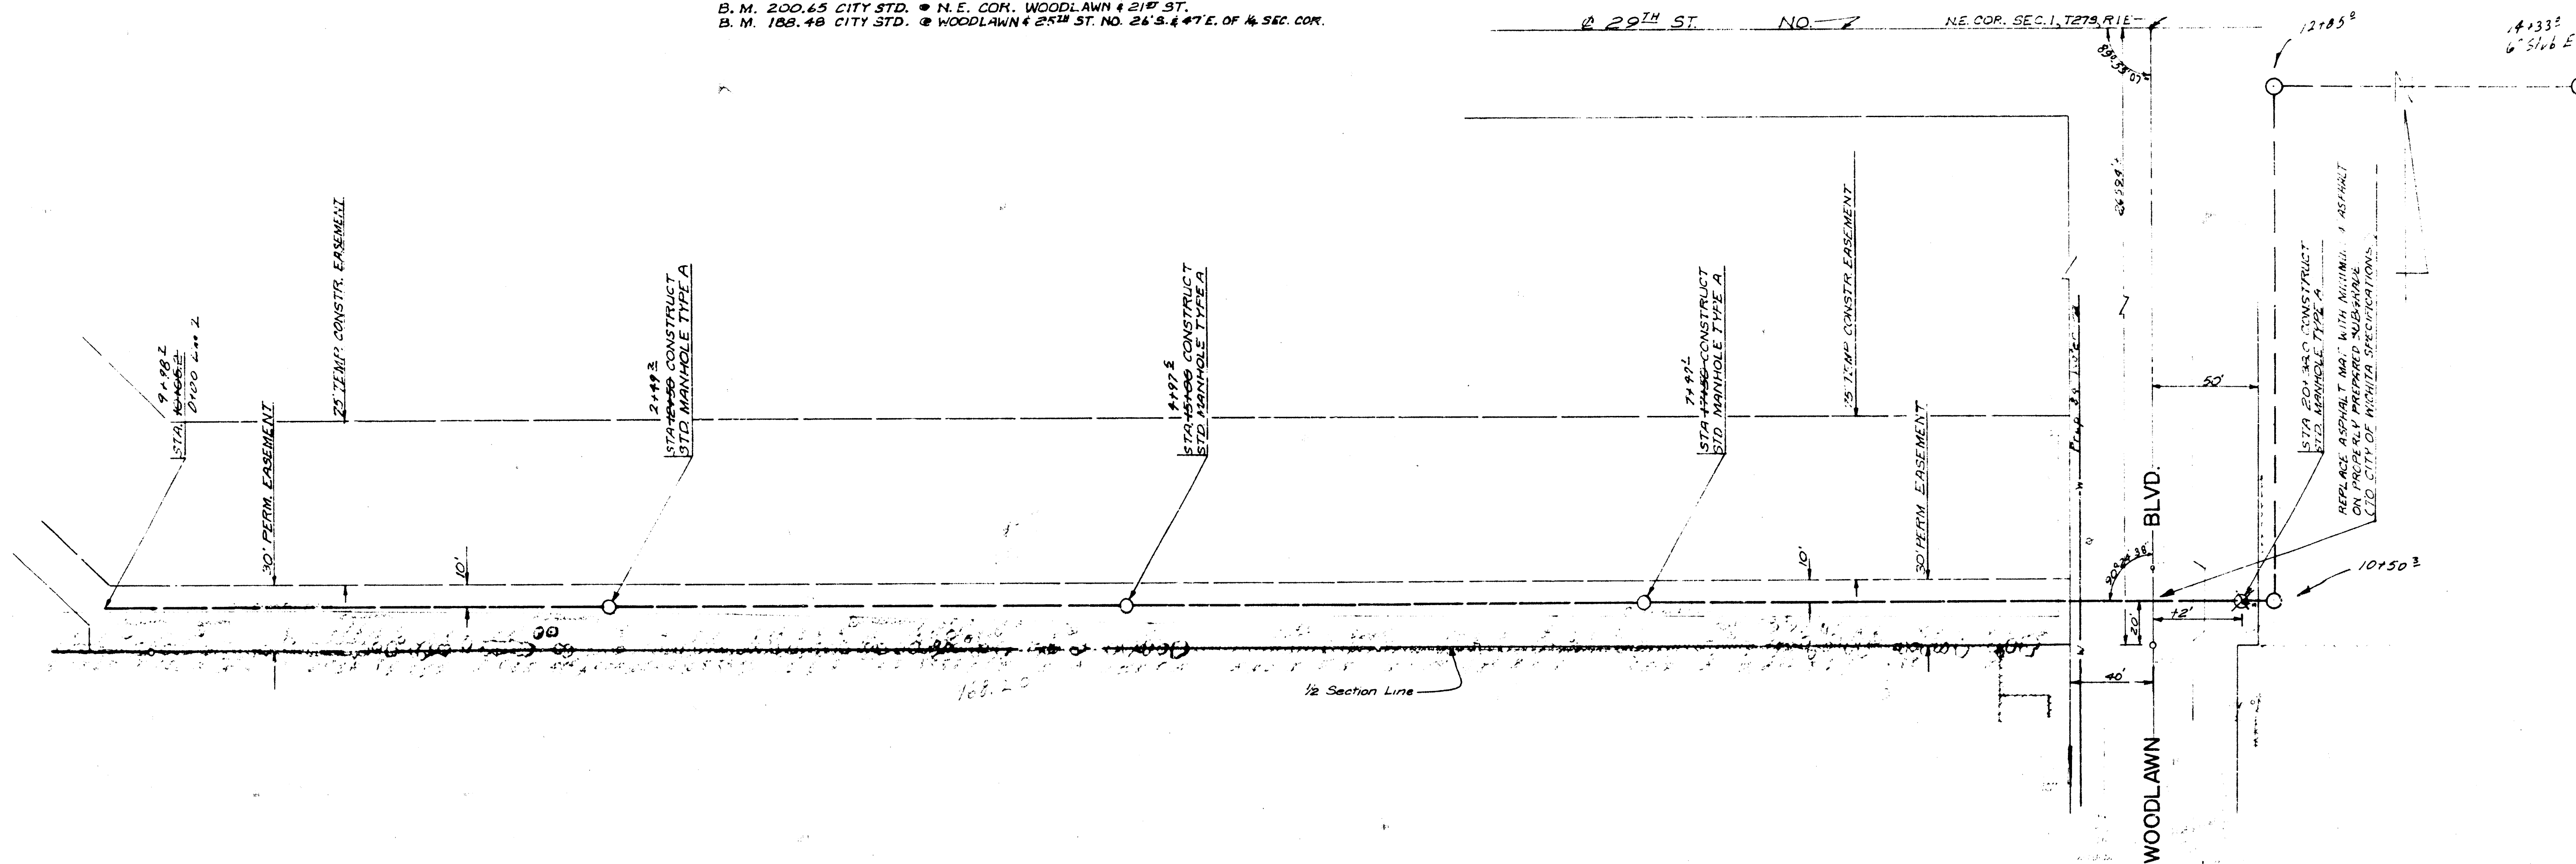

LAT. 32, MAIN 5, S.S. NO. 23
PROJECT NO. AAKB 502027
SHEET NO. 2 of 2
Revised 10-20-72