


LATERAL 44, MAIN 5, SANITARY SEWER No. 23

Project no. 468-76-245-81320-000-000-001

CITY OF WICHITA, KANSAS
MIKE LINDEBAK CITY ENGINEER

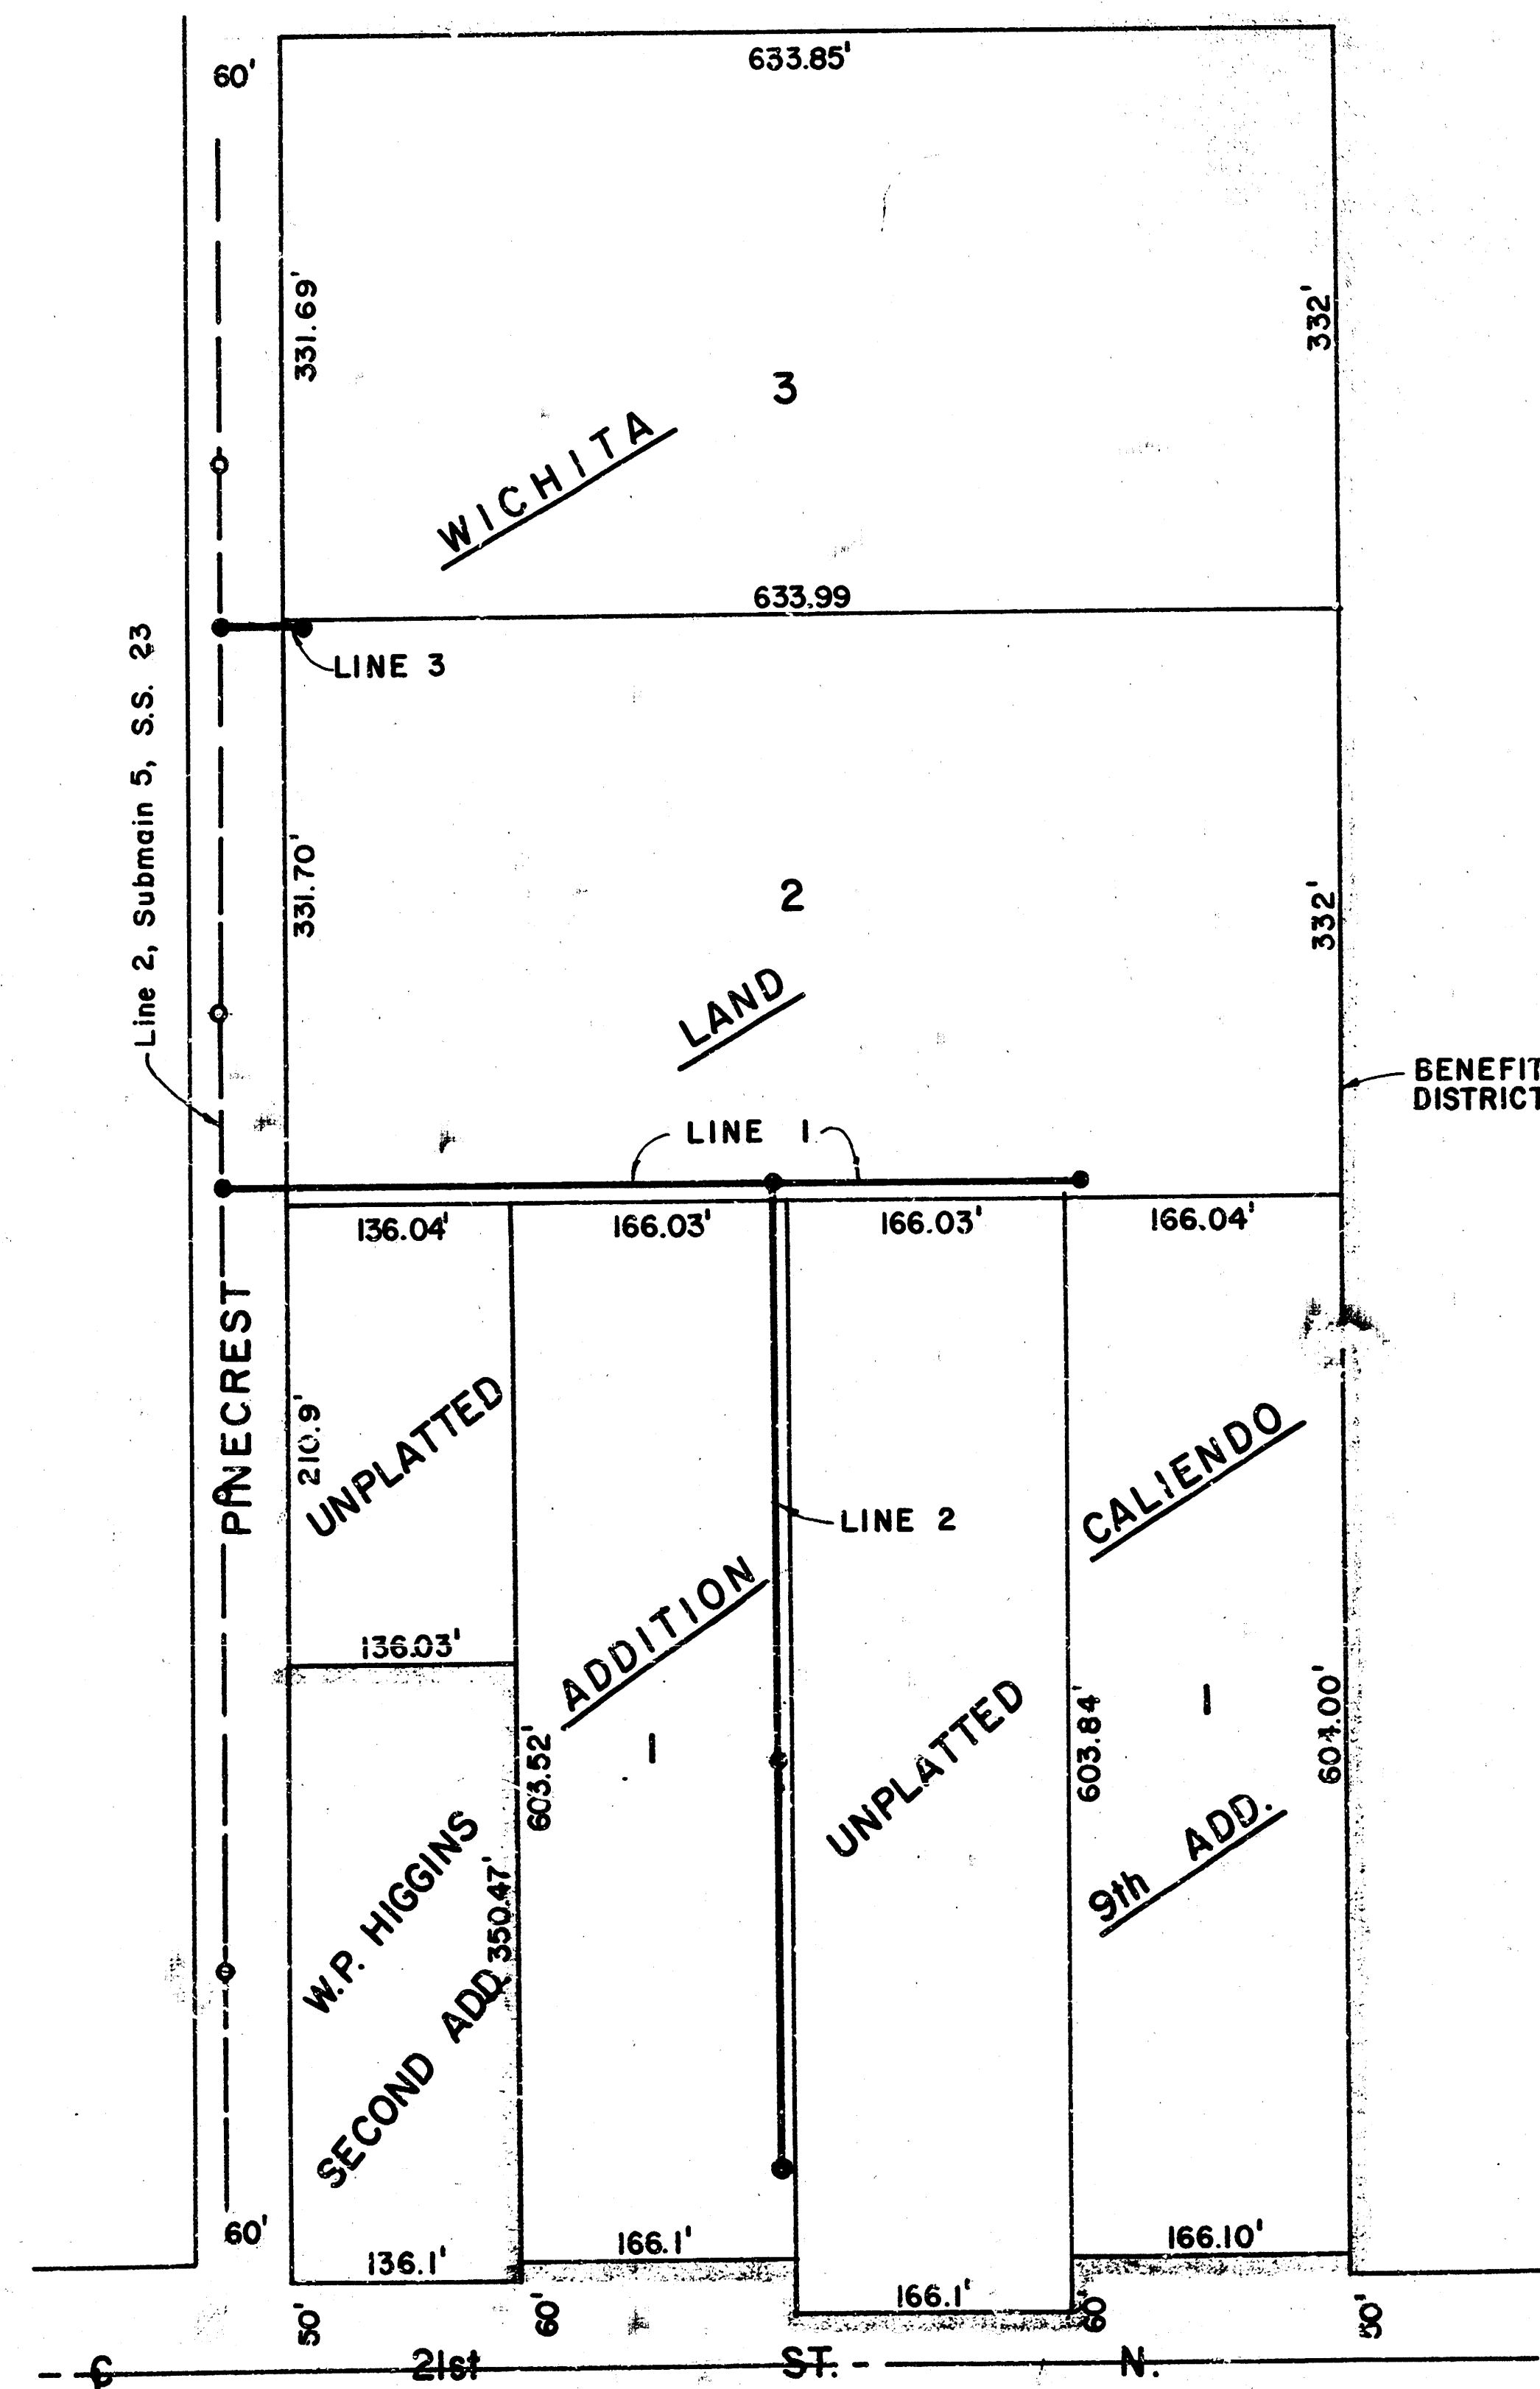

As Built
J.L.L.
8-84




1/3

BAUGHMAN COMPANY, P.A.
SURVEYING & ENGINEERING
316/262-7271 • 330 LAURA • WICHITA, KANSAS 67211


FILMED FROM THE BEST

N

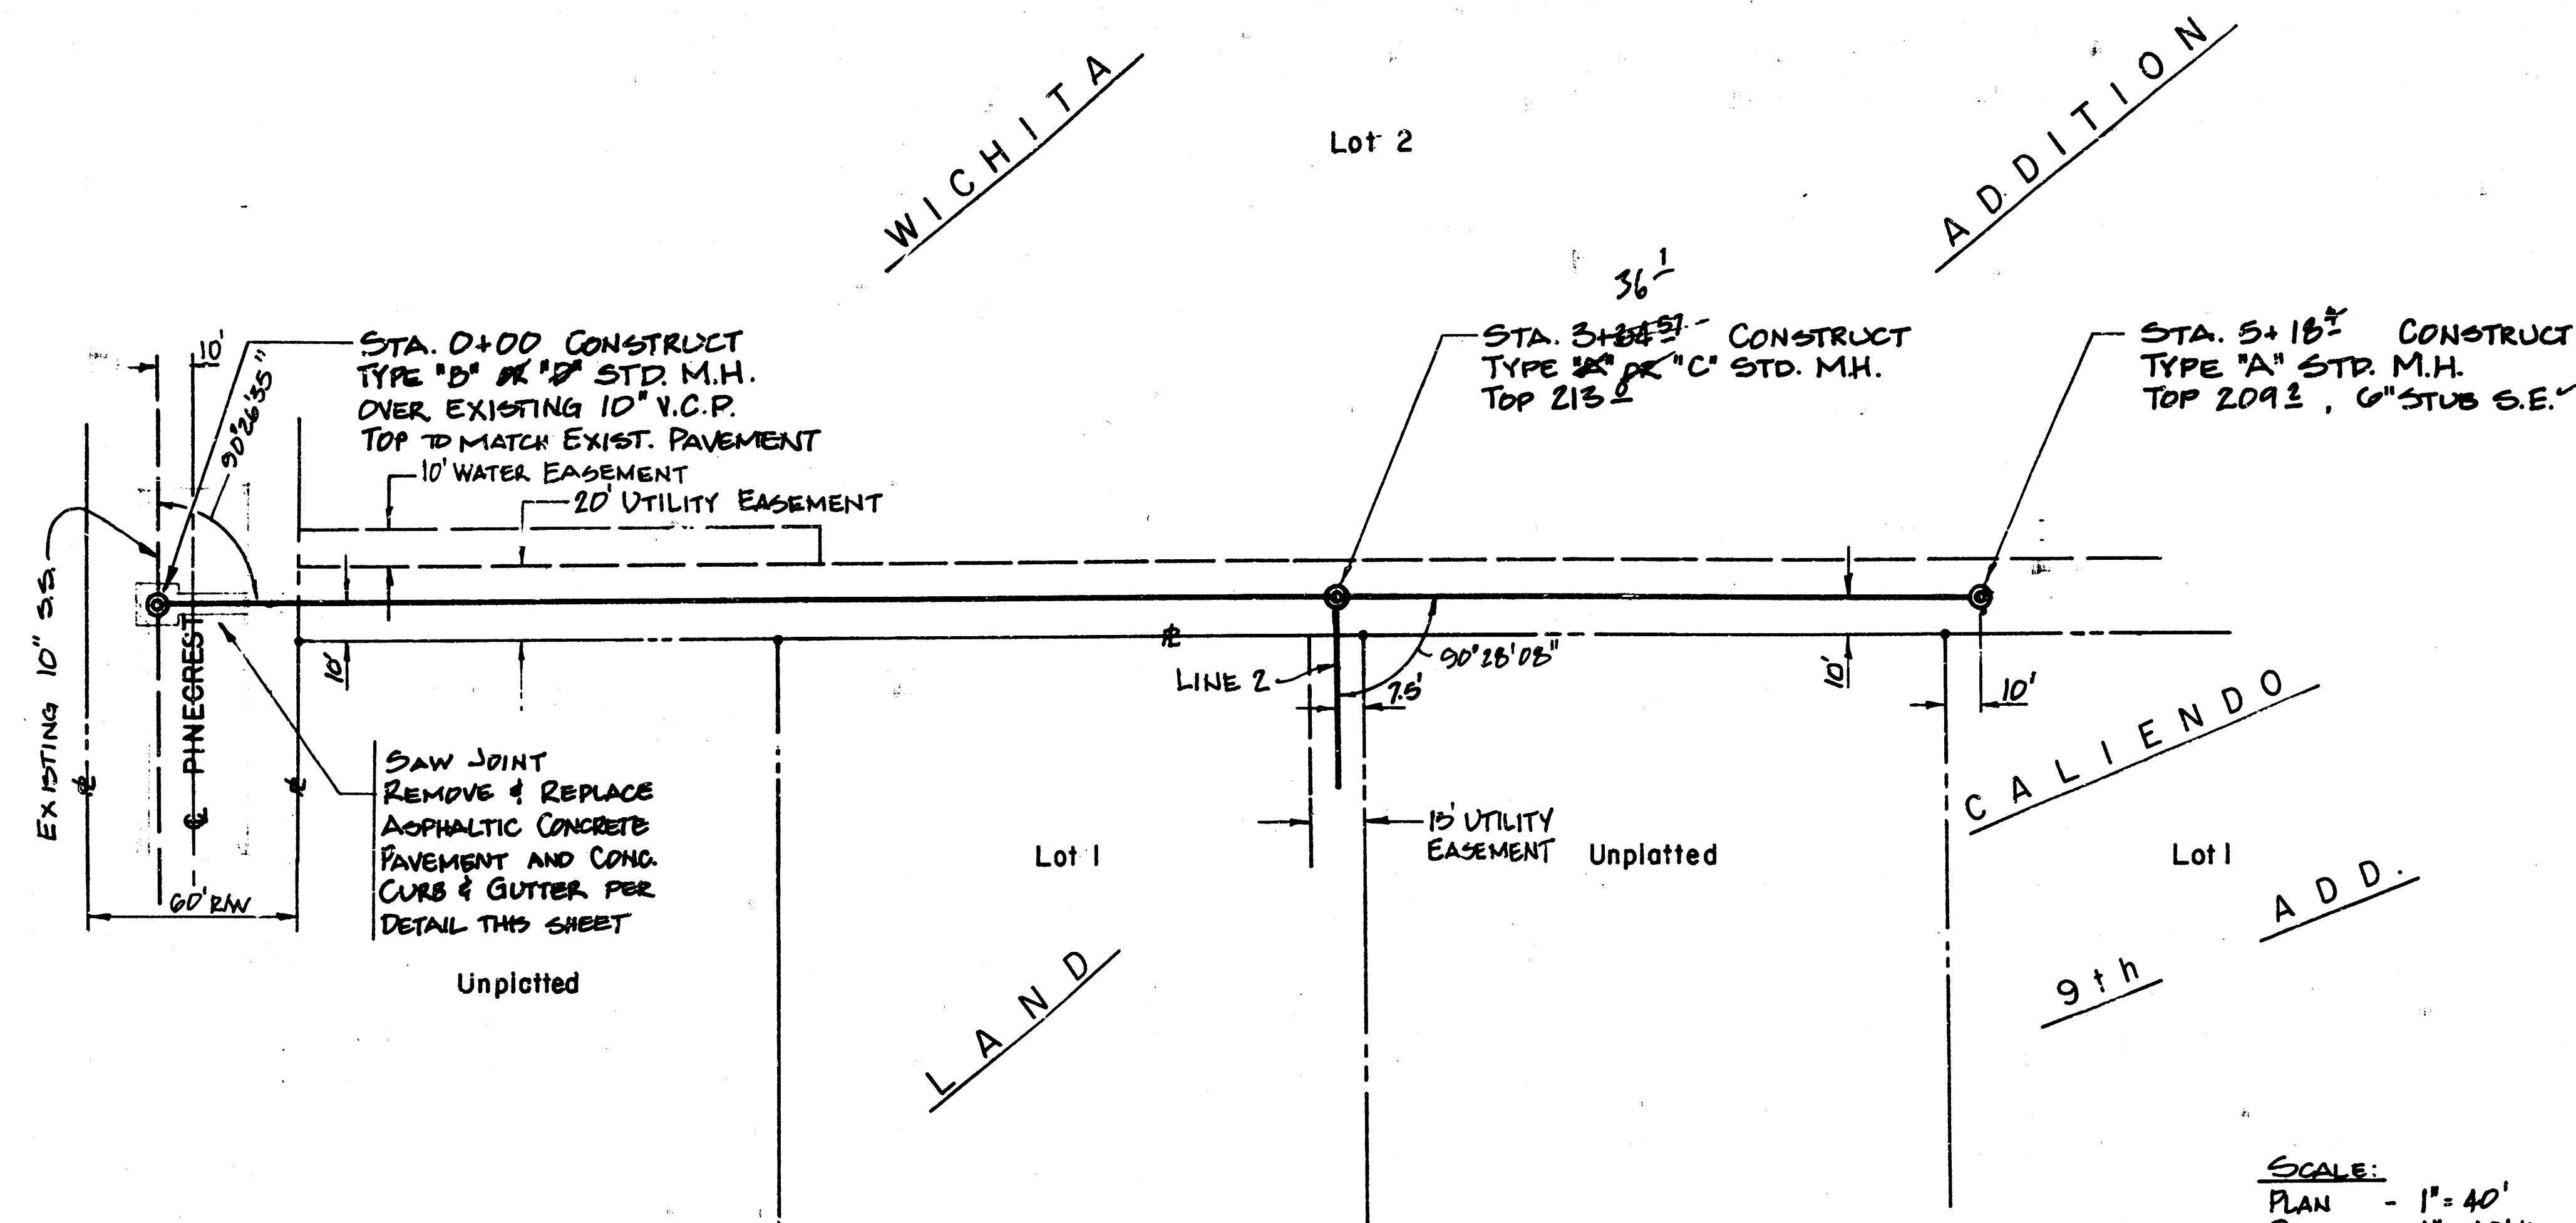

As Built
J.L.L.
8-84

SCALE:
PLAN - 1" = 40'
PROFILE - 1" = 40' HORIZ.
1" = 5' VERT.

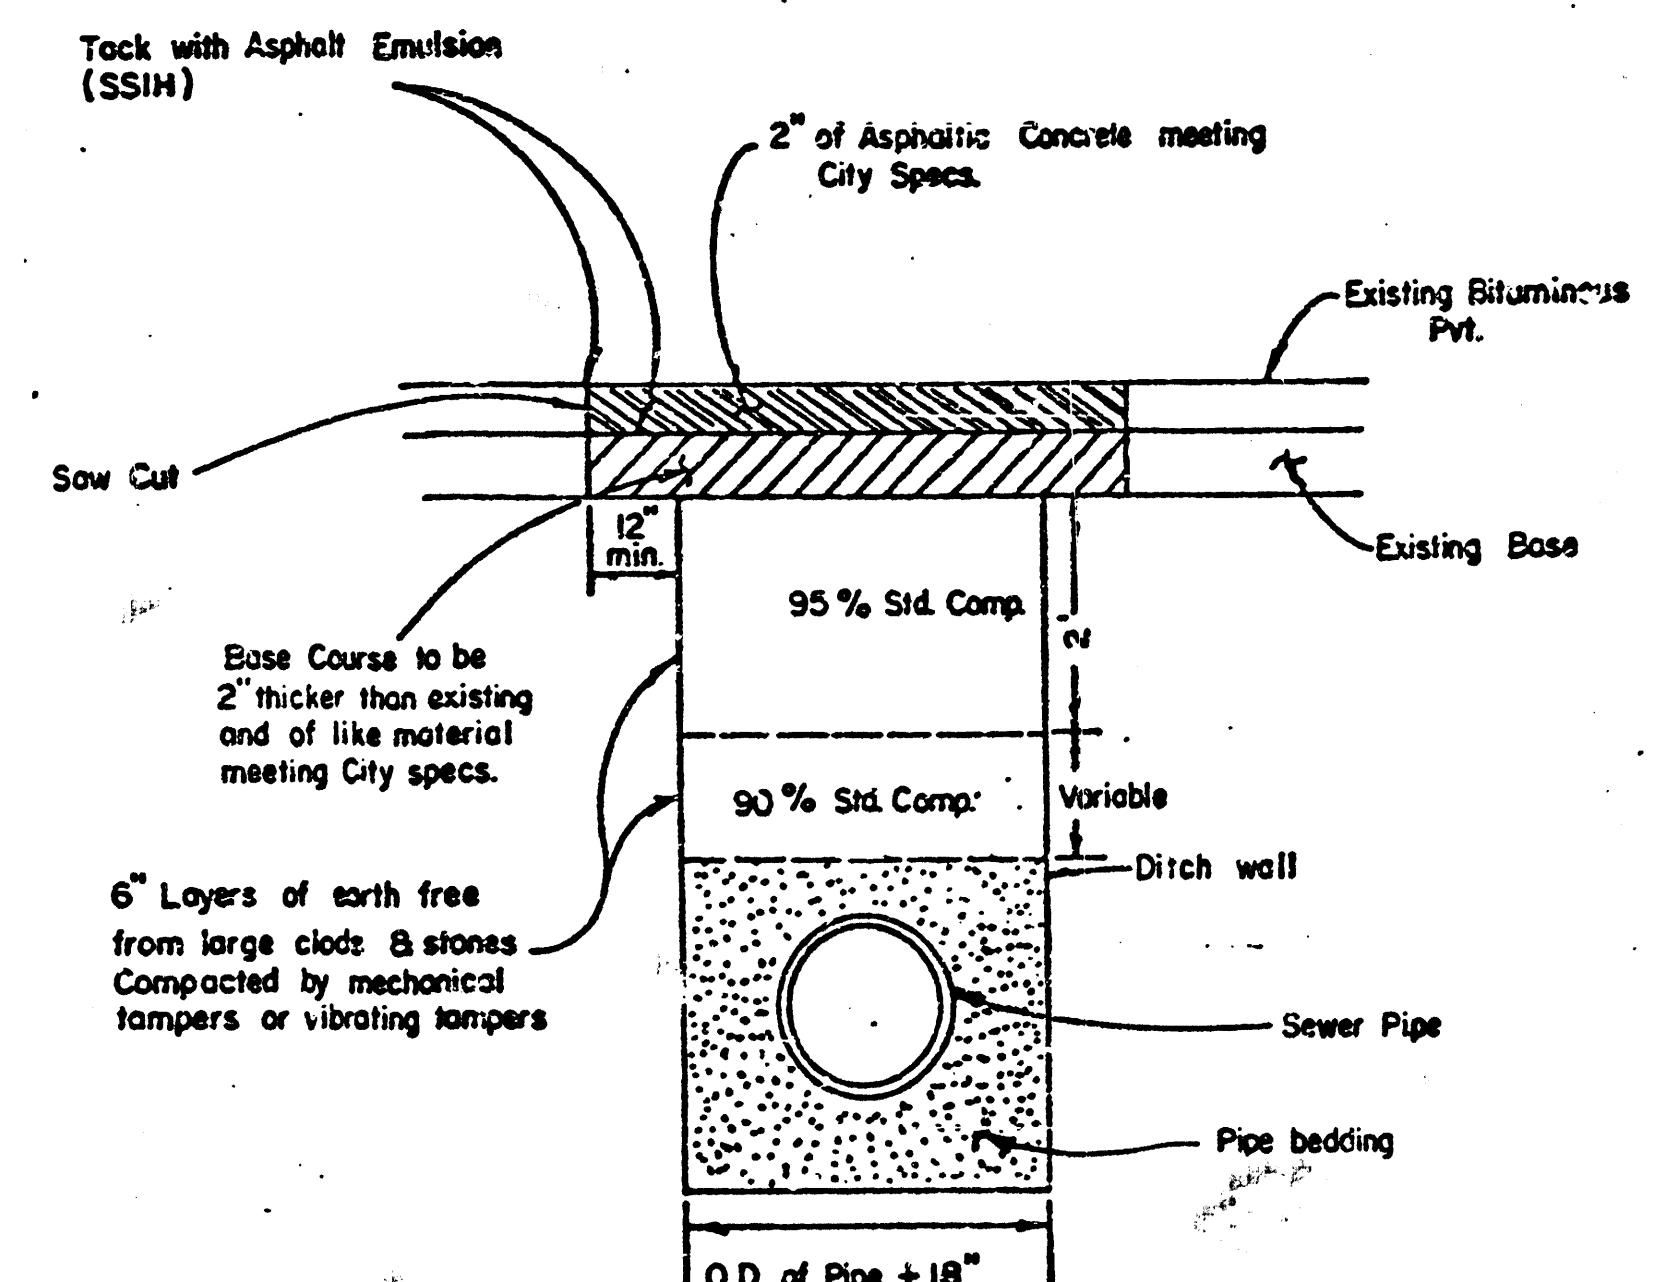

Pavement shall be removed to 1.0' min. beyond limits of trench and manhole excavation, or to next construction joint within 4'. All cuts shall be rectangular.

Standard Density Test, as described in the latest edition of ASTM D 698, shall be performed to verify the above requirements to the Satisfaction of the Dept. of Engineering or the Dept. of Operations and Maintenance. All testing cost shall be included in the unit price bid for the pipe in place.

PAVEMENT REPLACEMENT DETAIL

BENCH MARKS


"B" CUT ON CORNER OF WALK
AT S.W. COR. WOODGATE 2ND ADD.
ELEV. 221.82

"B" CUT ON TOP OF CURB, 45.81' W. OF
S.W. COR. LOT 2, WICHITA LAND ADD.
ELEV. 207.28

NOTE:

THE CONTRACTOR SHALL BE RESPONSIBLE FOR PROTECTION OF ALL PROPERTY CORNERS OR IRONS. ANY CORNERS DESTROYED BY THE CONTRACTOR'S OPERATION SHALL BE REPAIR BY A LICENSED SURVEYOR OR PROFESSIONAL ENGINEER AT CONTRACTOR'S EXPENSE.

THE COST OF ANY TREE REMOVAL NECESSARY FOR THE PROJECT SHALL BE CONSIDERED AS INCIDENTAL TO THE COST OF LF PIPE.

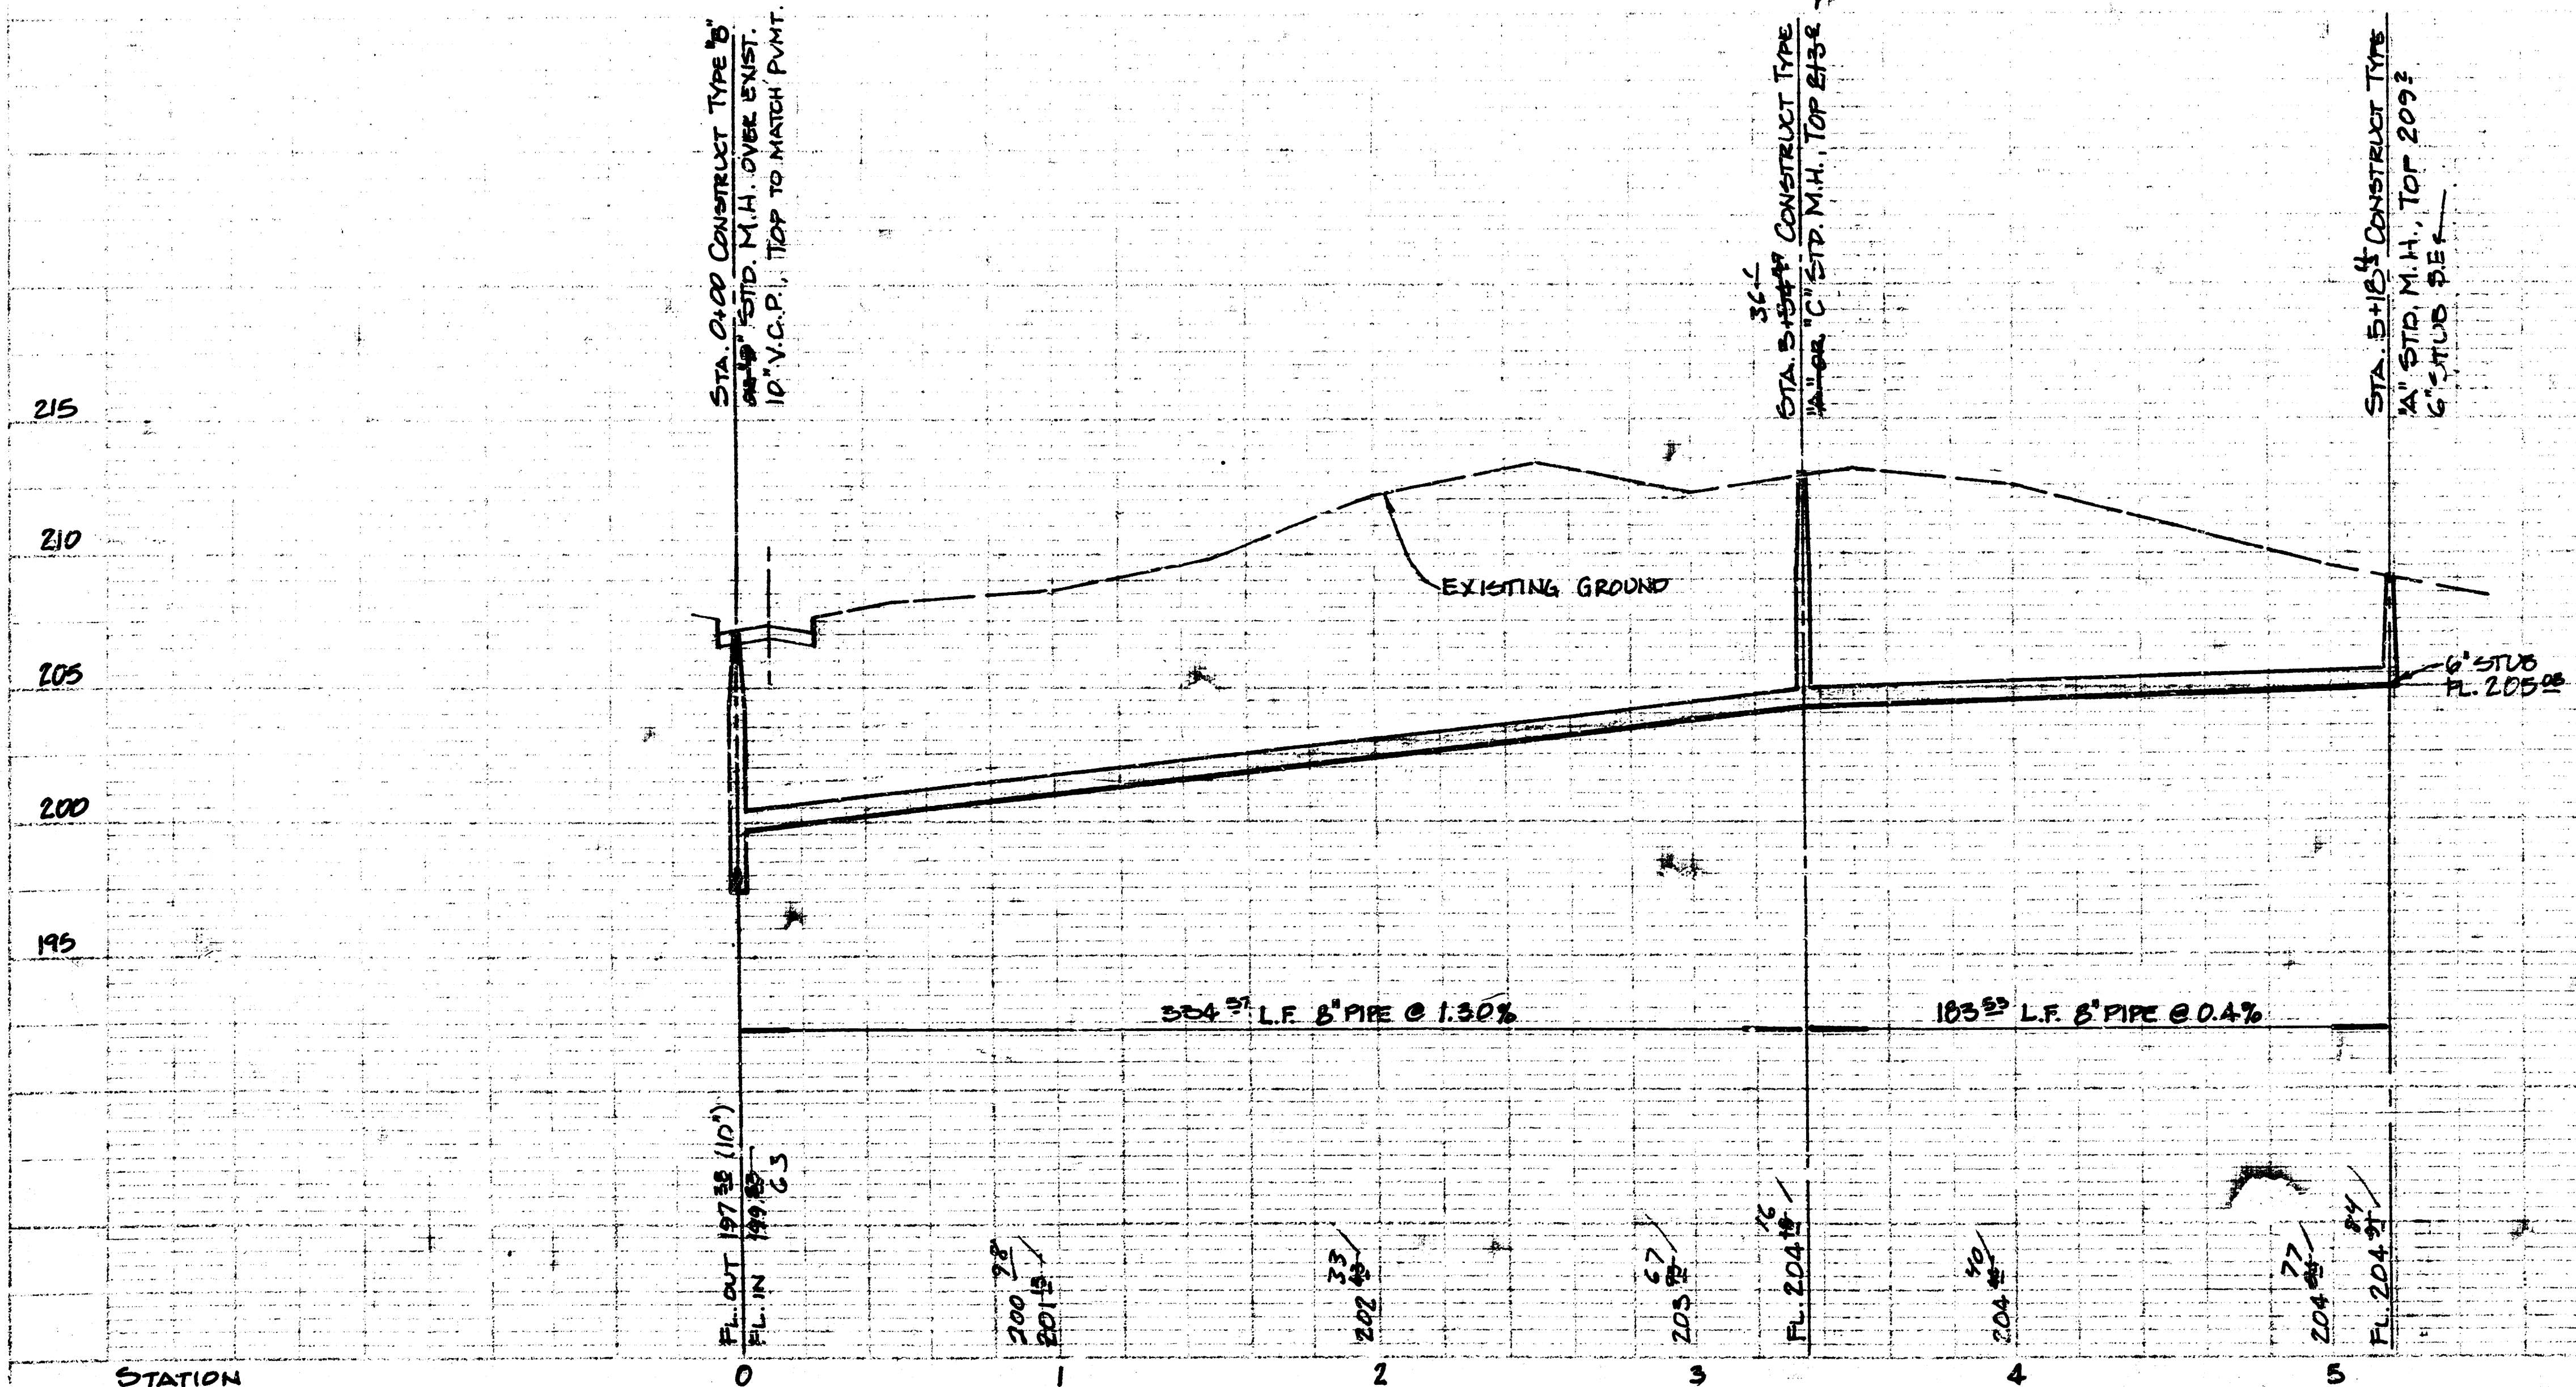

**LATERAL 44, MAIN 5
SANITARY SEWER 23**

City of Wichita, Kansas

Project no. 468-76-245-81320-000-001

BAUGHMAN COMPANY, P.A.
SURVEYING & ENGINEERING
316/242-7271 • 200 LAMAR • WICHITA, KANSAS 67211

2/3

**FILMED FROM THE BEST
AVAILABLE COPY**

WICHITA

Lot 2

LAND

Unplatted

STA. 0+00 = 3+34.5 (LINE 1)
TYPE "A" OR "C" STD. M.H.
TOP 215.2
210.2

STA. 3+30^{1/2} CONSTRUCT
TYPE "A" OR "C" STD. M.H.
TOP 220.2
219.7

STA. 5+65 CONSTRUCT
TYPE "A" OR "C" STD. M.H.
TOP 224.8
223.2 6" STD. W.

STA. 0+00 CONSTRUCT
TYPE "A" OR "C" STD. M.H.
OVER EXISTING 10" V.C.P.
TOP 189.1
188.1


STA. 0+45 CONSTRUCT
TYPE "A" OR "C" STD. M.H.
TOP 200.6
NE. & S.E. 1/4

SCALE:
PLAN - 1" = 40'
PROFILE - 1" = 40' HORIZ.
1" = 5' VERT.

As Built
J.L.L.
8-84

LINE 2

LINE 3

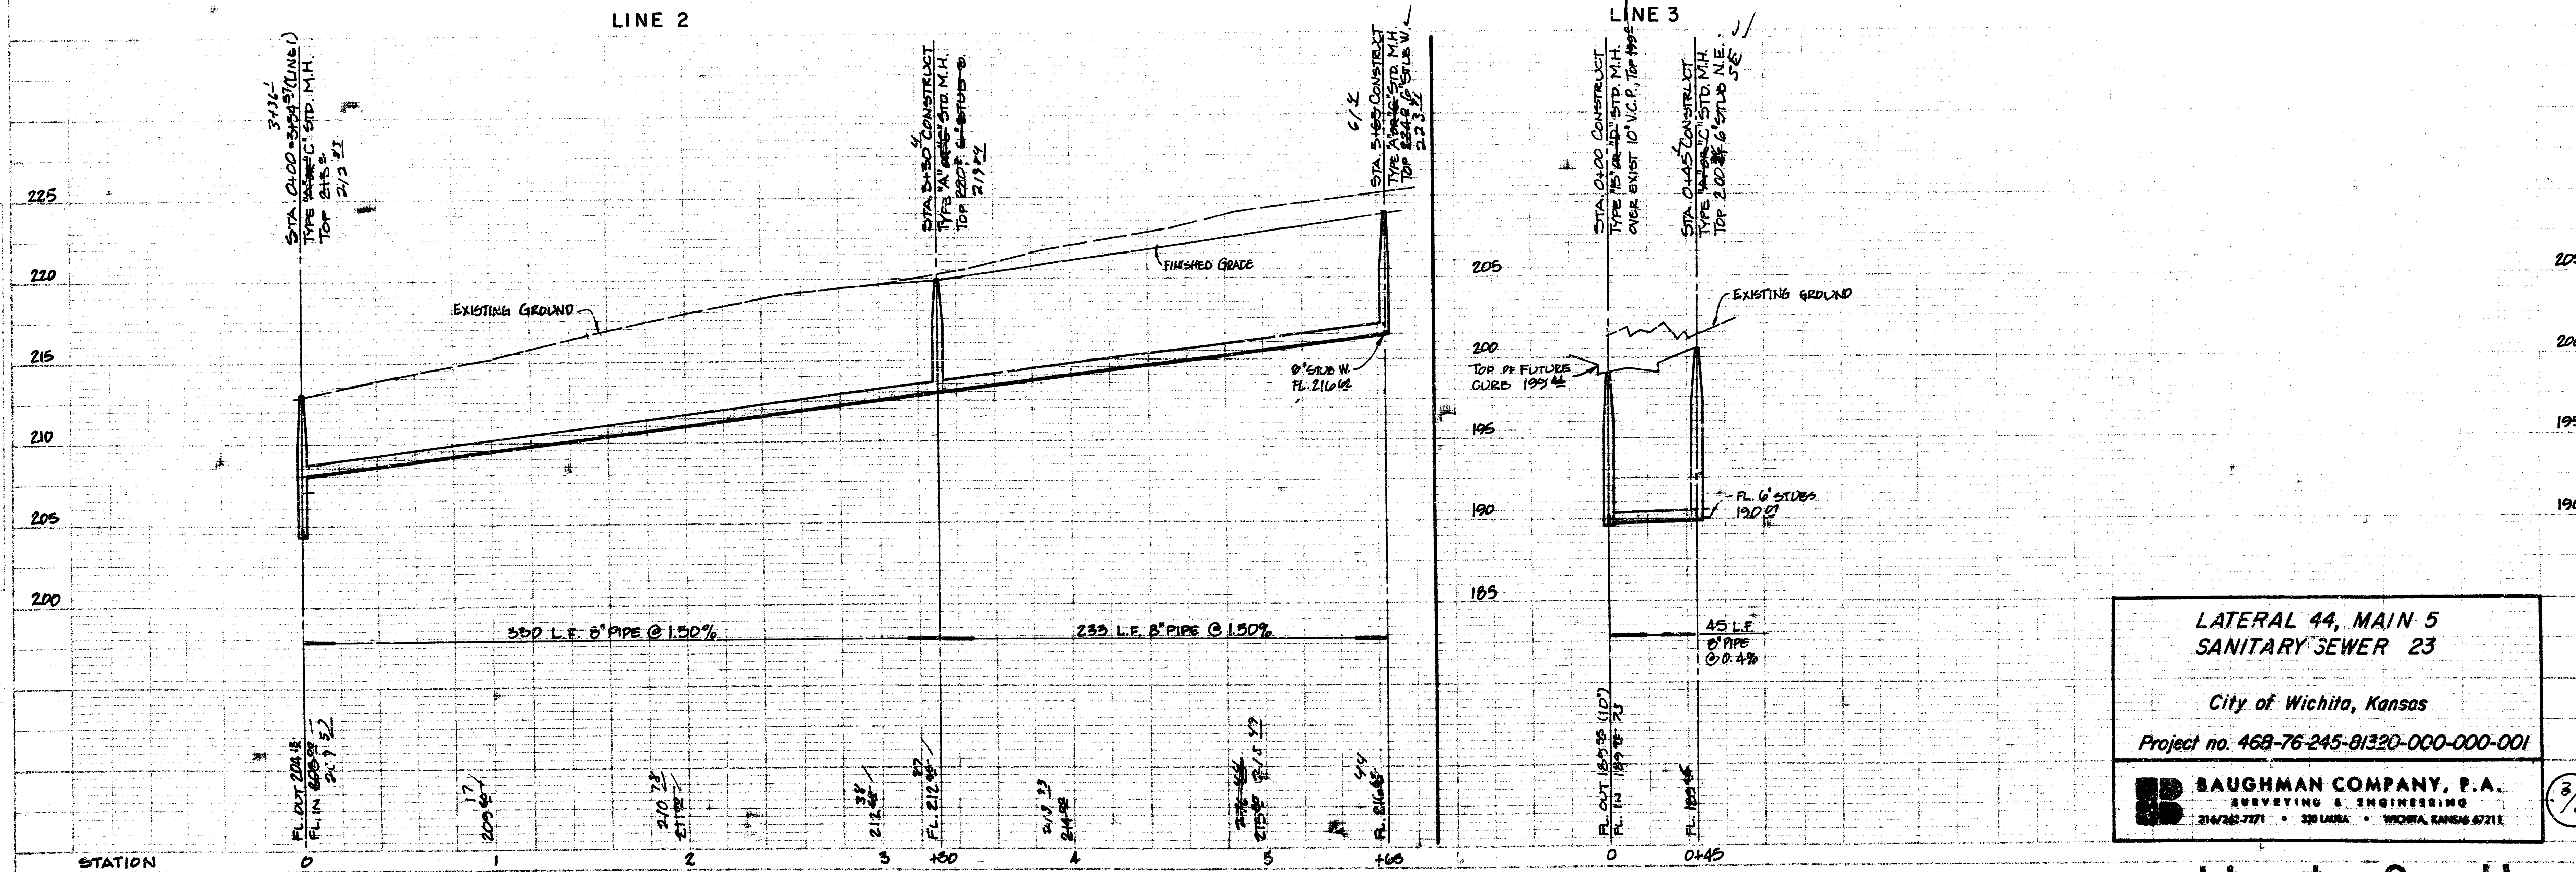

LATERAL 44, MAIN 5
SANITARY SEWER 23

City of Wichita, Kansas

Project no. 468-76-245-81320-000-000-001

BAUGHMAN COMPANY, P.A.
SURVEYING & ENGINEERING
214/262-7271 • 330 LANNA • WICHITA, KANSAS 67211

2/3

FILMED FROM THE BEST