

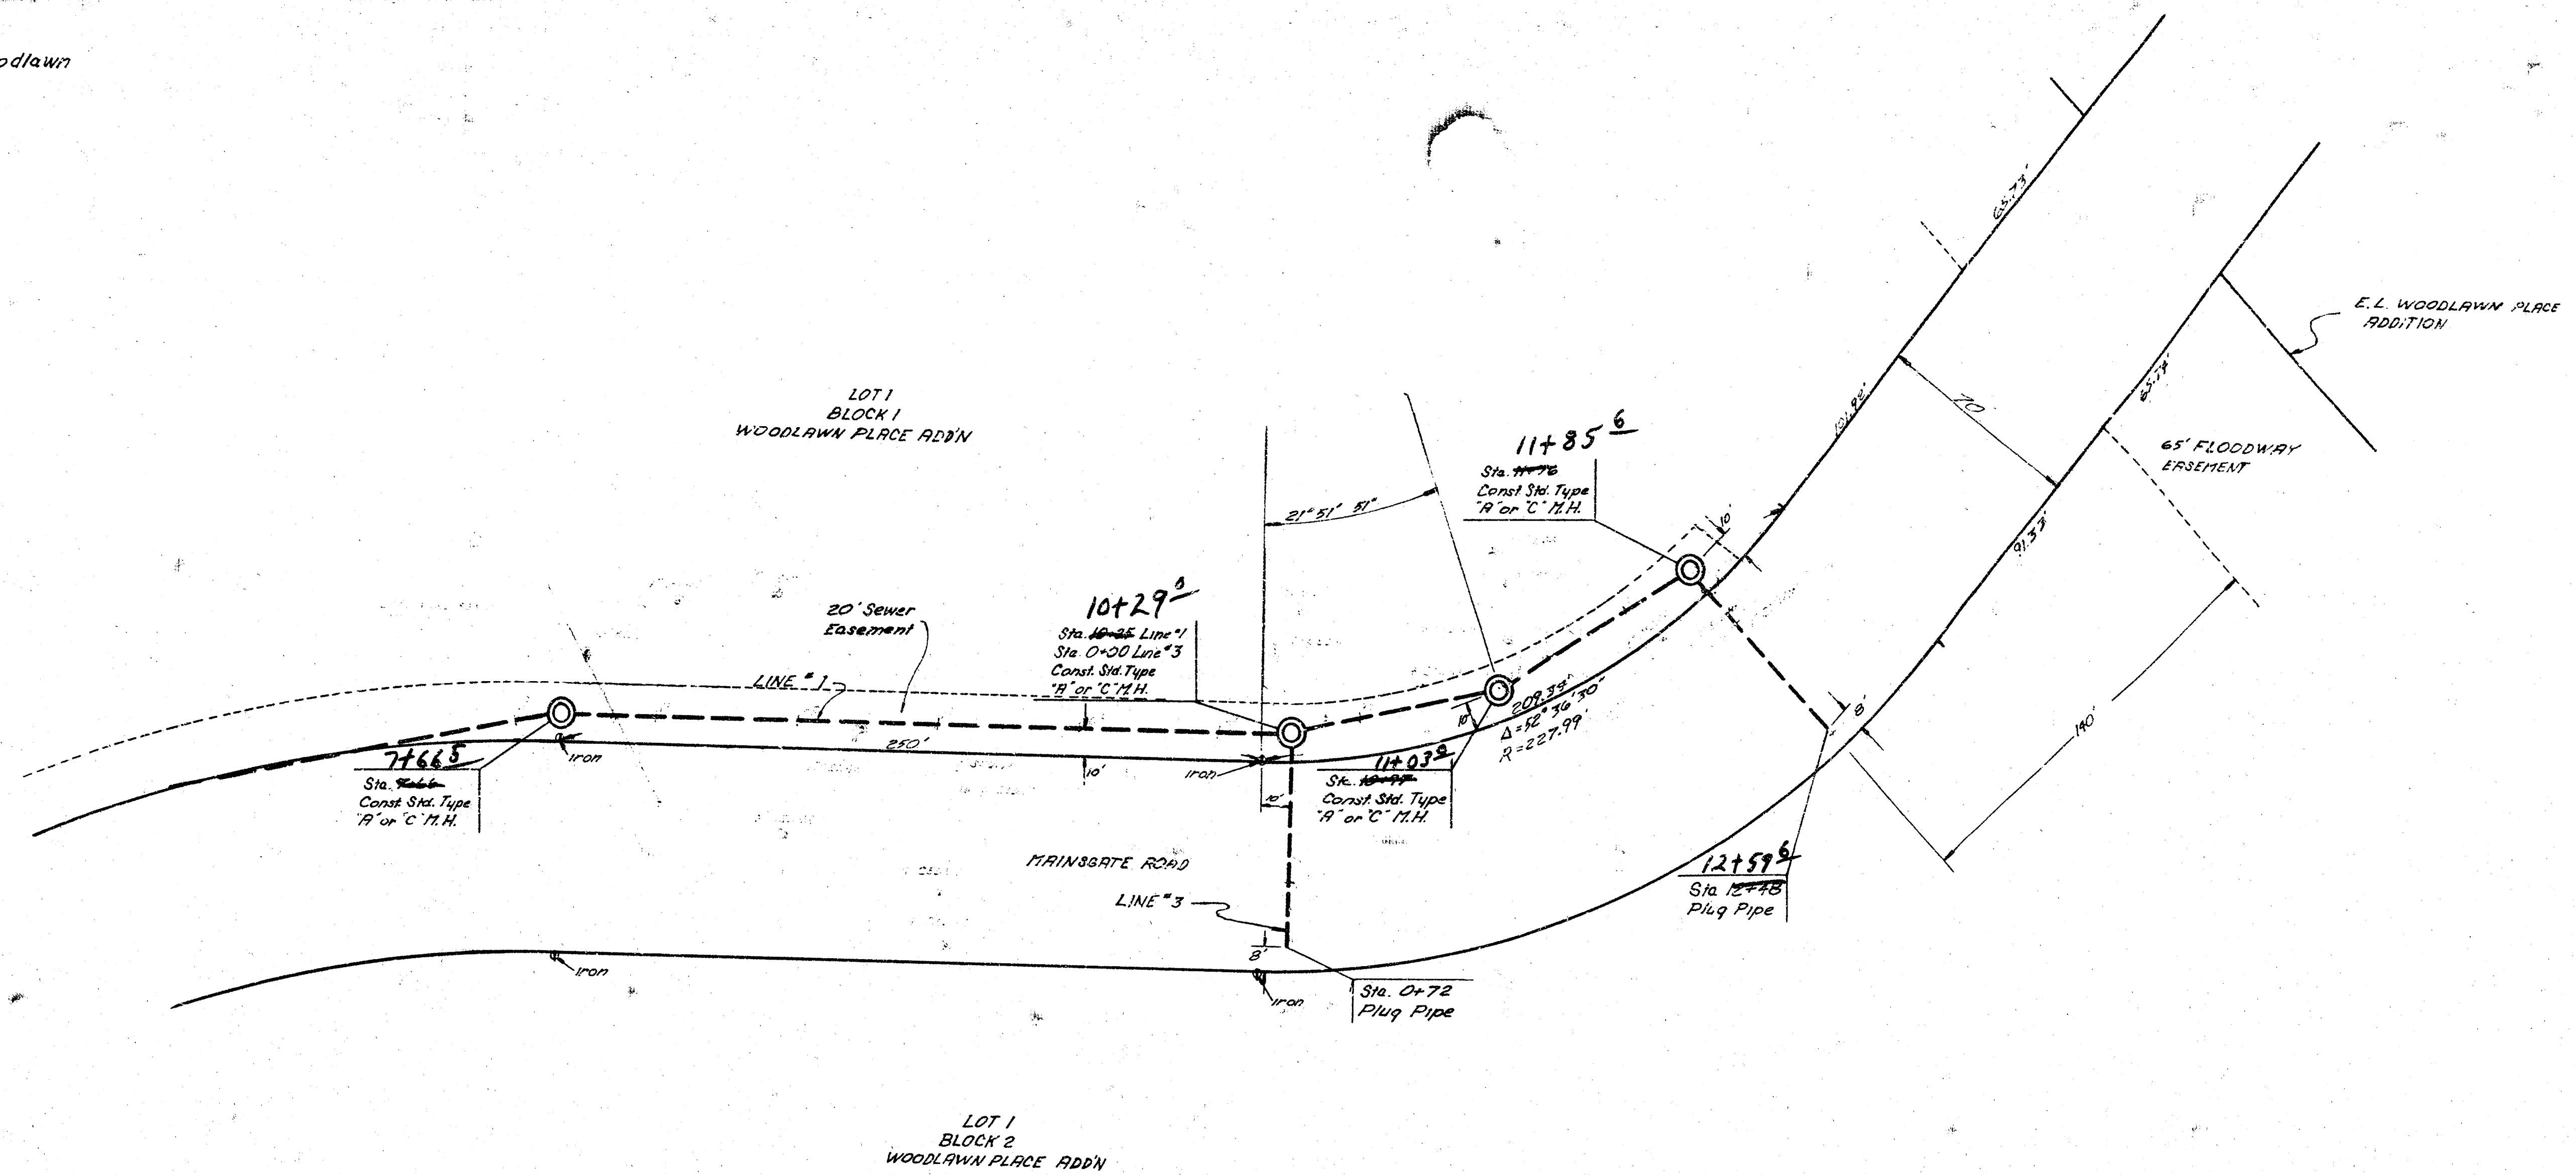


B.M. 188.48 City Std. 26'S. + 47'E. of 25th Woodlawn

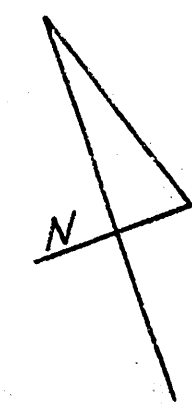

SCALE
PLAN 1"=40'
PROFILE VERT. 1"=5'

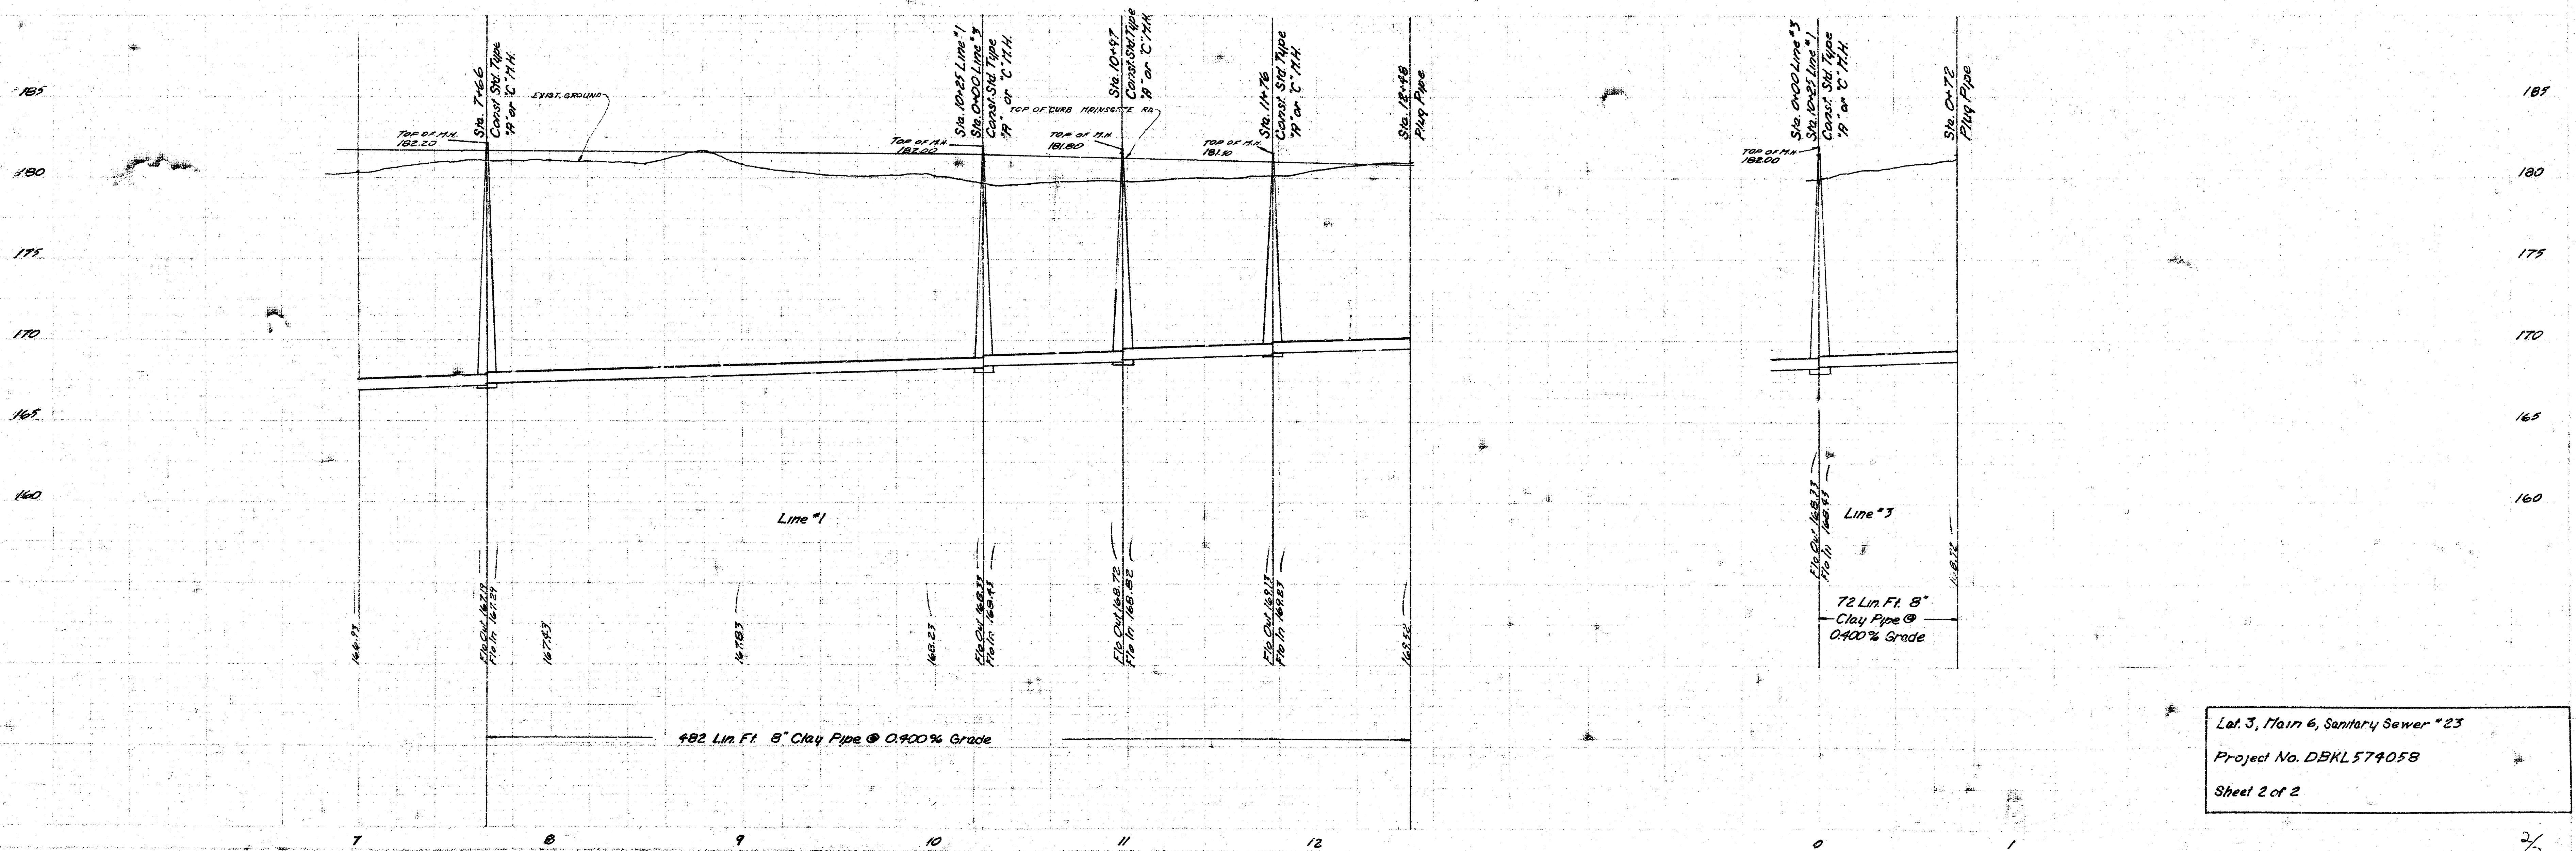

Lot 3, Main 6, Sanitary Sewer "23"
Project No. DBKL574058
Sheet 2 of 2

